

PLAN SHOWING PROPOSED FRONT VERANDAH ON PLOT

Nº 116 SHEET Nº A-21

NAPIER Q<sup>5</sup>

SCALE 3 TO 1



N

SITE PLAN


SCALE 20:1

KAMIL LOHAR ST

36-9

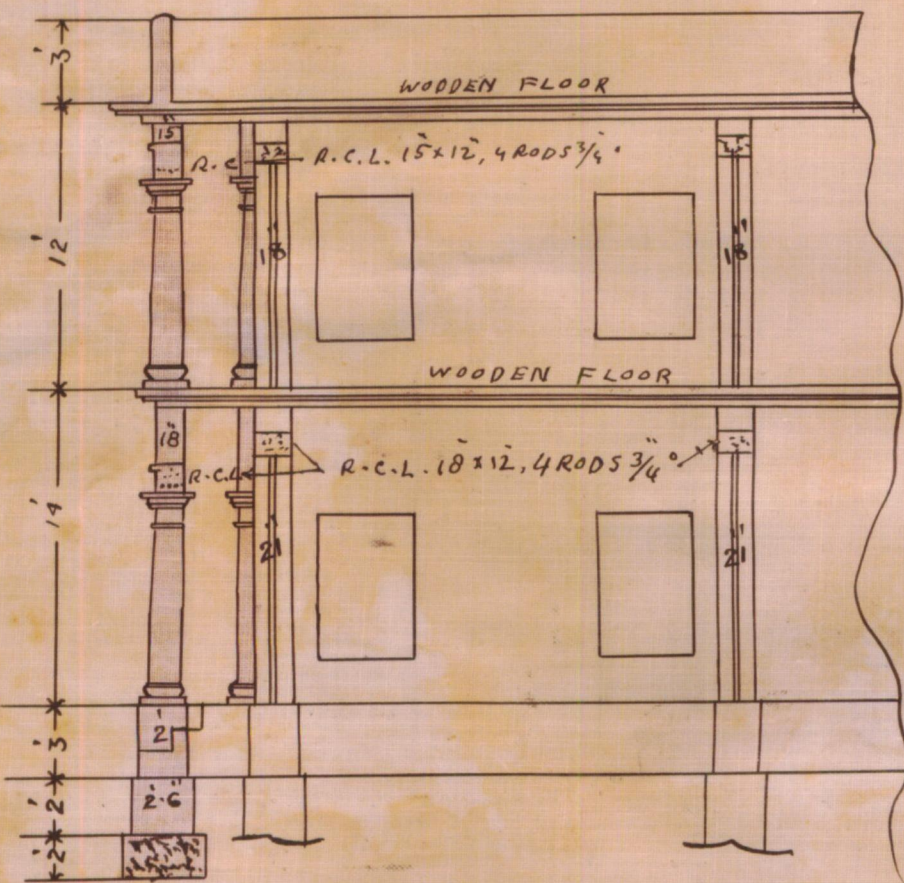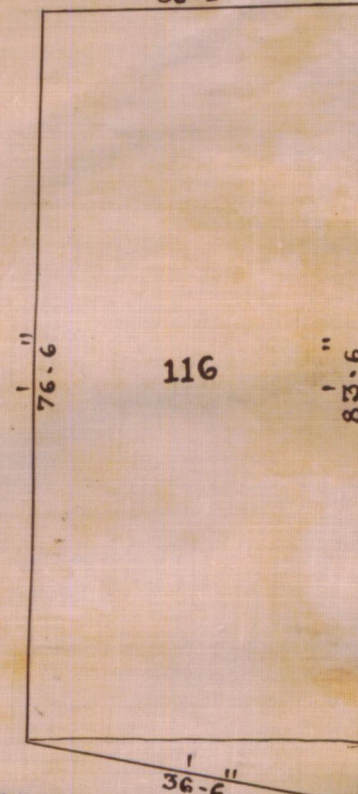


SECTION ON AB

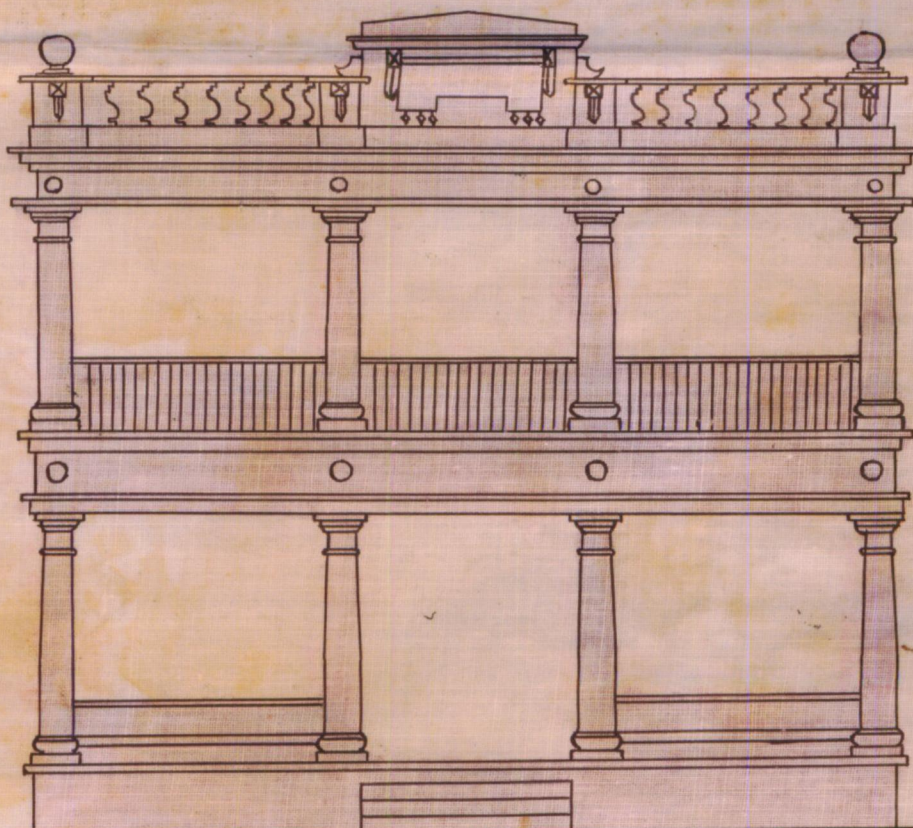


ELEVATION

APPROVED  
*Subject to the condition that the ceiling boardings and the cabin are removed.*

OWNER

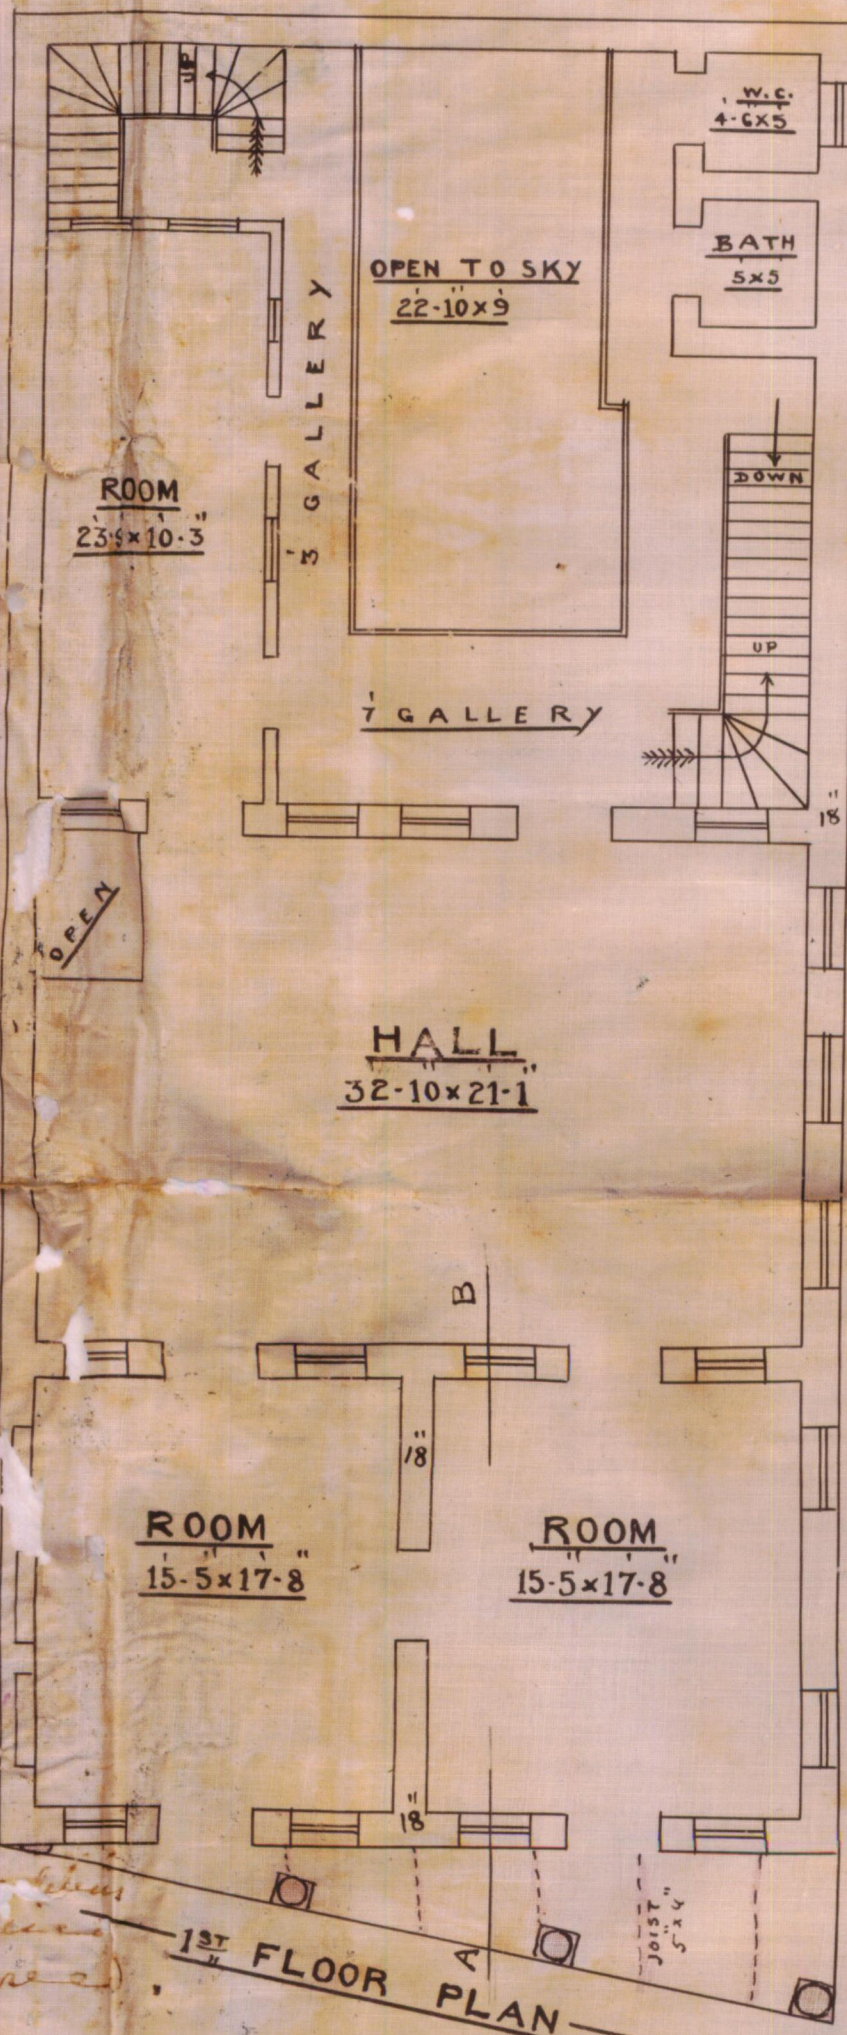

1<sup>ST</sup> FLOOR PLAN

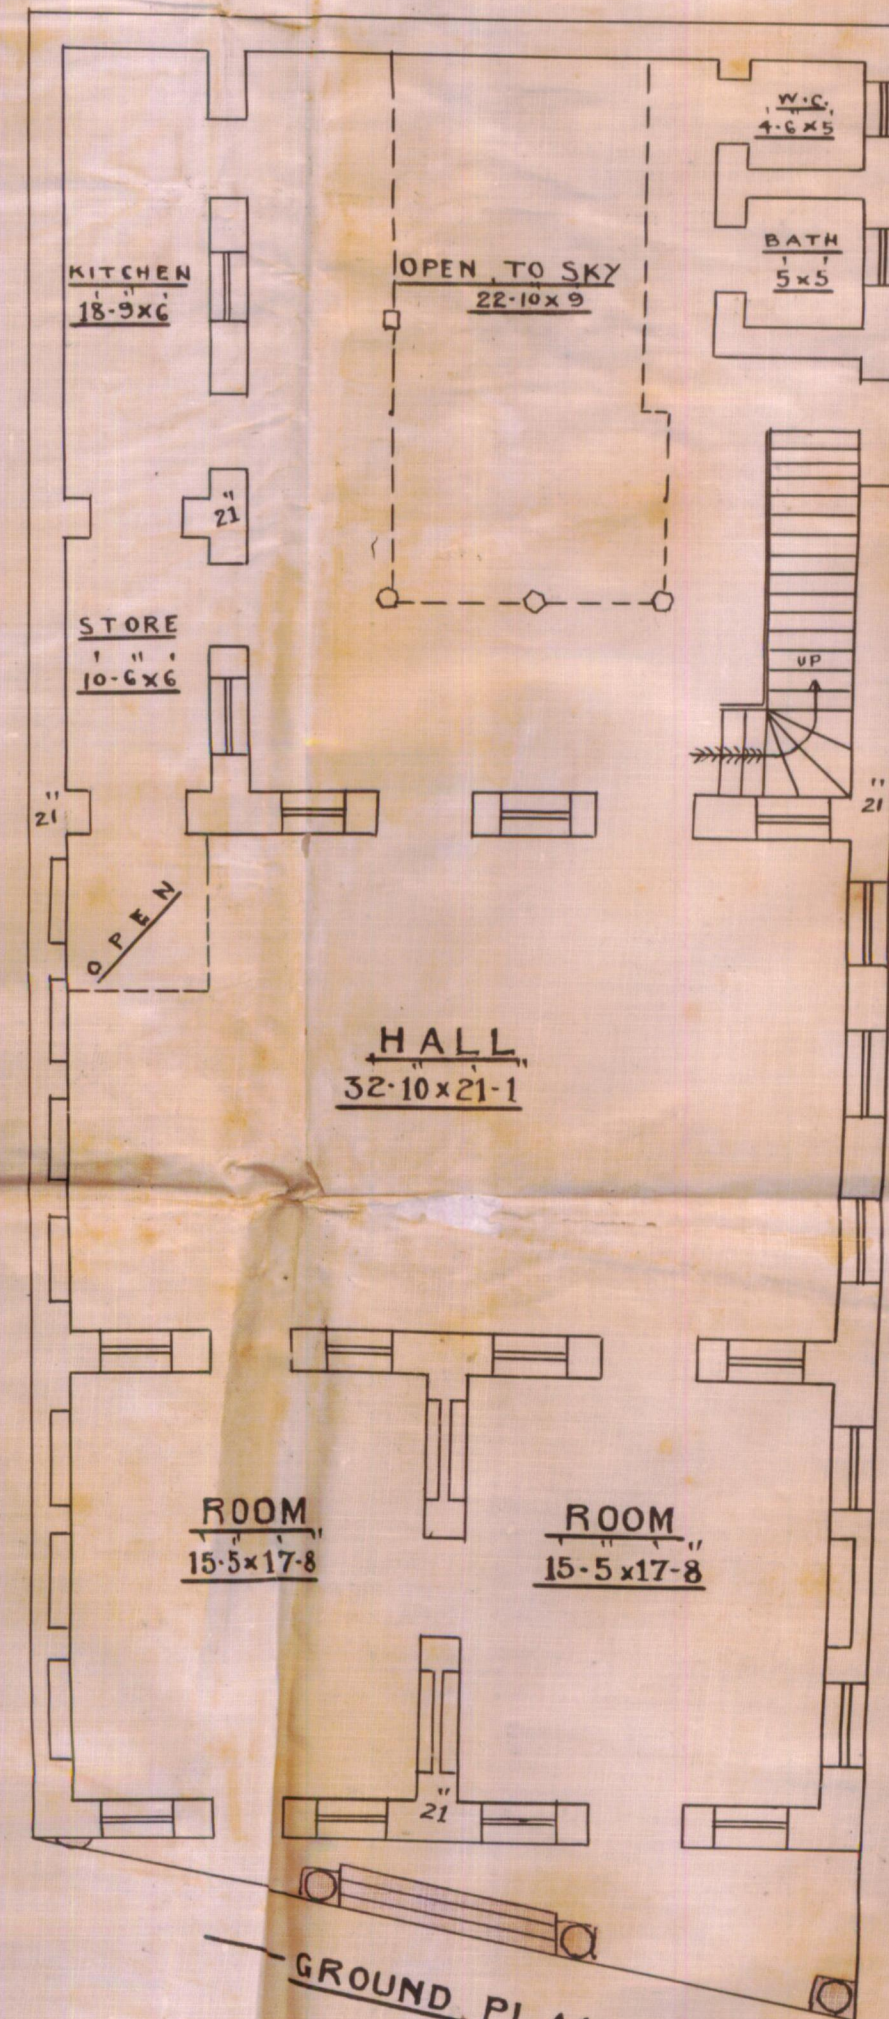

GROUND PLAN

ARCHITECT & SURVEYOR

PLAN SHOWING PROPOSED FRONT VERANDAH ON PLOT

Nº 116

Nº A-21


NAPIER Q<sup>E</sup>

APPROVED.

SCALE 8 TO 1

B. Sc., A. M. Inst. C. E.  
Land Manager & Architect.

15/11/29

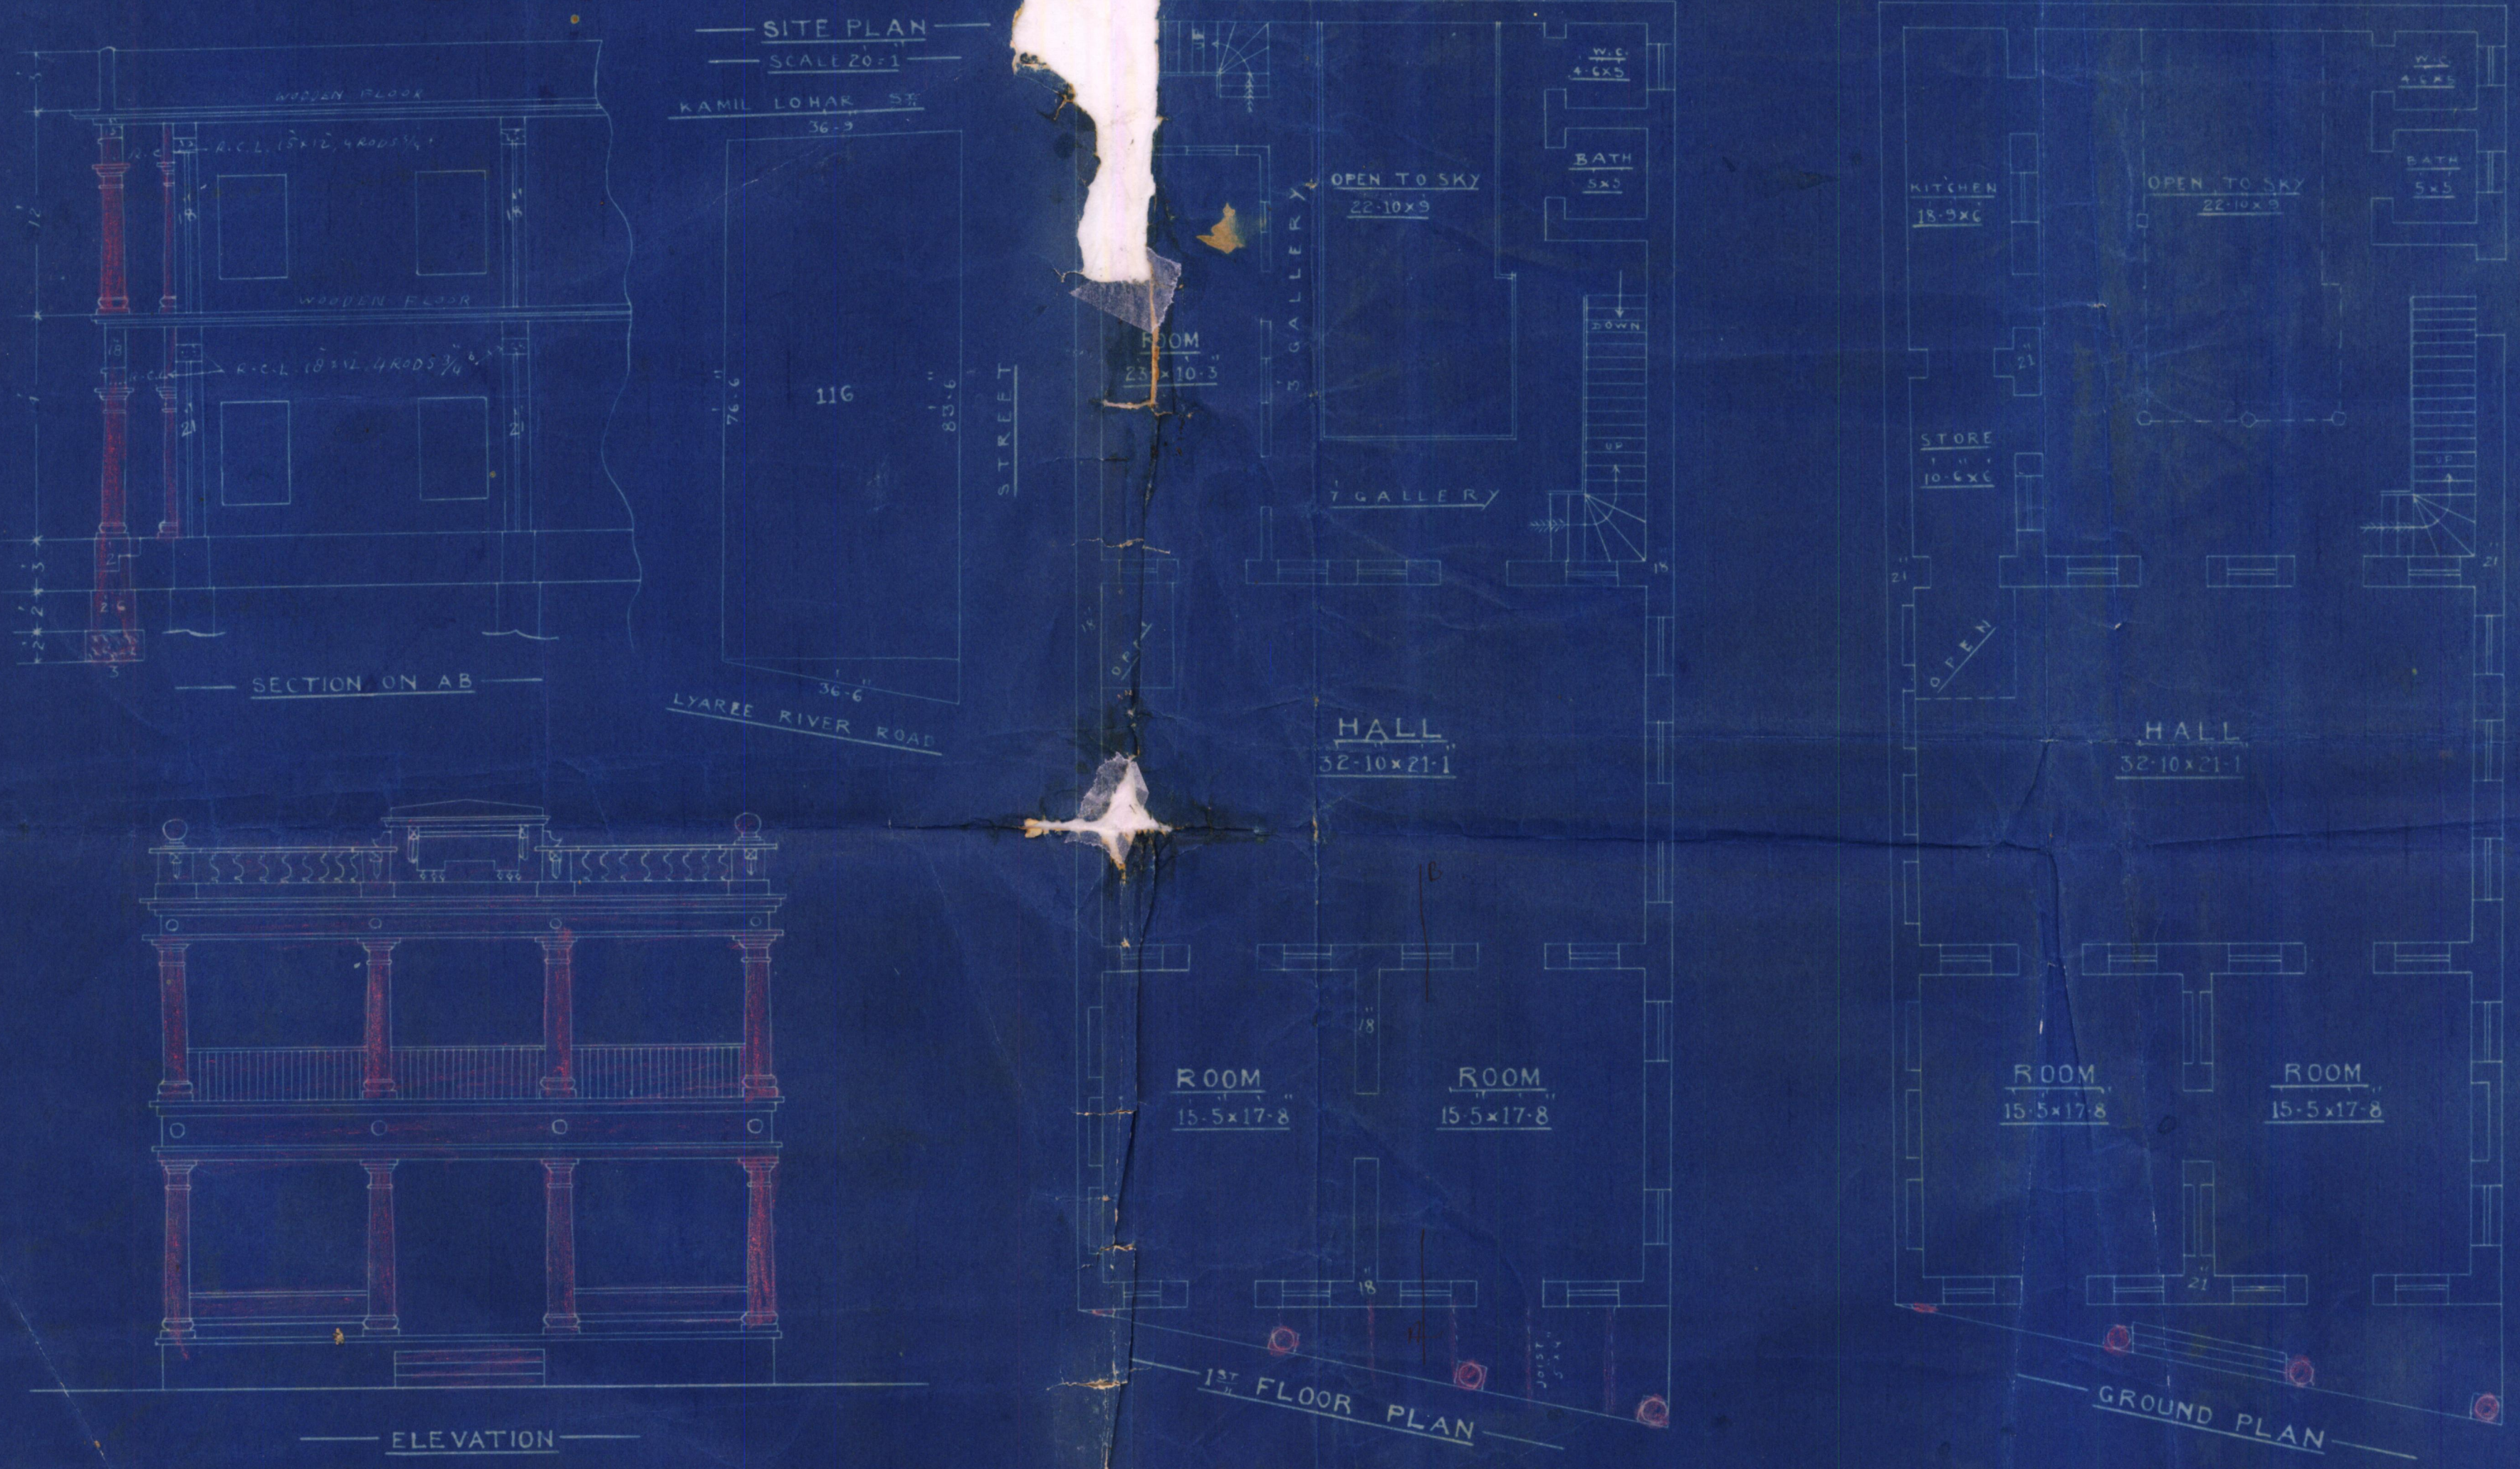

ELEVATION

1<sup>ST</sup> FLOOR PLAN

GROUND PLAN