


PLAN OF PROPOSED ON PLOT NO 3-K-I-2 GARDEN


Scale 8"=1'

193


FRONT ELEVATION

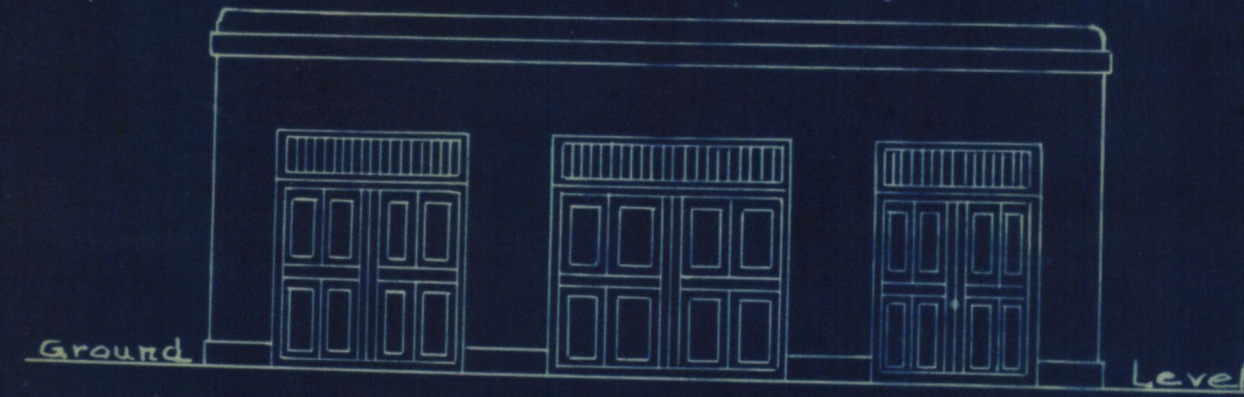


PLAN

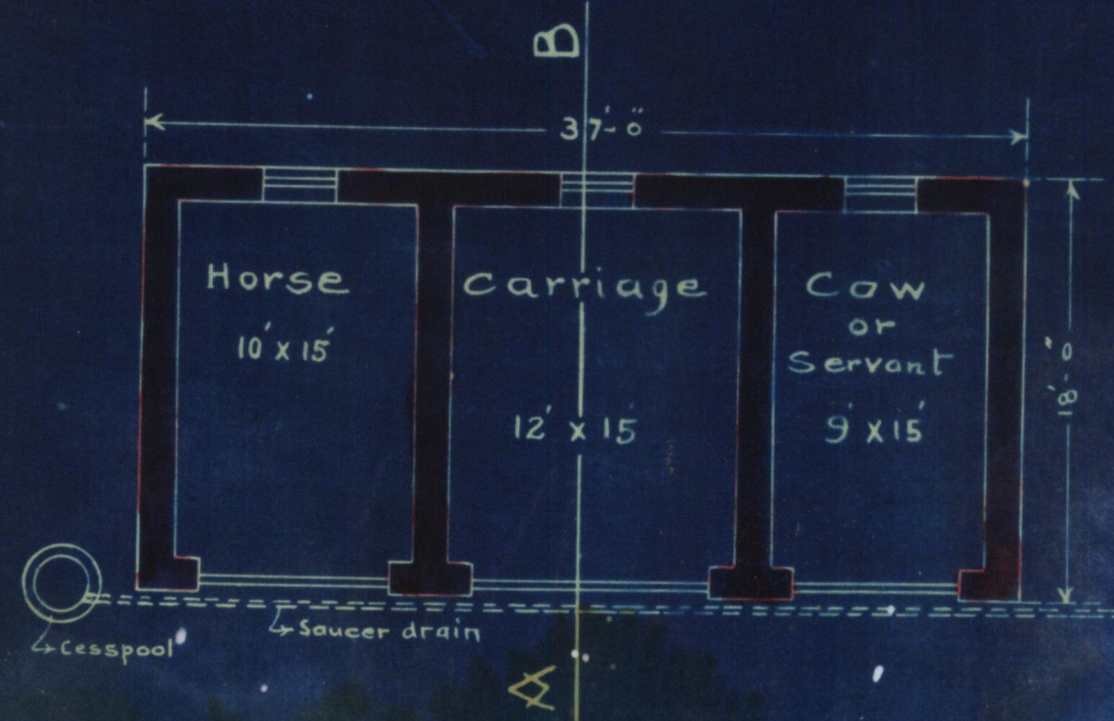



SECTION ON A-B

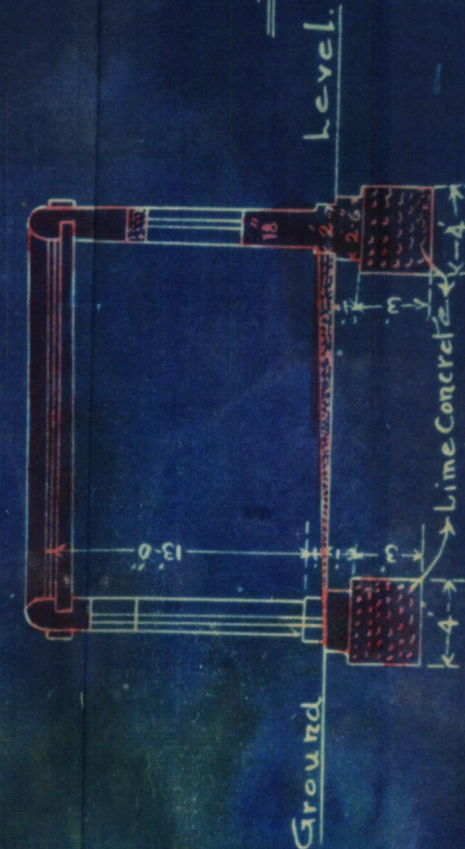

PLAN

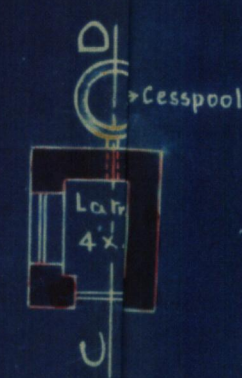


SECTION ON C-D

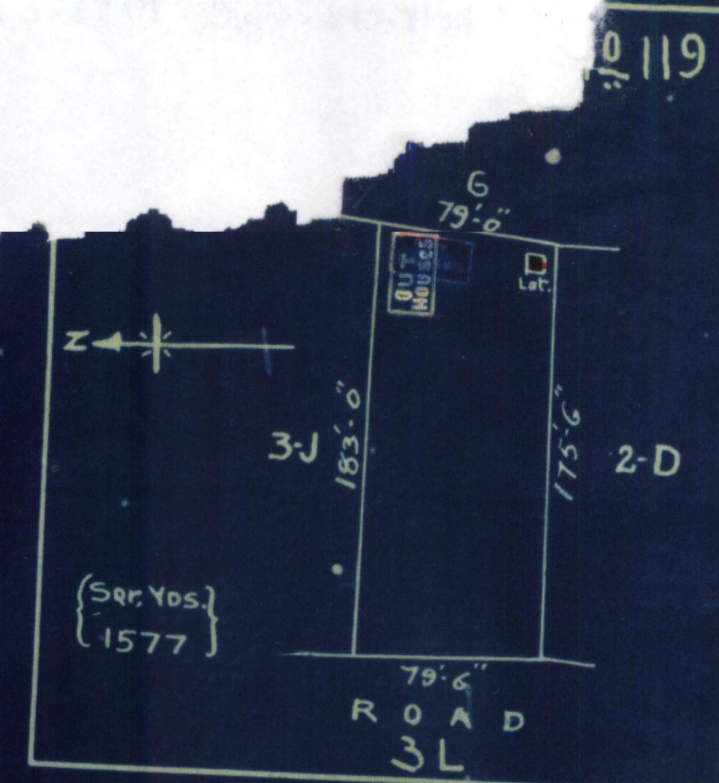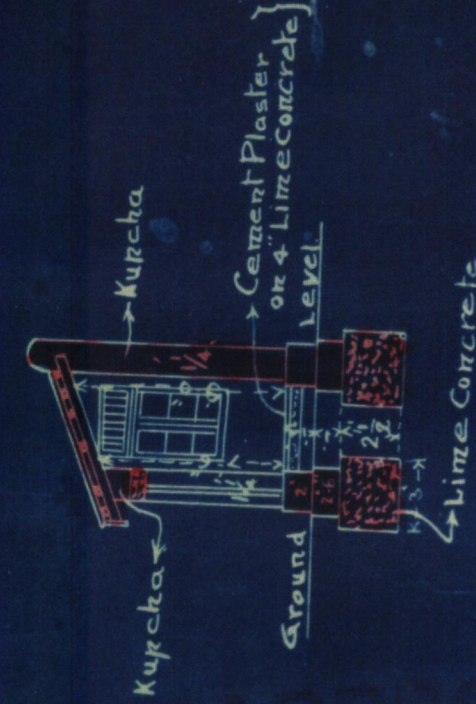


APPROVED

Architect

AMENDED PLAN ON PLOT No. 3 GARDEN QUARTER. Scale 8"=1'

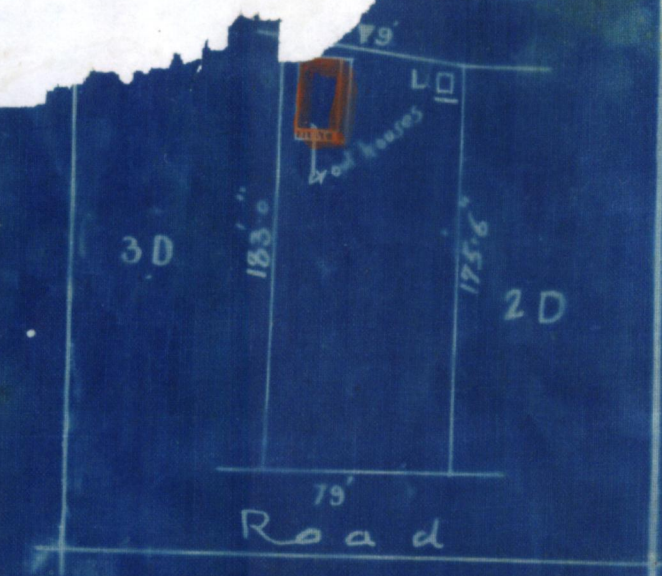


FRONT ELEVATION

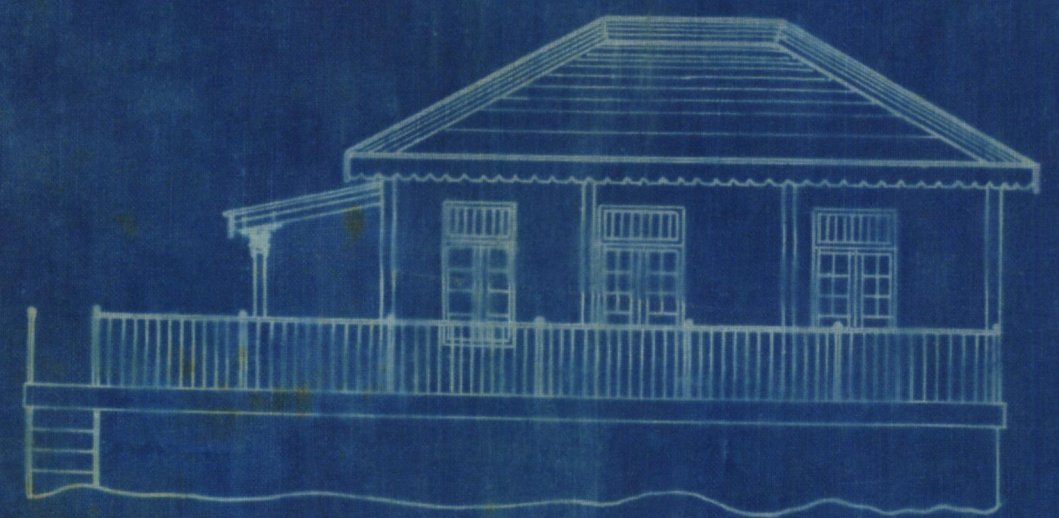


Total Area = 587 yds
Area under construction = 283 5.40%

FIRST FLOOR

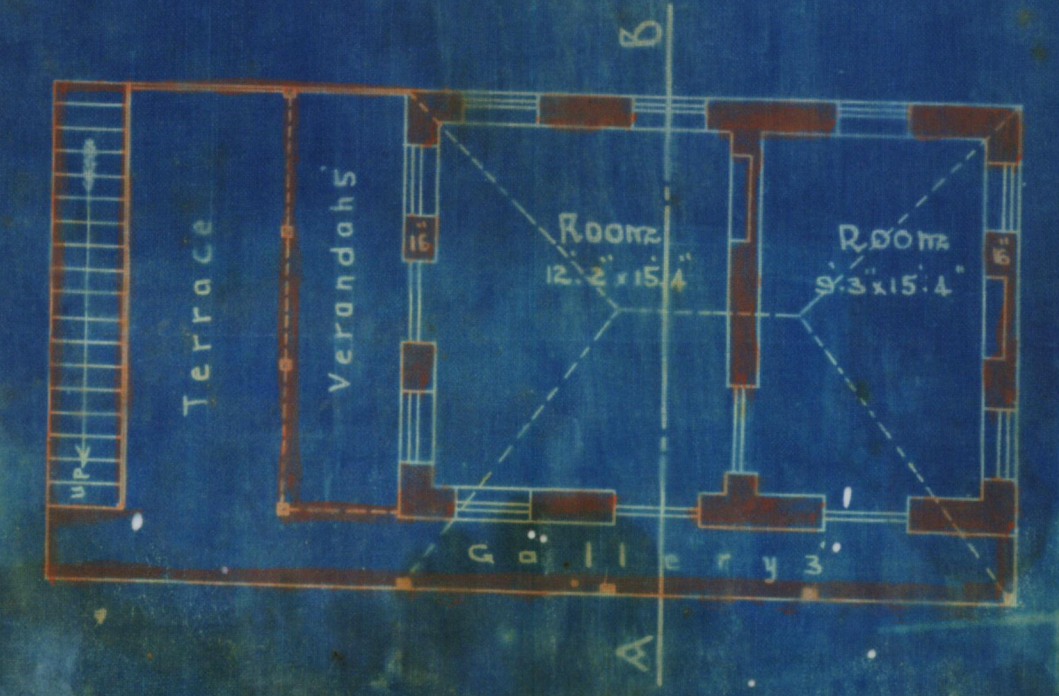


SECTION ON A.B.

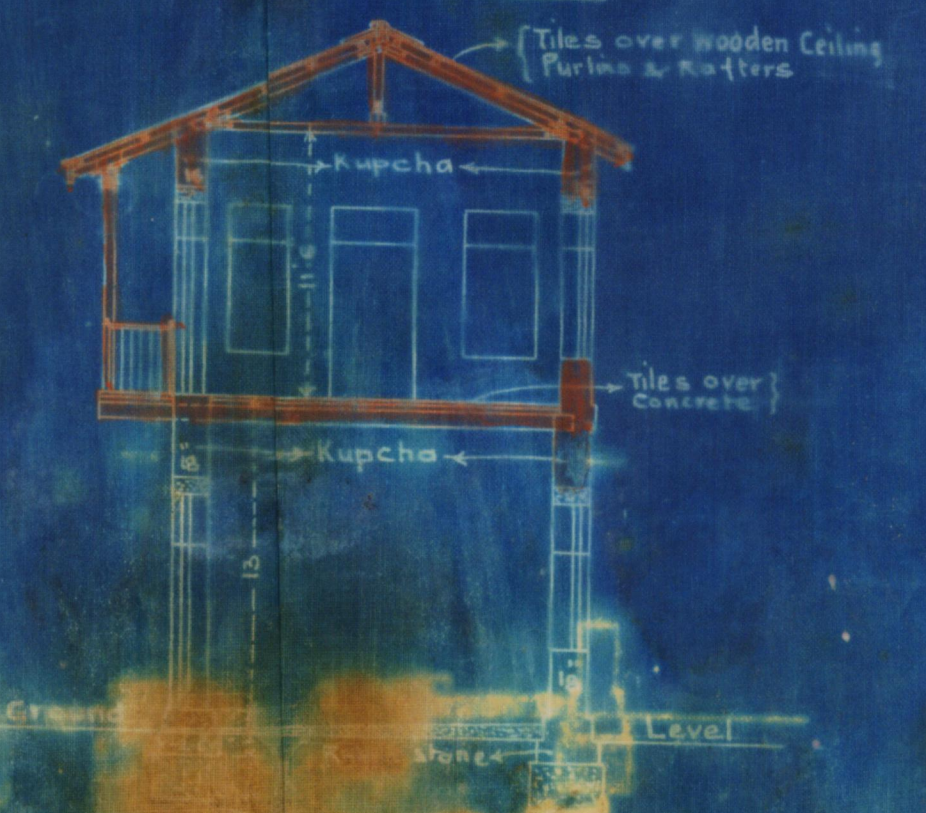

OWNER

ARCHITECT

AMENDED PLAN ON PLOT NO 3-K GARDEN QUARTER. Scale 8"=1"

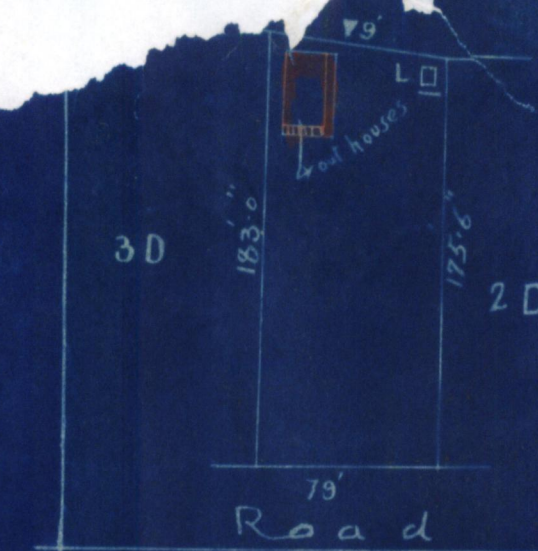


FRONT ELEVATION




Total Area = 58.3 s. yds.
Area under construction = 58.3 s. yds.

APPROVED
H. M. B. B.

FIRST FLOOR

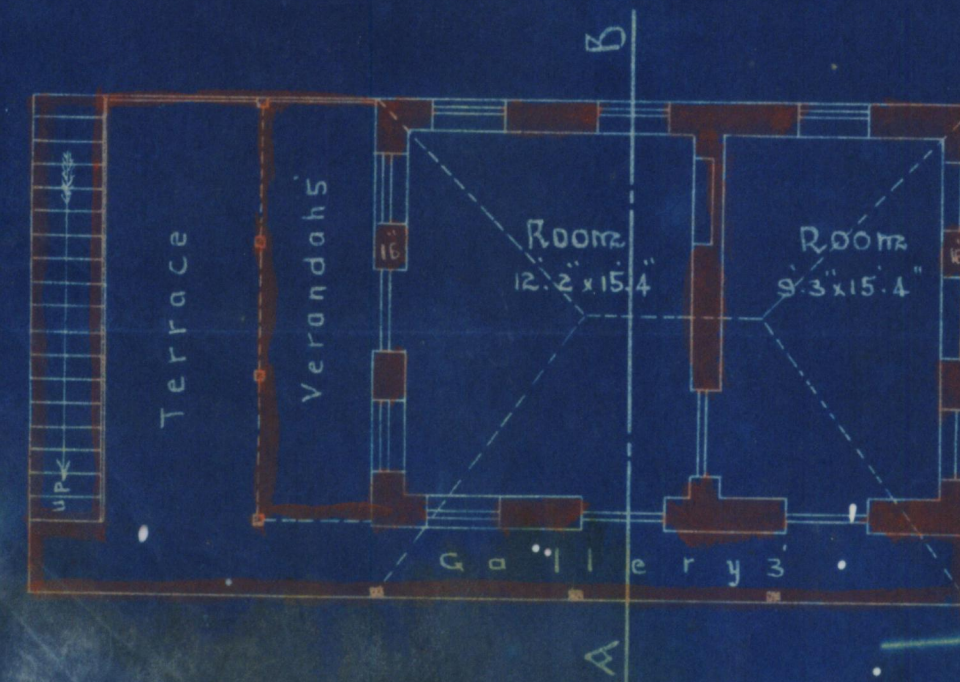

SECTION ON A.B.

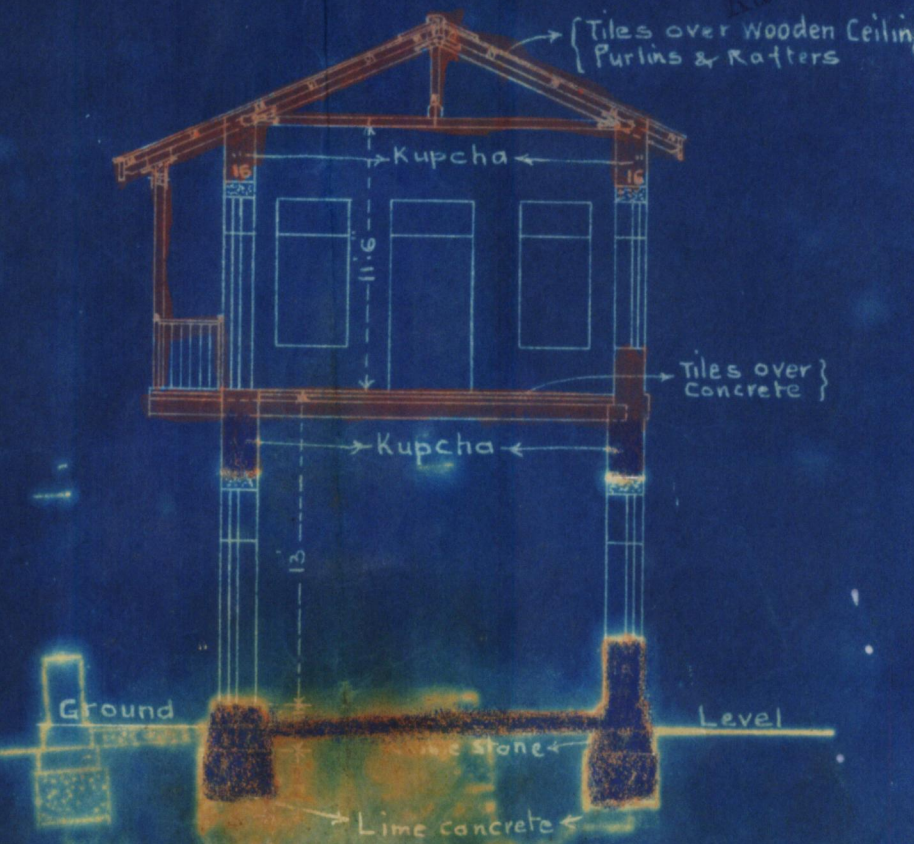

OWNER

ARCHITECT.