



Heritage

KMR.CDD.NaQ.1921.04

Form No. 31-300-15.10.20.

No. L. S.

of 1920.

MUNICIPAL OFFICE,

Karachi, 25th May 1921.

MEMO:



Building Completion Report.

MUNICIPAL OFFICE,

Karachi, 26th May 1921.
31

To

THE ENGINEER,

KARACHI MUNICIPALITY.

SIR,

I beg to report, the building work on plot No. 57 ALL Sheet
Qapri Quarter owned by Mr. Vinudas Fatschani
Bunamal
is completed according to the plan approved by the Municipality. Orders are
requested to file the correspondence.

Yours obediently,

Building Surveyor " " Section,
Karachi Municipality.copy to be
file

M. C. A.

Karachi Municipality



Form No. 6-300-20

No. L. S. 8585 OF 1921

MUNICIPAL OFFICE,

Karachi, 11 2 1921

MEMO:

Building Surveyor Section B is informed
that Mr. Techandus Dewan has been permitted
to build
his house
on plot No. 57 Ass Nap Street
Nap Quarter report should be made to the
Undersigned when the house is completed.


D. Banington Brown

M. I. MEER, E.,

Ag. Engineer,
Karachi Municipality.




EAST ELEVATION

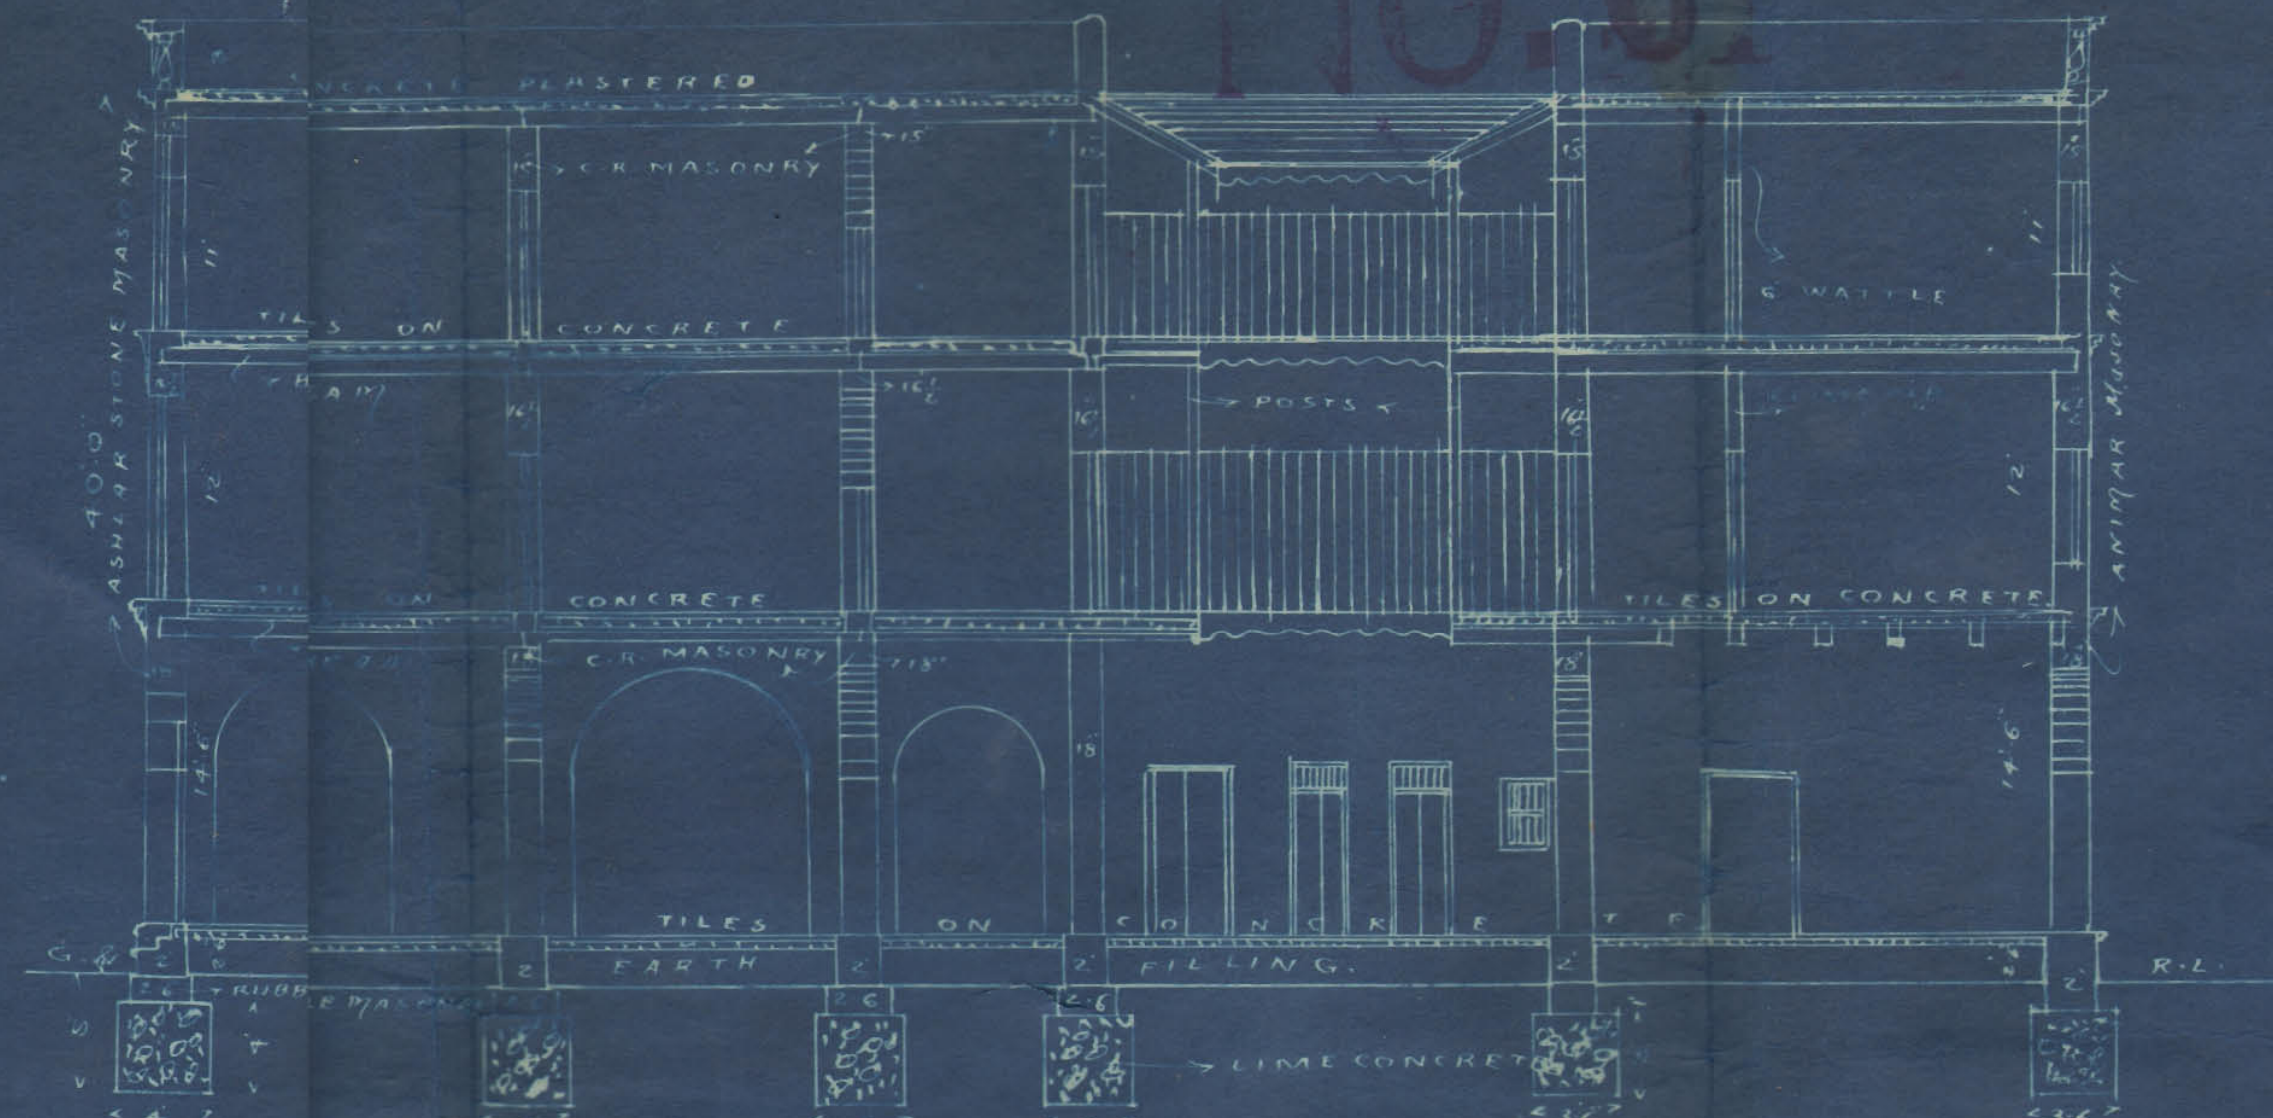


SECTION ON A-B

AMENDED PLAN OF PROPOSED BUILDING
ON PLOT NO. 57-A-28-NAPIER Q.B.

SCALE 1/2" = 1'

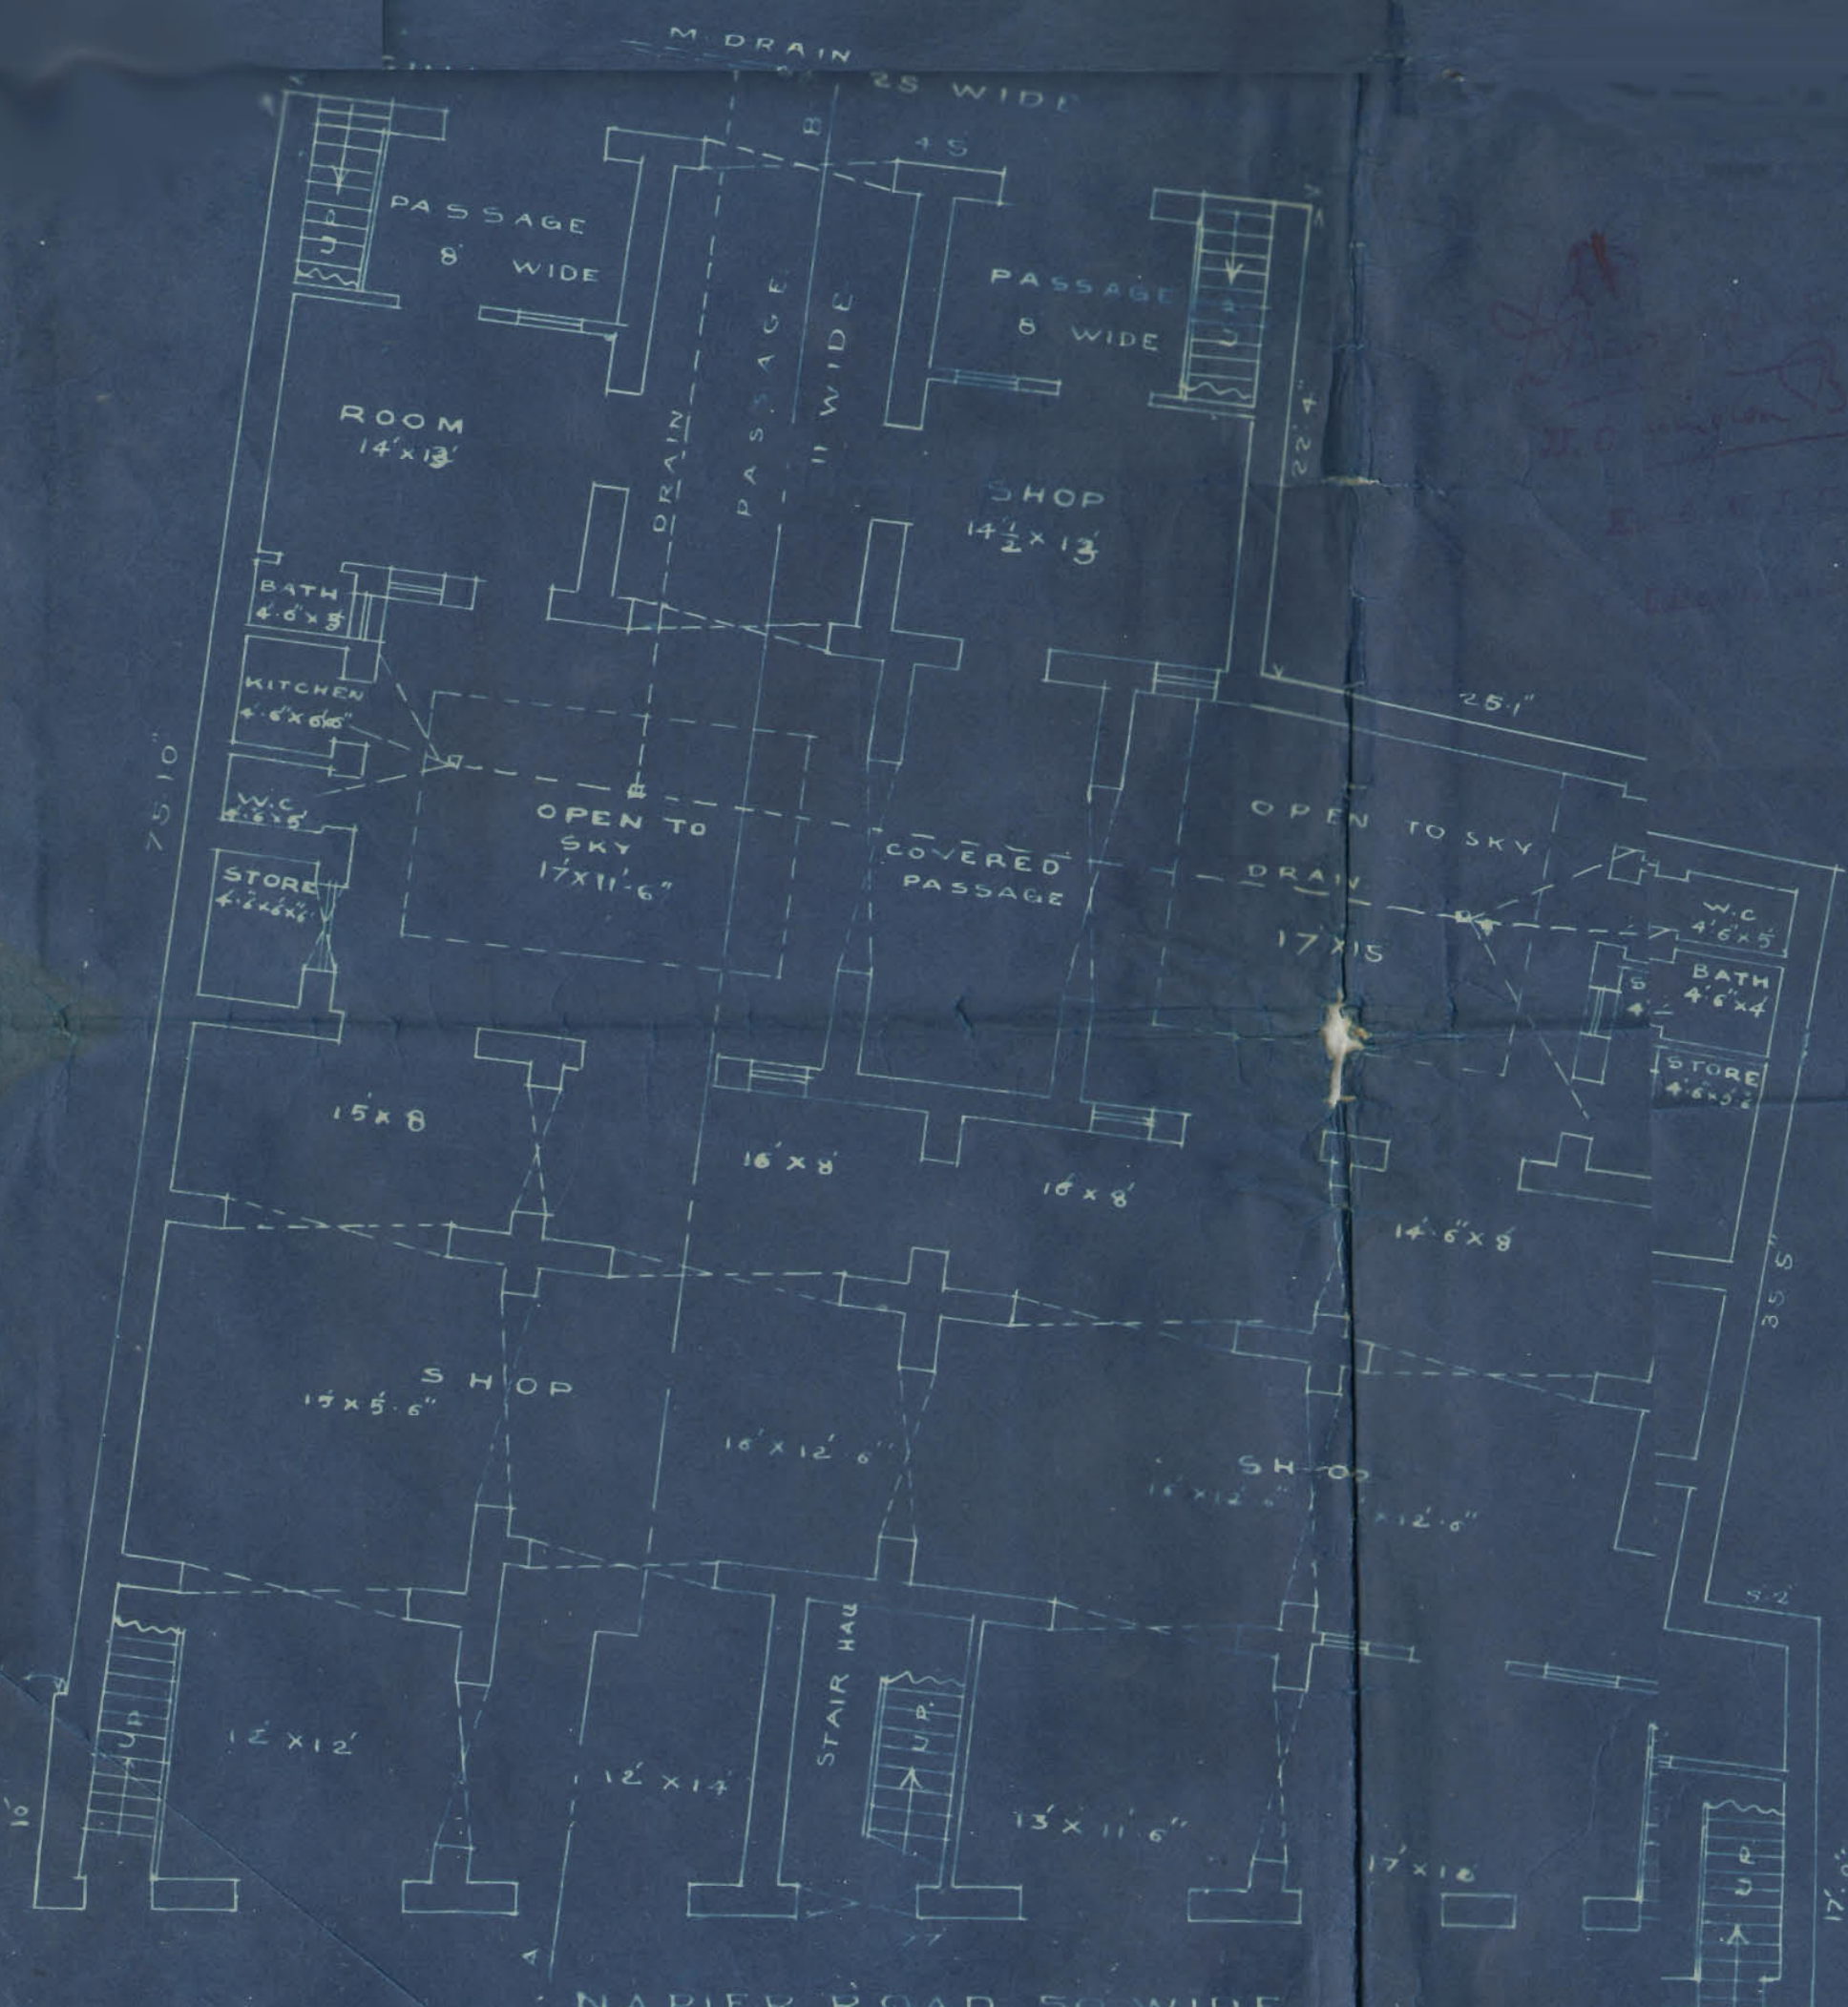

PLAN OF GROUND FLOOR

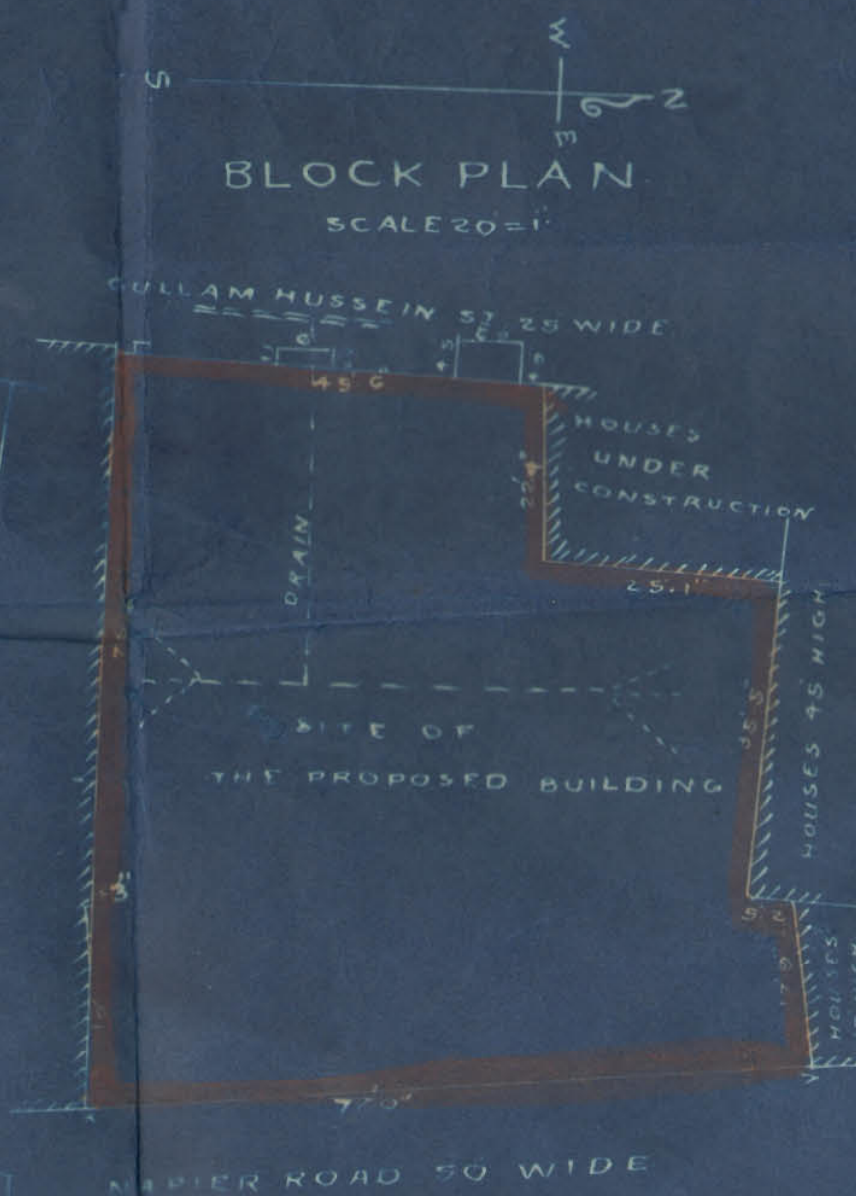

BLOCK PLAN
SCALE 1/20" = 1'