



Department.

FILE No.

of 1932.

SECTION

PART

Disposal No.

P. 67-3/20

3

Subject

+50.

+28

128.

S. R. 9

General

NOTE :—Former Correspondence filed in

• file

Compilation No.

Subsequent Correspondence filed in

file

Compilation No.

FORM A.

NOTICE UNDER SCHEDULE VI CHAPTER XI, RULE 2 (I) OF
THE CITY OF KARACHI MUNICIPAL ACT 1933.

Karachi 8/12/11/34

Date of delivery at Municipal Office

To,

THE CHIEF OFFICER,

MUNICIPAL CORPORATION,

Dear Sir,

KARACHI.

Pursuant to the provision of Schedule VI, Chapter XI, Rule (1) of the City of Karachi Municipal Act 1933, I hereby give you notice that I intend with the meaning of that rule to erect a building on plot No. 127 Survey Sheet S.R. 5 Situated in Narain street Serai Quarter as per Ground plan, Elevation and Section sent herewith in quadruplicate,

The said building will be of the following description,

It is intended for the purpose of Add: & alterations.

†Specification of the work will be as follows:—

*I also submit herewith a certificate from the Electrical Inspector to Government as required under Rule 92 (3) of the Indian Electricity rules.

I further beg to inform that the name of the person whom I intend to employ to supervise the erection of the said building is M/s. M. Khimji & Co.

I hereby make take to abide by the City of Karachi Municipal Act 1933, and all rules and bye-laws framed pursuant to the Act.

Yours faithfully,

Signature of the owner

Matiram Inwarani
or Chetihai Matiram

Address of the owner

M. KHIMJI & CO.
ARCHITECTS.

†See on the reverse.

*This line to be struck off if there is no electric line passing by the plot.



Heritage

KMR.CDD.SeQ.1934.06

2

Nature of soil in foundation ExistingNature of masonry in foundation dodo Plinth dodo Superstructure Chimney MasonryKind woodwork in trusses, post, etc. P.T. & plywoodKind of Roof a.c.c. RoofKind of Floor Cement & brick flooringMethod of Drawing Sullage Water n/c

—:0:—

NOTE:—Specification and nature of work should be given against items of work mentioned above.

Karachi 17/11/34

To,

The Chief Officer,

Municipal Corporation,

Sir,

Karachi.

With reference to the notice under Schedule VI, Chapter XI, Rule (2) 1 of the City of Karachi Municipal Act 1933, submitted to you by Mr.

M. Khan Jewaram for Add: & alterations
for the building in Plot no 129 S-27, Sirai @ R!

I beg to inform you that I have agreed to supervise the erection of building work mentioned therein,

I beg to remain,

Sir

Your most obedient Servant.

M KHIMJI & Co
ARCHITECTS.

Licensed Surveyor.

S. S. (A) } 400-2-34.
600-6-34.



Heritage

KMR.CDD.SeQ.1934.06

No. B. S. P. 673/34

MUNICIPAL CORPORATION
KARACHI.

15 FEB 1935

From

KUMBERALI BHALEDINO Esq., L.C.E.

Land Manager & Architect,

ORDER UNDER SCH. VI CHP. XI, RULE 5 (I) OF
ACT XVII OF 1933.

Mrs. Chetibai Motiram

c/o M/s M. Khimji (Architects)

KARACHI.

With reference to your application with plan for building
on plot No. 129/1 & Sheet No. S.R. 9 Serai Quarter received in this
office on 19. 11. 1934, I have to inform you that the said plan is
approved and permission to build in accordance therewith is hereby granted.
The building must be erected in conformity with the Bye-laws and rules of
the Karachi Municipal Corporation.

A copy of approved plan is attached herewith.

2
Land Manager & Architect,
Karachi Municipal Corporation.

NOTICE, 1:—This sanction holds good, provided the work of construction is commenced in earnest within a year from this date, whereafter the sanction will be deemed to have lapsed.

NOTICE, 2:—This sanction does not entitle the owner to build on land not conveyed to him either by the Government or the Municipality by a Sanad or entry in a Sanad.

NOTICE, 3:—This pass does not give permission to occupy Municipal land with building materials. This can only be allowed when the Street is wide enough to permit building materials being deposited on it without it being a source of danger to the public and only then on a hoarding placed round the land to be occupied and on payment in advance, of fees for occupation of Municipal land, at the following rates.

(1) For first 12 weeks, per square yard per diem	... Rs. 0 0 3½
(2) For the next 12 weeks, " "	... " 0 0 7
(3) For any subsequent time " "	... " 0 1 2

NOTICE, 4:—Windows, steps and doors of the building will not be permitted to project on or overhang public street or Municipal land.

NOTICE, 5:—Plinth cornice will not be allowed to project more than 2 inches on any Public street for ornamental purposes.

NOTICE, 6:—You are required to give timely intimation to the Land Manager and Architect before filling in the foundation and before concrete is filled in for Reinforced concrete work.

NOTICE, 7:—In case of set back or set forward, the first course of Plinths must be laid after the line is checked by the Land Surveyor.



Heritage

KMR.CDD.SeQ.1934.06

4-1

KARACHI MUNICIPALITY.**NOTES SECTION.***Building Department.*

Case No. P/C 673/34.

Applicant's Name

Chetnai Motiram.

Architect's Name

Mr. Khunji & Co.

EXTRACT FROM THE LAND REGISTER.

New plot No.

130/129.

Sheet No.

S. R. 9

Old plot No.

130

Sheet No.

} Serai

Quarter.

Whether under Govt. or
Municipal Control ...

Govt.

Registered Holder of
plot. ...

Fatehchand Singhania 6

Government ...

606

Area. Municipal ...

Total ...

606

Title and period of lease

99 years from 17-11-1914.

Form of lease

H/2/1 with new clauses

Any Special conditions of
lease ...

as

Remarks. ...

The above application with plans is forwarded with compliments to the Health Officer for favour of report.

Date of despatch

20/11/34

for Land Manager and Architect,
Karachi Municipality.**MUNICIPAL HEALTH OFFICER'S REPORT.**

Returned with compliments to the Land Manager and Architect, Karachi Municipality with the following Remarks:—

No objection

Municipal Health Officer

Health Officer.

129. S.R.9



Heritage

KMR.CDD.SeQ.1934.06

A copy of plan is herewith forwarded to Engineer for favour of remarks and return as early as possible.

Date of despatch 26/11/34

for Land Manager & Architect.

ENGINEER'S REMARKS.

No objection

26/11

Date 20/12

ENGINEER.

LAND SURVEYOR'S REPORT.

- (1) Does the plot come under Alignment? No alignment on this portion
- (2) Is the Alignment Correctly shown?
- (3) Are the Site Measurements correct?
- (4) Is there any encroachment? No
- (5) Is the plot affected by T. P. Scheme?
- (6) Is the plot subject to any conditions of previous sub-division and Amalgamation?

(1) Is the width of the road correctly shown (No)

Site measurements must be clearly & correctly shown -

- (2) There are two ditches in front of the plot
- (3) Whether the ditches were removed or were left as is

L.S.
For further action
PWP
5/12/34

in corrected

Side measurements must be corrected by the architect
Now
6/12/34
Land Surveyor.
25/1/35

129, S. R-9



Heritage

KMR.CDD.SeQ.1934.06

P-67313

3

BUILDING SURVEYOR'S REPORT.

Lined area for the Building Surveyor's Report.

Date _____

Building Surveyor,

Remarks of LAND MANAGER AND ARCHITECT.

Lined area for the Remarks of Land Manager and Architect.

Date _____

Land Manager and Architect.

Office Telephone Nos. 1140 & 1141.

Residence " " 199.

KUMBERALI BHALEDINO,

L. C. E.

LAND MANAGER & ARCHITECT



Heritage

5 KMR.CDD.SeQ.1934.06

MUNICIPAL CORPORATION

KARACHI.

Reference No. B. S. P673/34

18 DEC 1934

To,

Mr. Motiram Mewaram

c/o M. Khimji architect

Dear Sir,

With reference to your application dated _____
with a plan for the proposed building/additions and alterations on plot
No. 129, Survey Sheet No. 3.R.9, Serai _____ Quarter
I have to request you to comply with the following requirements:—

1. The plot has been ~~xxxxxxx~~ subdivided and therefore
the correct plot no. must be submitted when the
plans will be further dealt with.

After report on the correct plan.

3/1/35
H.D.

Plan check report if required correction are correctly made.
9/1/35

L.S.

- (1) The side measurements are found correct except the Dicky measurements
- (2) Plot Numbers require to be correctly shown as per sanctioned sub-division plan

Plot No. as per sub division must be given on the plan
2) Measurements of distance must be given
9/1/35
10/1/35
4.3

The plans are returned herewith rejected.

Submits

Yours faithfully

As object may be communicated

There is no other objection

18/12
Land Manager & Architect.

20 do so
15/7/1

12/7



Heritage

KMR.CDD.SeQ.1934.06

M Khimji & Co.,

No.

of 193

ENGINEERS, ARCHITECTS

&

SURVEYORS.

— 0 : —

LAND MANAGER &
ARCHITECTS DEPT
KARACHI MUNICIPALITY

20. DEC. 1934

No.

WATER COURSE ROAD,

1934

To,

The Land Manager, & Architect.
Karachi of Municipal Corporation.
Karachi.

Dear Sir,

With ref: to your no. B.S.P. 673/34
 Dated 18/12/34 we have the honor
 to hand you herewith corrected
 copies of plan for Building on plot
 no. 129/c. + 129/d. Sheet S.R. 9. Sera
 Quater as desired.

The favour of early disposal
 is requested.

Yours Faithfully,
 Gulshan AliM KHIJJI & CO
ARCHITECTS

for attachment
 20/12/34

10/12/34
 21/12/34

Office Telephone Nos. 1140 & 1141.

Residence „ „ 199.

KUMBERALI BHALEDINO,

L. C. E.

LAND MANAGER & ARCHITECT



Heritage

KMR.CDD.SeQ.1934.06

MUNICIPAL CORPORATION

KARACHI.

Reference No. B. S. P. 673/34

17 JAN 1935

To,

M/s M. Khimji, Architect

Dear Sir,

With reference to your application dated 20-12-34
with a plan for the proposed building/additions and alterations on plot
No. 129, Survey Sheet No. 3.B.9, Serai Quarter
I have to request you to comply with the following requirements:—

1. Plot no. as per subdivision must be given on the plan.
2. Measurements of dickies must be given.

17-1-35

The plans are returned herewith rejected.

Yours faithfully

Kumberali Bhaledino

17/1

Land Manager & Architect.

B. S. 24

2000-11-34



Heritage

KMR.CDD.SeQ.1934.06

OF 193

Khimji & Co.
ENGINEERS, ARCHITECTS

LAND MANAGER No.
ARCHITECT'S DEPTT.
KARACHI MUNICIPALITY
21 JAN 1935
Karachi, 21/1/1935
No.

WATER COURSE ROAD,

SURVEYORS

—:0:—

To,

The Land Manager,
Karachi Municipality.
Karachi.

Dear Sir,

Plot No. as per
sanctioned sub division
map shown
correctly
25/1

With ref: to your no. B.S.P. 673/34
dated 17 January 1934. We beg to return

The plans for Building on plot no.
129/c & 129/d Sheet S.R. 9. Serai
Quarter duly corrected as desired.

26/1

The favour of early approval is
requested.

Put up with file
24/1/35

Yours Faithfully,
M. Khimji & Co.
ARCHITECTS.

(1) Dicky measurements
are shown by the architect


(2) Plot Numbers are not correctly
shown as per sanctioned sub-division

As for report
23/1

AMC.
25/1/35



TOP FLOOR PLAN.

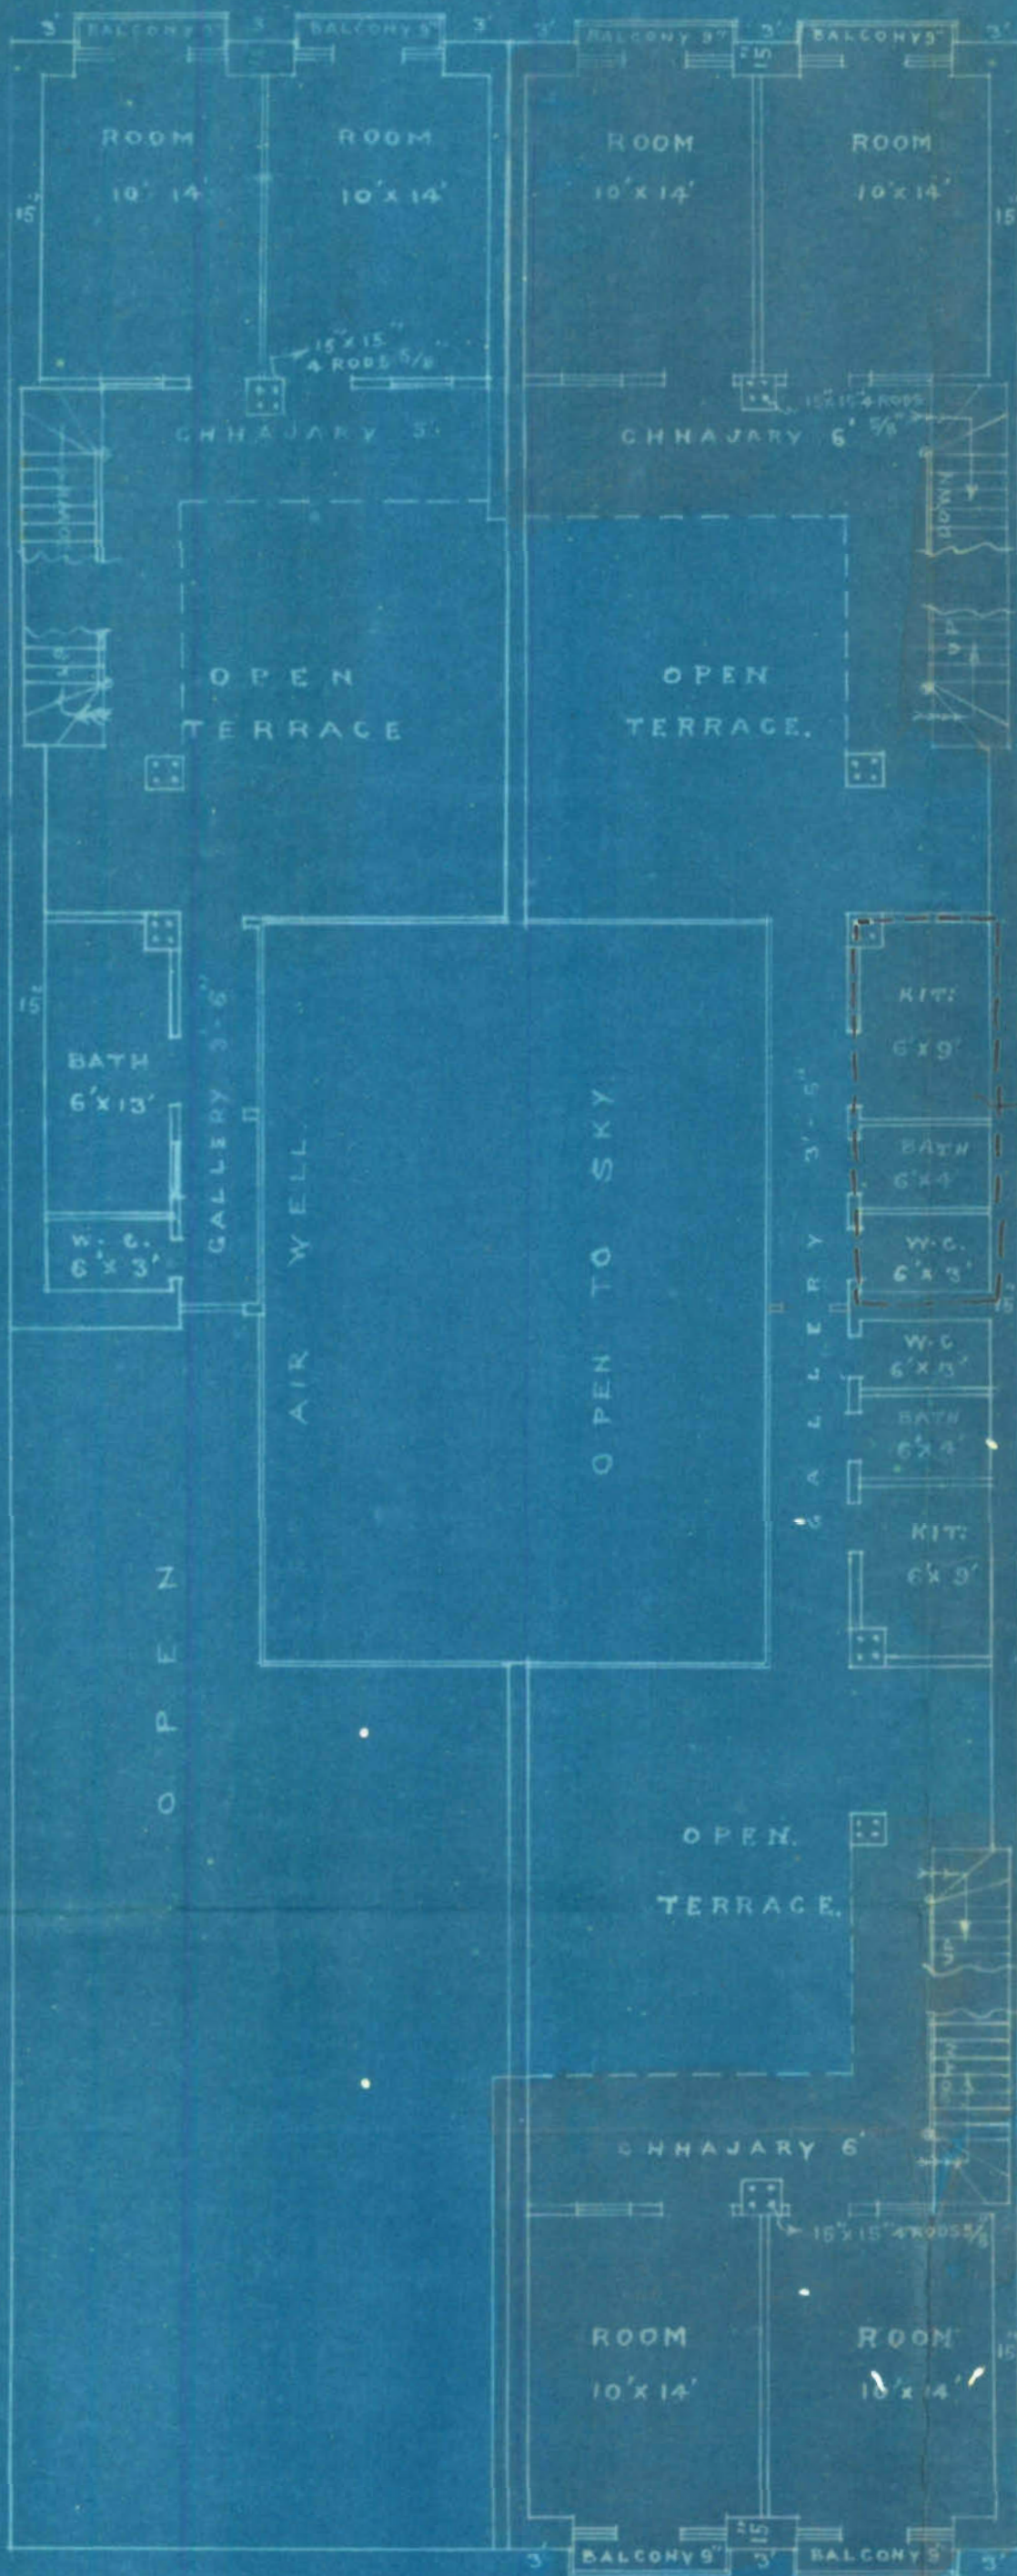

Gobindlal Nounitram Nungia

OWNER.

M. Khimji & Co.

ARCHITECTS.

DETAIL OF R.C.C. BEAM A (16'x8')



—AMENDED PLAN—

—SHOWING PROPOSED BUILDING—


129/23-129/24

—ON PLOT NO 129 S.R. 3—

—SERAI QUARTER—


—SCALE: 8"=1'—

BELLASIS STREET

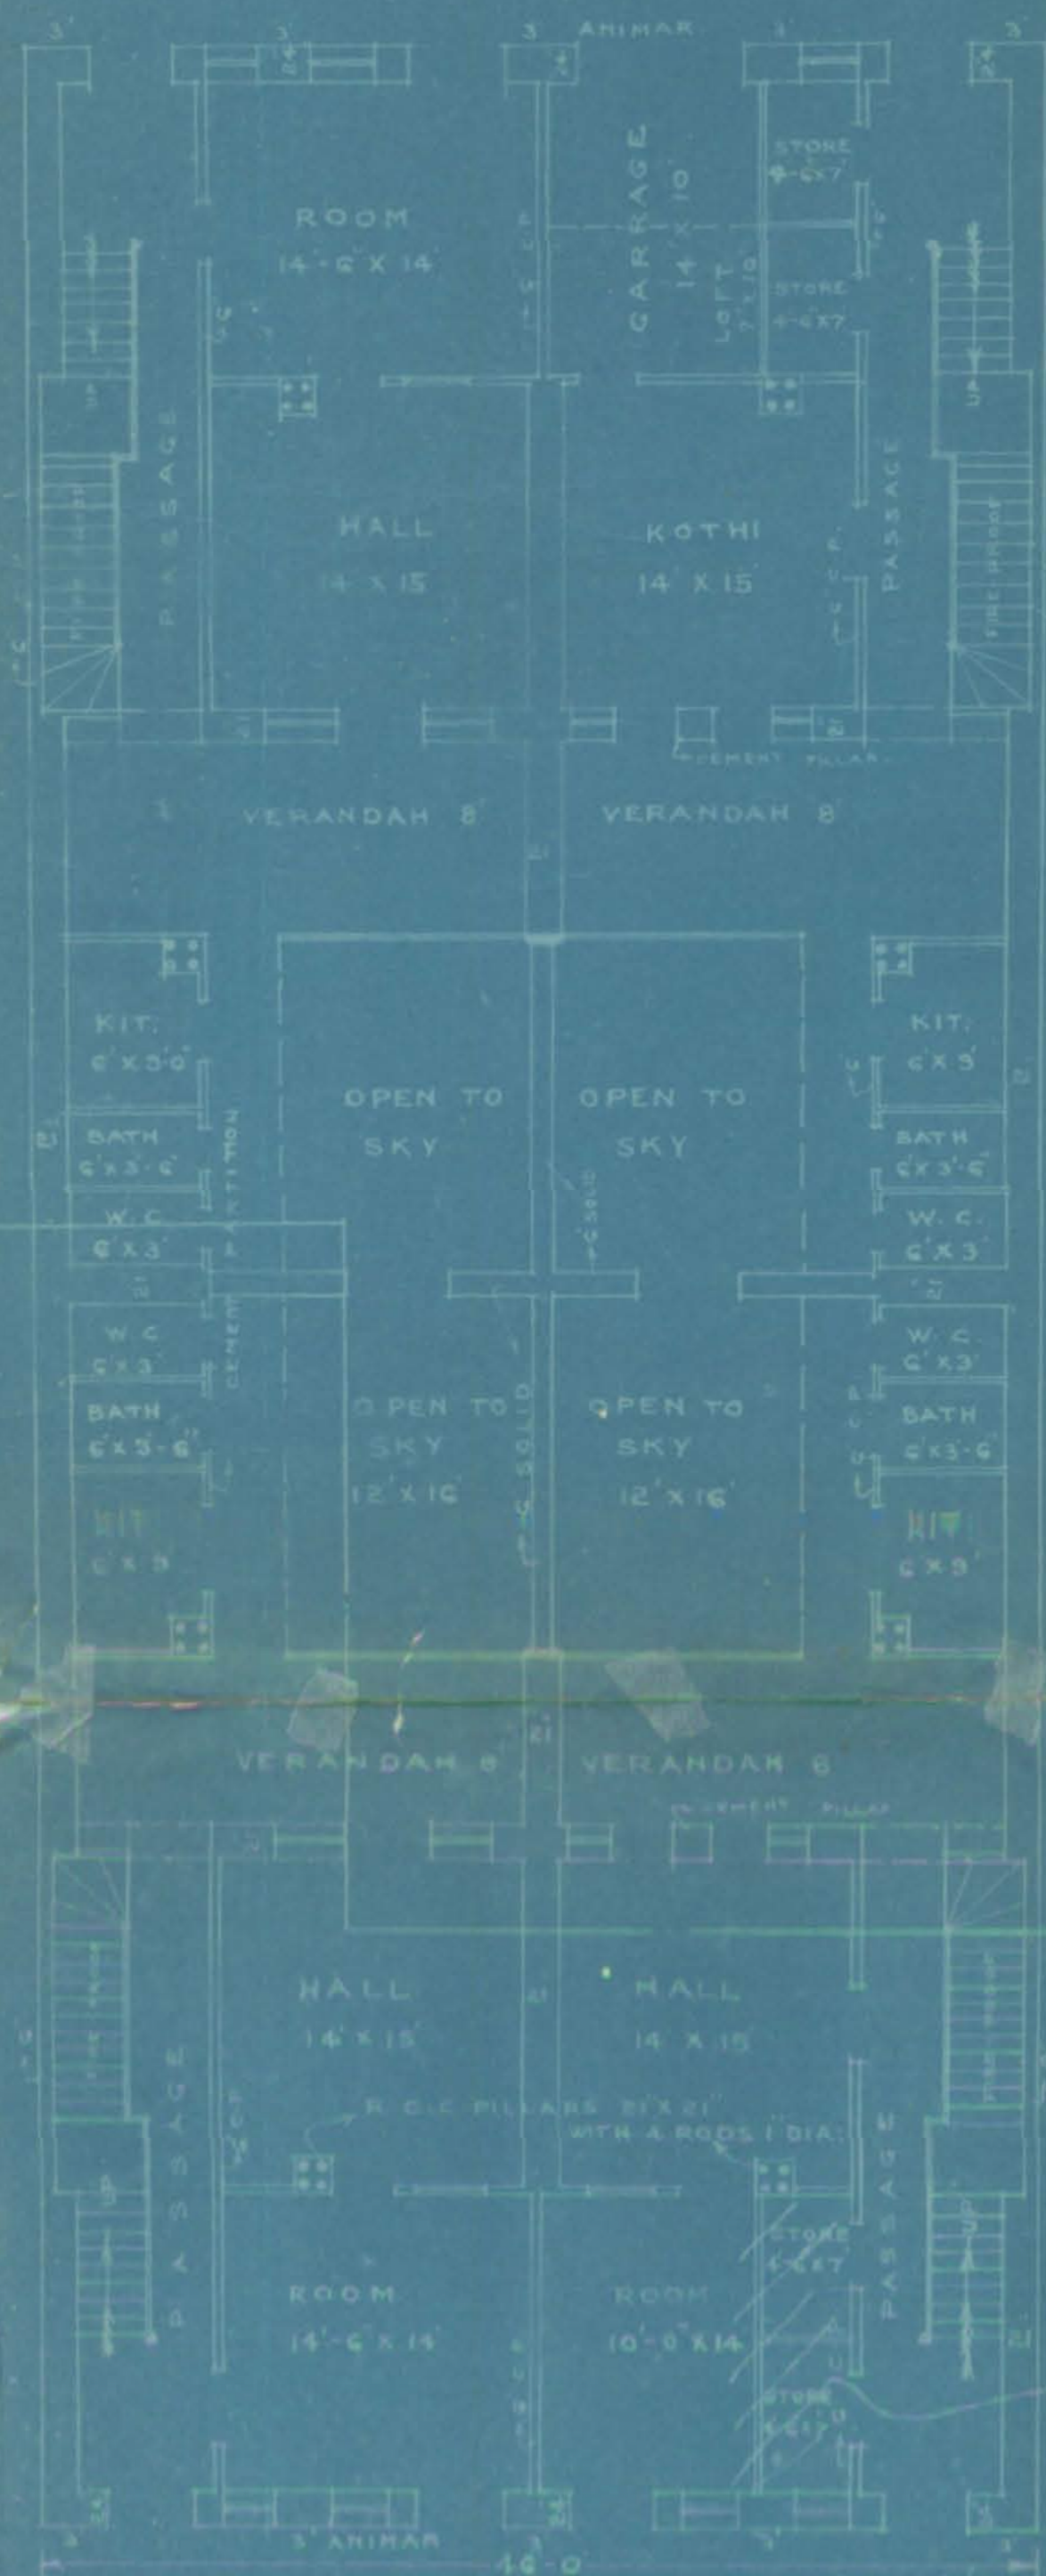


NARAIN STREET


GROUND FLOOR

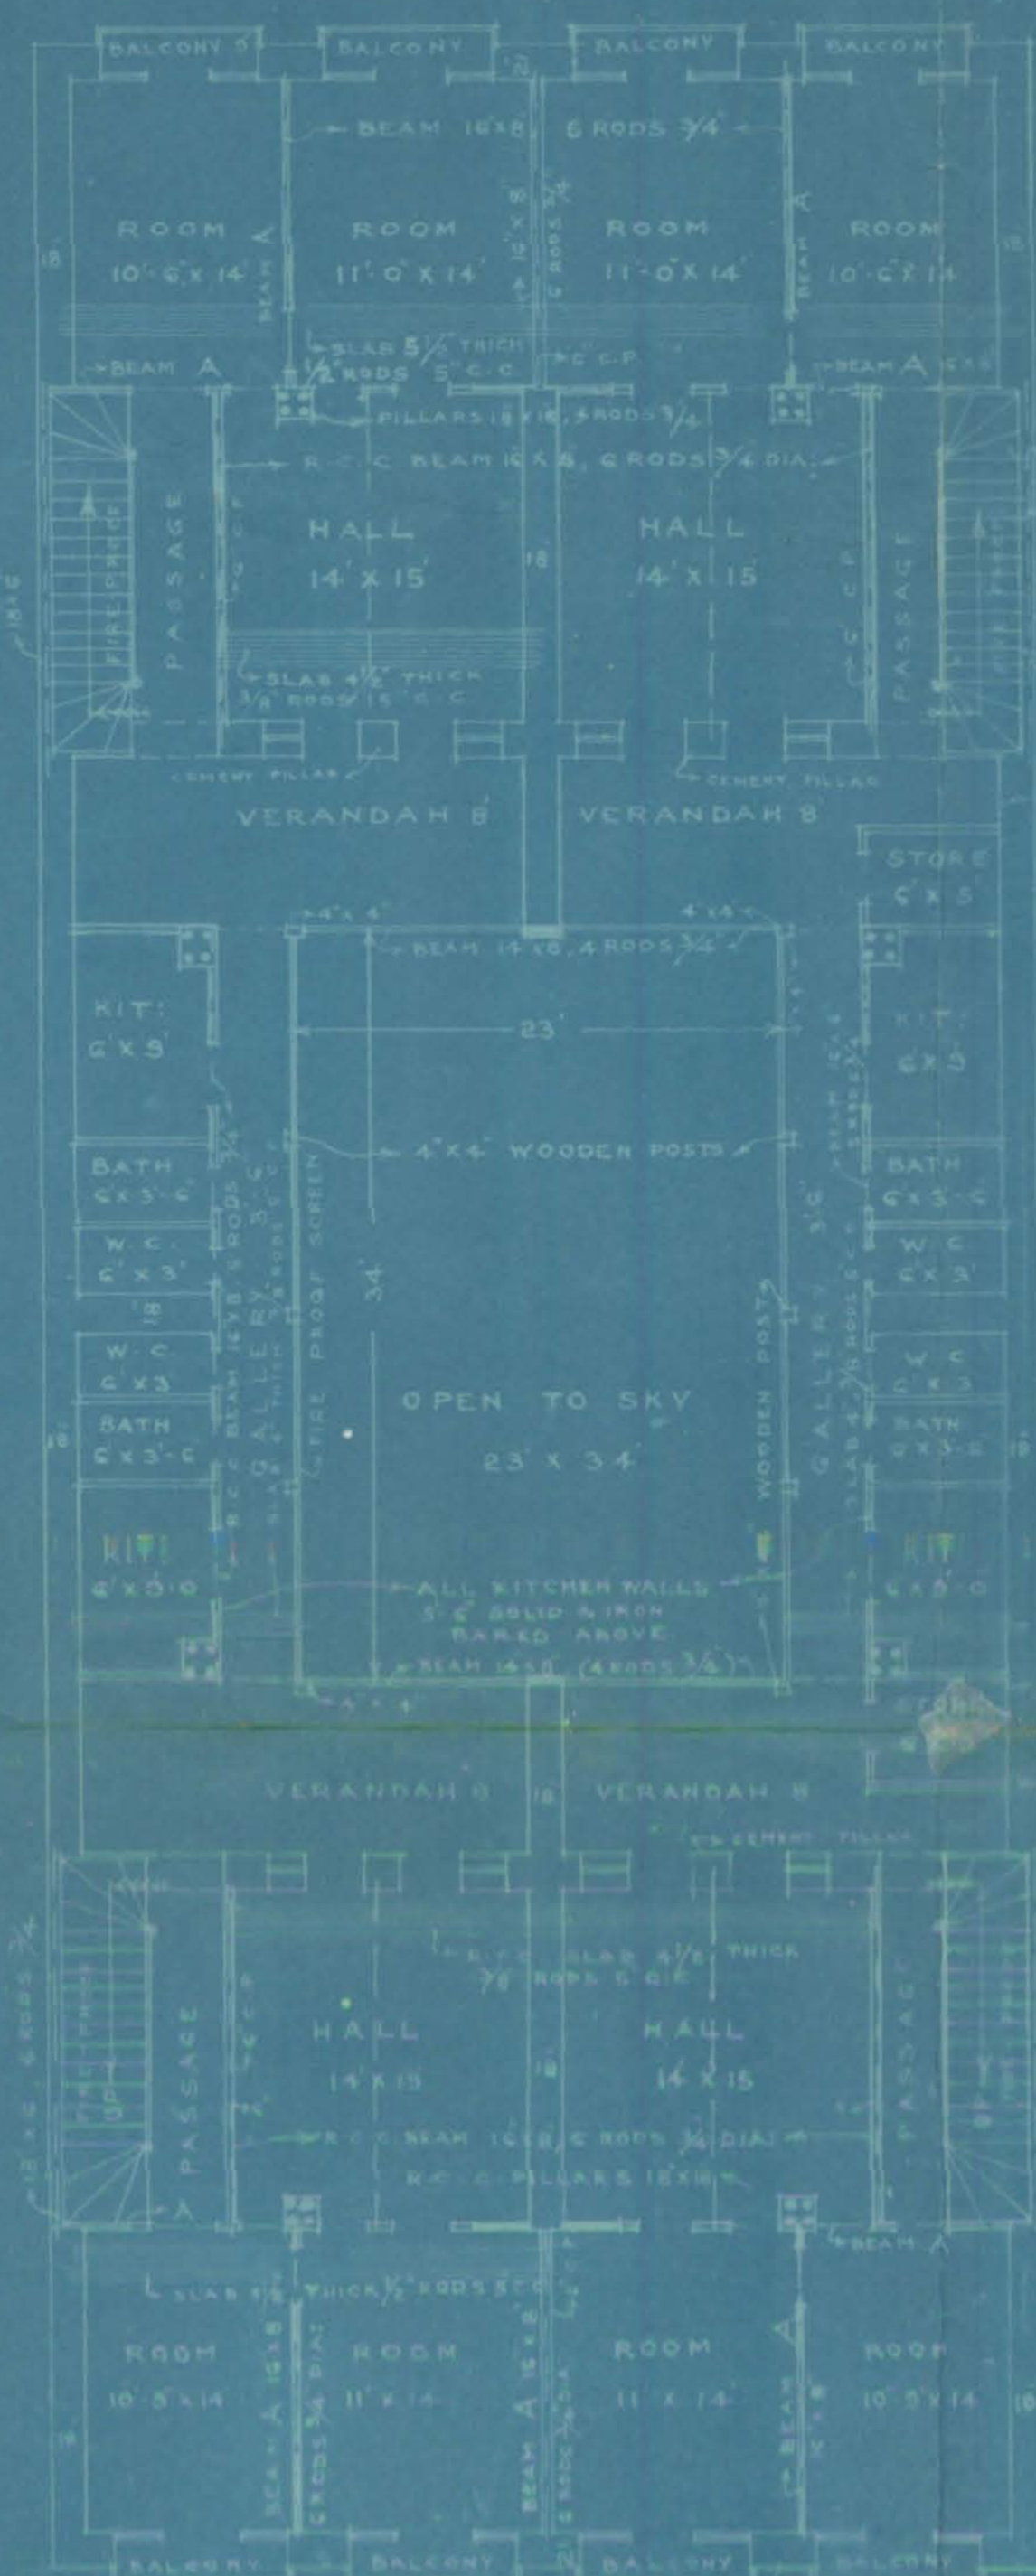

FIRST FLOOR

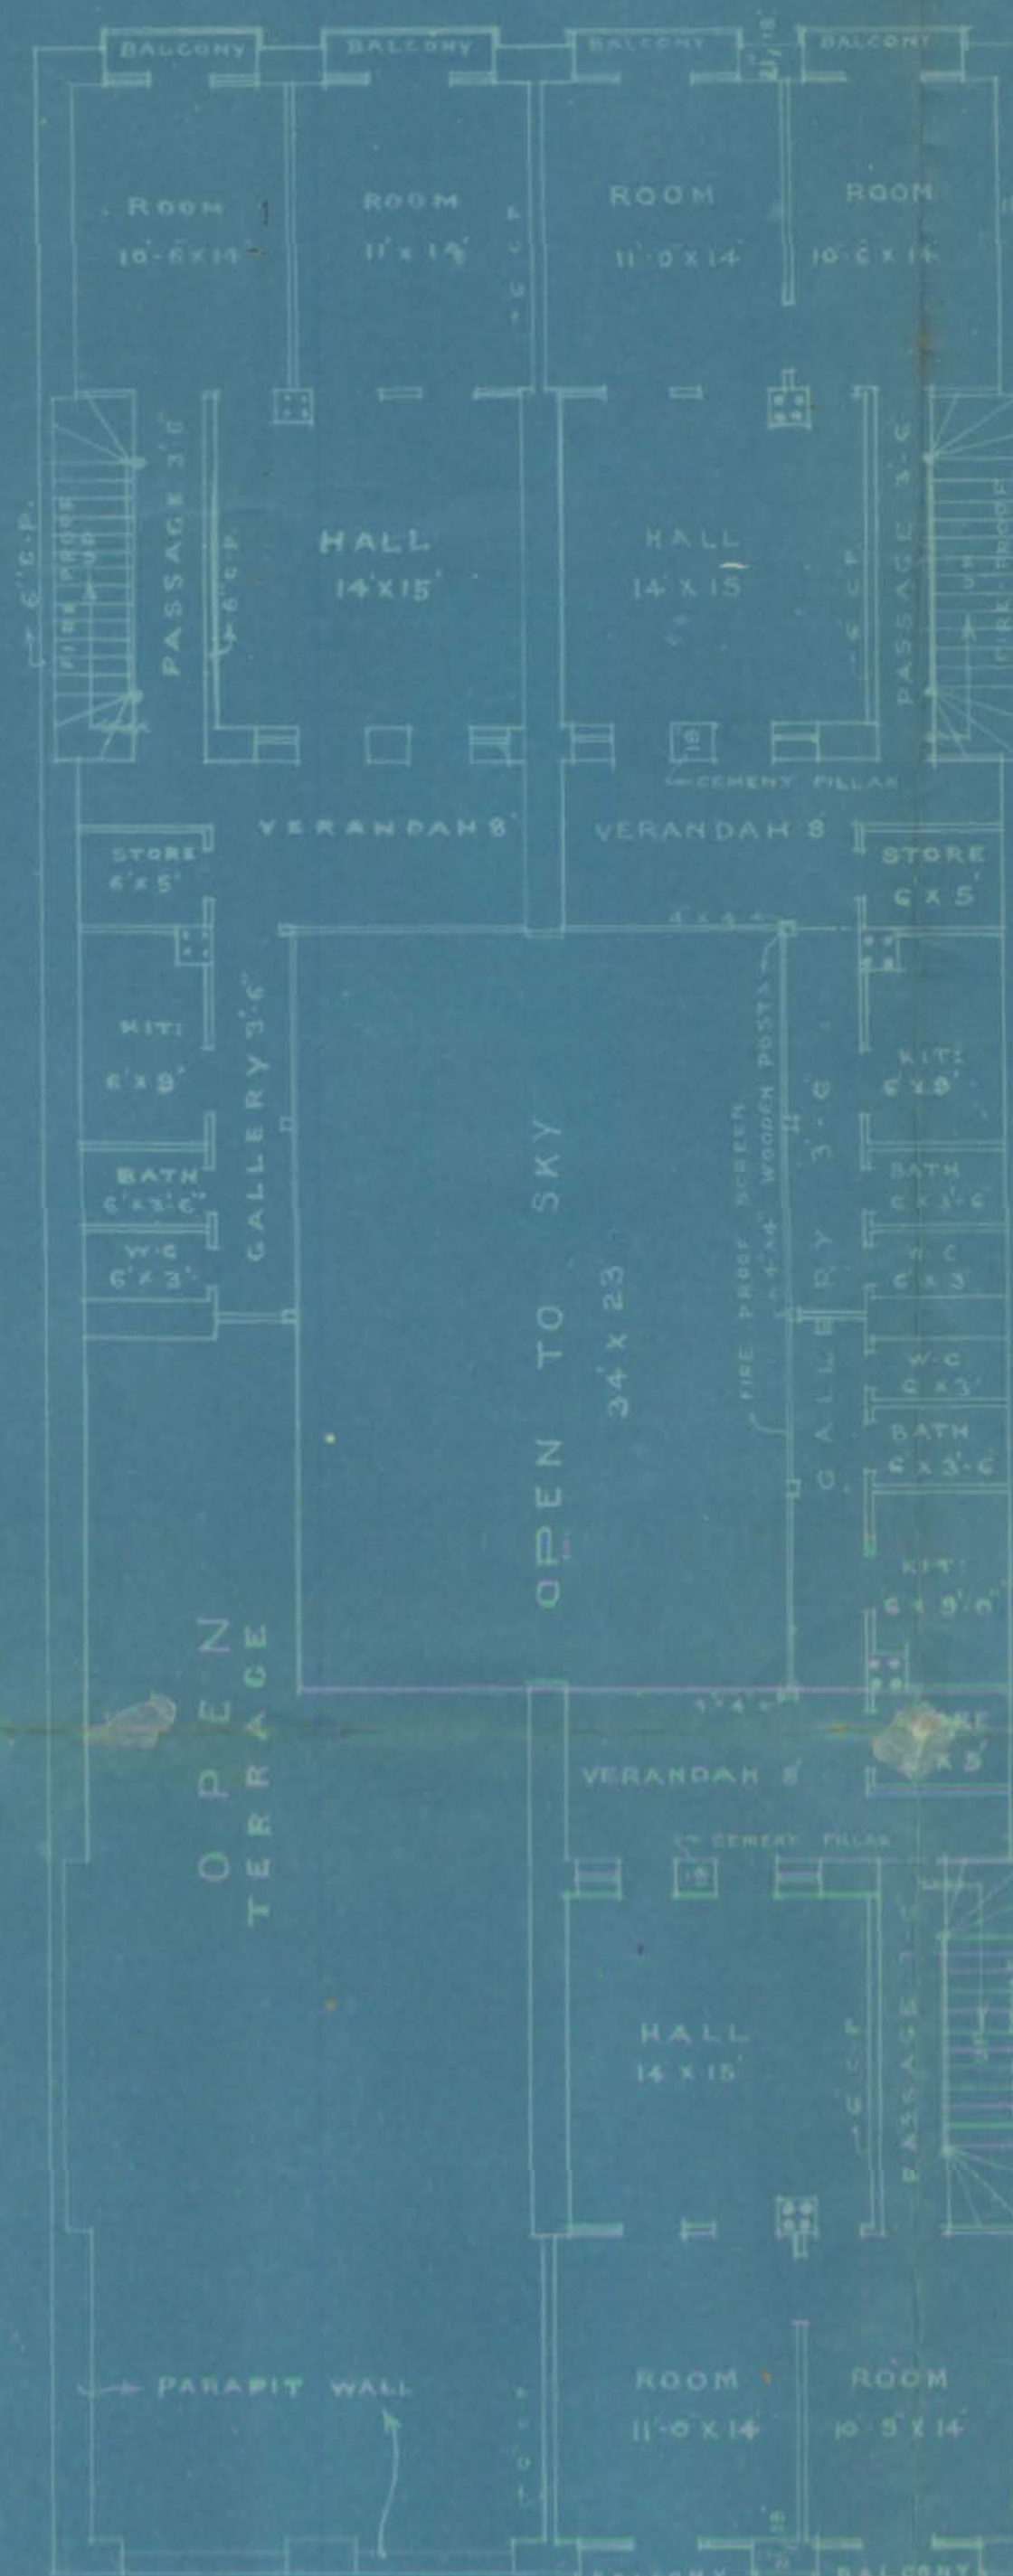

2ND & 3RD FLOOR

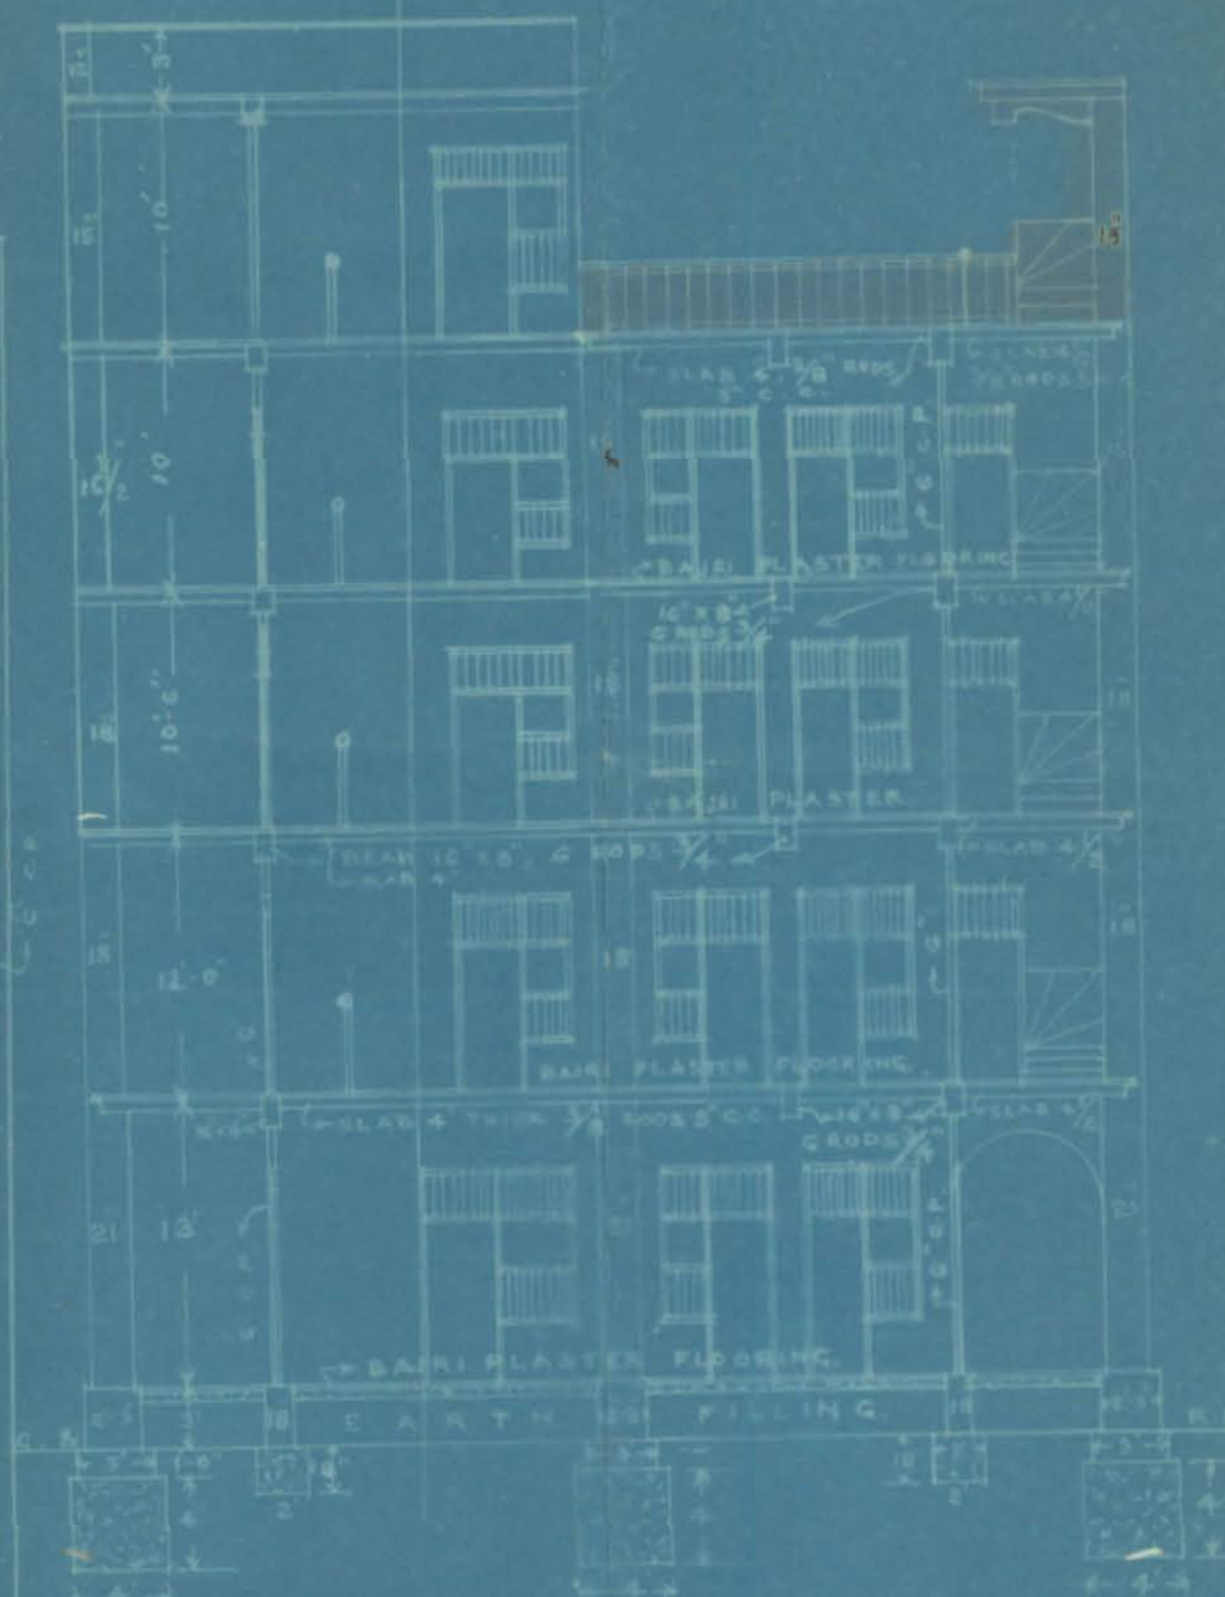

SECTION ON A-B

SITE PLAN

SCALE: 1"=10'

129/23-129/24

129/23-129/24

OWNER

M. KHANJAN & CO



Office Telephone Nos. 1140 & 1141.

Residence „ „ 199.

KUMBERALI BHALEDINO,

L. C. E.

LAND MANAGER & ARCHITECT



MUNICIPAL CORPORATION

KARACHI.

Reference No. B. S. P. 673/34

29 JAN 1935

To,

~~M/s M. Khimji, architects~~

Dear Sir,

With reference to your application dated 19-1-35
 with a plan for the proposed building/additions and alterations on plot
 No. 129, Survey Sheet No. B. 9, Cerai Quarter
 I have to request you to comply with the following requirements:—

- ✓ 1. Plot no as persanctioned subdivision must be
 xshown correctly .

Enbrieto

objection. Have been
 complied with

28-1-35.

Man approved
 6/12

4/12 7/12

The plans are returned herewith rejected.

Yours faithfully

Kumberali Bhaledino

Land Manager & Architect.



Heritage

KMR.CDD.SeQ.1934.06

12

M Khimji & Co.,
ENGINEERS, ARCHITECTS
&
SURVEYORS

No.

of 193

WATER COURSE ROAD,

—:0:—

LAND MANAGER &
ARCHITECT'S DEPTT.
KARACHI MUNICIPALITY
31 JAN 1935
No.....

Karachi,

9/30/11

1935

To,

The Land Manager,
Karachi Municipal Corporation.
Karachi.

Dear Sir,

With ref: to your no. B.S.P. 673/34
dated 29th inst: We have the honour to
submit herewith plans for Building on
plot no. 129/1 & 129/2 Sheet S.R. 9
Sarai Quarter, duly corrected as

no objection desired.

Now the plans may kindly be
approved.

195-412/35
Main
11/2/35
Main
11/2/35

Yours Faithfully,
M. Khimji & Co.
ARCHITECTS.

11/2/35
11/2/35



Heritage

13
KMR.CDD.SeQ.1934.06

Office Telephone Nos. 1140 & 1141.

Residence " " 199.

KUMBERALI BHALEDINO,

L. C. E.

LAND MANAGER & ARCHITECT



**MUNICIPAL CORPORATION
KARACHI.**

Reference No. B. S. P. 673/34

11 FEB 1935

To,

M/s M. Khinji & Co: (Architects)
for owner .

KARACHI.

Dear Sir,

Re: Plot No. 129/1&2 Sheet No. S.R. 9 Serai Qr.

With reference to your applications dated 30 . 1 . 193 5
for the proposed additions & alterations on the above plot, you
are required to submit one more copy of the
correct plan on CLOTH .


Yours faithfully,

for Land Manager & Architect.


1000-8-34



TOP FLOOR PLAN.

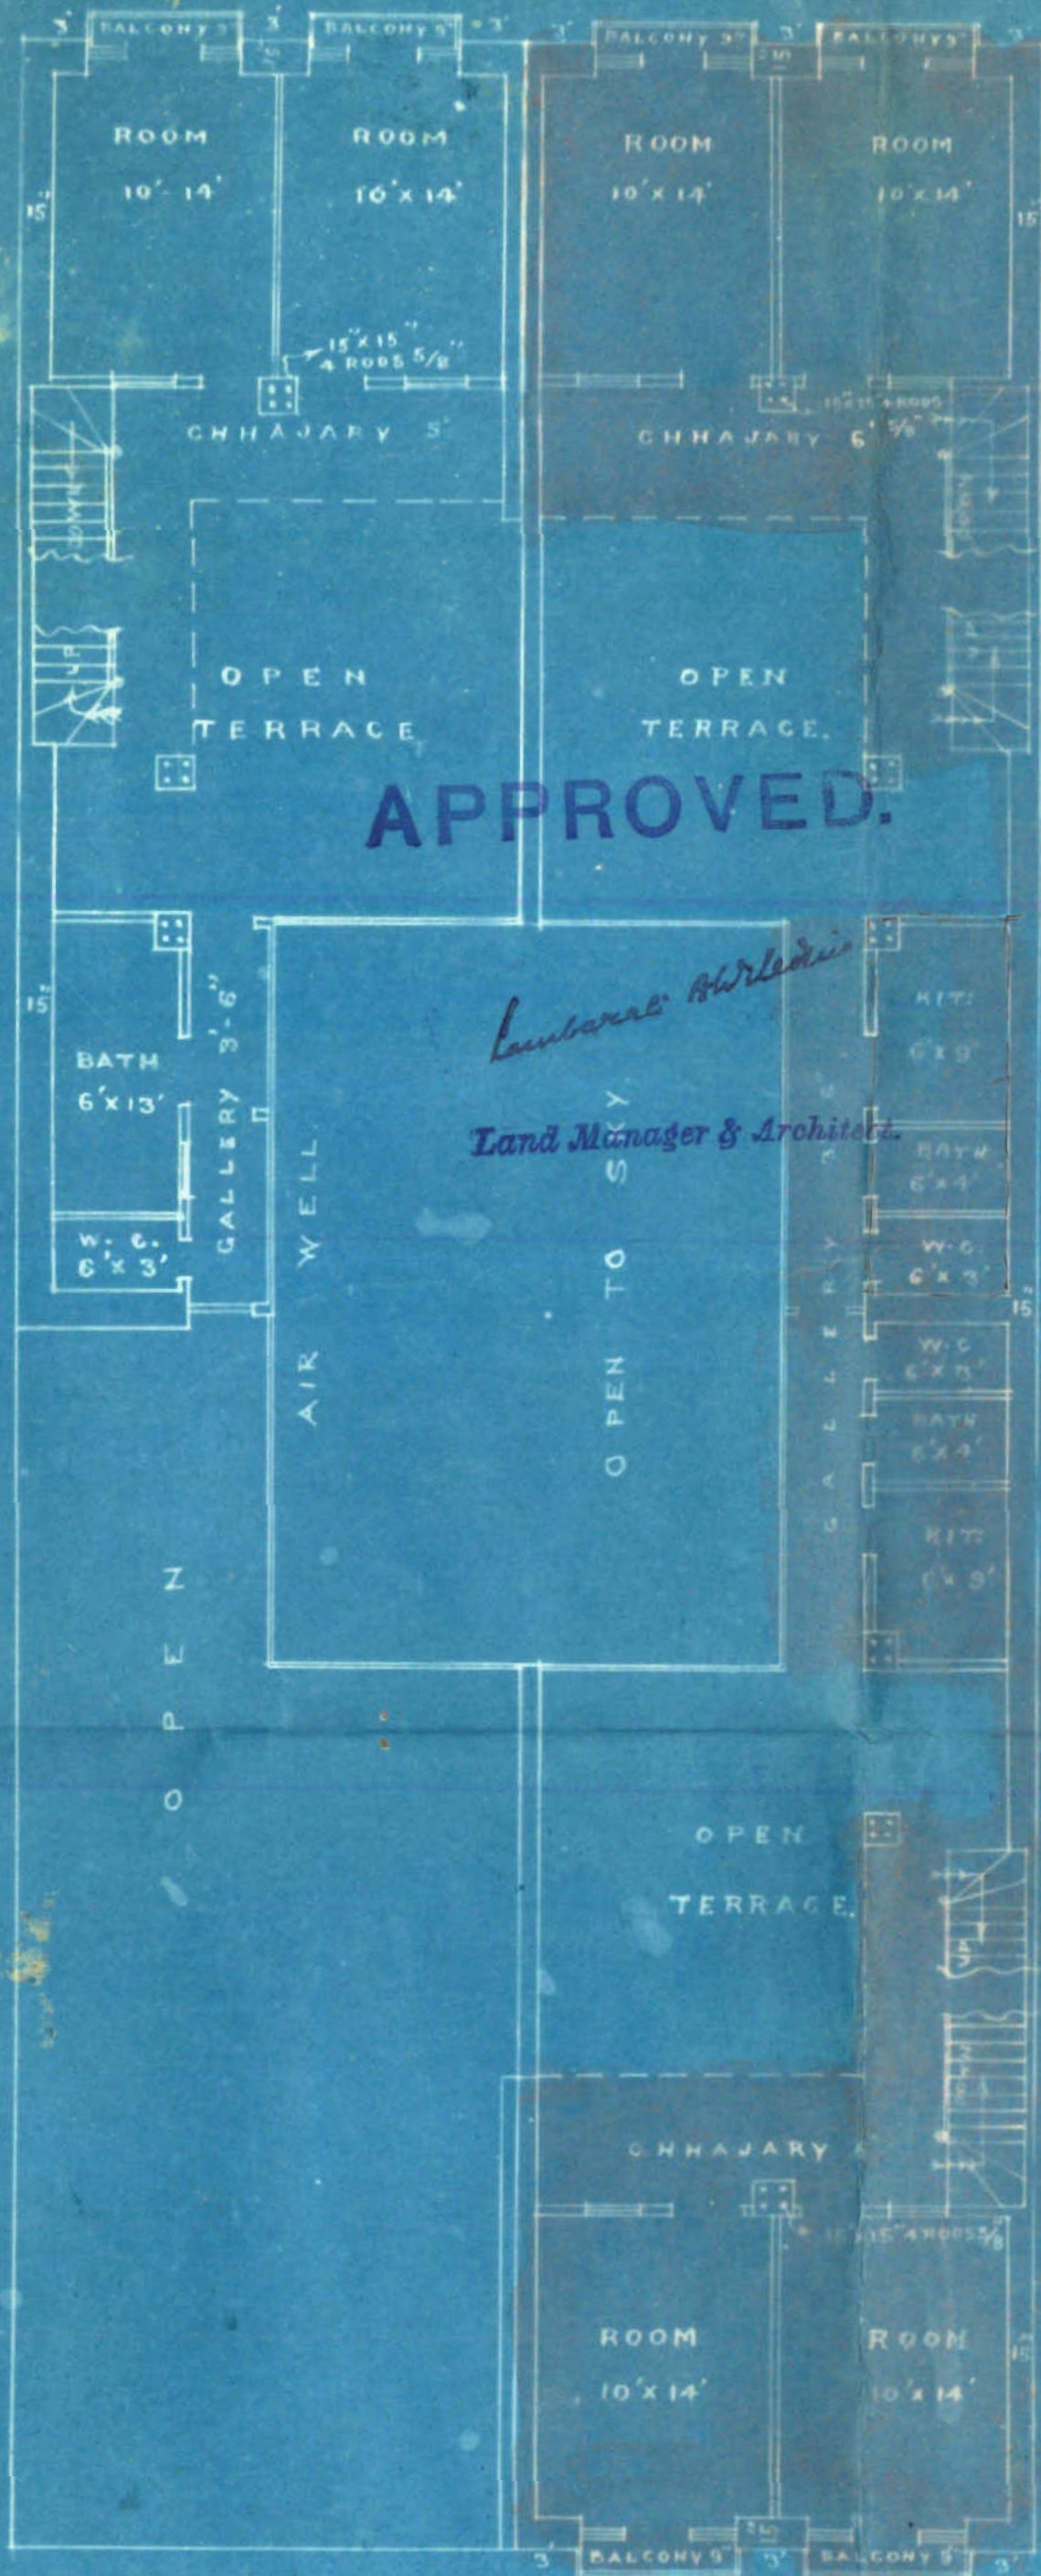

DETAIL OF R.C.C. BEAM A (16"x8")

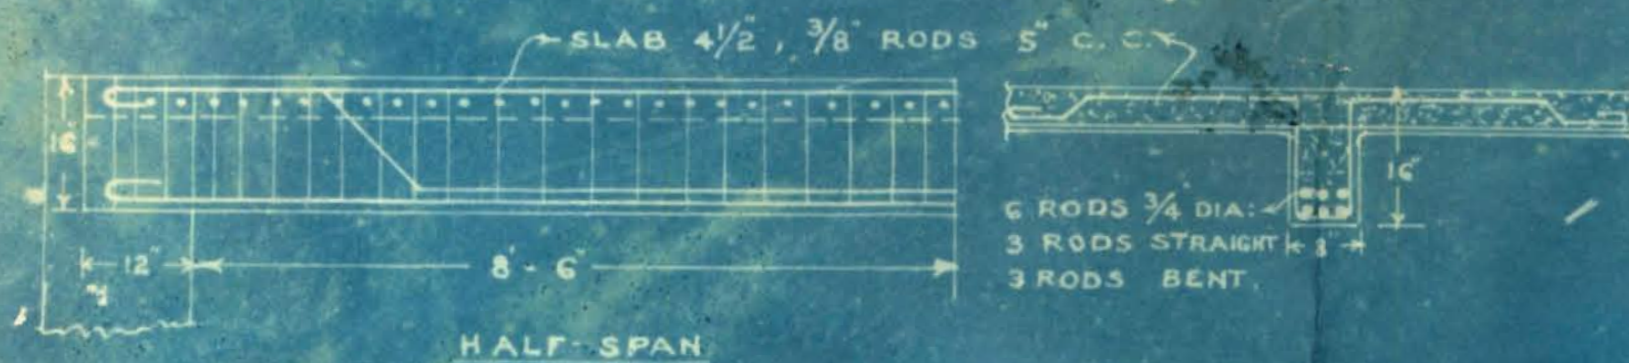

—AMENDED PLAN—


—SHOWING PROPOSED BUILDING—

—ON PLOT NO. 129/1 & 129/2, S.R. 9—

—SERAI QUARTER—

—SCALE: 8"=1"—

BELLASIS STREET

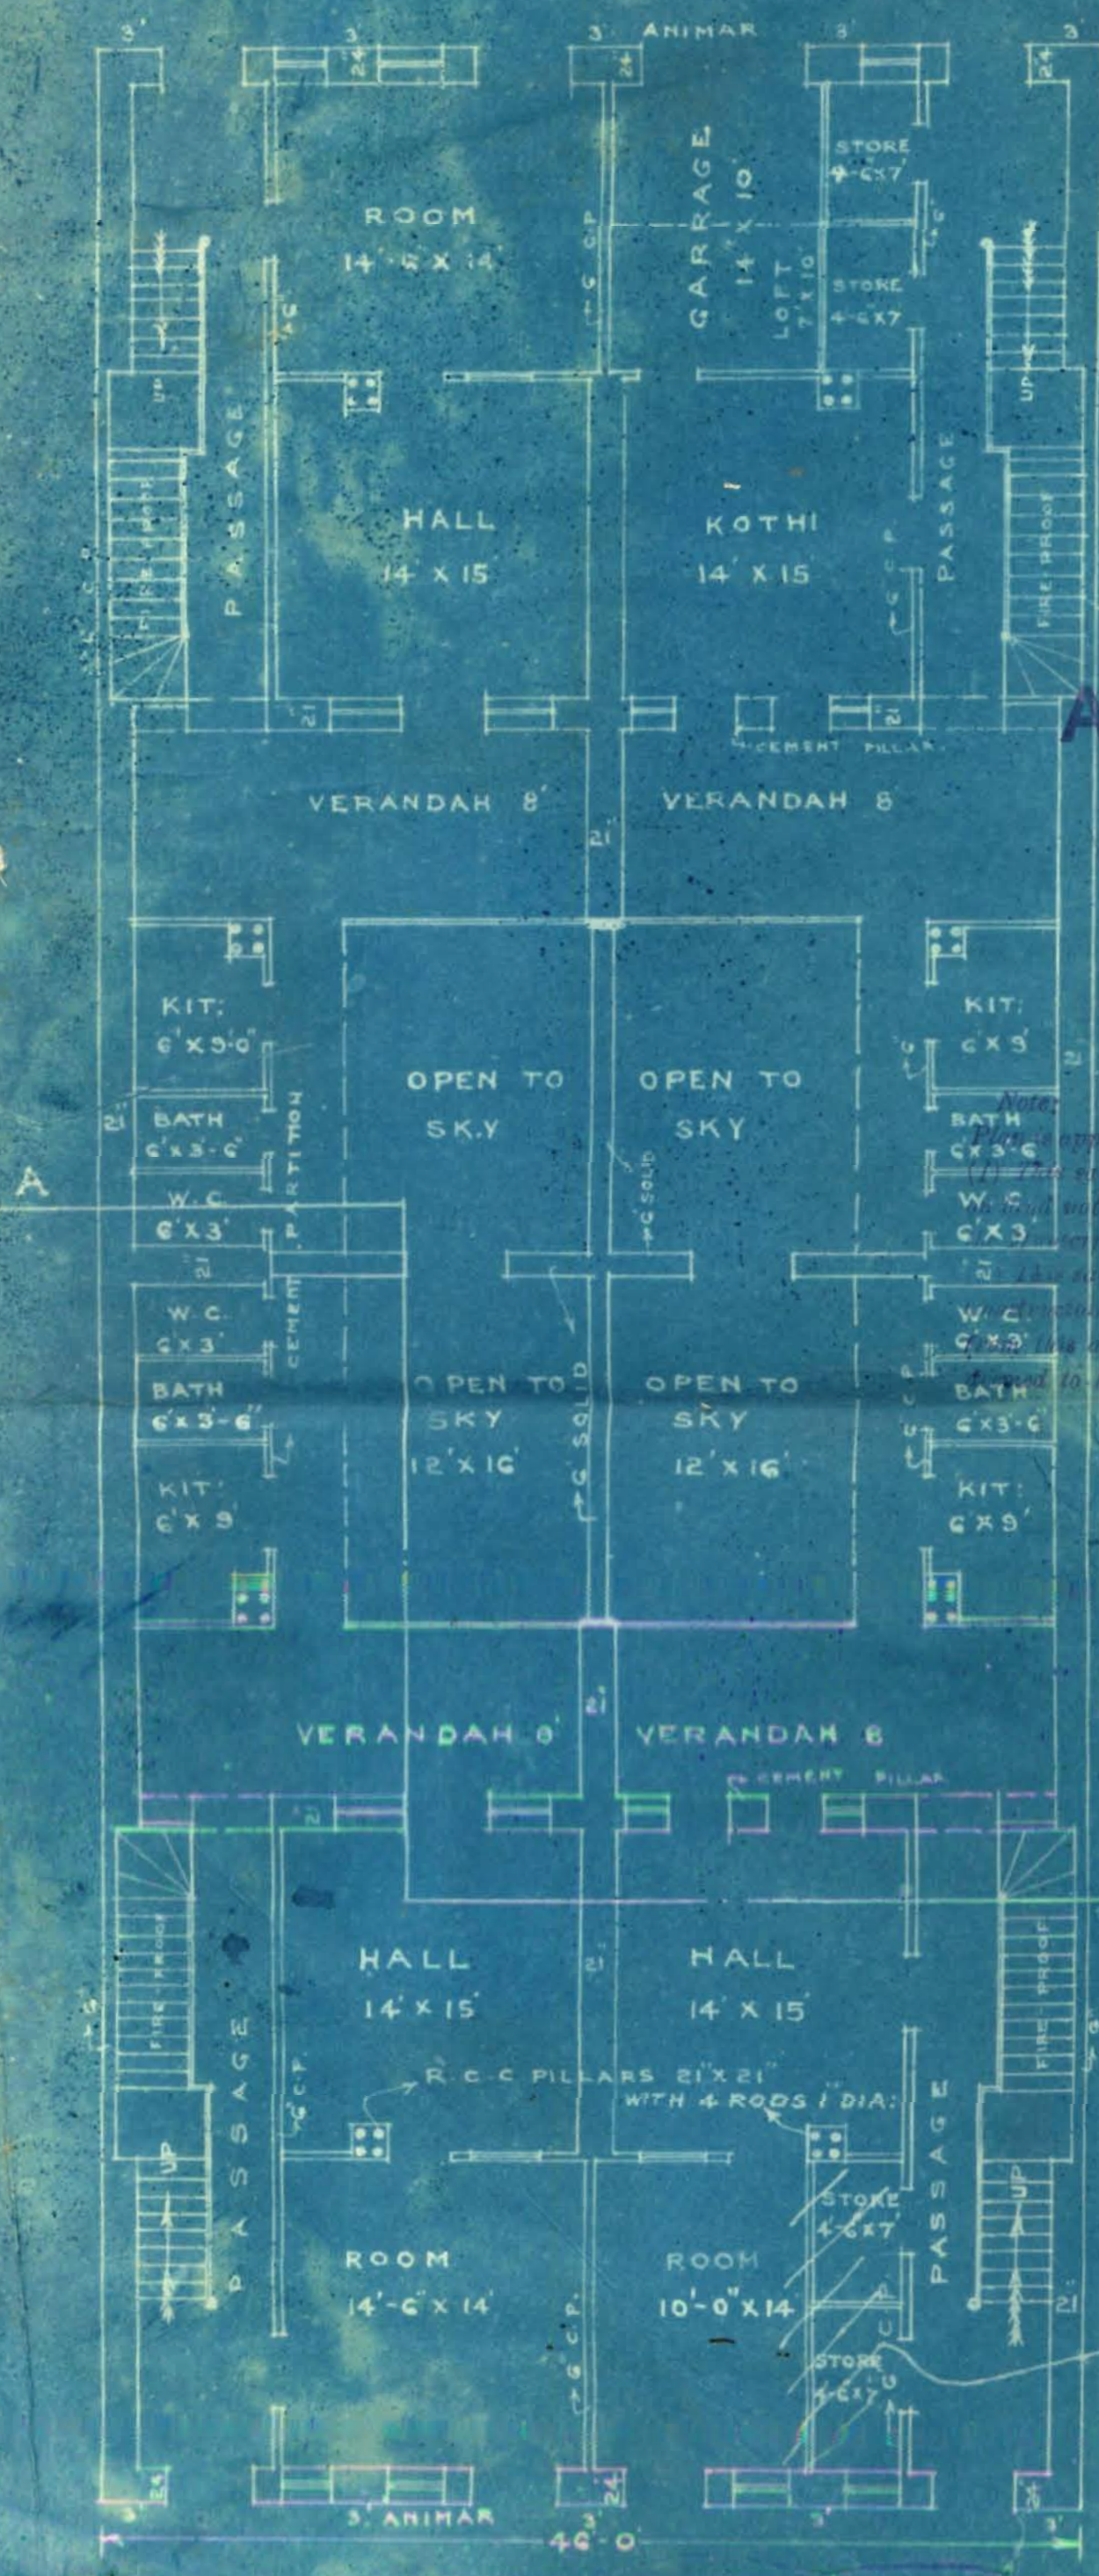

NARAIN STREET


GROUND FLOOR

APPROVED

Land Manager & Architect

Notes:
1. The plan is approved subject to the following conditions:
(a) The structure does not encroach the road or building line.
(b) The structure is not to be used for any purpose other than that for which it is approved.
(c) The structure is to be built in accordance with the specifications of the Municipal Corporation.
(d) The structure is to be built in accordance with the specifications of the Municipal Corporation.
(e) The structure is to be built in accordance with the specifications of the Municipal Corporation.


DEMOLISHED

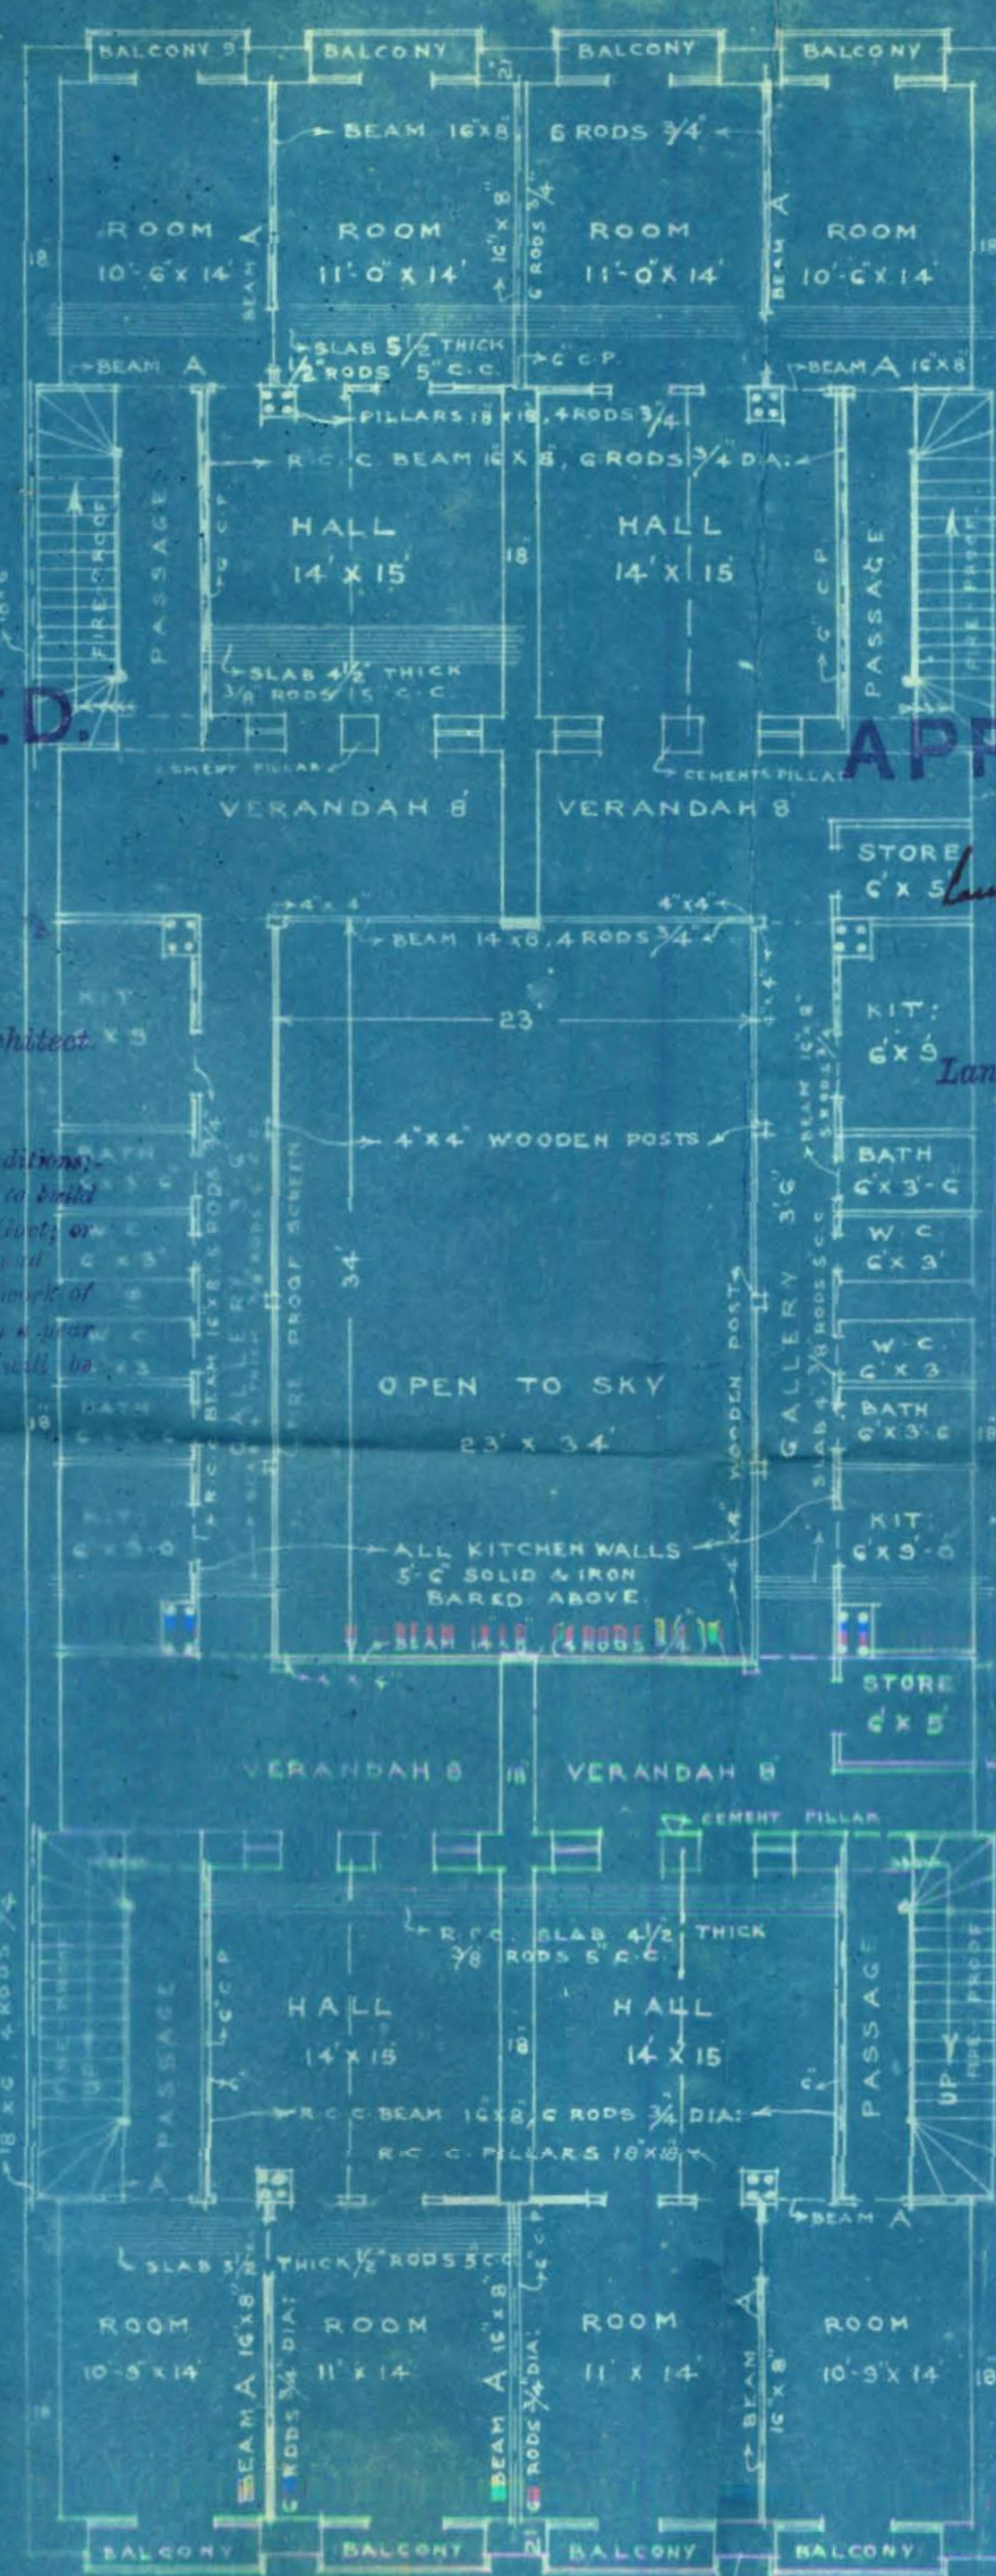

FIRST FLOOR

APPROVED

Land Manager & Architect

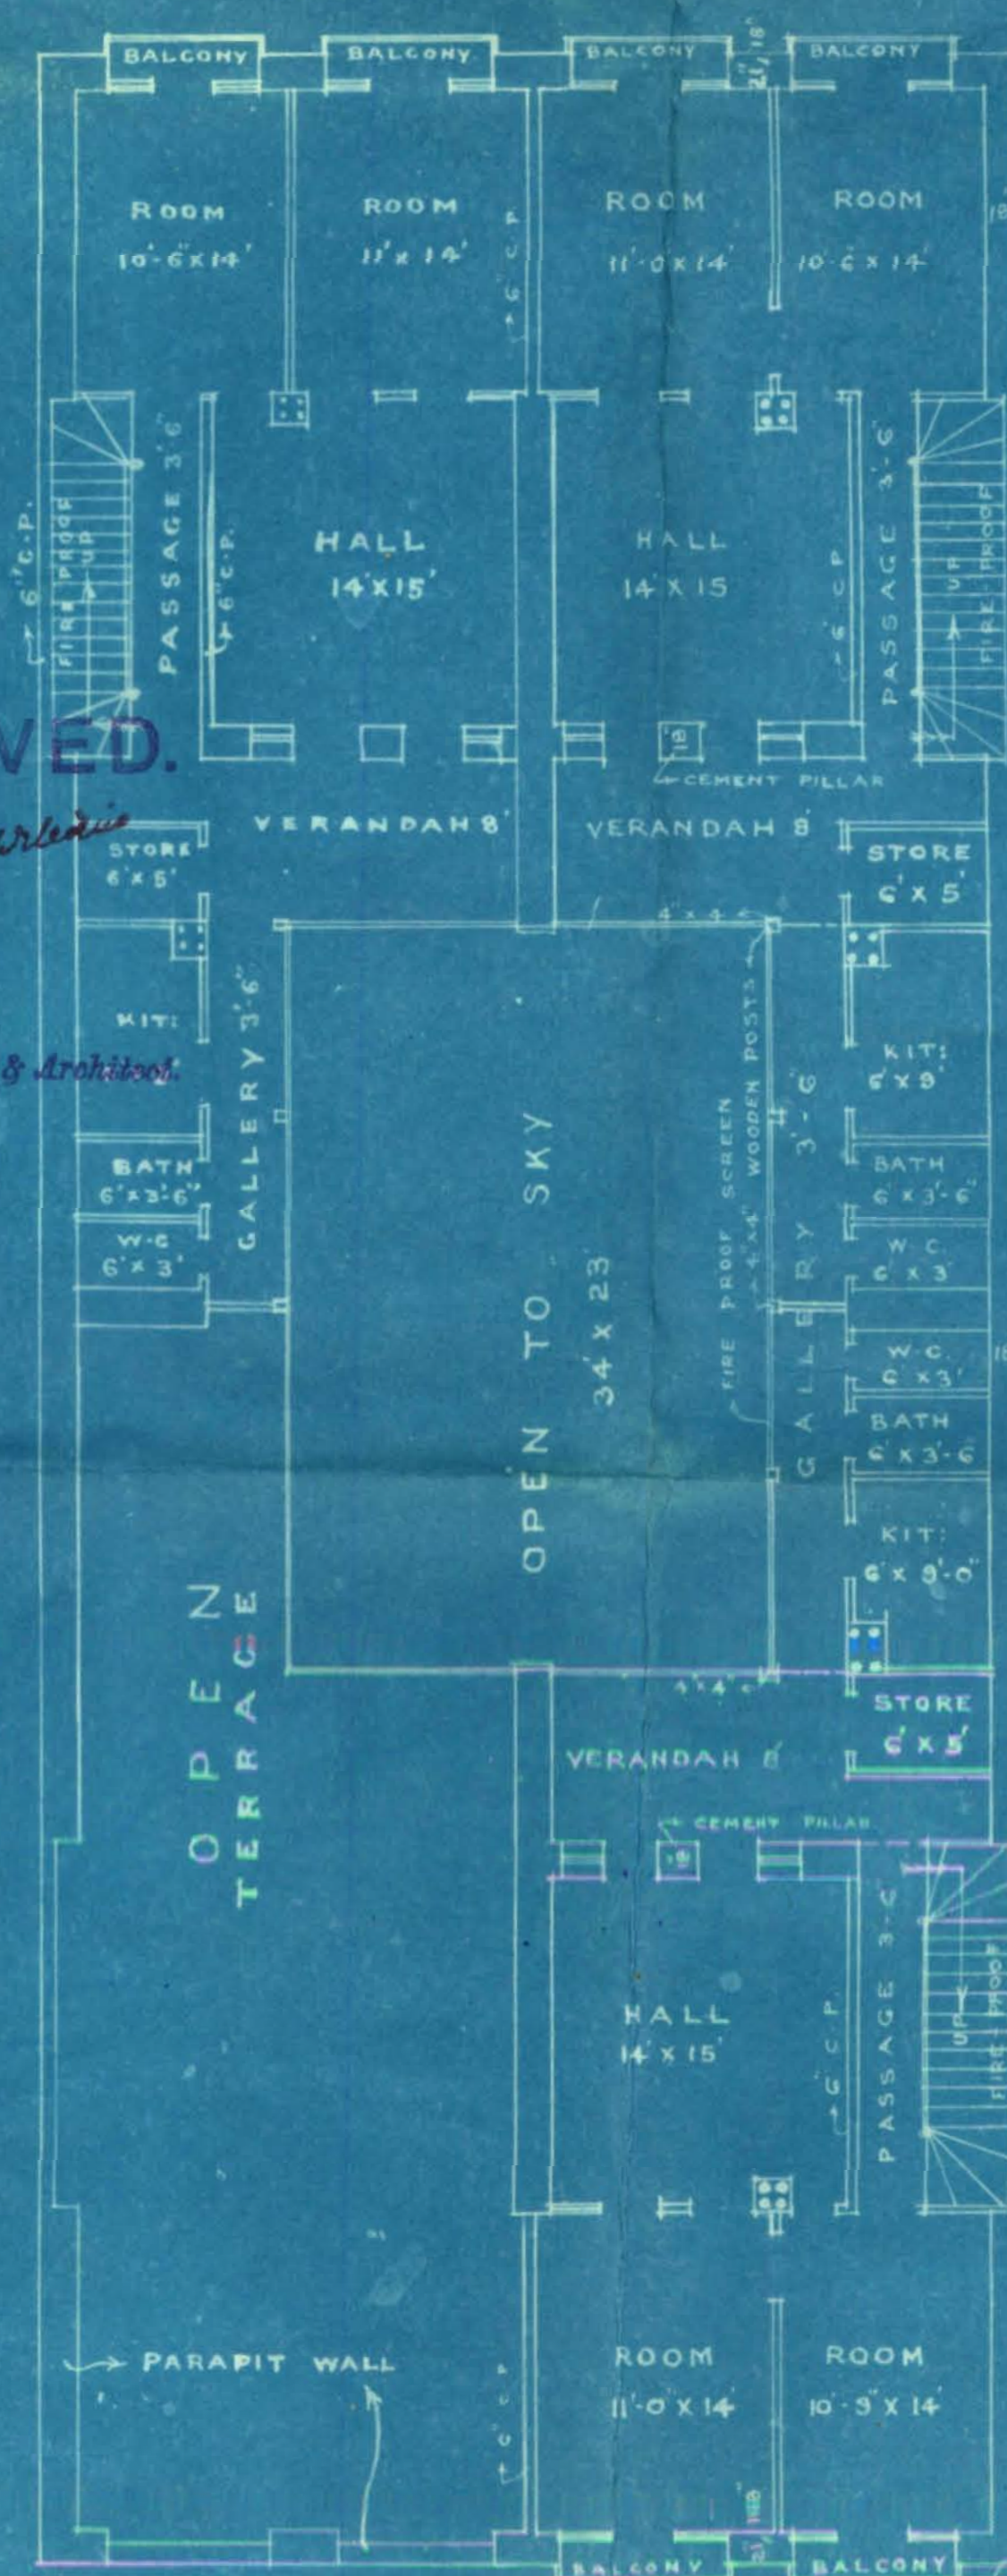


2ND & 3RD FLOOR



Heritage

KMR.CDD.SeQ.1934.06

118

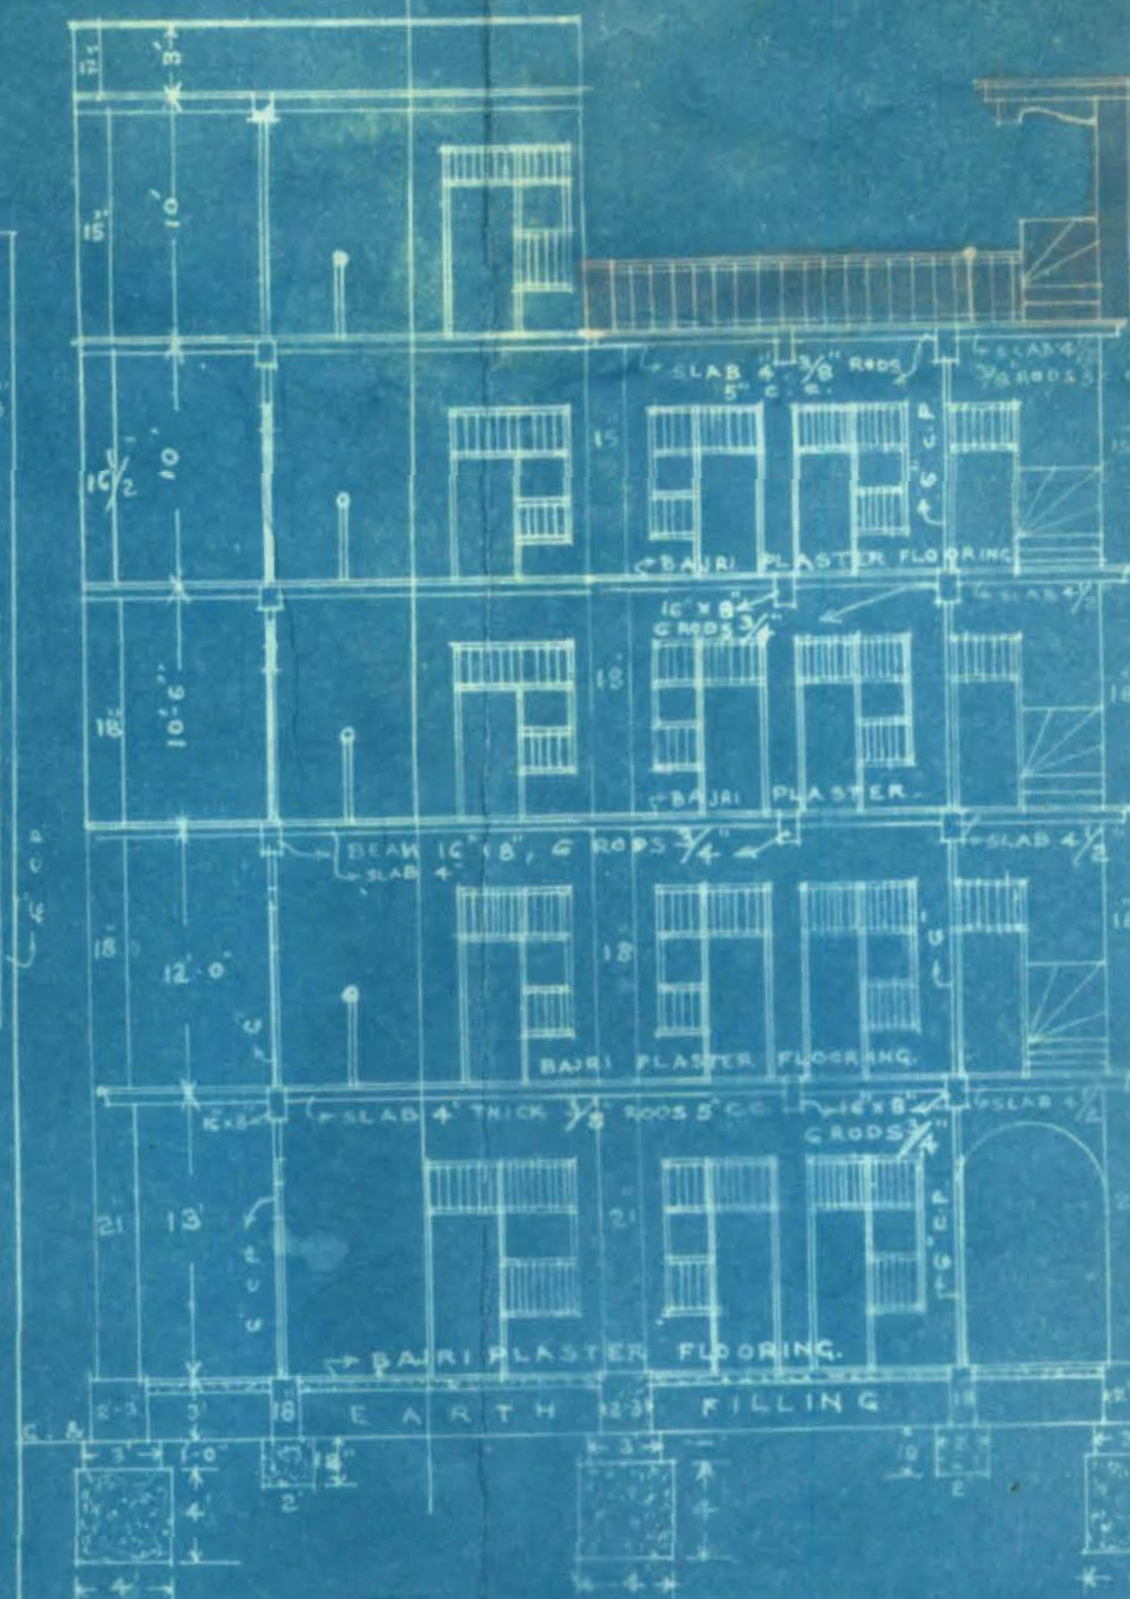

SECTION ON A B

SITE PLAN

SCALE: 1"=10'

BELLASIS STREET

NARAIN STREET

OPEN PLOT

OPEN PLOT

Motiram Bhowani & Co.

OWNER

M. KHIMJI & CO. ARCHITECTS

M Khimji & Co.
ARCHITECT'S DEPTT.
ENGINEERS, ARCHITECTS
&
SURVEYORS.
RAIPUR MUNICIPALITY
12. FEB. 1935

OF 193

WATER COURSE ROAD,

No. 44.1 Karachi, 12/2 1935

To,

The Land Manager,
 Karachi Municipality,
 Karachi.

Dear Sir,

With ref: to your no. B.S.P. 673/34

Dated 11th Feb: 1935. We have the
 honour to submit herewith one
 more Copy on Cloth for Building
 on plot no. 129/1 & 129/2 sheet
 No. S.R. 7. Sarai Quarter, as
 desired. Now the plans may
 kindly be approved soon.

B.S. Khimji
 archt
 12/2

Yours Faithfully.
 M Khimji & Co.

M KHIJJI & CO
ARCHITECTS

P. put up approval
 from Mr. 12/2