



NO: L. S. 2091 of 1921.

Municipal Office.

Karachi 23rd June 1921.

M E M O : -

With reference to his letter dated 10th June 1921, Mr. Gopalji Mararji for Mr. Kallianji Khetsi owner of plot Nos. 153 & 1492, E-6 Ramswami Quarter is informed, there is no objection to the amended plan .

One copy of the plan is returned herewith duly approved.

P. B. Shirdasan

FOR: ENGINEER

KARACHI MUNICIPALITY.

P.L.V.
22.6.21

Memo.

18/6/2

With ref. to his letter dated 10th June 21.
Mr. Gopalji. Moraji. for Mr. Kallhoing
Khetri owner of plot Nos 153 & 149A. 36
Ranwari. Is informed, there is no
objection to the amended plan

one copy of the plan is
returned herewith duly approved.

PM

W

M. C. D. M. L. C. E.

L. Officer.

Karachi Municipality



Form No. 17-400-47-19.

No. L. S. 1207 OF 1921.

MUNICIPAL OFFICE,

Karachi, 9th May 1921.

Memo.

Mr. Kalijji Khetoi
Messrs.~~is~~
~~are~~ informed that it is observed that in building~~his~~
~~their~~ Hall Library on Plot No. 153+149/A
roadSurvey Sheet 36, Ramswani Quarter,~~he is~~
~~they are~~ deviating from the approved plan, in as much as
partition walls have been erected on the
ground floor & 1st floor without permission
so as to convert them into shops & dwelling rooms.Instructions are therefore given to ~~him~~
~~them~~ to at once stop the work and
submit an amended plan within
make the building in conformity to the approved plan, or steps will be taken
3 days.
under the Act.

A.M. INST. C.E.

Engineer,

Karachi Municipality.


NO: L. S. 1118 of 1921. 4

Municipal Office.

Karachi 7th May 1921.

MEMO :-

With reference to his application dated 8th October 1920 Mr. Kalianjikhetsi on behalf of the Catchi Gurjar Sutar Community of Karachi is informed, that the amalgamation of plots Nos.153 & 149/A, E-6 Ramswami Quarter can not be considered as the plots are held on different leases ;

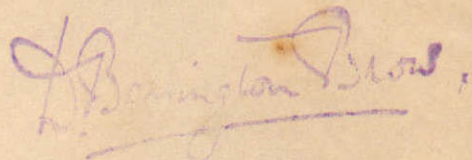

M. C., A. M. I. C. E.

ENGINEER.

KARACHI MUNICIPALITY.

oooooooooooooooooooooooooooooooo

NO: L. S. 1119 of 1921.

Municipal Office.

Karachi 7th May 1921.P.L.V.
4.5.21

Copy to the Building Surveyor Section "A" who
above
is instructed to see that the building on the plots which is
under construction at the present time is erected in accor-
-dance with the sanctioned divisions in order to avoid -
trouble in future .



M.C., A. M. I. C. E.

ENGINEER.

KARACHI MUNICIPALITY.

i.b.

R

1534 149/A 66 Ranswaamers

Submitted with report
there is no objection to
approve the amended plan

14/6/21
St

There seems no objection

S.

J/C. M.
No objection

16/6 St

2/c Attached, herewith
16/6 St

No objection

16/6 St

1128

Karachi 10th June 1921

To



The Engineer.
Karachi Municipality

Sir

With reference to your letter No. L.S. dated
I beg to submit here with 2 copies
of the amended plan for purpose of approval.
The amendments consist of only
partition wall

Land survey
for the map
AB.

Thanking you in anticipation

Your most obedient
servant

THURSDAY 21st 1921


ie. Lalaji Maraji

248
Mr. Vansoni for report
of the S.D. 1921

of 1919.

Municipal Office,
Karachi, 11th July 1919. 7

reference to their letter dated 9th July
plan of building under construction on plot
Quarter Undersigned has the honor to
and Essexlas that the same is approved
in accordance therewith is hereby

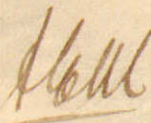

M. I. M. E.,
Acting Engineer
Karachi Municipality.

No. L.S. 3502 of 1919.

Municipal Office,
Karachi, 11th July 1919.

Copy to the Building Surveyor Section A.
of the amended plan for information and guidance.



M. I. M. E.,
Acting Engineer
Karachi Municipality.



Heritage

KMR.CDD.RaQ.1920-1921.01

BUILDING COMPLETION REPORT.

MUNICIPAL OFFICE,

Karachi, 29th June 1921.
1-7-21

To,

THE ENGINEER,

KARACHI MUNICIPALITY.

SIR,

I beg to report that the building work on plot No. 153 & 149
sheet P6 Rauwani Quarter owned by
Mr. Kalliangi Khatri is completed
according to the plan approved by this office.

Copy to the A/c for information



Yours obediently,
Rauwani
Building Surveyor, "A." Section
Karachi Municipality.

Karachi Municipality

DRAWING NO 37

PLAN OF PROPOSED BUILDING TO BE BUILT

ON PLOT NO 153 & 149 SHEET E-6

RAMSWAMI QUARTER

SCALE 8"=1"

APPROVE

P. B. Shinde

M. C. J. M. C. E.


Surveyor

BLOCK PLAN

SCALE 20"=1"





GROUND PLAN

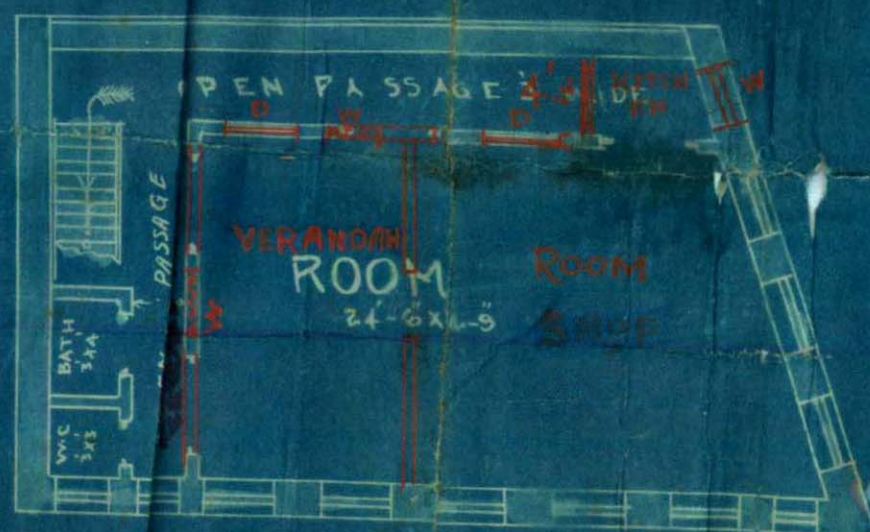


FIRST FLOOR PLAN

MOOSA STREET

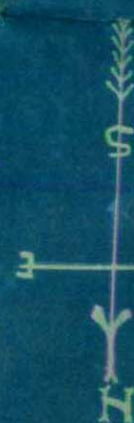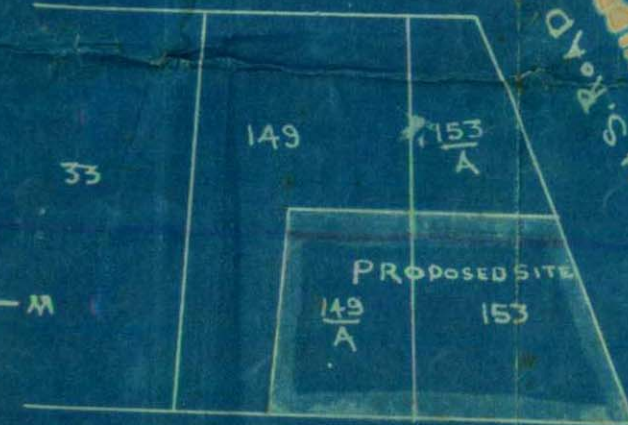

JEEVAN STREET 40'-0" WIDE

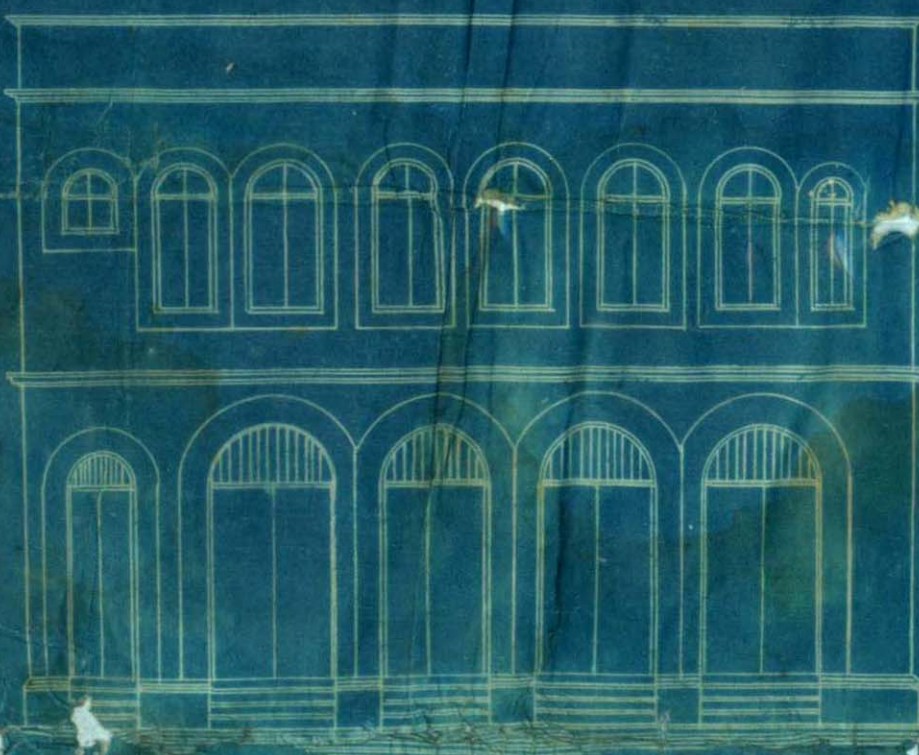

FRONT ELEVATION



SECTION A.B.

T. N. Shrivastava

ARCHITECT & SURVEYORS

11/2/20