



PLAN OF PROPOSED CHAWL No 1

ON PLOT No 4 K. SHEET E. II


GARDEN QUARTER

SCALE 8"=1" INCH


TABLE OF AREA

TOTAL AREA OF THE PLOT	Sq. Yds.	1275
AREA ALLOWED TO BE BUILT		425
AREA OF CHAWL No 1		174
D ₁ D ₂ BATH & W.C.		14
D ₁ D ₂ No 2		174
D ₁ D ₂ BATH & W.C.		18
TOTAL AREA TO BE BUILT		380


80

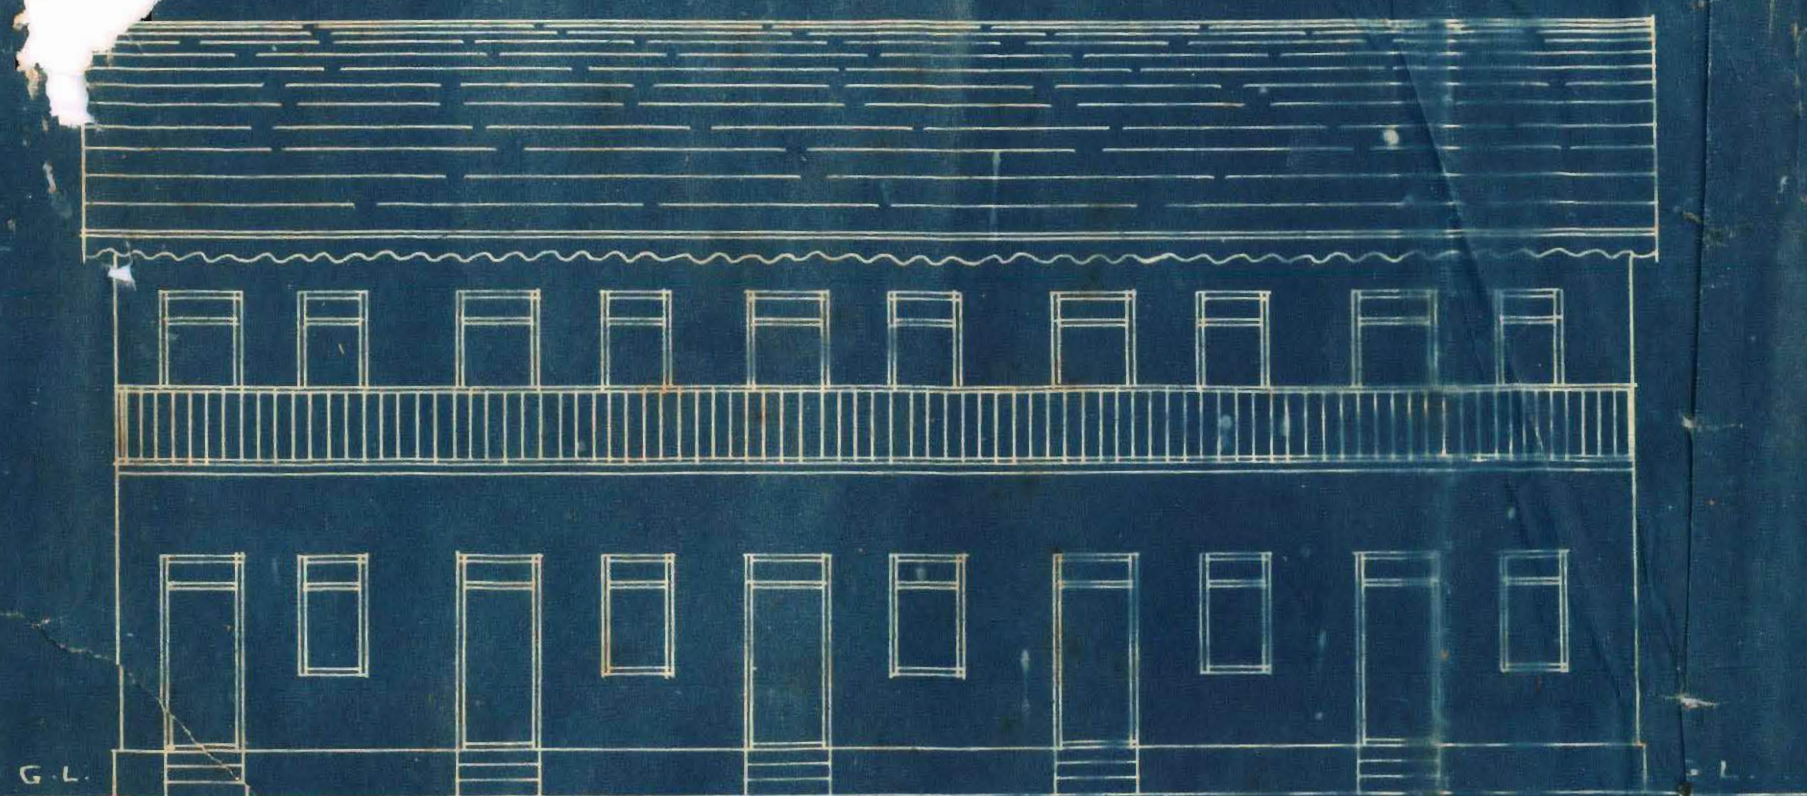



SOUTH ELEVATION

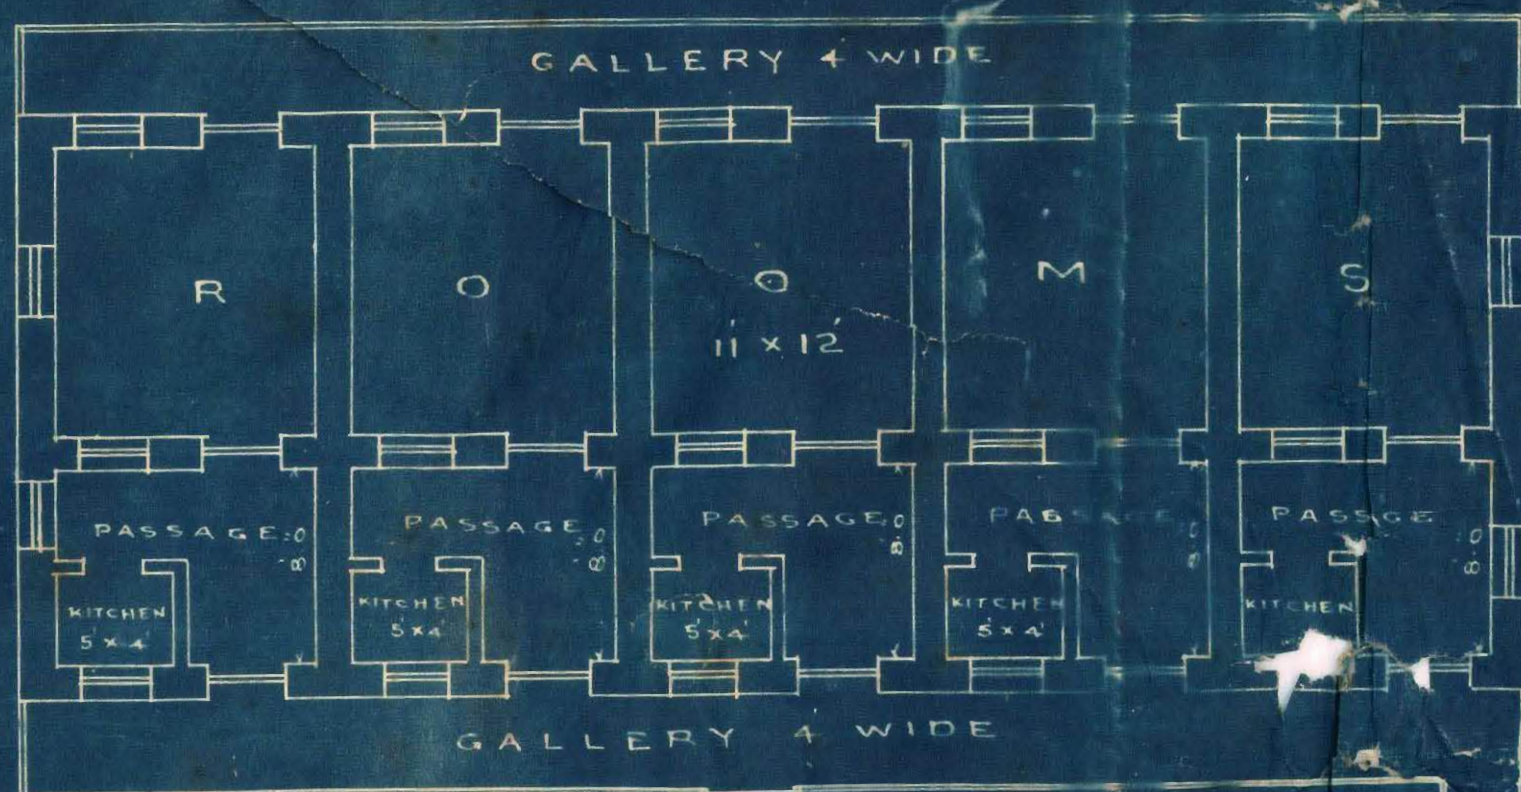

PLAN OF 1ST FLOOR


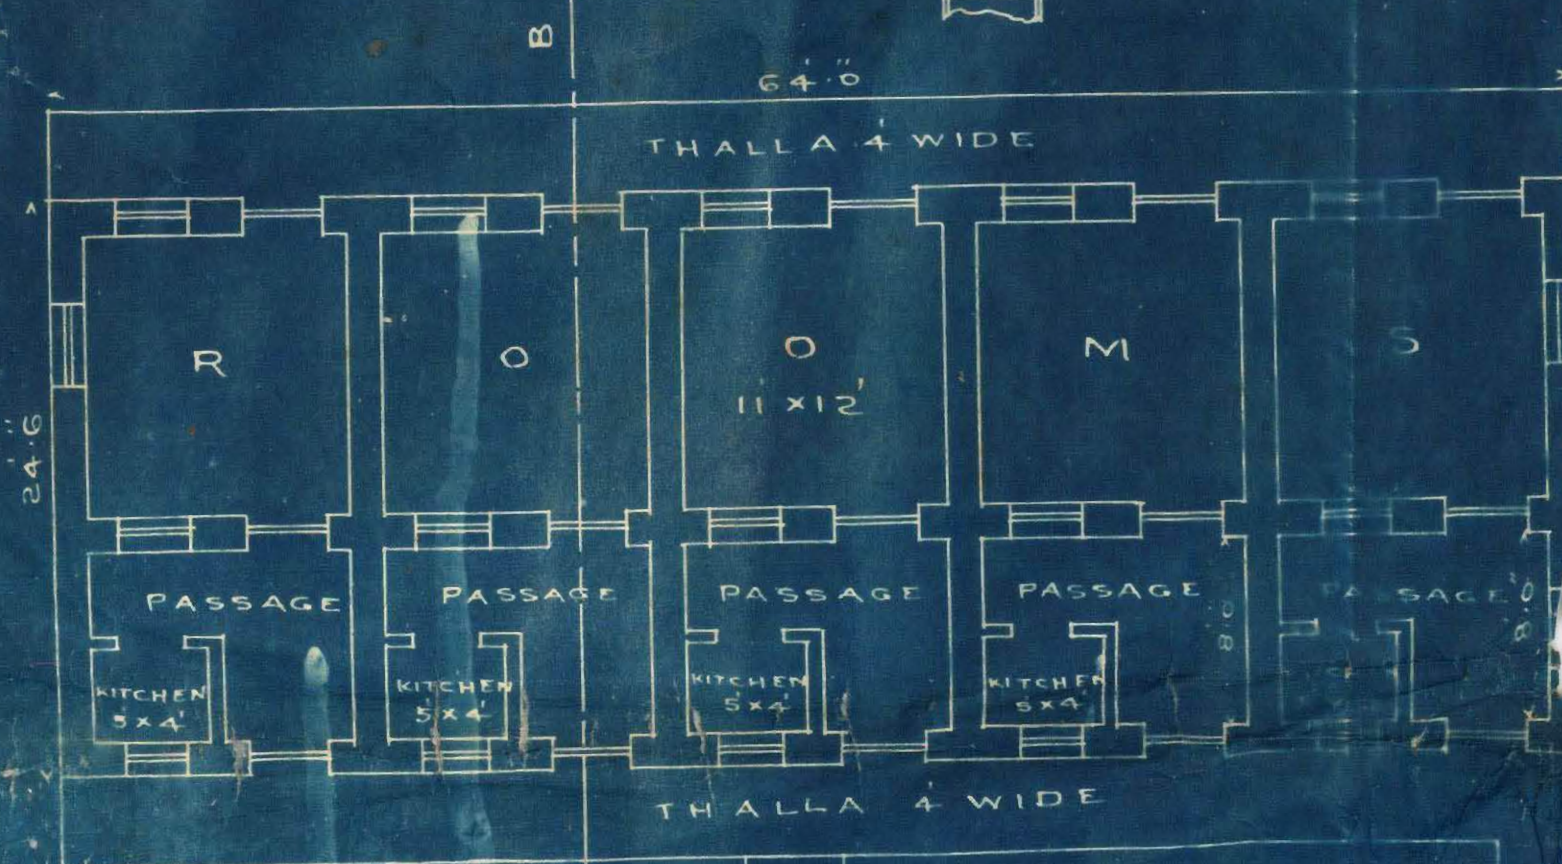


PLAN OF GROUND FLOOR
(A IN SITE PLAN)

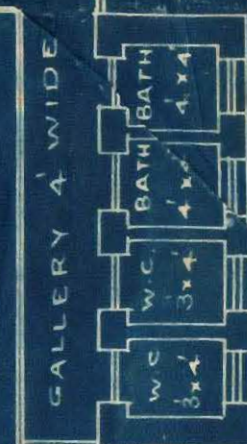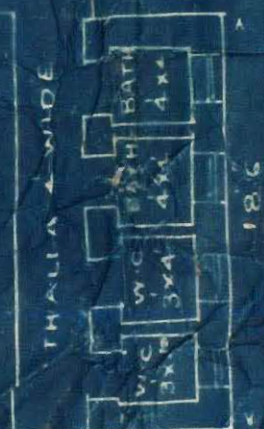

BLOCK PLAN
SCALE 40' = 1"

ROAD 35' WIDE

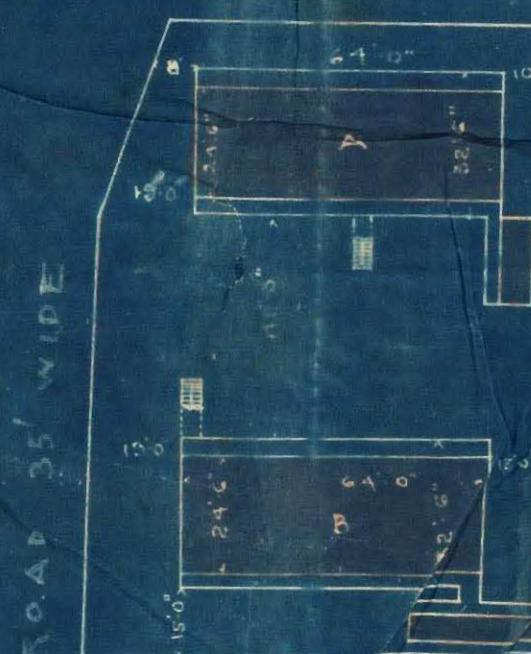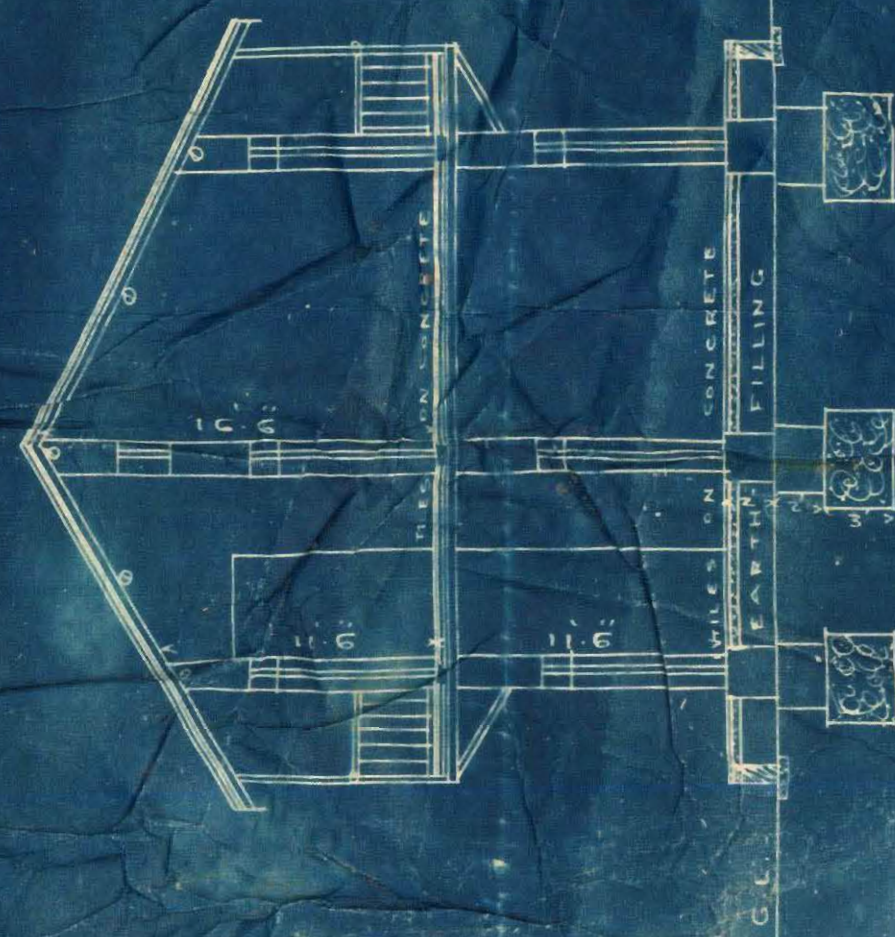



Heritage
FOUNDATION

SHEET No 2

KMR.CDD.MIQ.1916-1918.01(B)

PLAN OF PROPOSED CHAWL No 2


ON PLOT No 4-K, SHEET E-II

GARDEN QUARTER


SCALE 8" = 1" INCH

AREA OF CHAWL No 2.



80

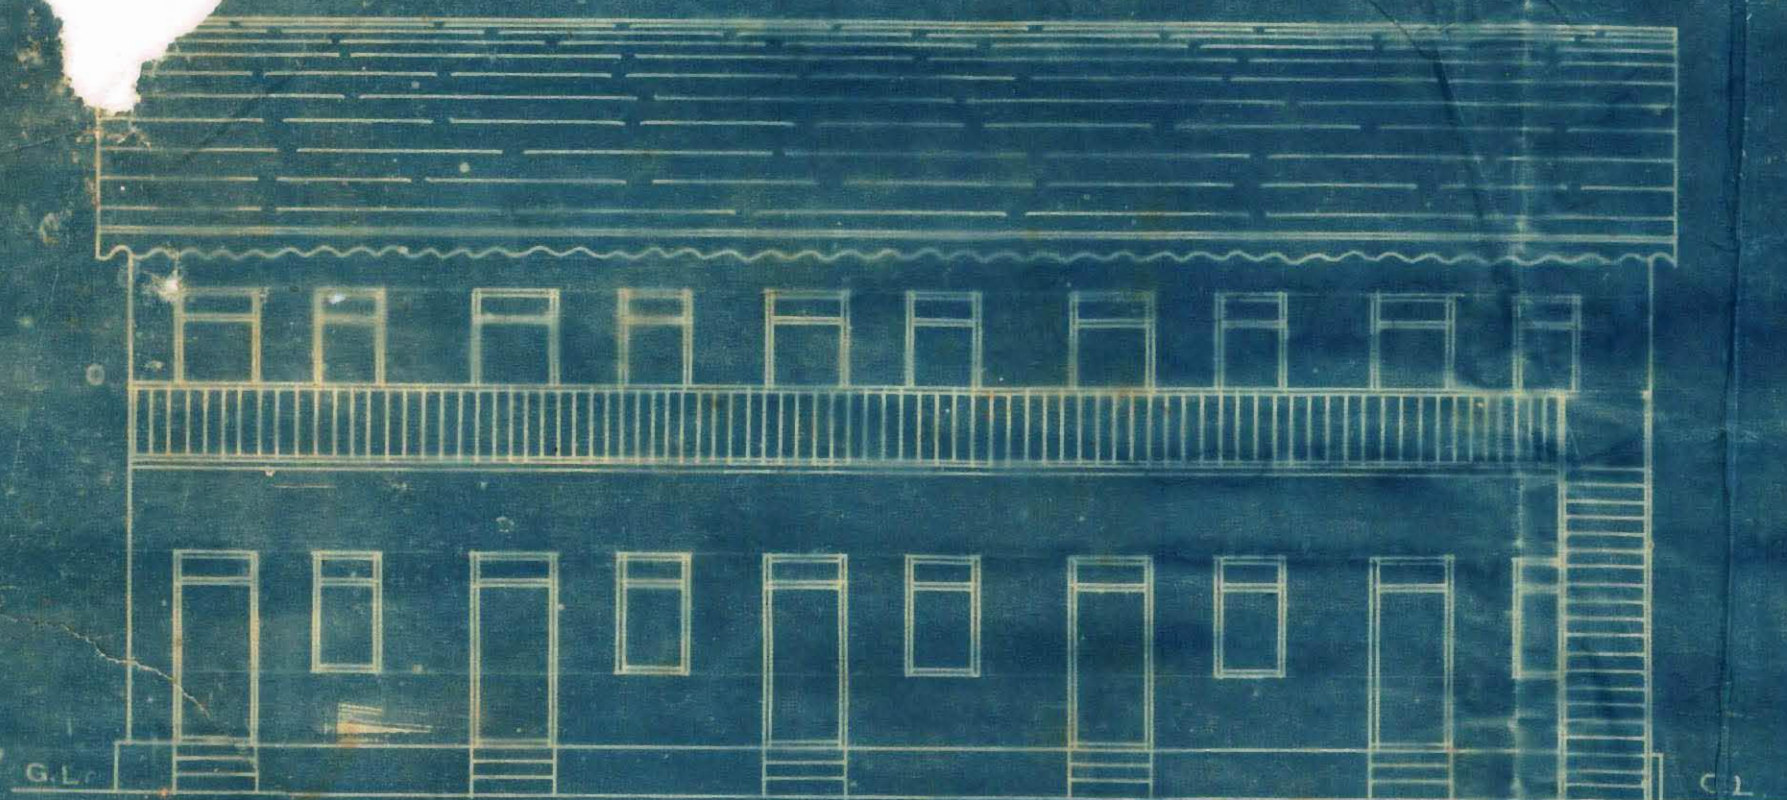

SOUTH ELEVATION


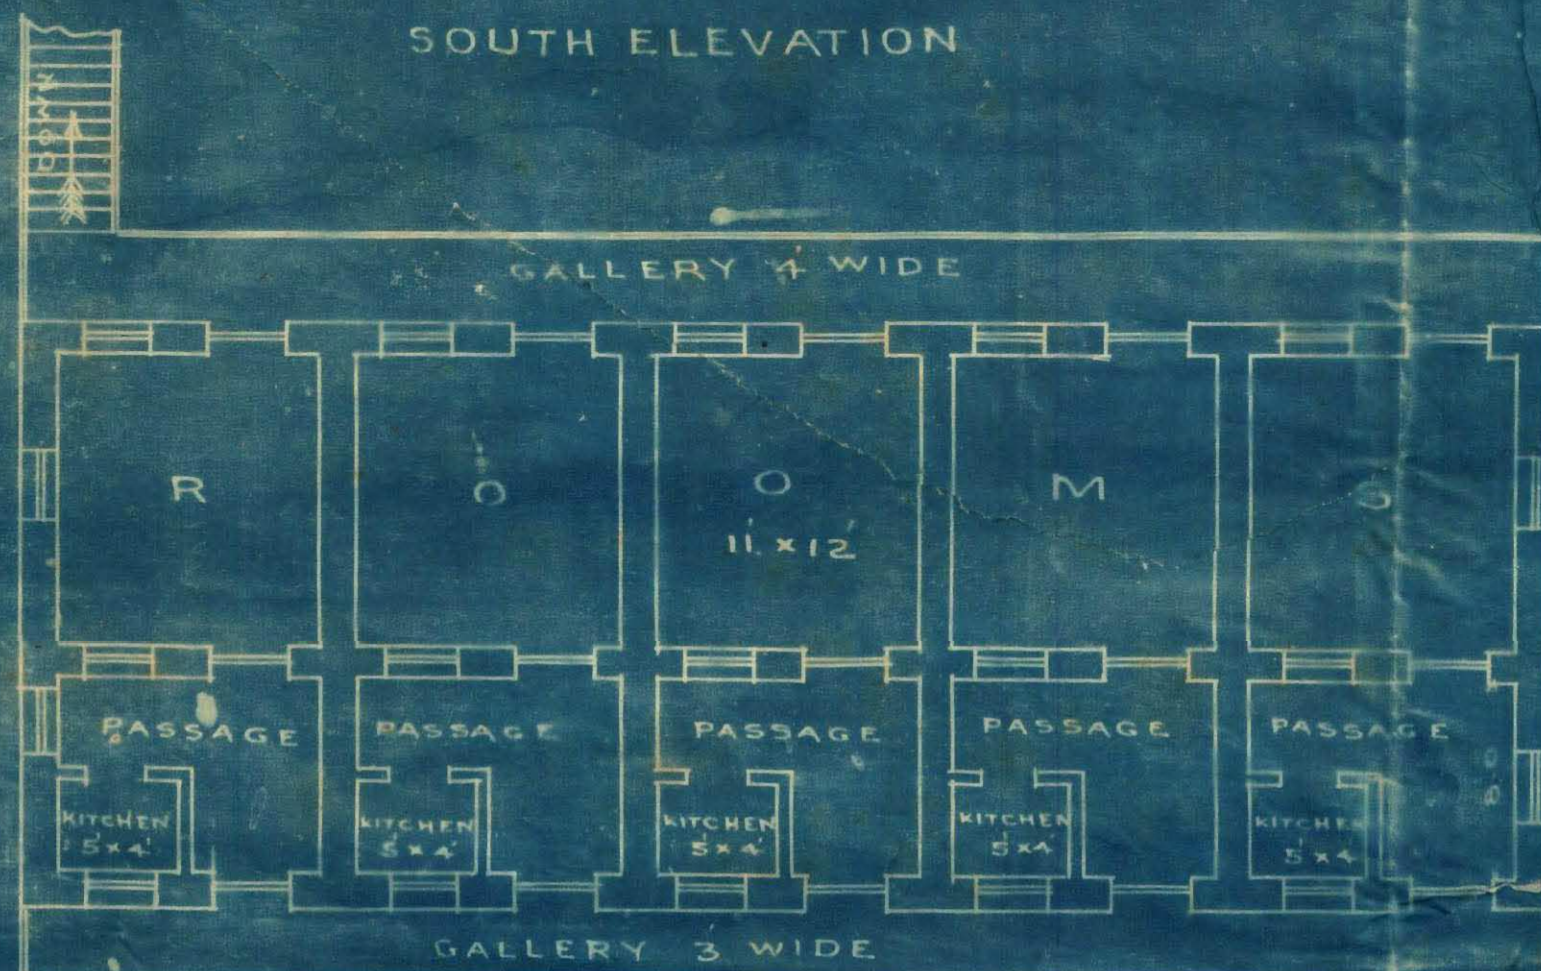


PLAN OF 1ST FLOOR

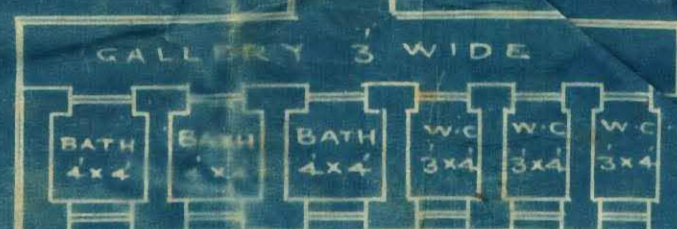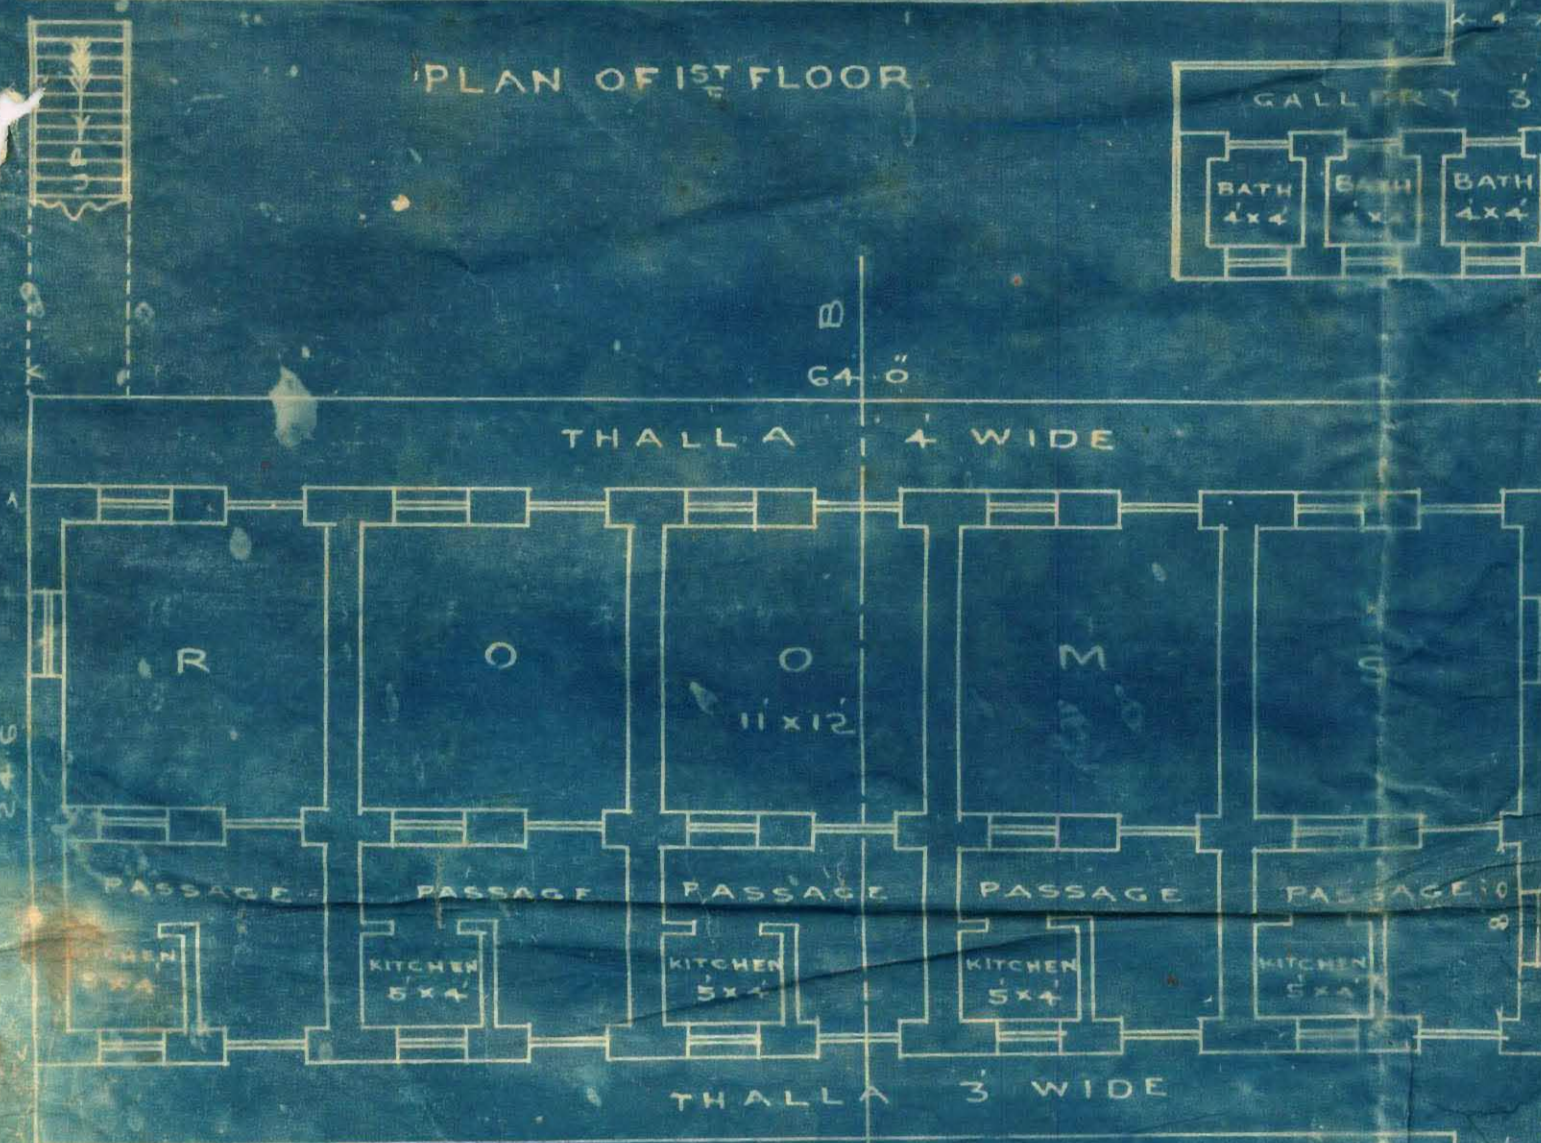

PLAN OF GROUND FLOOR

[BIN BLOCK
RAN]

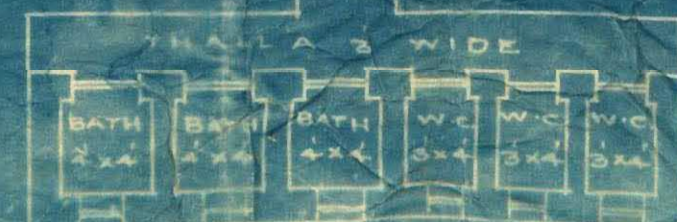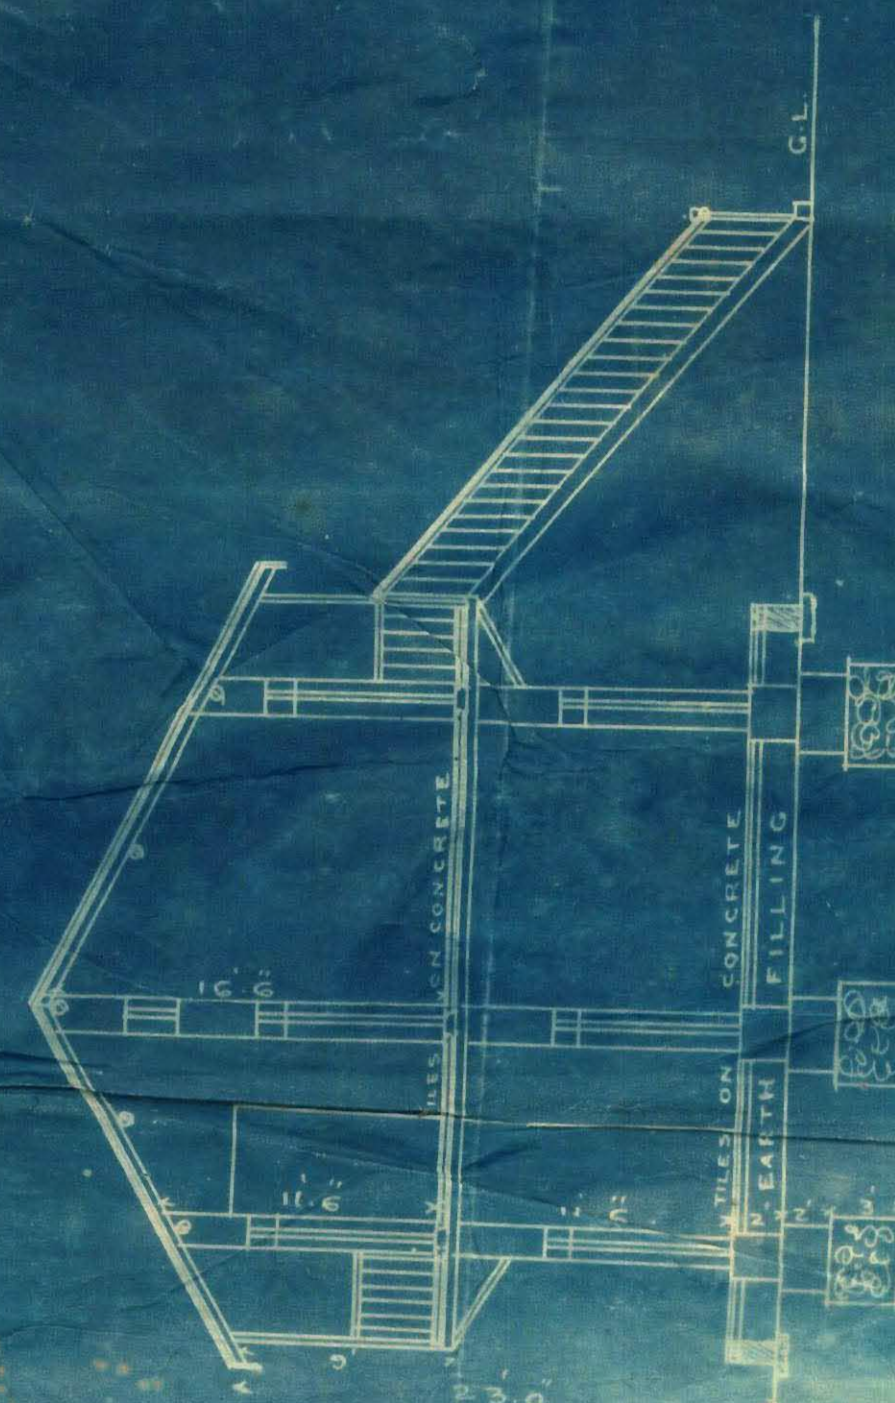

SECTION ON A.B.

M. H. Zarith
12.11.17

10-818-214



80

PLAN OF PROPOSED CHAWL

ON PLOT N^o 4-K. SHEET E.11

GARDEN QUARTER


SCALE 8"=1" INCH.

BLOCK PLAN
SCALE 40'=1"



ROAD 35' WIDE




ELEVATION ON LINE CD

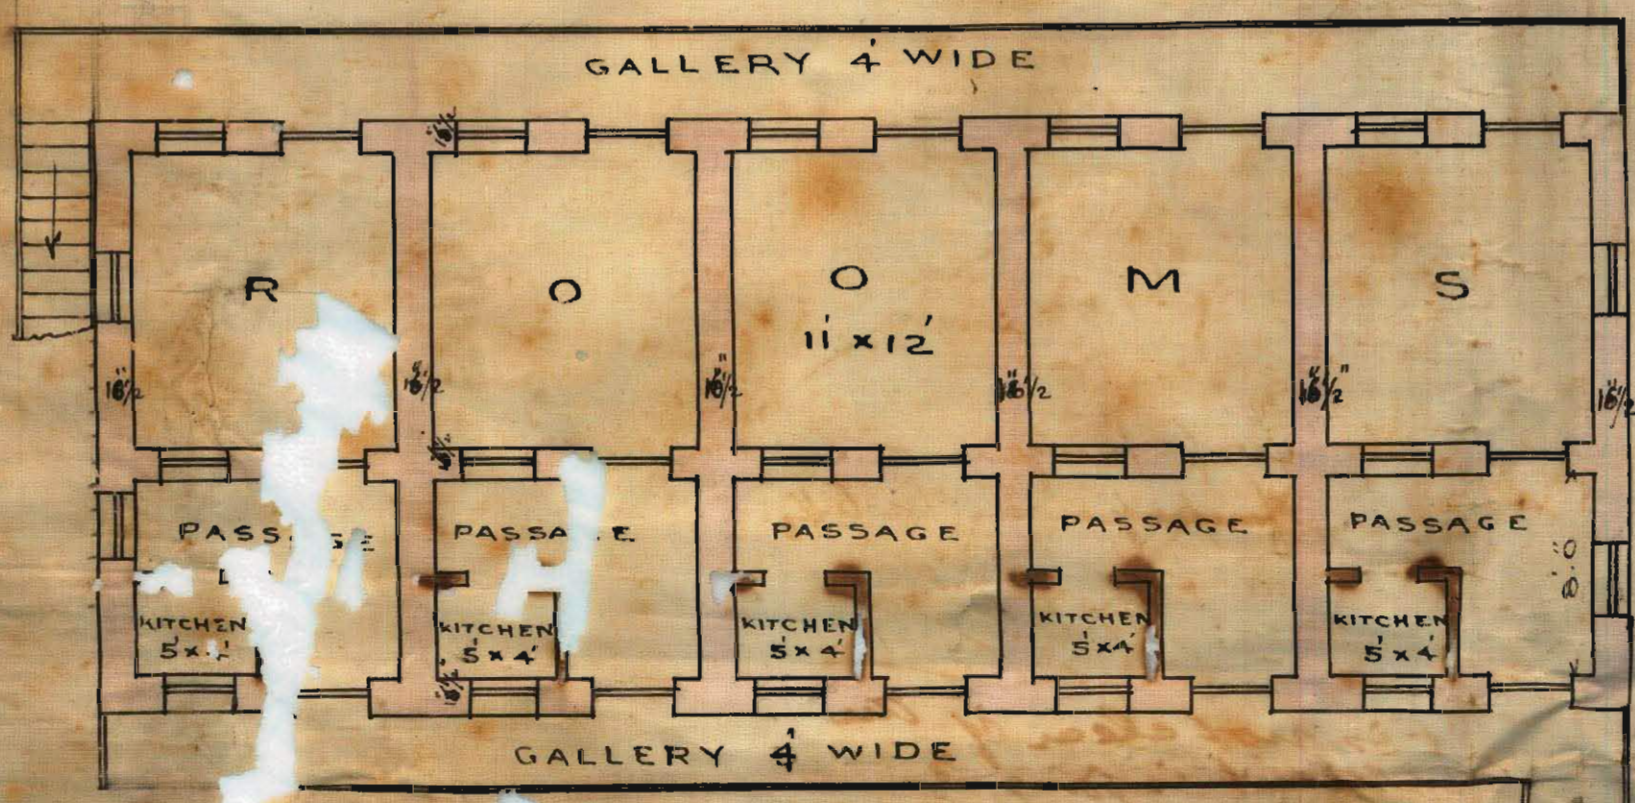

PLAN OF 1ST FLOOR

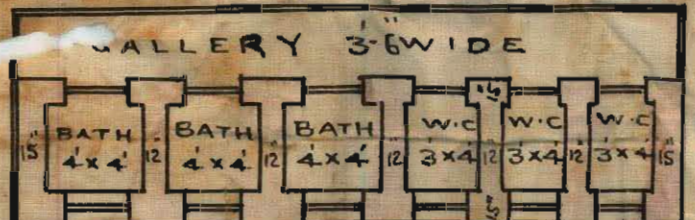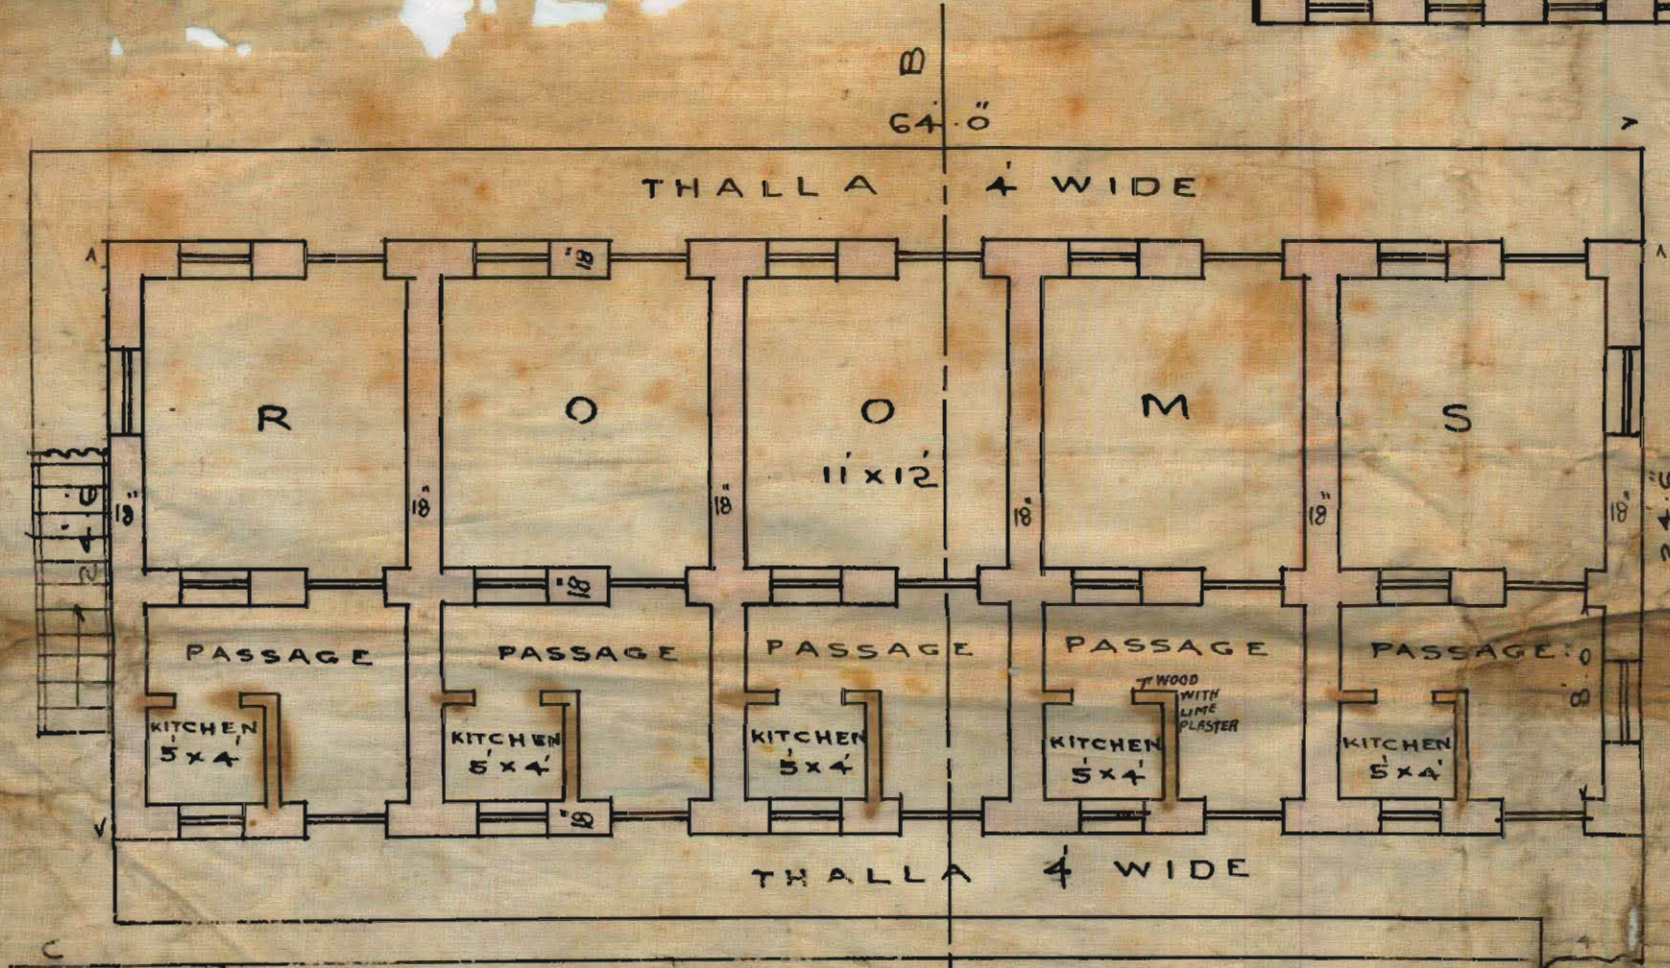

PLAN OF GROUND FLOOR

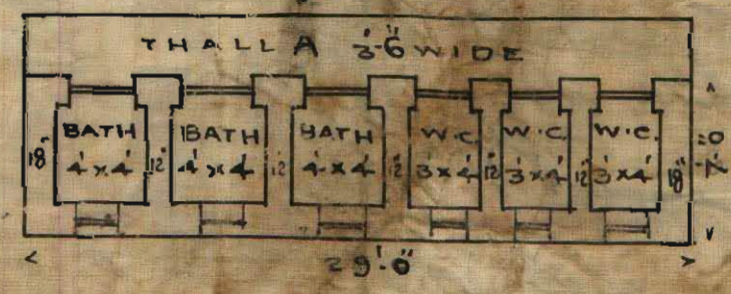


APPROVED


J. G. H. Verley
Architect, C.E.

Engineer.

TOTAL AREA OF THE PLOT	Sq. Yds. 1275
AREA PROPOSED TO BE BUILT UPON, INCLUDING THALLA & BATHS	263

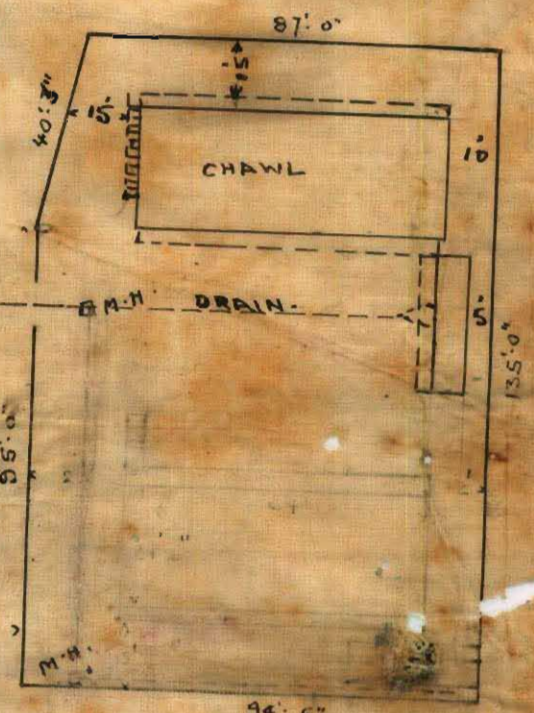

OPEN SPACE *M. K. G. S. S.*
(12-11-17)

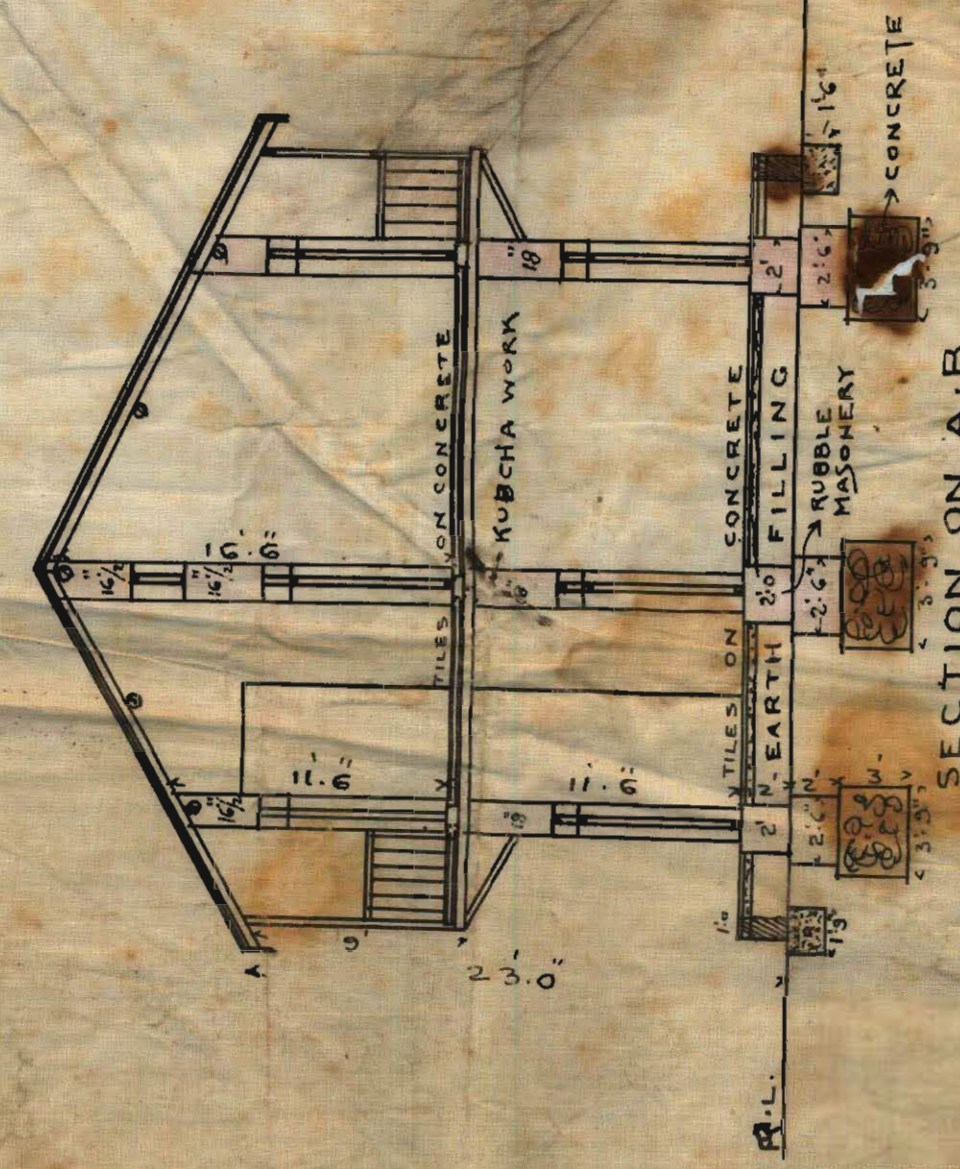

SECTION ON A.B.

B-4

No. E 1035² of 1917.

Municipal Office.

Karachi. 24th November 1917.

26th

MEMO


With reference to the plans submitted by ^{them} him on 12th instant for building on plot No. 4K, E-11 Garden Quarter Messrs Dayaram Gordhandas and Issardas Assanmal are informed that not more than 1/4th of the area of the plot will be allowed to be built on.

Only one building will be allowed on a plot of less than 2000 square yards area in this quarter.

All buildings must be set back to at least 10'-0" from the compound walls.

It must be shown on the plan how ^{they} proposes to connect ^{the} in^{ter} Cs. with the drainage system.

The plans are herewith returned for amendment.

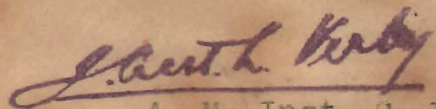

A. M. Inst. C. E.,

E n g i n e e r

Karachi Municipality.

Received the ^{plan} back for
the same as instructed by
Messrs Dayaram Gordhandas



Heritage

2-5 (1)

KMR.CDD.MIQ.1916-1918.01(B)

Sr.

Very brief that the plan is not complete
hence cannot be considered. Request
then to inform the owner accordingly

J R Ramesh

3/11/17

ask applicant to return the same
requesting him to complete the same
return with three more copies.

Nathan

3/11/17

Received the plans back for completing
the same as instructed by the
Land Surveyor.

Goyaram Erdandas

3/11/17



3073
19-11-17

Sir,

They to report that
the owner has amended
the plan as proposed by
the Health officer. Now
it might forward to
the Health officer for
their report.

Yours truly
Nathaniel

12/17

H.O. for report of
report.

15/17

Sub Insp Benjamin
~~for report~~ Show to H.O.

19/17

AS

It is not clear if the
applicant is going to
connect his premises with
the drainage. If so, it
will be necessary to show
on the plan how the
connection is to be made.

21/17

Edwards

Land Survey
fill in application form trace up
with Survey sheet. 11.25/17