



Heritage

KMR.CDD.GaQ.1921.01

BUILDING COMPLETION REPORT.

MUNICIPAL OFFICE,

Karachi, 9th June 1921.

To,

THE ENGINEER,

KARACHI MUNICIPALITY.

SIR,

I beg to report that the building work on plot No. 2C.

sheet

I 11

Garden

Quarter owned by

Mr.

Noshing Dosa Bahian

is completed

according to the plan approved by this office.

Copy to the A/c for information

Yours obediently,

Broasani
Building Surveyor, " 1 " Section,

Karachi Municipality.

M. C. A. M. I. C. E.

Engineer,

Municipality



Heritage

KMR.CDD.GaQ.1921.01

Form No. 6-400-30-4-21

No. L. S.

OF 1921

12/3

MUNICIPAL OFFICE :

Karachi

3

1921

MEMO :

Building Surveyor Section

is informed

that Mr. *Kishanji Dasa Kachari* has been permitted

to *build a lungalow*

~~his house~~

on plot No.

2 C

11

Street,

Garden

Quarter, report should be made to the


undersigned when the house is completed.

[Signature]


M. C., A. M. I. C. E.,

Chief Engineer,

Karachi Municipality.

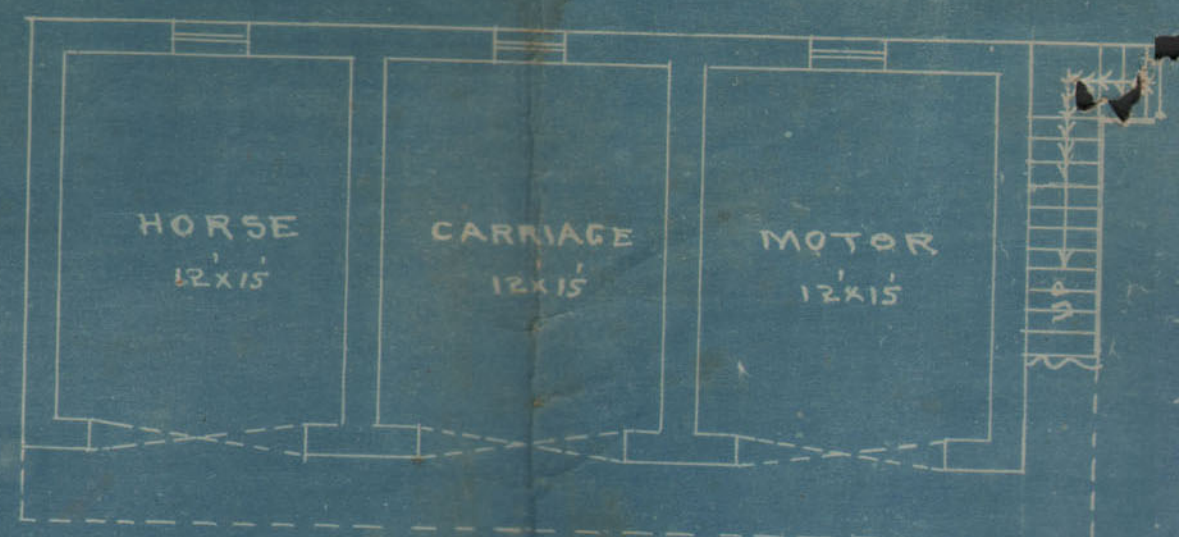


GROUND PLAN

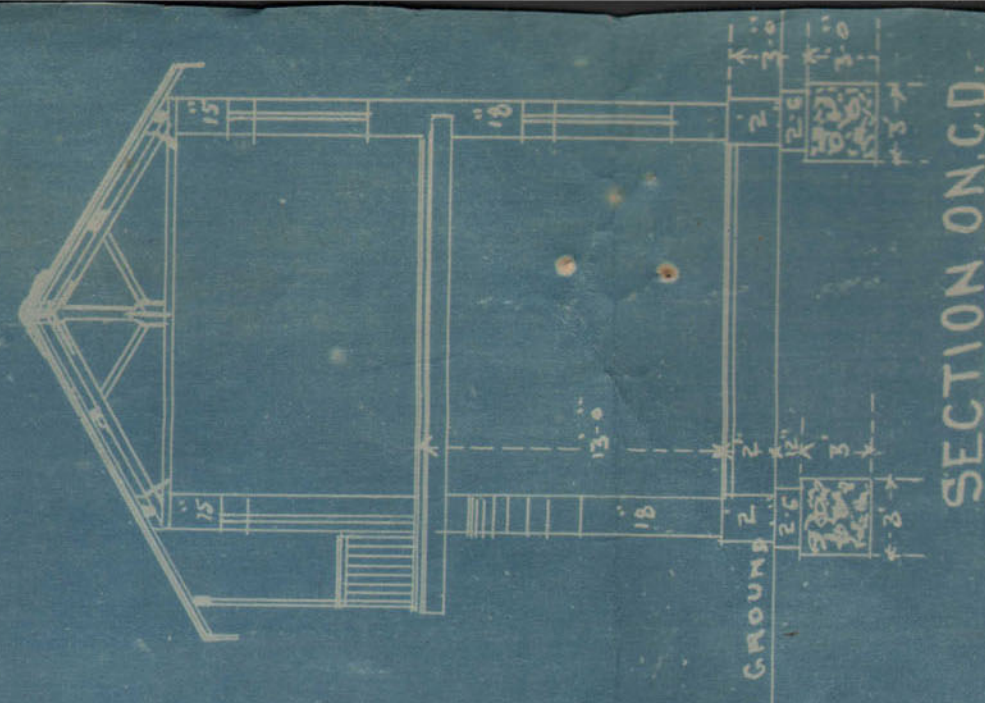

SECTION ON C.D.



SECTION ONE

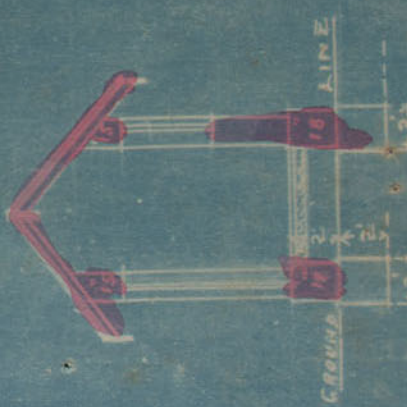



ELEVATION




No. 173

BLOCK PLAN
SCALE 20' = 1"


AMENDED PLAN
OF BUNGALOW ON PLOT NO. 2.C. SHEET III
GARDEN QUARTER
SCALE 8' = 1" INCH

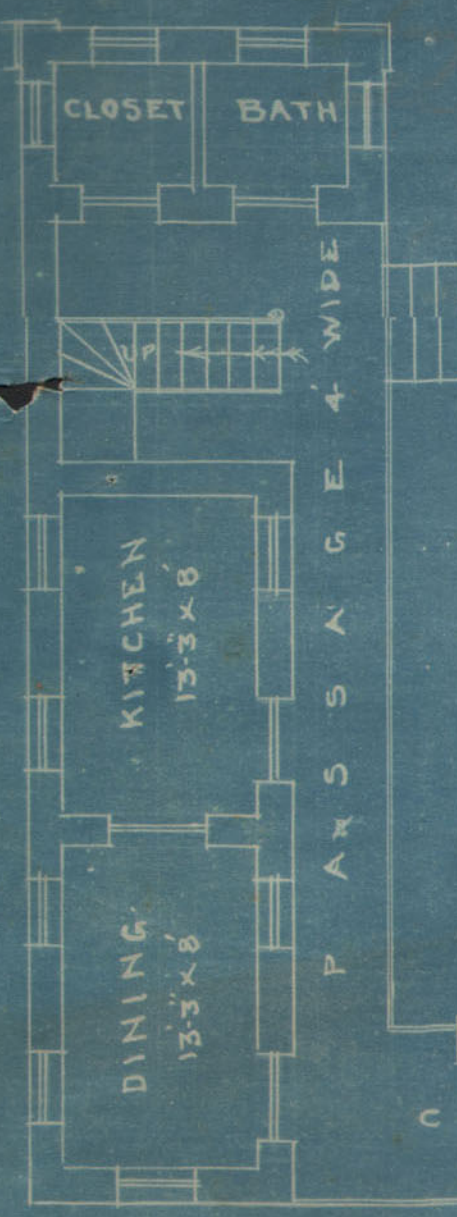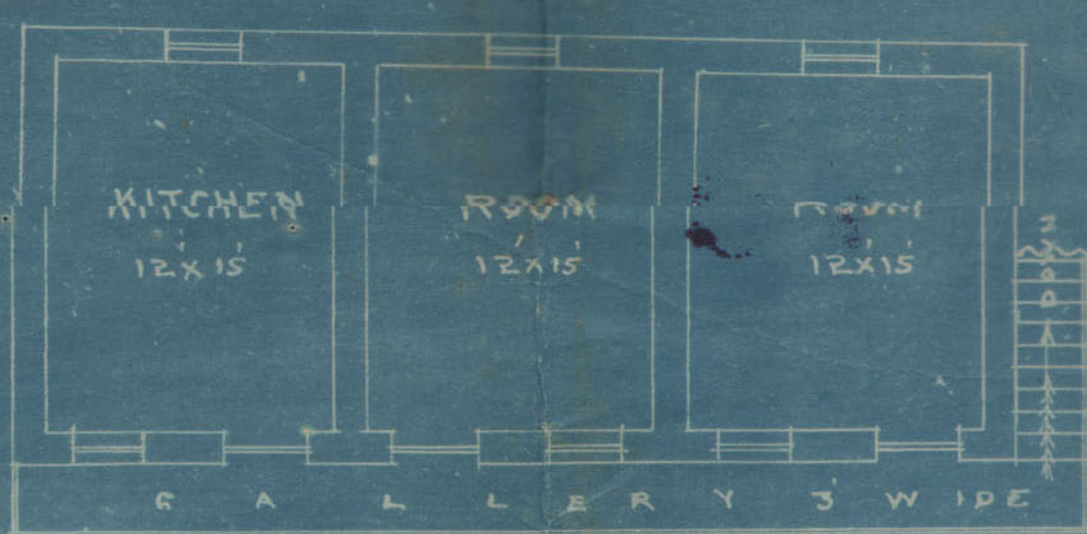


FIRST FLOOR PLAN

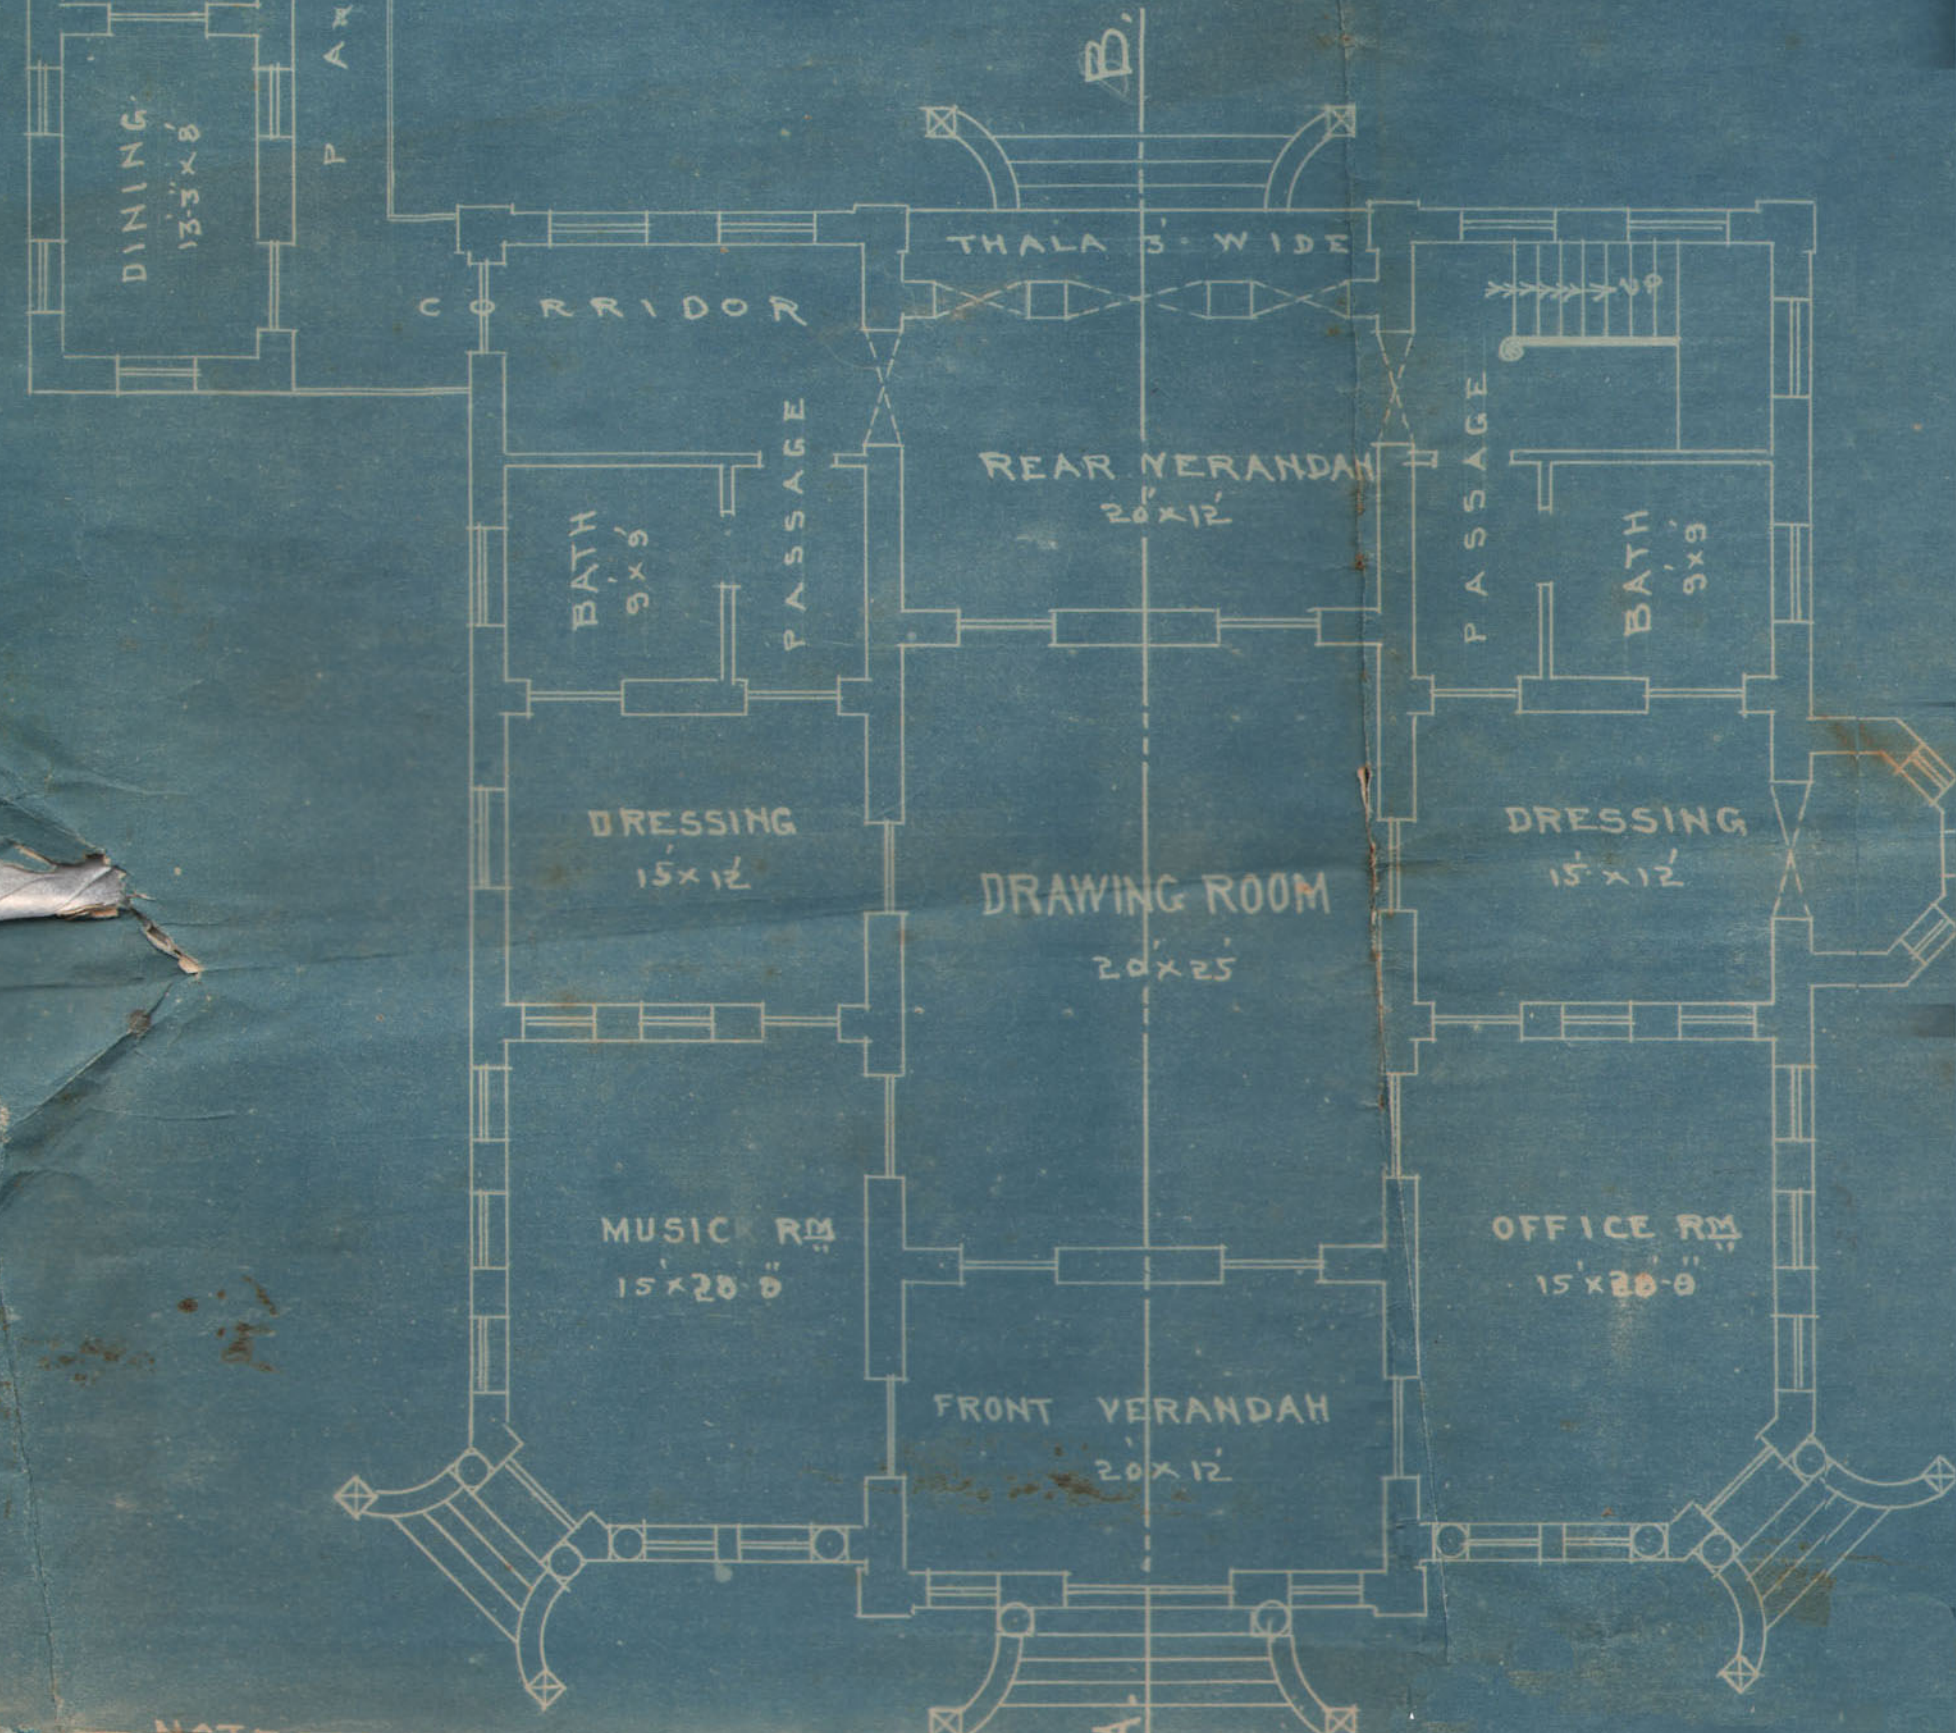

SECTION ON A-B.

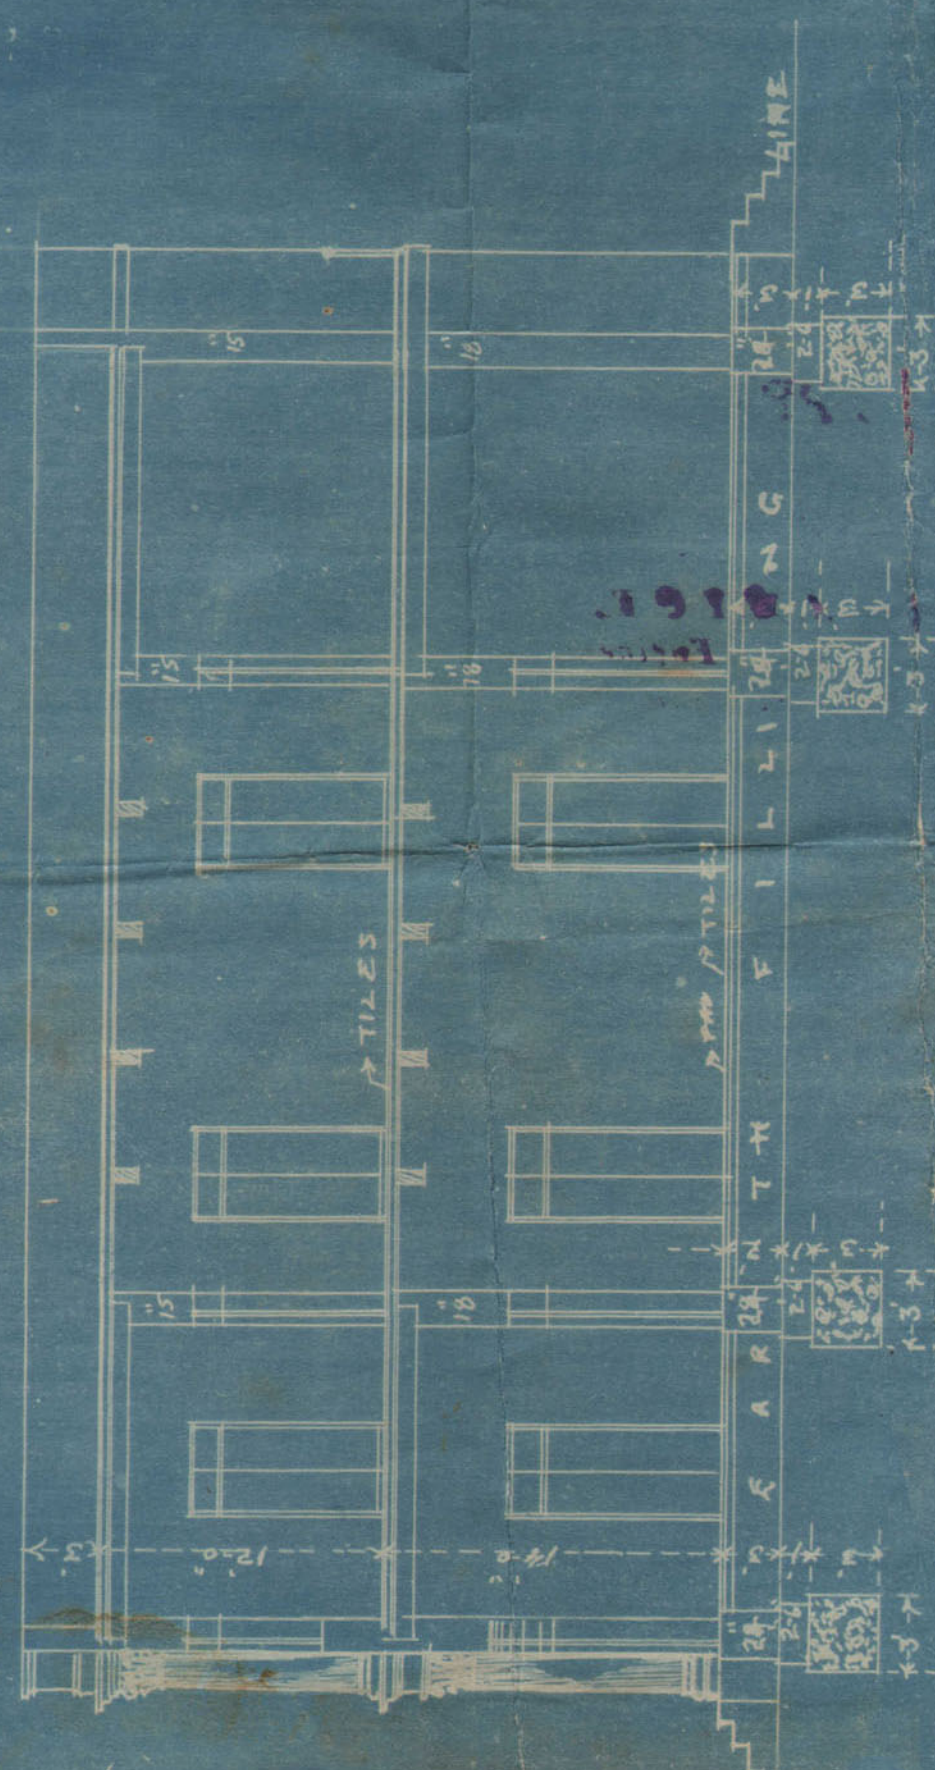

APPROVED
D. Banington Buns
1910
F. C. J. R. C. E.
Engineer.
Karachi Municipality

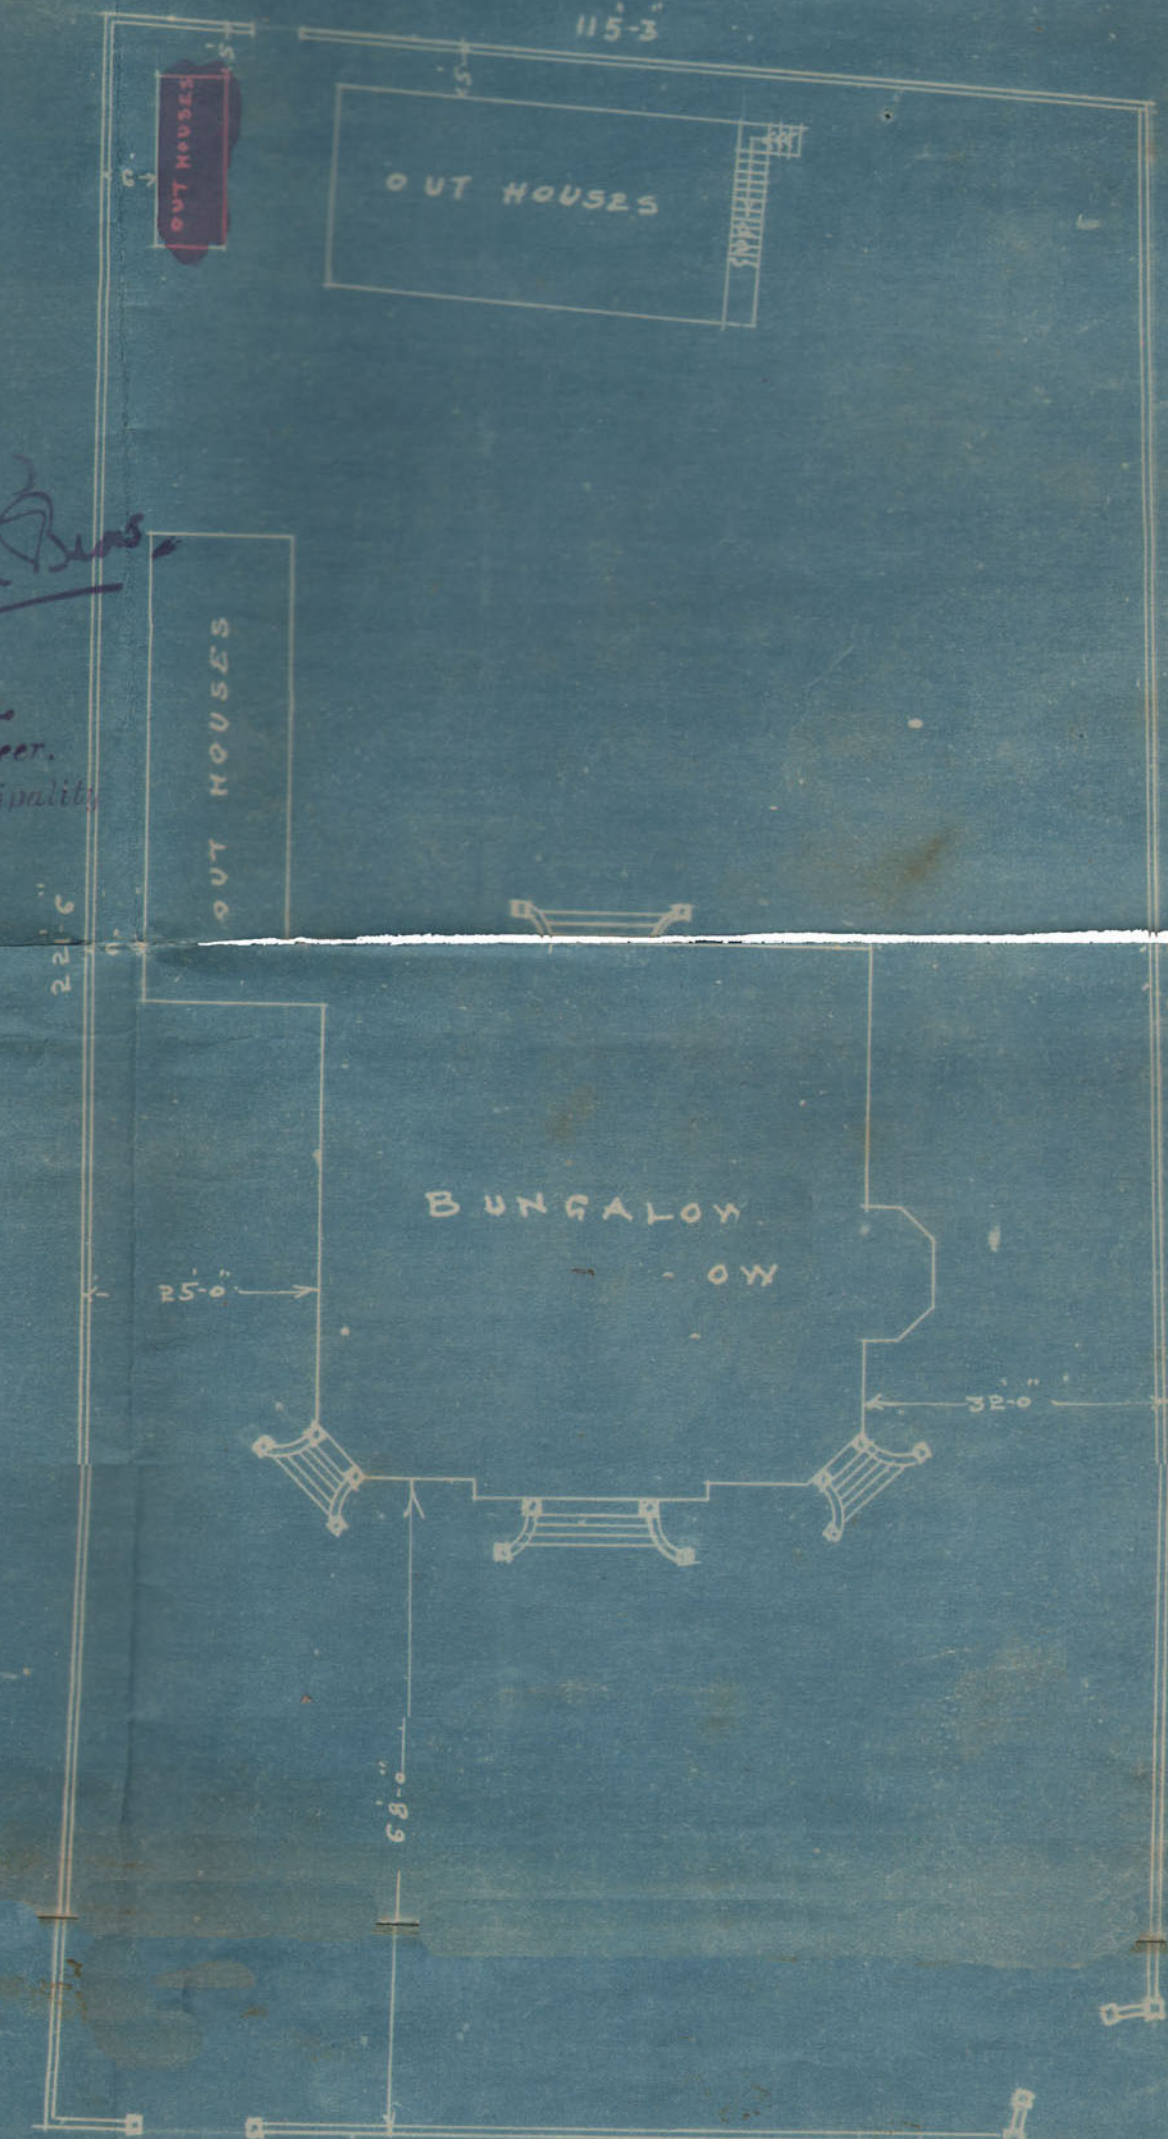

AREA UNDER BUILDINGS 587

GROUND & FIRST FLOOR PLAN

Architect & Surveyor