



Heritage

KMR.CDD.PrQ.1920.02

Form No. 6.

No. L. S.

887

OF 1920

No. 30

MUNICIPAL OFFICE,

Karachi

9/2/10

1929

MEMO :

Building Surveyor Section

A

is informed

that Messrs G. V. Schuff & G. N. Kharegar has been permitted

to build travellers bungalow & additions & alterations

his house

on plot No.

14

F3

Vecharia Road

Street

Preedy

Quarter report should be made to the


Undersigned when the house is completed.

Hakimullah

A.M. INST. M.E.,

1929, Engineer,
Karachi Municipality.

GROUND & FIRST FLOOR PLAN

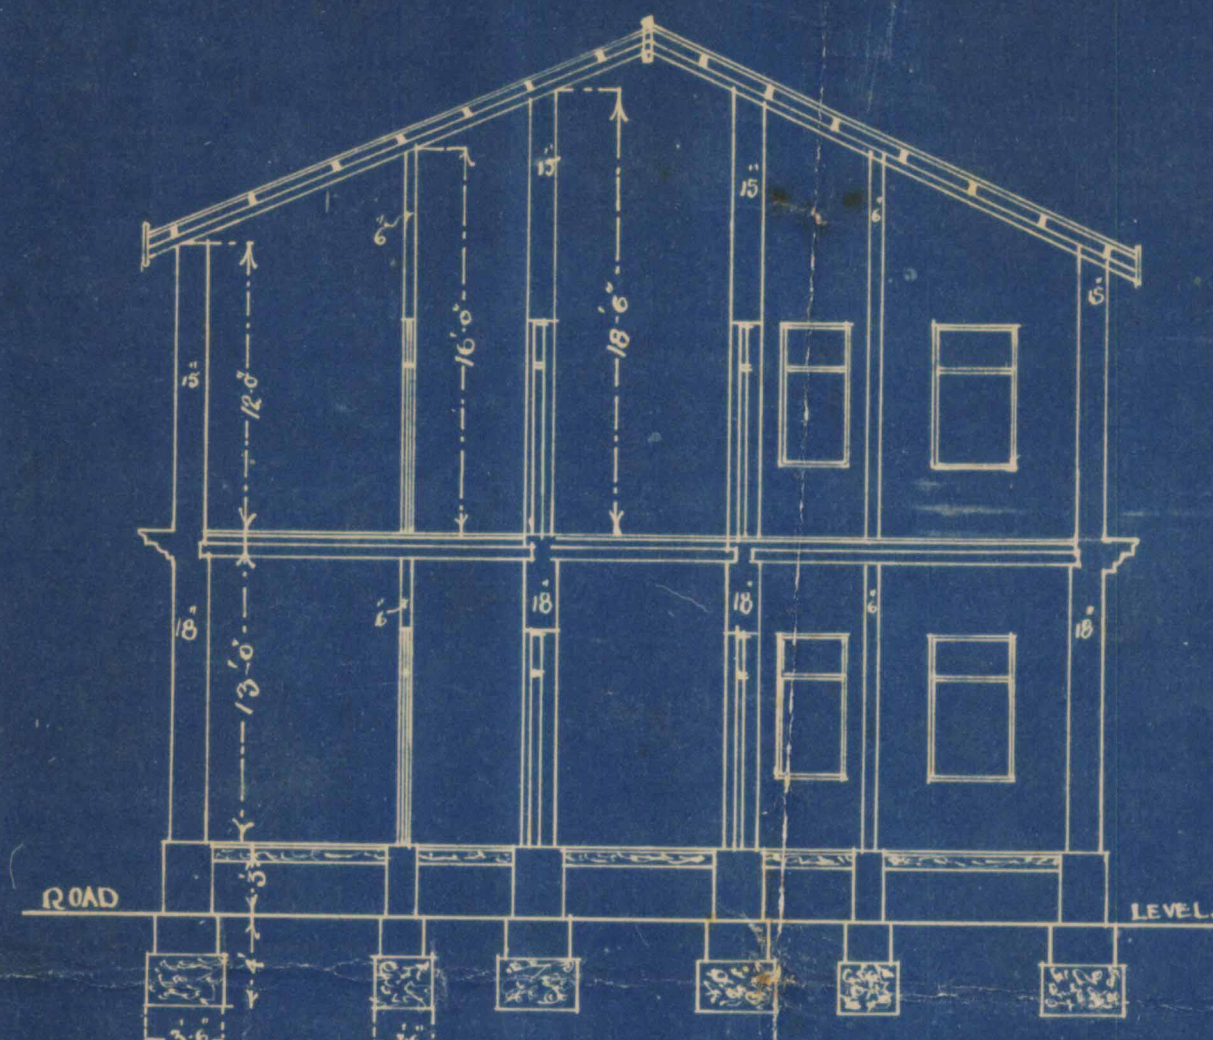


SECTION ON LINE A.B



- FRONT ELEVATION

PROPOSED PLAN FOR TRAVELLERS' HOUSE
ON
PLOT NO 14 SHEET NO P-3.
SCALE 3 FT TO AN INCH

SITE PLAN
SCALE 40 FT TO 1 INCH

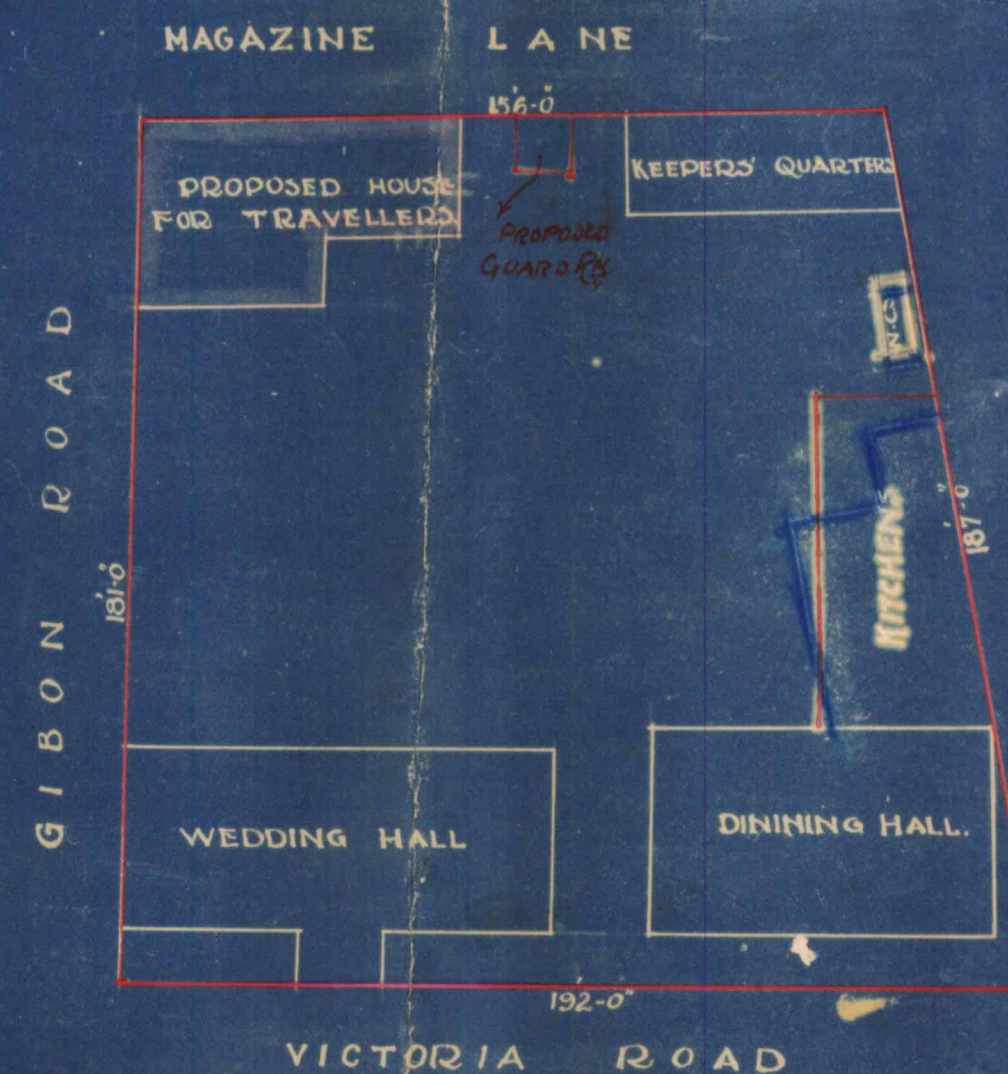

MISRI & BHEDWAR
ARCHITECTS & ENGINEERS



Heritage

KMR.CDD.PrQ.1920.02

No. L. S. 4854 OF 1920

Form No. 6.

MUNICIPAL OFFICE,

Karachi 15 8 1929

MEMO :

Building Surveyor Section A is informed
that Messrs C. D. Shroff & E. V. Khanpot has been permitted
to build a Hall.

his house
on plot No. 14 F3 Sebban Street

Ready Quarter report should be made to the
Undersigned when the house is completed.

M. Khanmurt

A.M. INST., A.E.,

as Engineer,

Karachi Municipality.



Heritage

KMR.CDD.PrQ.1920.02

Building Completion Report.

MUNICIPAL OFFICE,

Karachi, 25 April 1921.

To

THE ENGINEER,

KARACHI MUNICIPALITY.

SIR,

I beg to report, the building work on plot No. 14 Sheet 73.

Preedy Quarter owned by Messrs. E. D. Shroff & N. Khargab
is completed according to the plan approved by the Municipality. Orders are
requested to file the correspondence.

Yours obediently,

Browder

Building Surveyor "A" Section,
Karachi Municipality.

File
D




Heritage
FOUNDATION

KMR.CDD.PrQ.1920.02

25

No 196

— SITE PLAN —
— SCALE 40 FT TO AN INCH —
MAGAZINE LANE

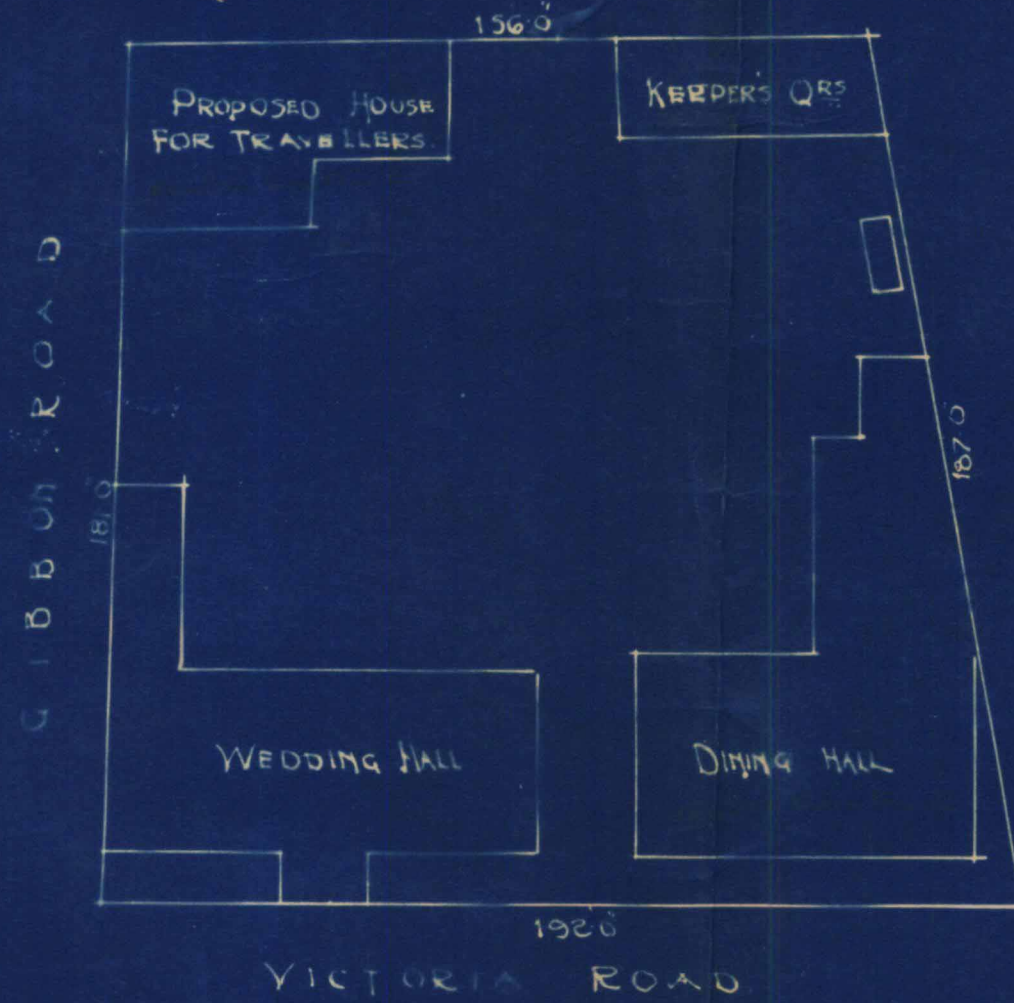

— AMENDED PLAN —
— FOR —
— PLOT NO 14 SHEET NO F-3 —
— SCALE 8 FT TO AN INCH —

NOTE
New work shown in Red.



— SIDE ELEVATION —

— WEDDING HALL —
87'0" x 35'0"

— GROUND FLOOR PLAN —

APPROVED
M. I. M. P.
J. J. J. J.
J. J. J. J.

BY ORDER OF
MISTRY & BHEDWAR
— B.A.S. I.C.E.S. —
— ARCHITECTS & CIVIL ENGINEERS —

Memo.

14/12/20

With ref^s to his letter dated 5th Dec 20,
with an ^{amended} plan for the ^{new} ~~re~~ ^{new} ~~year~~ ^{new} ~~room~~ ^{room}
& with a traveller's Bungalow on
Plot No. 14 F3 Pready Q, Mr.
D.H. Tharwala on ~~behalf of~~
is informed there is no objection.
One plan is returned herewith
duly approved.

Heck

M. I. M. Es.,
Acting Engineer,
Karachi Municipality.



14p 73 Preedy Quarter

Forwarded to the Health
Office for favour of
report.

M. I. M. E.,
Acting Engineer,
Karachi Municipality.

No objection

10 12 20

Submitted with report there
is no objection

10/12/20

Submitted to the Engineer
for order there seems no
objection to grant pass for
the proposed addition &
alteration.

N. A. H. Khan

10 12 20

No objection

M. I. M. E. 13/12

MISTRI & BHEDWAR,
B.A.'s., L.C.E.'s.,
ARCHITECTS, ETC.,
D. H. Daruvala, B. E.,
Representative.



KMR.CDD.PrQ.1920.02
Karachi, ^{5th} December, 1920.

To,

The Engineer,

Karachi Municipality.

Karachi.

Dear Sir,

RE: BUILDINGS ON PLOT NO. 14, F-3.

We have the honour to submit herewith amended site plans for the above, showing the deviations in red.

- (1) The w.c.s in travellers' quarters are placed out-side the building.
- (2) The location of the guard room is shifted from its original position to one marked in red.

We shall thank you to kindly sanction the above deviations.

We have the honour to be

Sir,

your most obedient servants

S. H. Daruvala
MISTRI & BHEDWAR.
Architects.

*Printing Surveyor Section "A" for F.C.
and reply. Nathial
7/10*



Heritage

KMR.CDD.PrQ.1920.02

PLOT NO. 14 SHEET NO. F3

SITE PLAN

SCALE 40 FT TO 1 INCH

MAGAZINE LANE

GIBBON ROAD



VICTORIA ROAD

M. D. D. S. Ch
MISTRI & BHEDWAR
ARCHITECTS & ENGINEERS