




NORTH ELEVATION

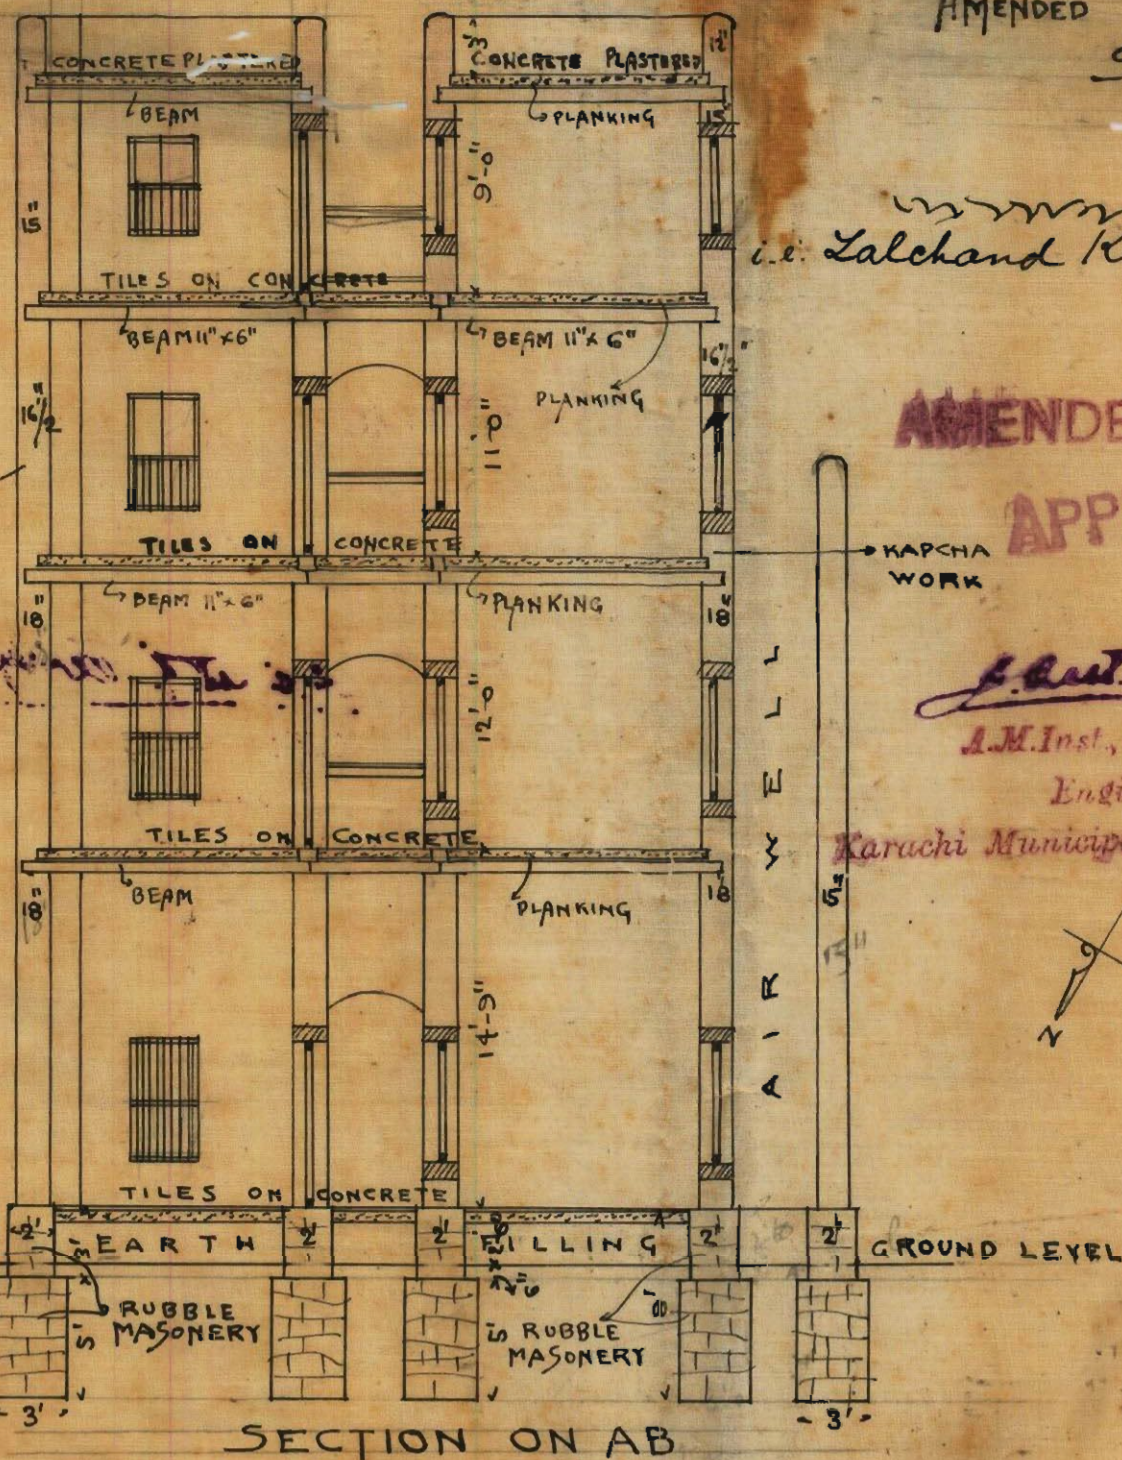

SECTION ON AB



AMENDED PLAN OF BUILDING ON PLOT NO. 107
SHEET A-24 NAPIER QR
Scale: 8"=1"

46


NOTE: PORTIONS ALREADY APPROVED
LEFT UNCOLOURED
i.e. Lalchand Khushaldas.
BLOCK PLAN
SCALE 20"=1"
M. Margareth
5th Feb. 1918

AMENDED PLAN
APPROVED.


L. A. H. Puri
A.M.Inst., C.E.
Engineer,
Karachi Municipality

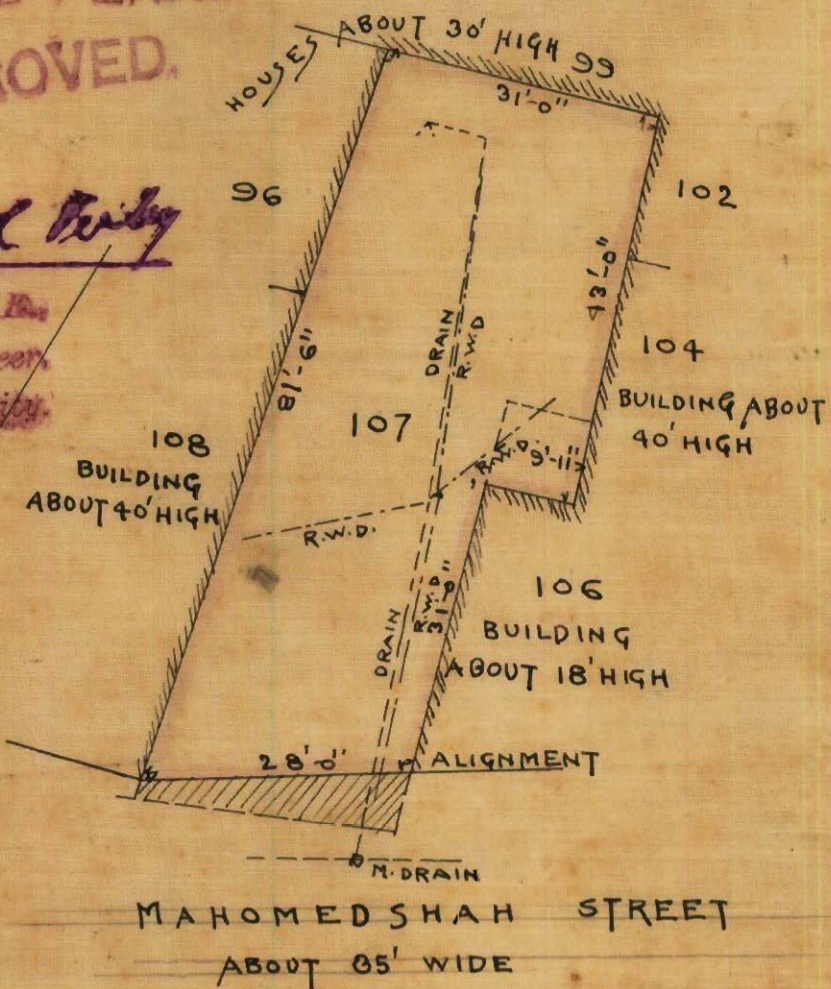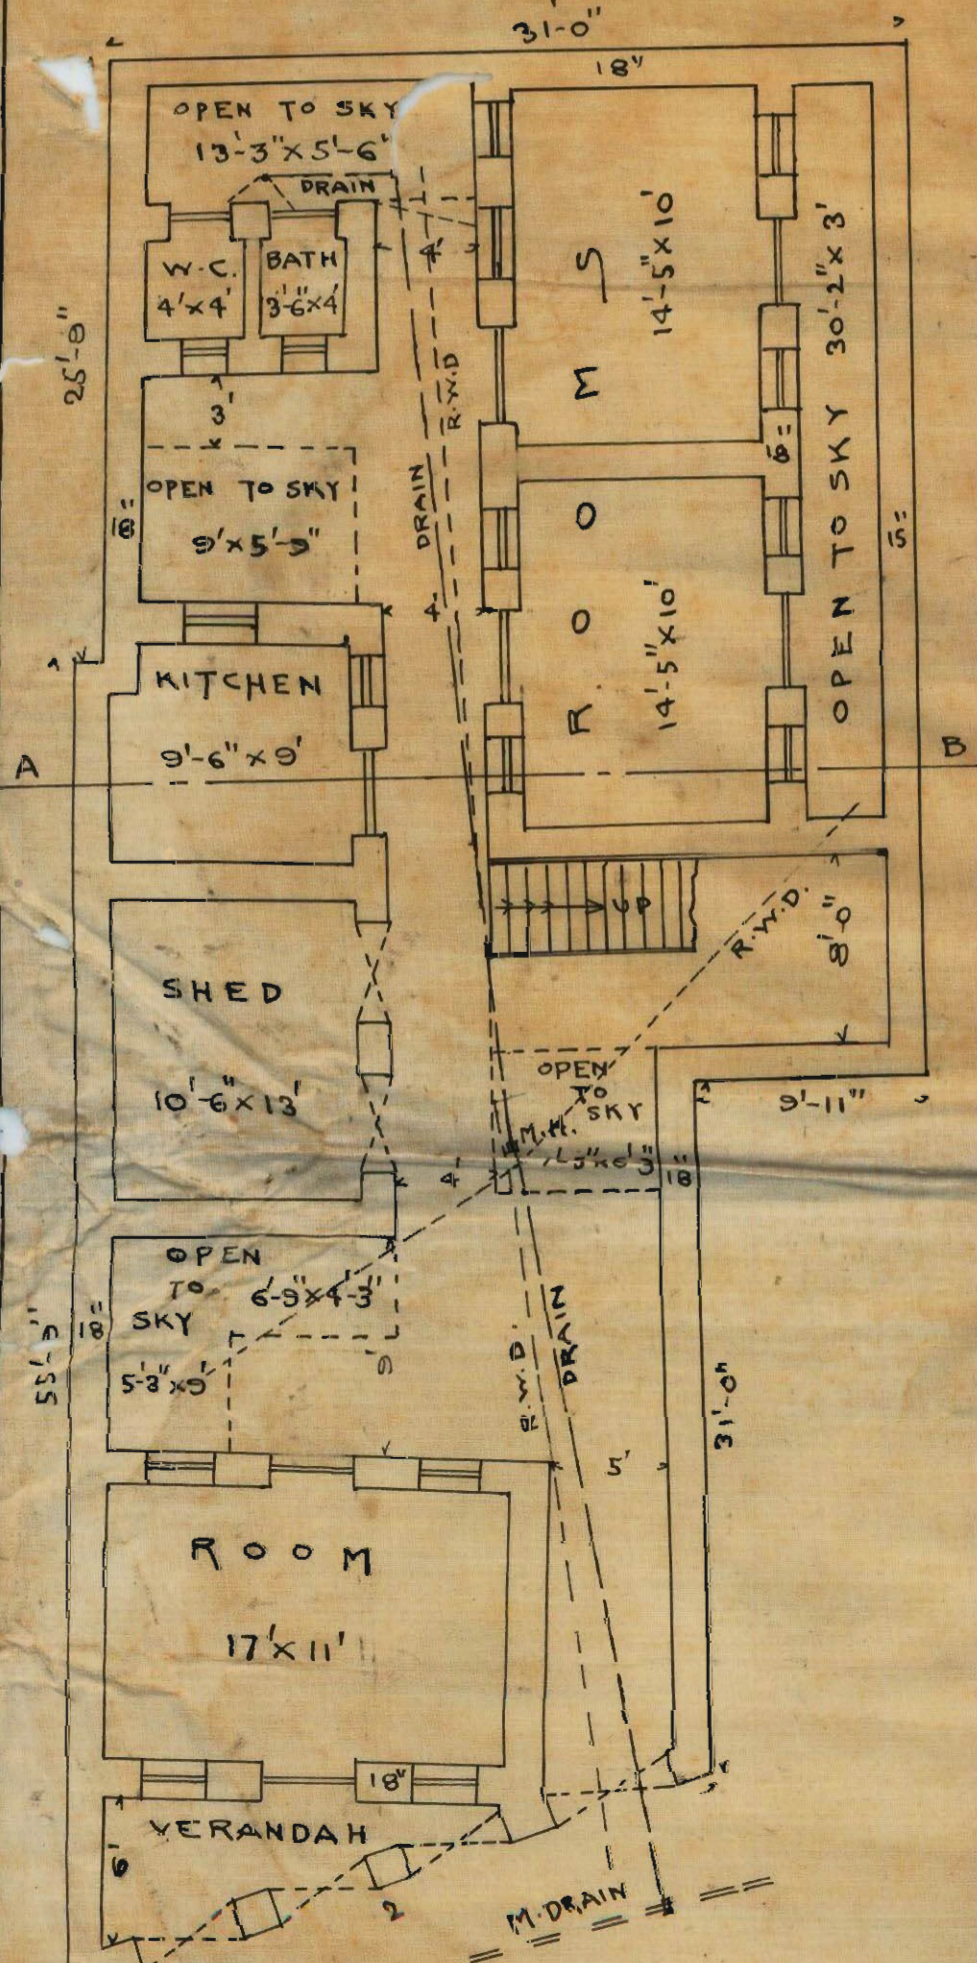

PLAN OF GROUND FLOOR

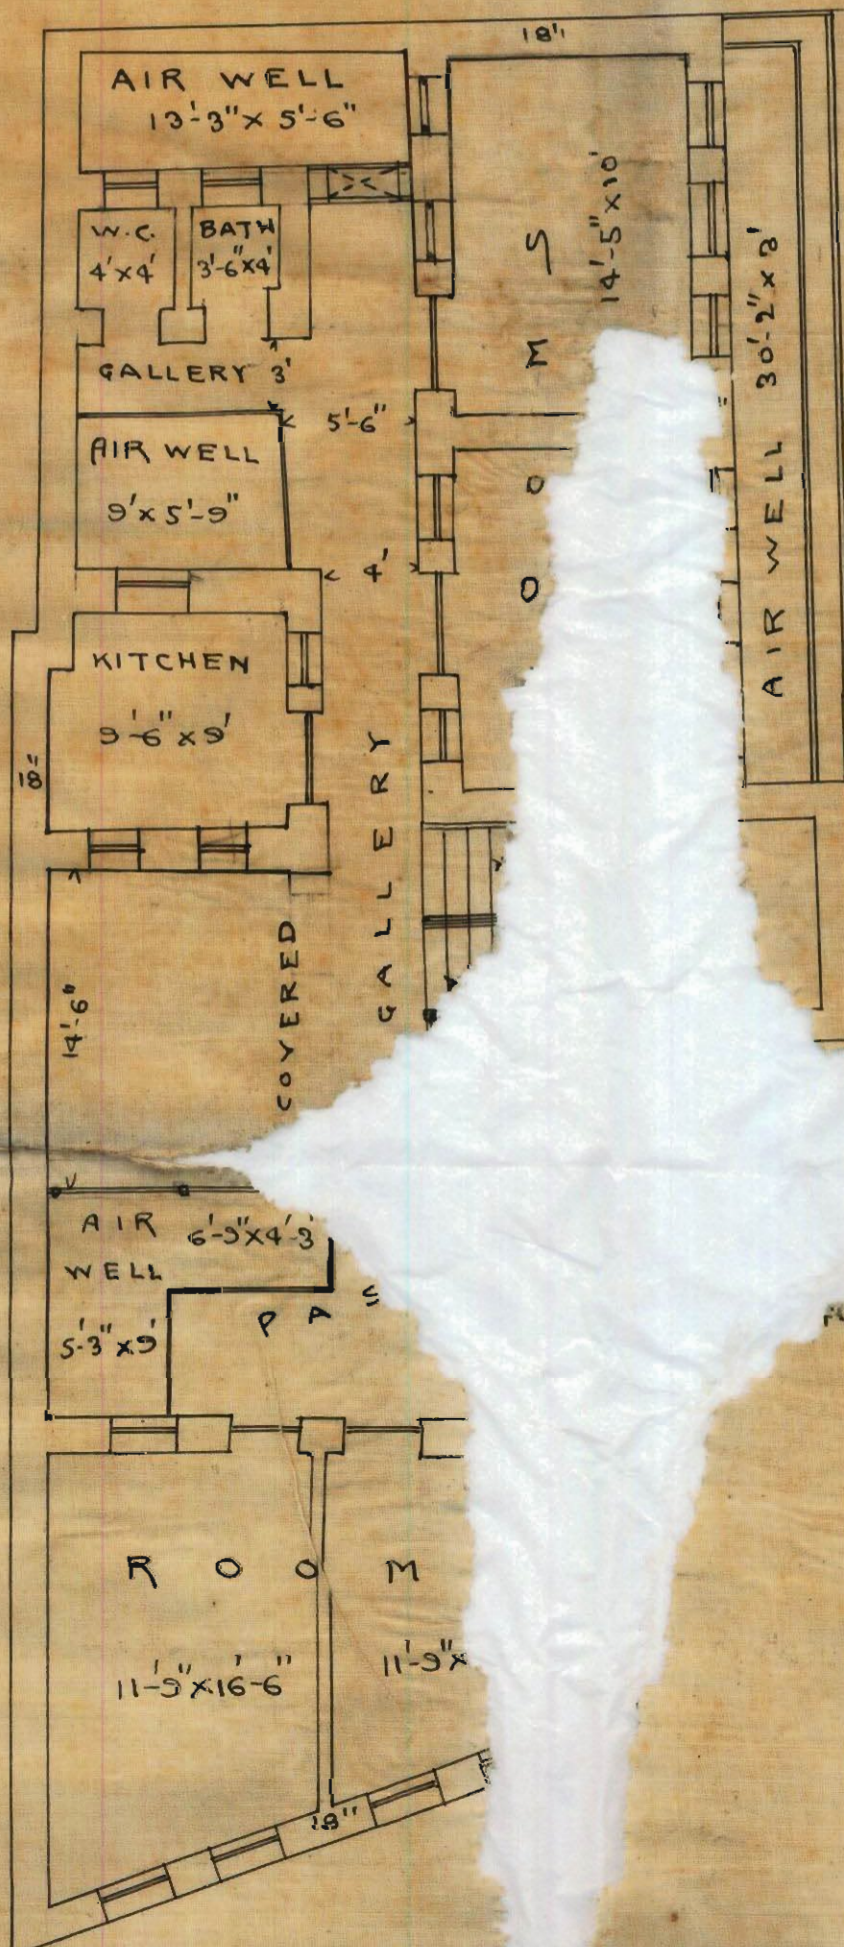

PLAN OF 1ST & 2ND FLOORS

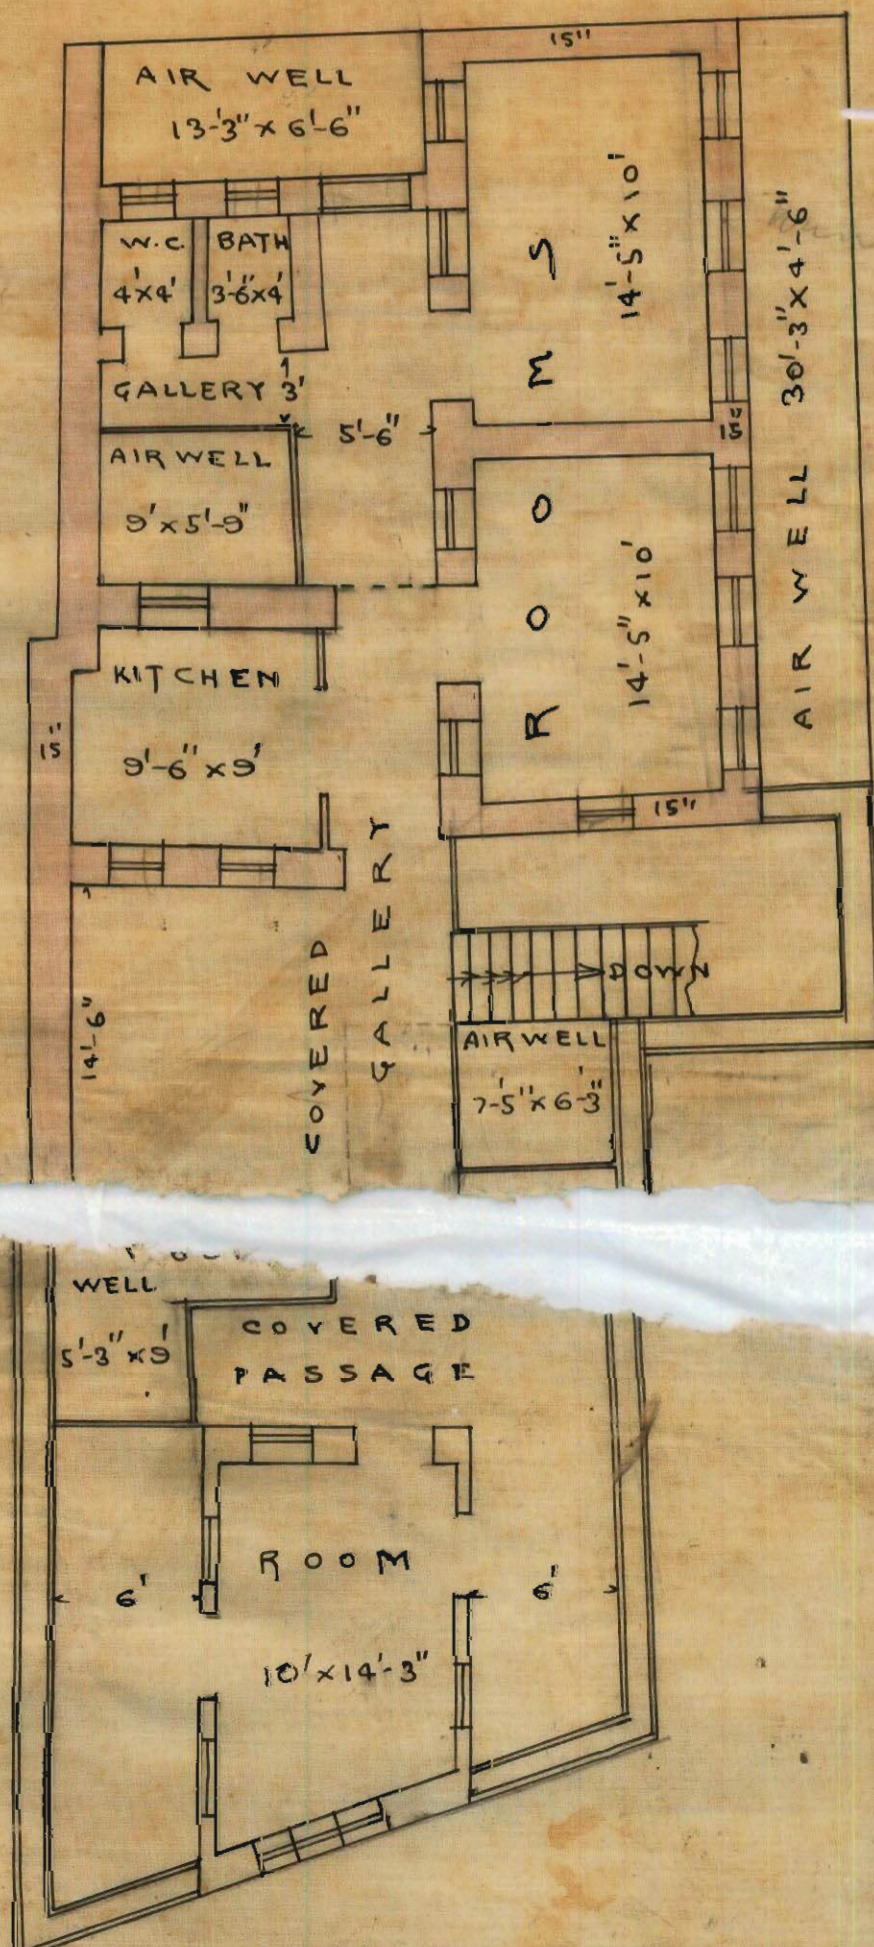

PLAN OF 3RD FLOOR

F1

(200-1-10-17).

Form No. 2.

ORDERS UNDER SECTION 96 (2) OF ACT, III OF 1901.

No. E/

2279

OF 1918

2627

46

MUNICIPAL ENGINEER'S OFFICE,

Karachi, 10th March 1918.

MEMO.

With reference to his application, dated 4th Feb: 1918,
Mr. Lalchand K. Shukhaldas is informed
amended that the plan submitted by him for building a house
on plot No. 104, Survey Sheet A 24,
situate in Mahamedshah Street, 7th Aperi
Quarter, is approved, and permission to build in accordance therewith is
granted. The building to be erected subject to the By-laws and Rules of the
Municipality.

L. A. M. INST. C. E.

A.M. INST. C. E.,

Engineer,

Karachi Municipality.

Ph SK

NOTICE 1.—This pass does not give permission to occupy Municipal land with building materials. This can only be allowed when the street is wide enough to permit building materials being deposited on it without it being a source of danger to the public, and only then on a hoarding being placed round the land to be occupied, and on payment, in advance, of fees for occupation of Municipal land, at the following rates:—

	Rs.	A.	P.
(1) For the first three months, per square yard per diem ...	0	0	$\frac{1}{2}$
(2) For the next three months " " " ...	0	0	1
(3) For any subsequent time " " " ...	0	0	2

NOTICE 2.—Windows, steps and doors of the building will not be permitted to project on or overhang any public street or Municipal land.

NOTICE 3.—Plinths will not be allowed to project more than 2' on any public street for ornamental purposes.

2280
Building
Copy to the Engineer

1 report 20

F2C15

G. B. K. Verley 11th February 1918

To

The Engineer,
Karachi Municipality

Sir. I beg to submit an amended plan for building on plot No 107. Sheet No. 24 Napier Quarter. The portions for which approval is now required is shown in red on plan & consists as will be seen of three rooms in place of a cabin shown on approved plan.

I beg to request that you will kindly approve of the plan for which favour I will be greatly obliged.

I beg to remain,

Sir,
your most obedient servant,

Lalchand Khushaldas

B. 7. 1917 Part IV
Ship No. 118.

Sir,

With reference to this
 They to report that there
 seems no objection to
 grant pass with the Health
 Officer's report

1094
 14.2.18.

Consul
 Nathan

12
 2 10

H.O. for form of report.

V. 13/2/18

Mr. Benjamin

Shaw & Co

13 ²/₁₈

DS

No objection

16 ²/₁₈ DS

Lord Lurgan
~~by name permission~~

attach F/C

V. 24/2/18

No objection

V. 24/2/18