



Building Completion Report.

19

MUNICIPAL OFFICE,

Karachi, 15th Feb 1921.

CB-7

To

THE ENGINEER,

KARACHI MUNICIPALITY.

SIR,

I beg to report, the building work on plot No. 272 Sheet
H B. Dy. Quarter owned by Mr. Muljimal Gangaram
is completed according to the plan approved by the Municipality. Orders are
requested to file the correspondence.

Yours obediently,

File
D

M. C., A. M. I. C. E.,
Engineer,
Karachi Municipality.

W. C. Bhattacharya
Building Surveyor "B" Section,
Karachi Municipality.



Form No. 6-300-25.9.20.

No. L. S. 7018 OF 1926.

MUNICIPAL OFFICE,


Karachi, 7. 12. 1920.

MEMO:

Building Surveyor Section B is informed
that Mr. Mr. Asghar Ali Khan has been permitted
to build.

_____ his house
on plot No. 272 K 6 Street

Lyari Quarter report should be made to the
Undersigned when the house is completed.

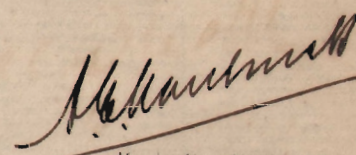
M. I. MECH. E.,Ag. Engineer,
Karachi Municipality.



DRAWING NO 29

AMENDED PLAN OF PROPOSED
HOUSE TO BE BUILT ON PLOT
NO 272 SHEET K-GLYAREEQ

SCALE 8"=1'



GROUND PLAN



FIRST FLOOR PLAN

BLOCK PLAN
SCALE 1"=1'

TREES


J. H. Sturges & Co. Architects & Surveyors
128



298



ELEVATION

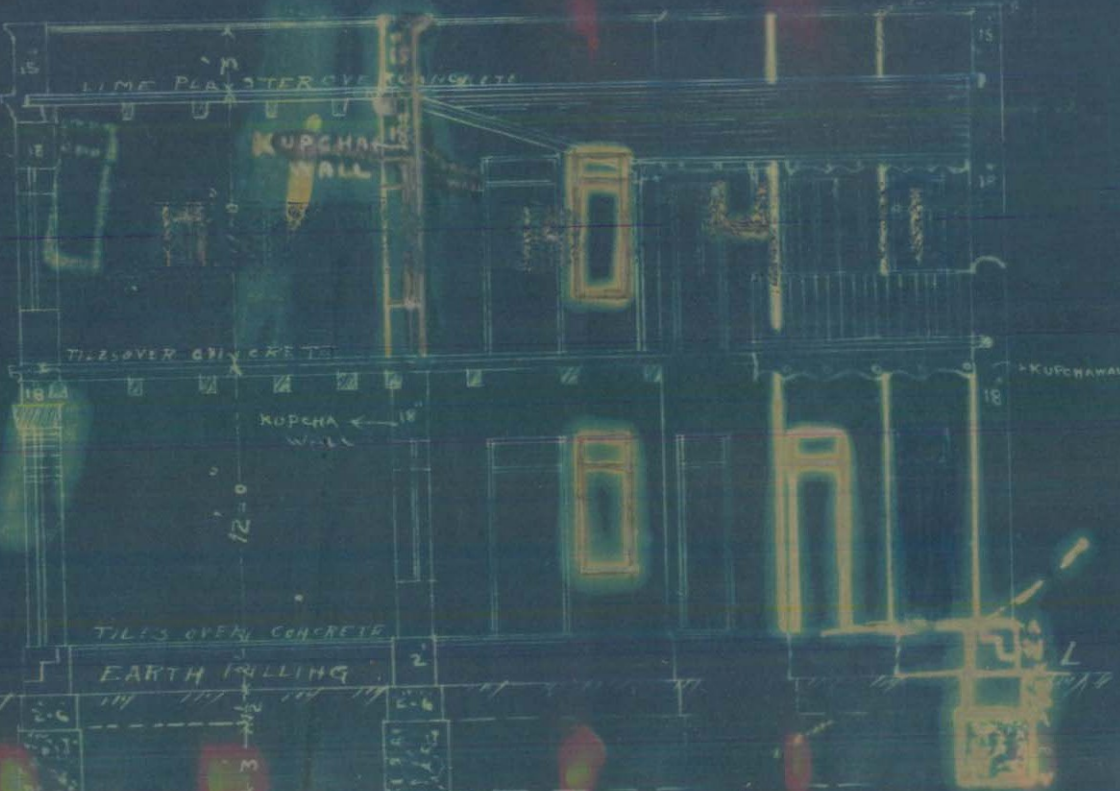

SECTION B