

AMENDED NO: 66

GROUND FLOOR

BLOCK A

AMENDED PLAN



SHOWING BUNGLOWS ON
PLOT NO: 8G SHEET 15
GARDEN QUARTERFOR MESSRS GULAM HUSSAIN KASSIM & SONS
SCALE 8 FT = 1 INCH

BLOCK A

APPROVED


H. Hussain

22

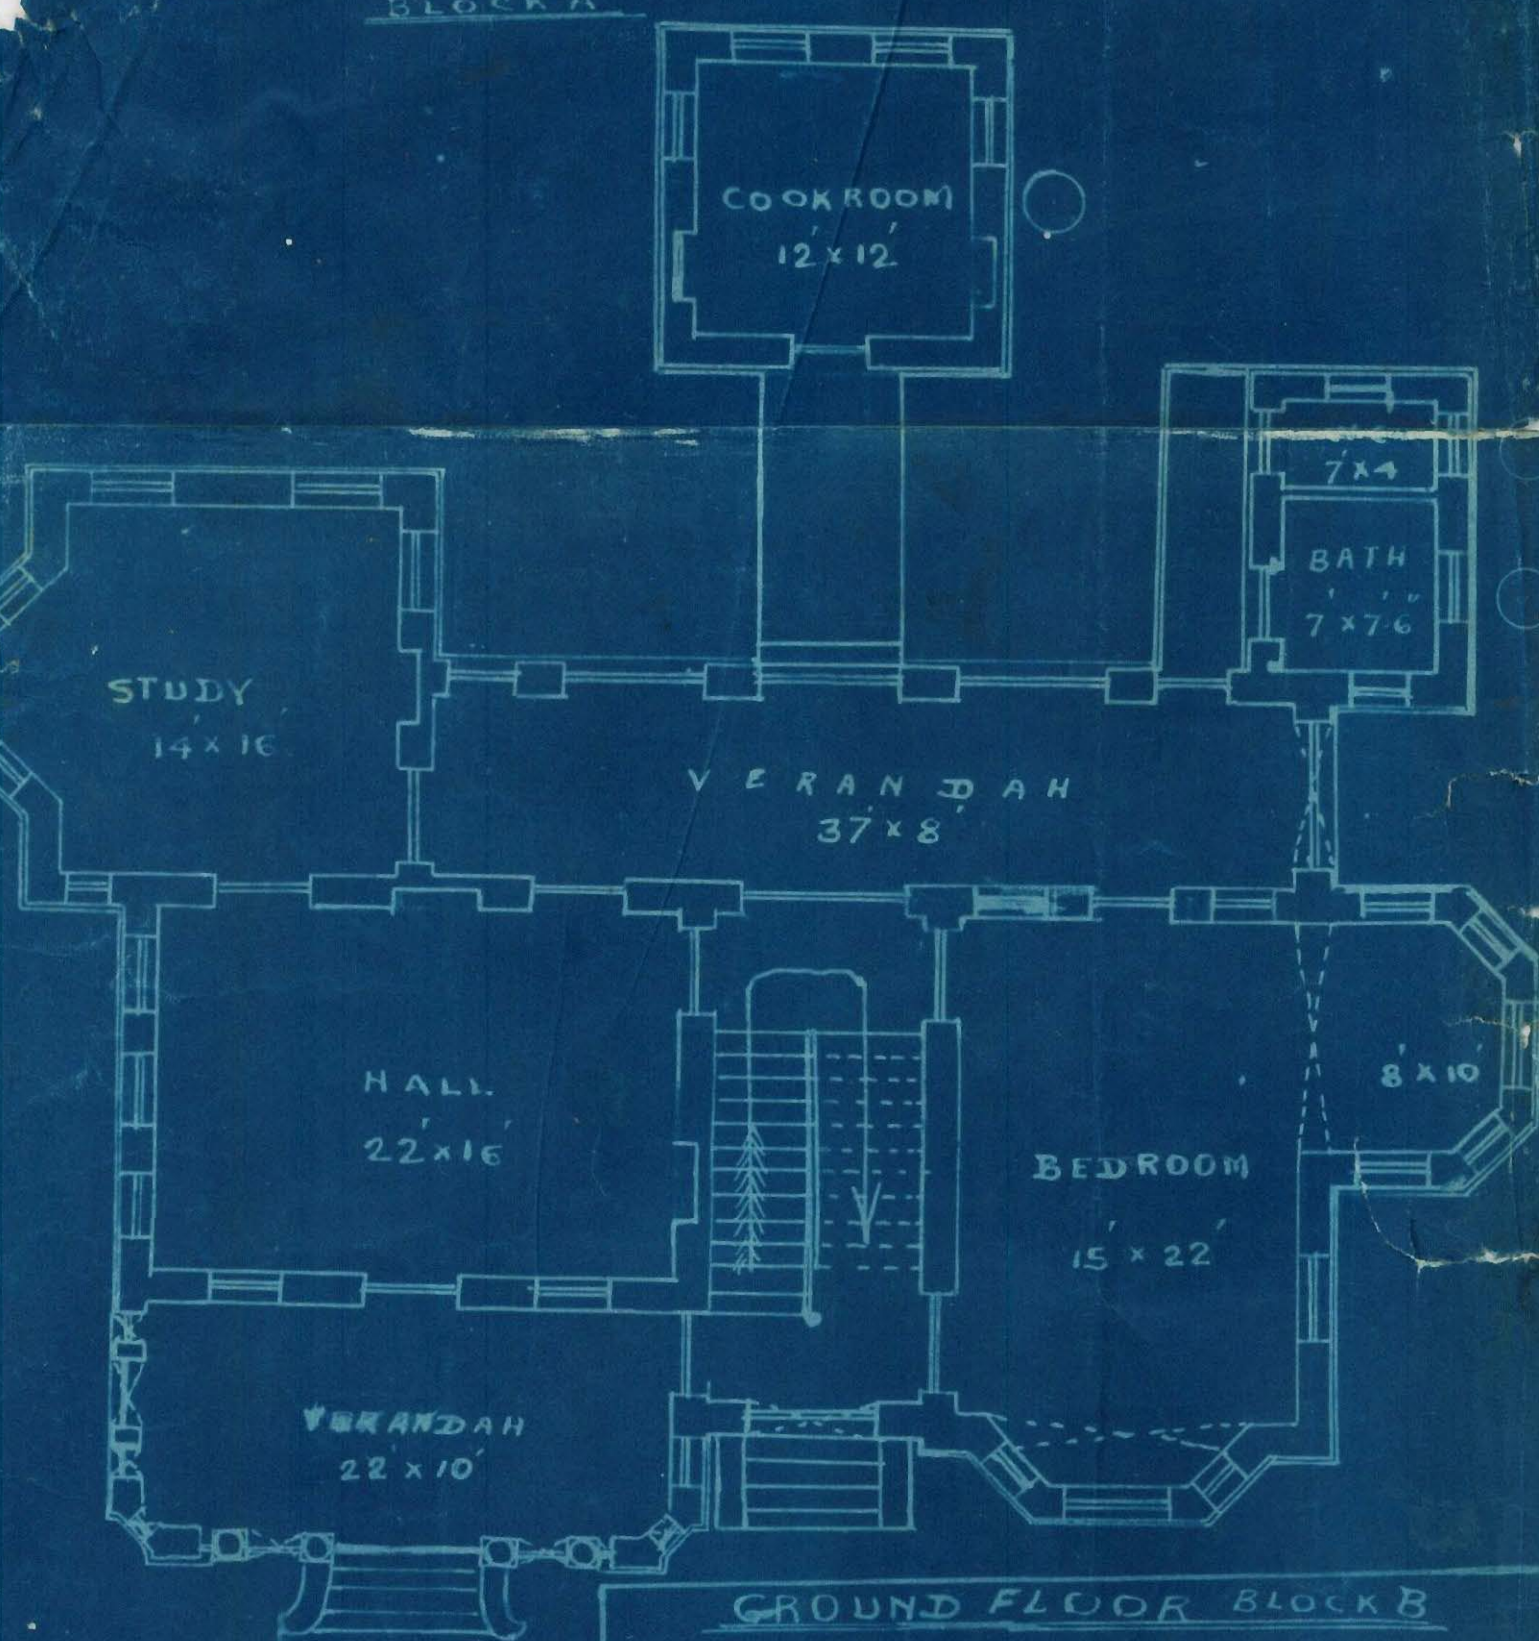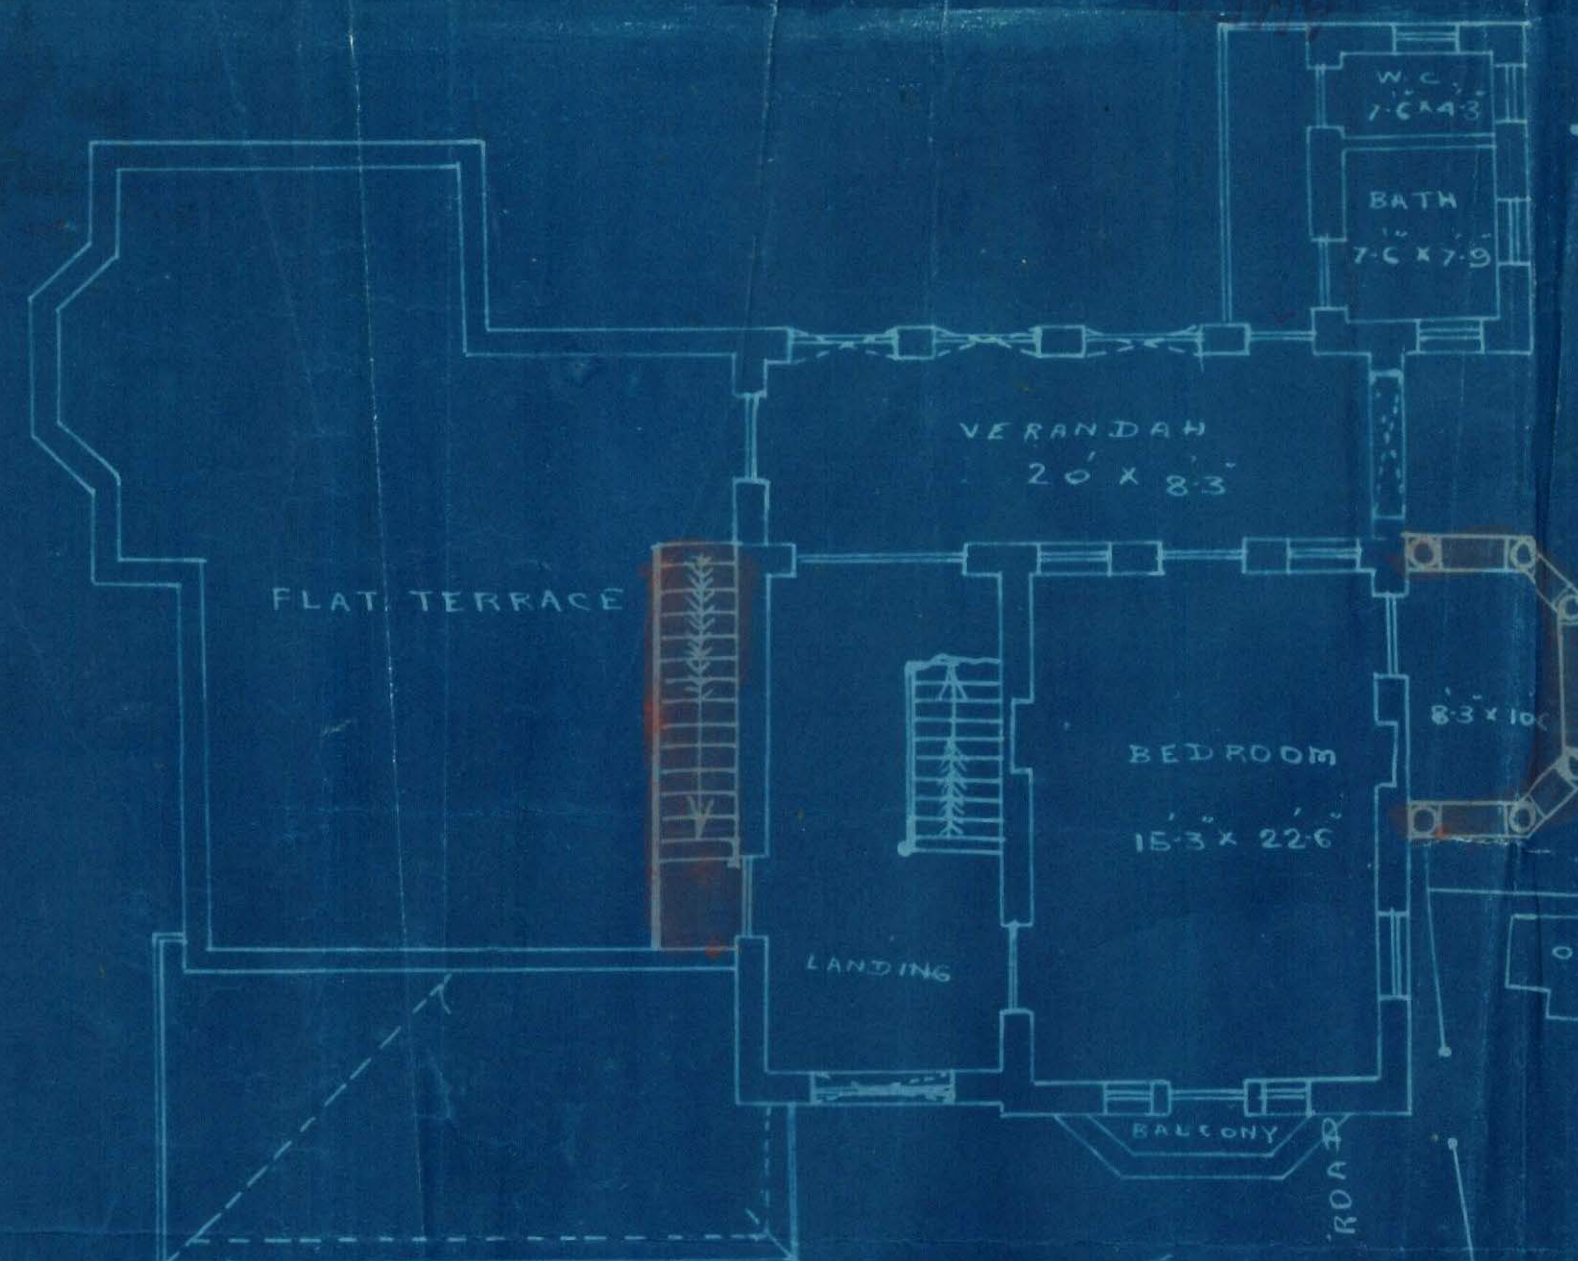

SITE PLAN



SCALE 40 FT = 1 INCH

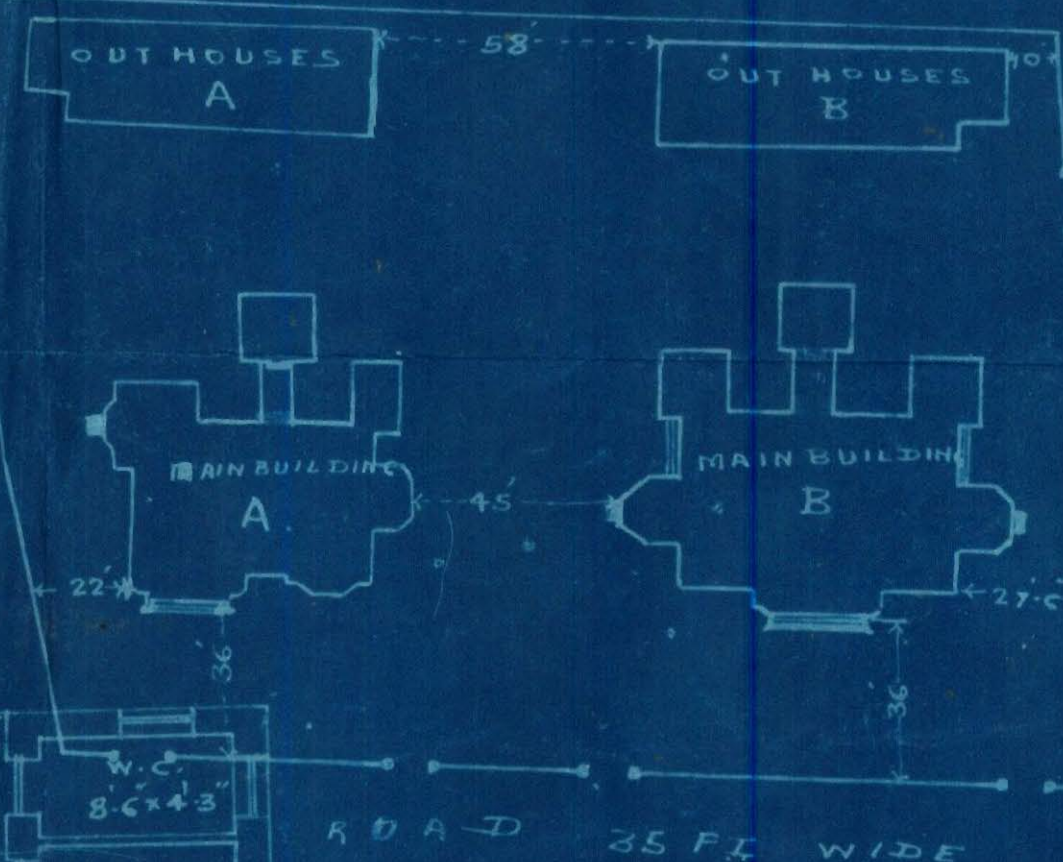

GROUND FLOOR BLOCK B

BLOCK B

FIRST FLOOR BLOCK B

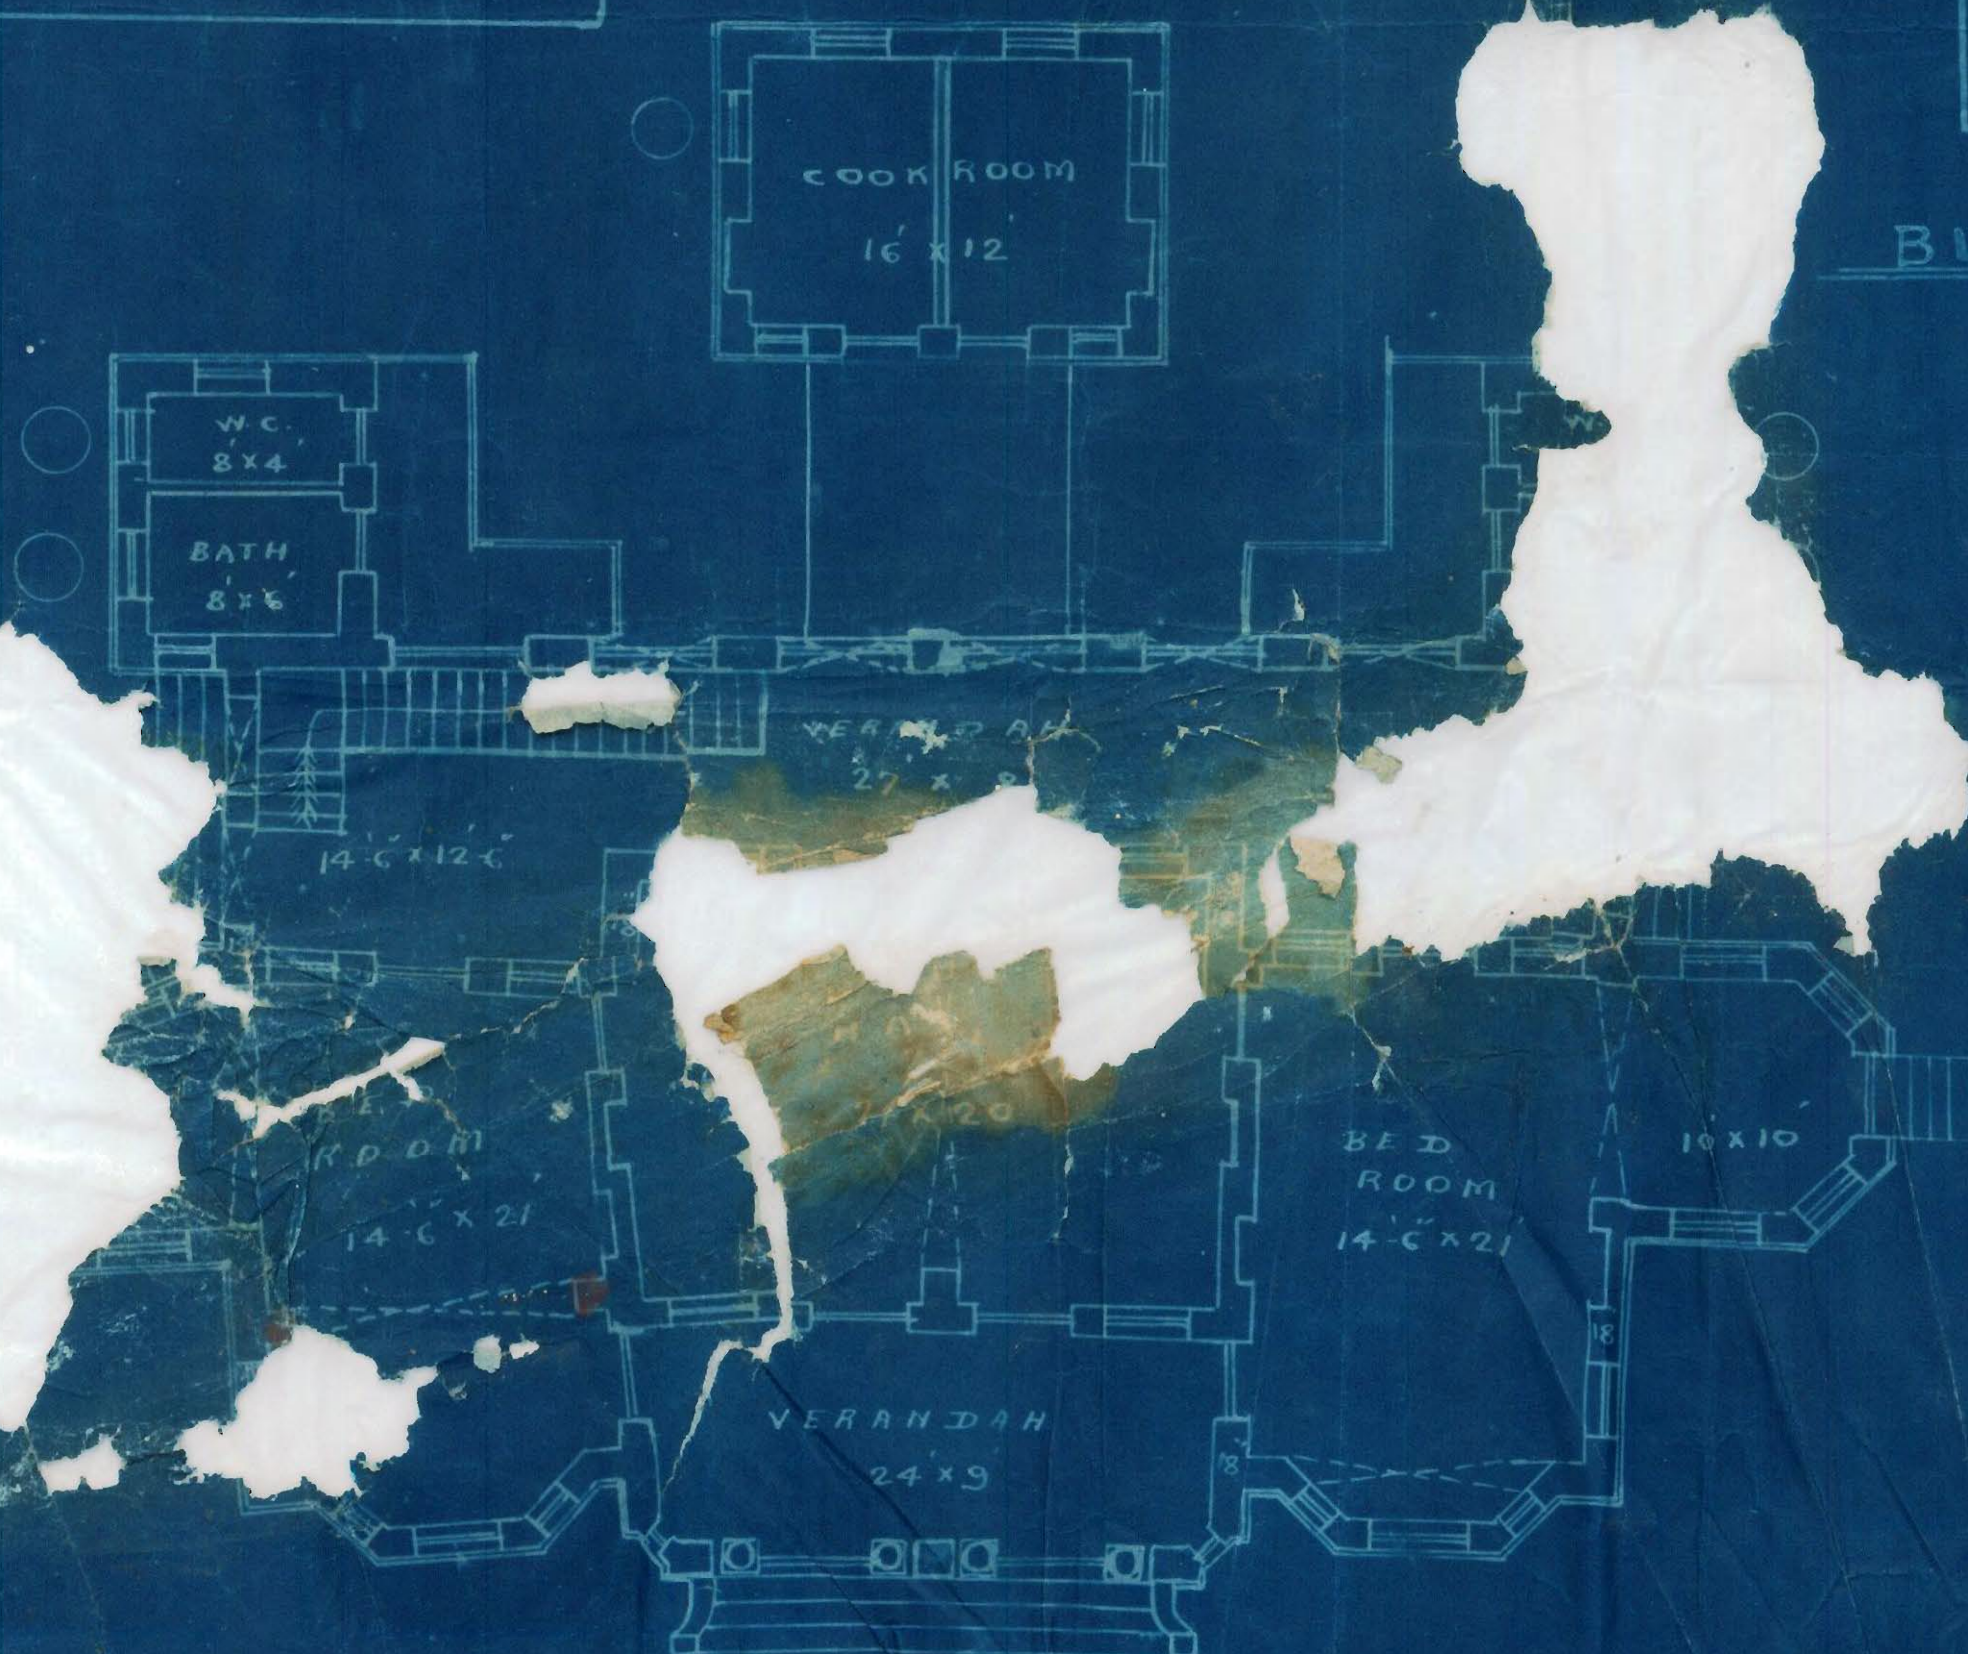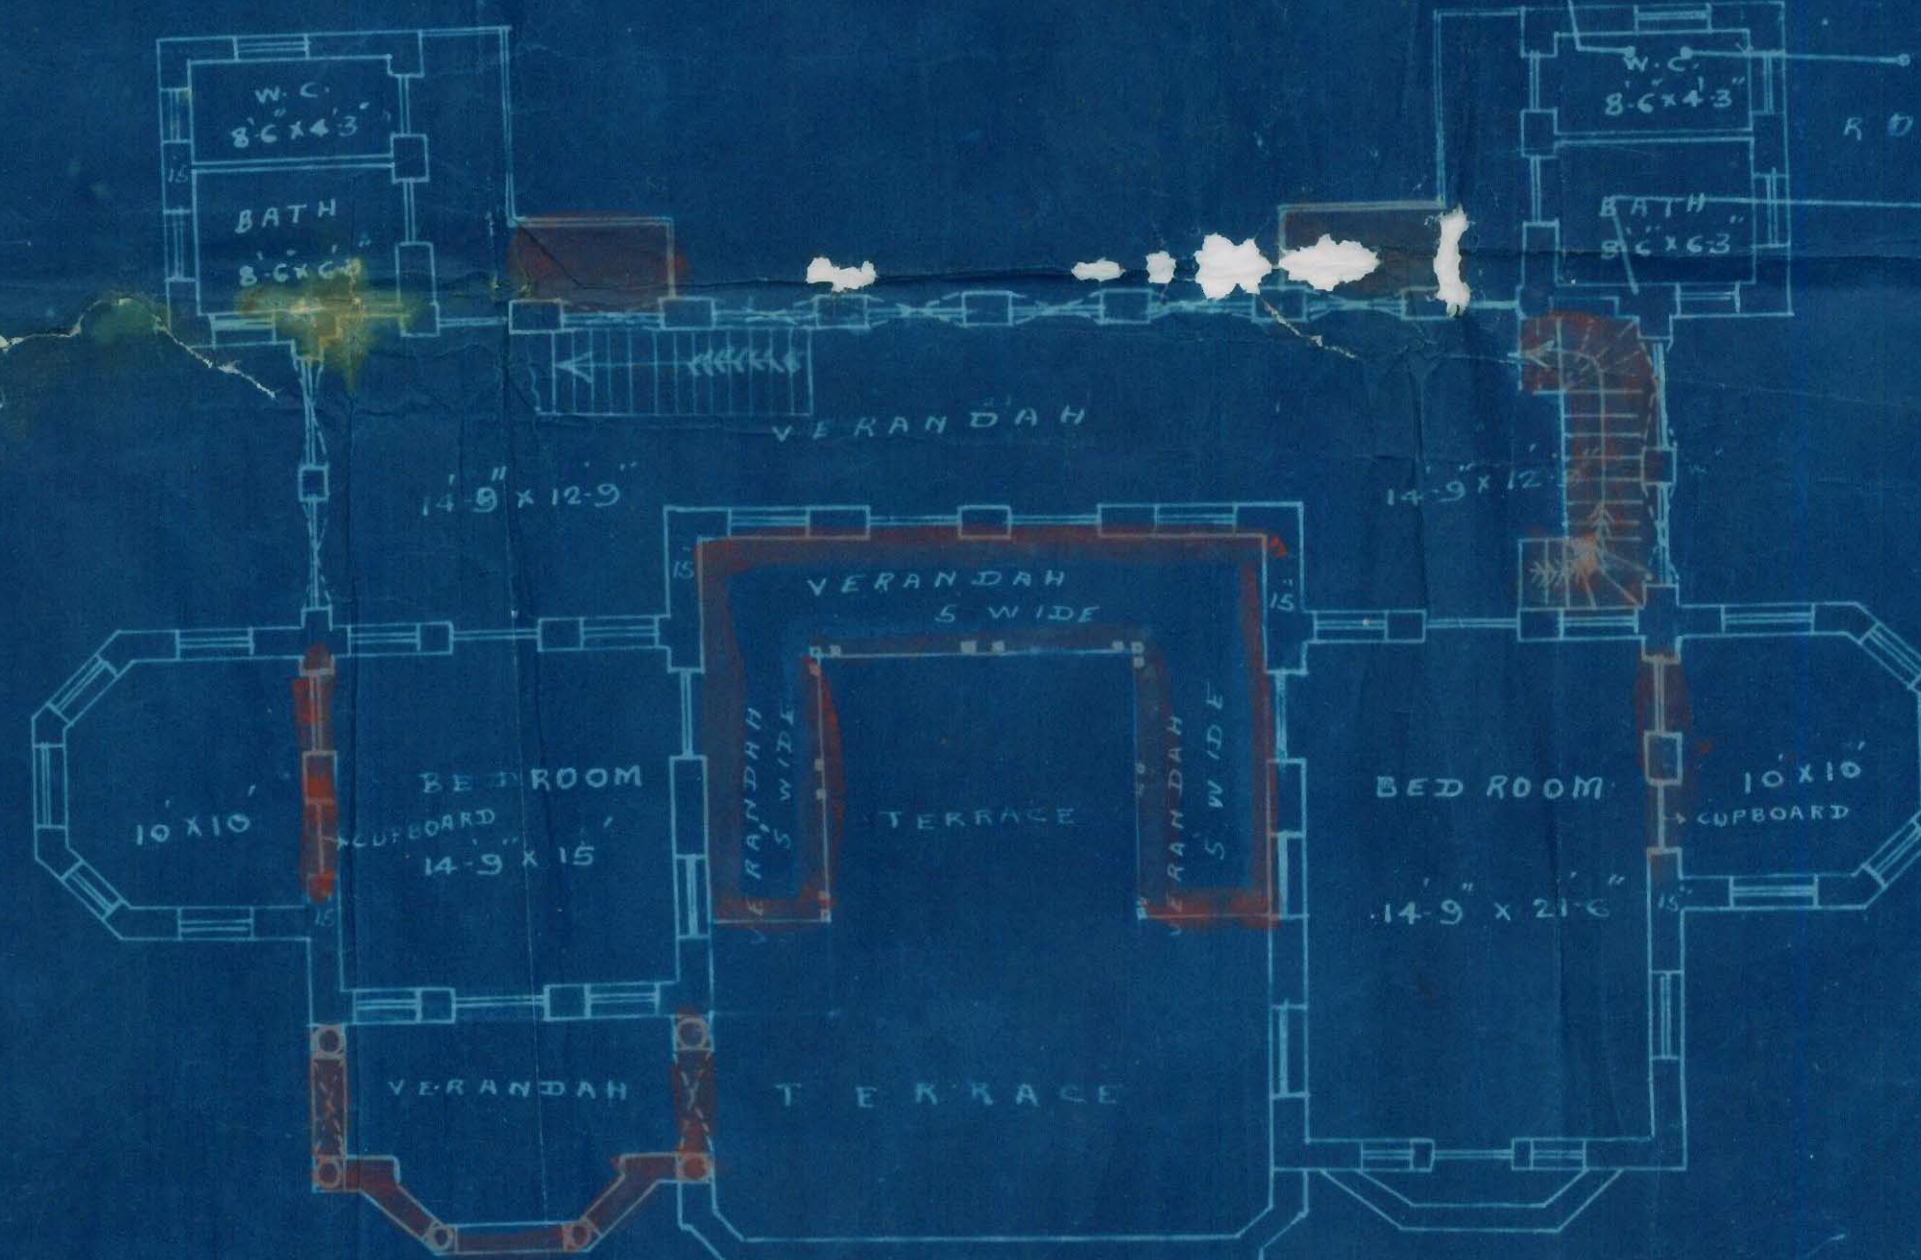*Hussain H. Hussain*ARCHITECT & SURVEYOR
KARACHI 1-10-1918