



Heritage

KMR.CDD.RbQ.1920-1921.01

BUILDING COMPLETION REPORT.

MUNICIPAL OFFICE,

Karachi, 30 June 1921
1.7.21

To,

THE ENGINEER,

KARACHI MUNICIPALITY.

SIR,

*R.34096
1.7.21*

I beg to report that the building work on plot No. 64
sheet M4 Rambaugh Quarter owned by
Mr. Ghanshyam Lalchand is completed
according to the plan approved by this office.

*Copy to be for information**P. B. Shindooan**M. C. A. M. T. C. E.**in*

Engineer,

Karachi Municipality

Yours obediently,

Brawani

Building Surveyor, „ A „ Section,

Karachi Municipality.



No. L. S. 1987 OF 1920

Form No. 6.

MUNICIPAL OFFICE,

Karachi 27 2. 1920

MEMO :

Building Surveyor Section A is informed
that Mr. Sahindram Kalehand has been permitted
to build

his house
on plot No. 64 File Radunal Street

Ramhaukh Quarter report should be made to the
Undersigned when the house is completed.

L. A. H. Kirby

A.M. INST., C.E.,


Engineer,

Karachi Municipality.


GROUND PLAN




1ST 2ND & 3RD FLOOR PLAN

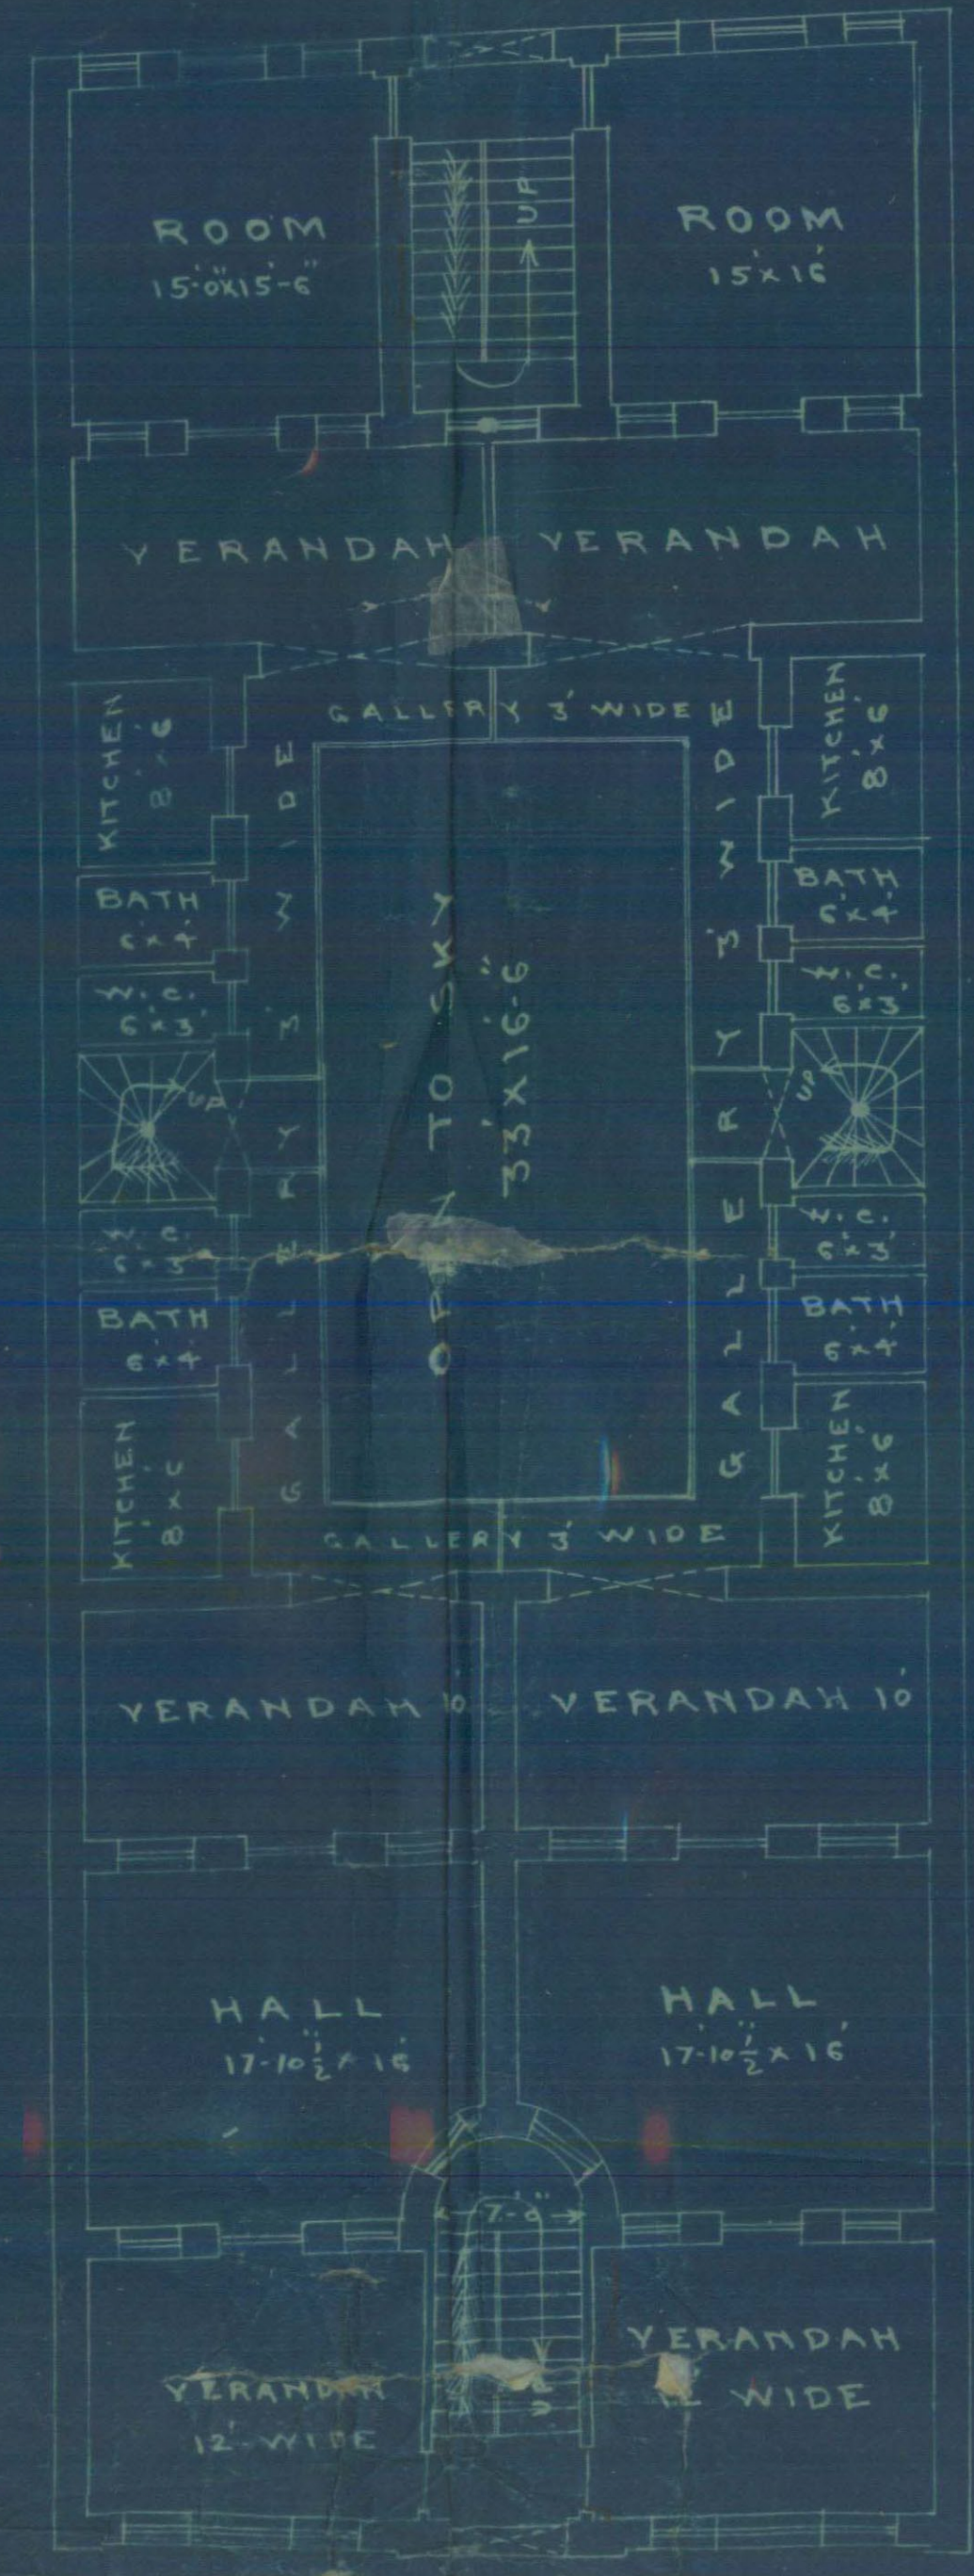


PLAN OF PROPOSED BUILDING ON PLOT No 64 F.14 RAMBAUGH QR: SCALE 8"=1" INCH

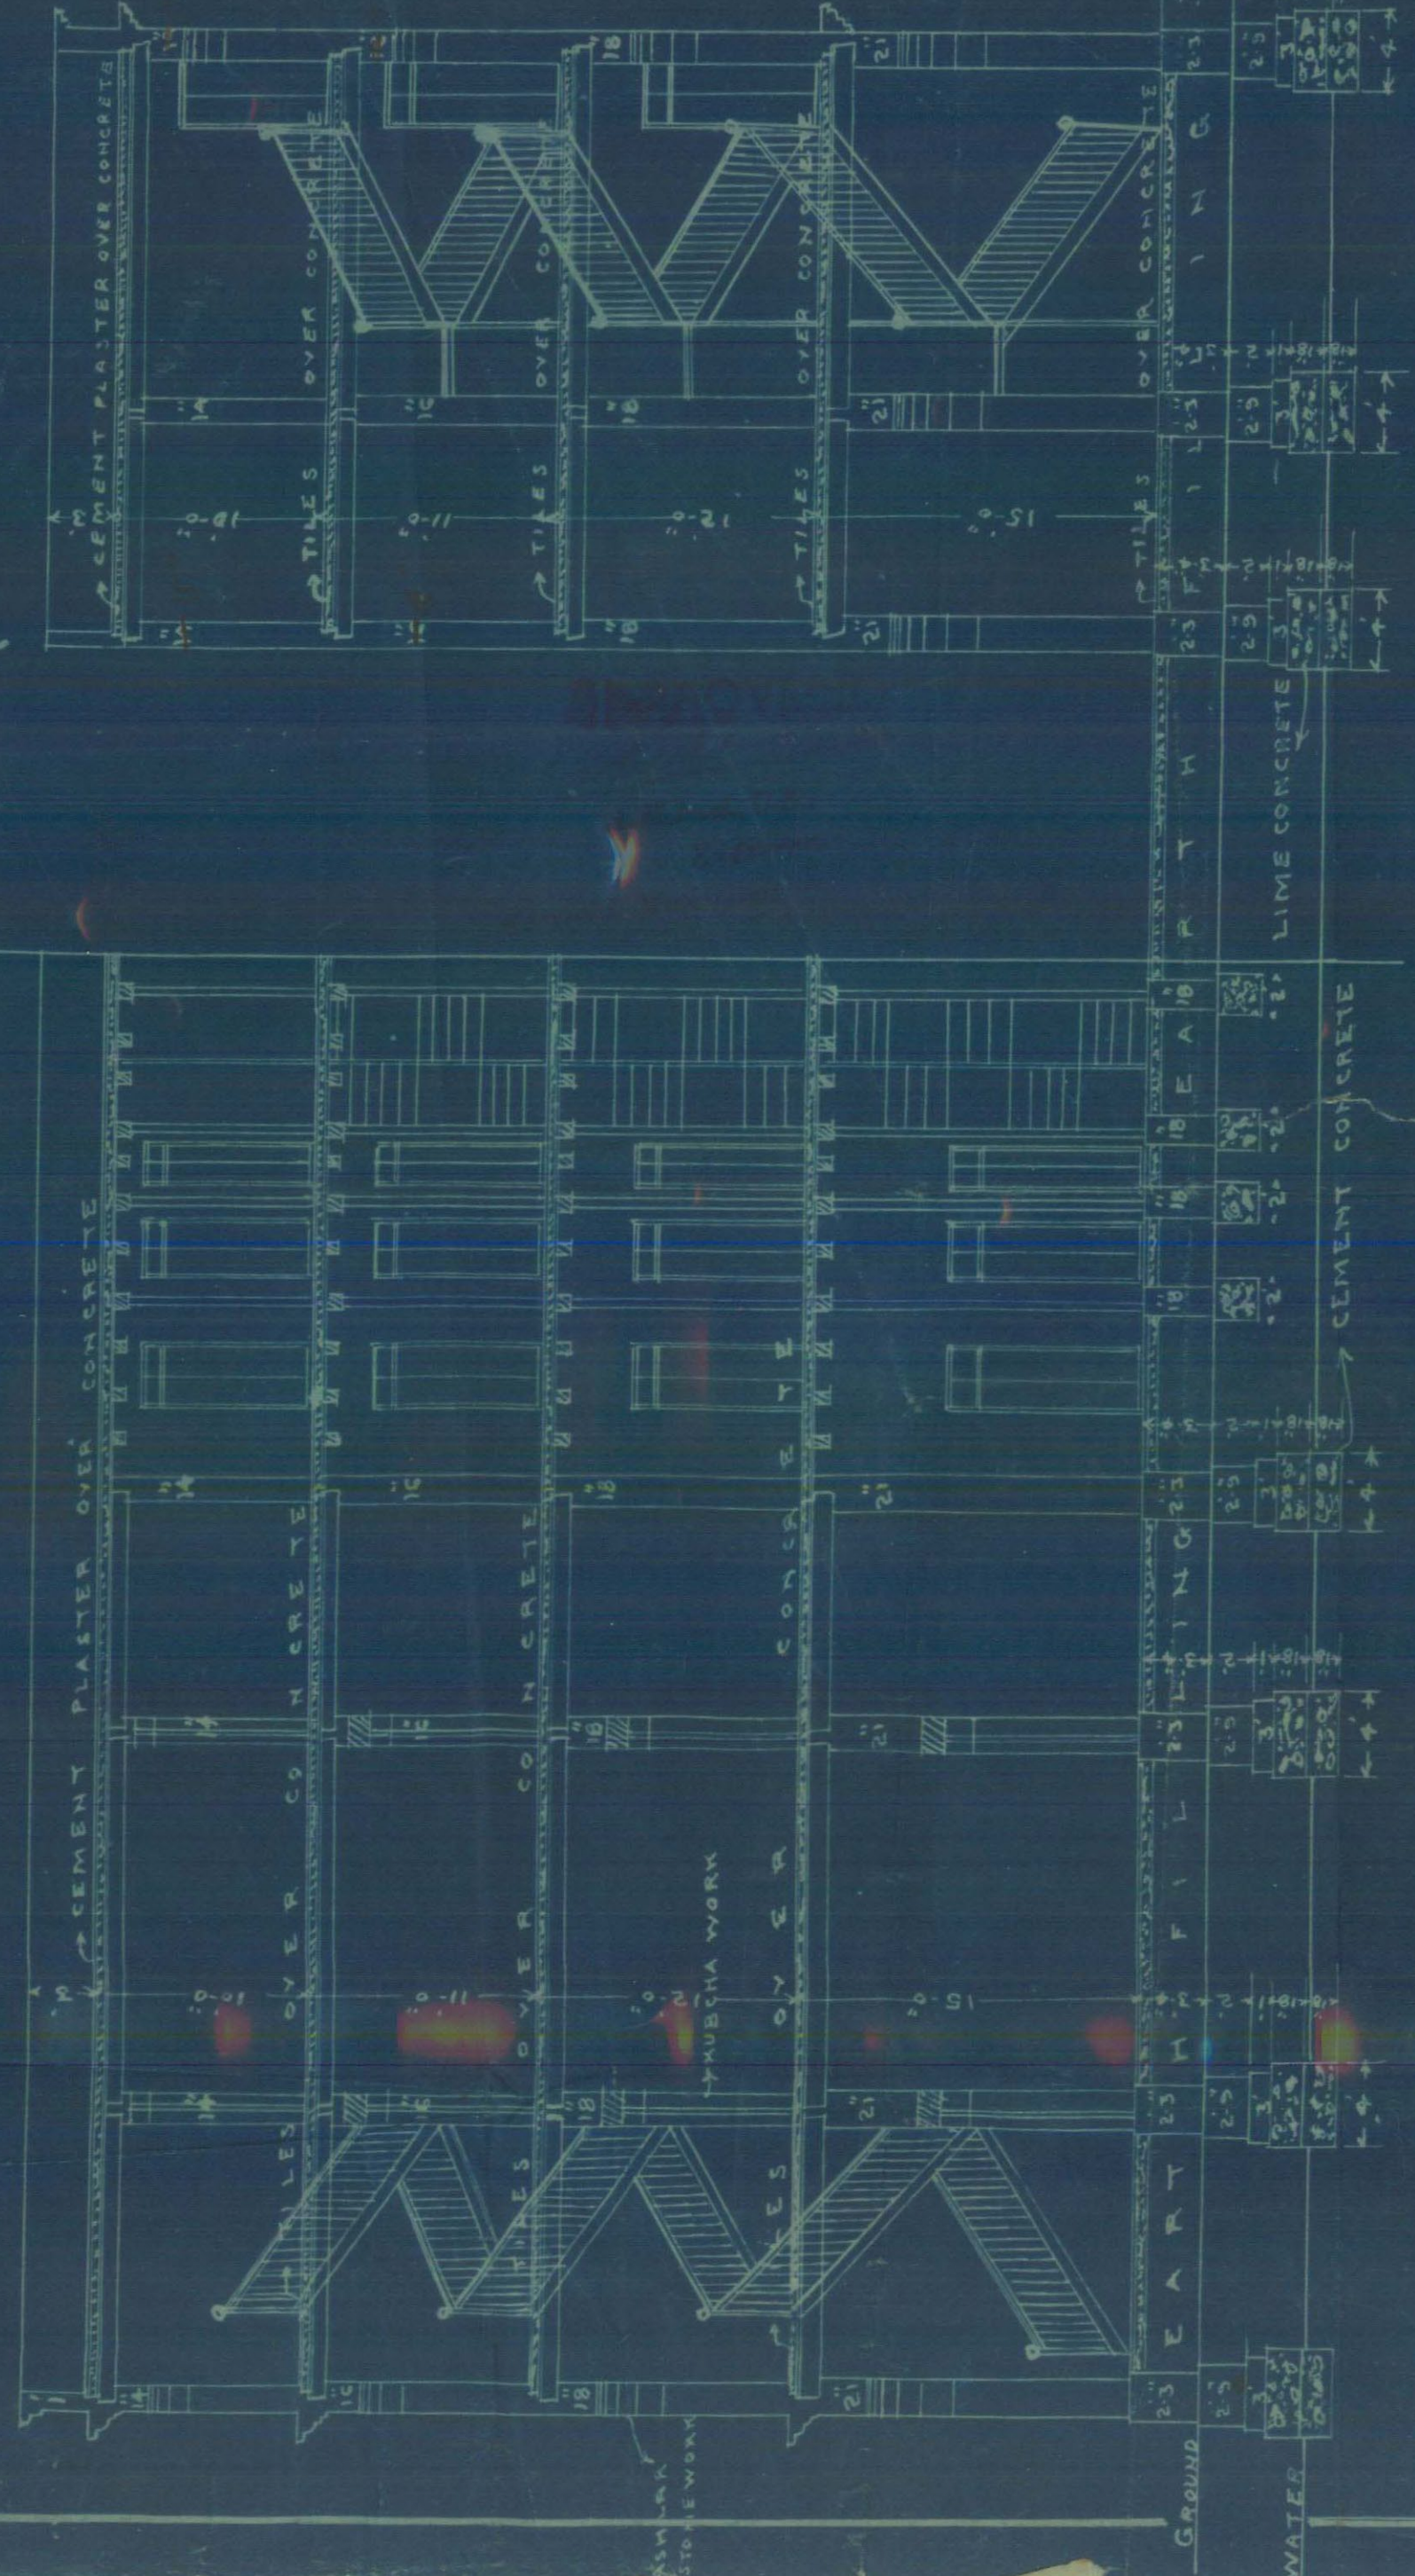

SECTION ON A.B.

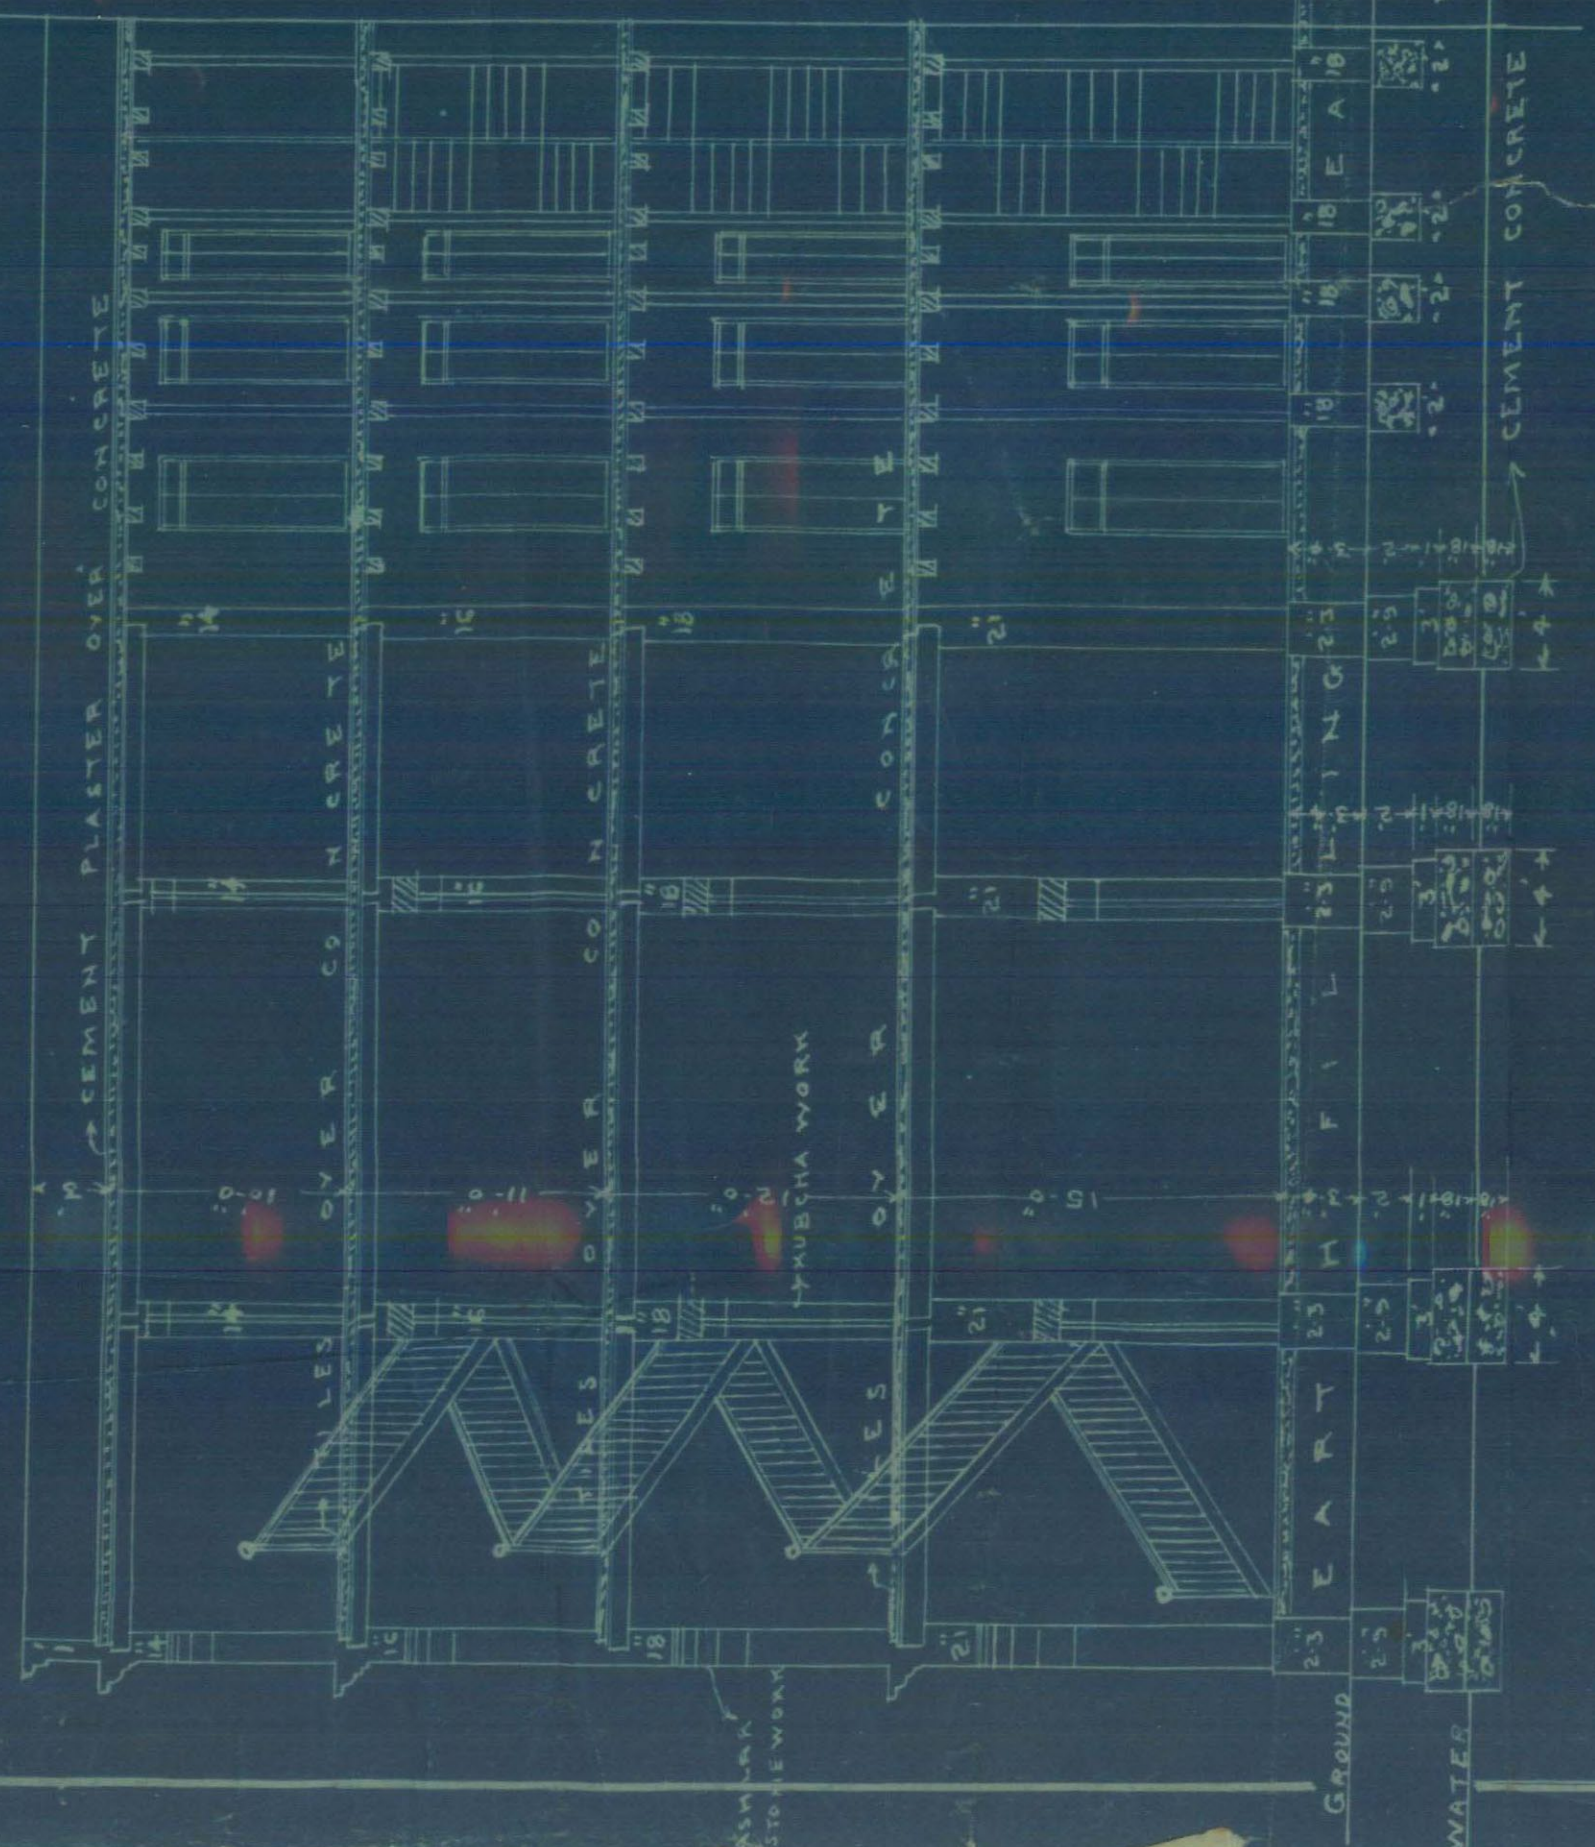

ELEVATION

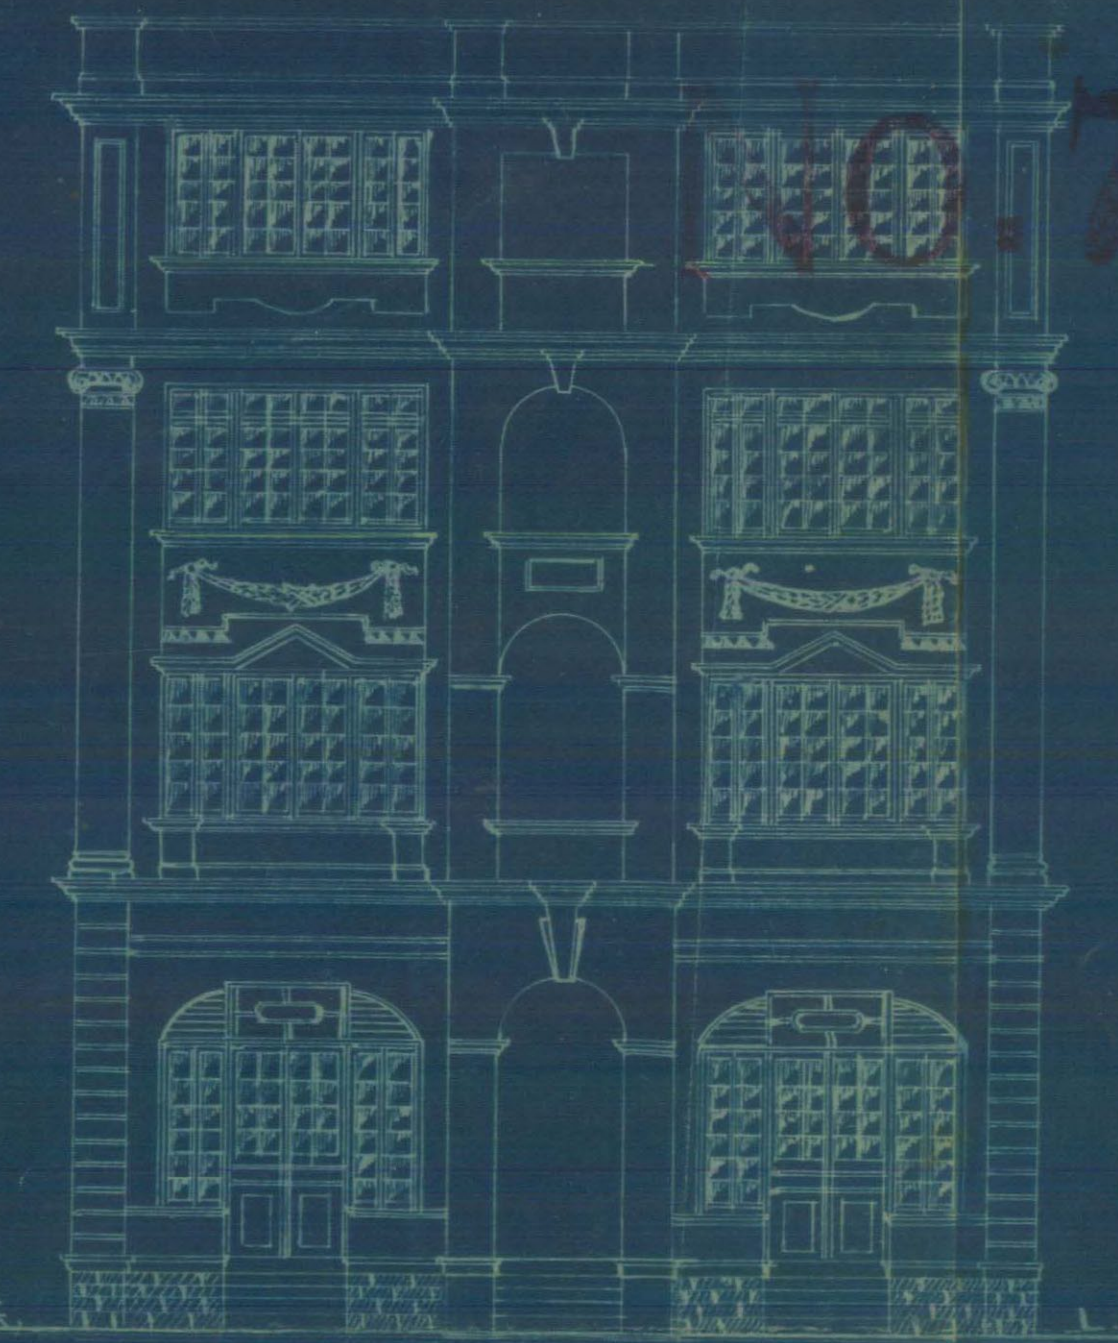

DRAWING No 146

BUILDING UNDER CONSTRUCTION

PROPOSED BUILDING

BUILDING 55' HIGH

ROAD 50' WIDE

SITE PLAN SCALE 20"=1'

ARCHITECT & SURVEYOR KARACHI 9-2-1920