



Heritage

KMR.CDD.FrQ.1923-1924.01

KARACHI MUNICIPALITY.

REF. No. L.S. 270 of 1924.

Municipal Office,

Karachi 18th January 1924.

MEMO :-

In continuation of this Office No. L.S. 6506 dated 17th December 1923, Mr. Allahbux Haji Khudabux is informed, the extra copies of plans asked for have not been received as yet. He is therefore again requested to submit them at once on receipt of this Notice.

17/1/24
EXECUTIVE ENGINEER.

KARACHI MUNICIPALITY.

memo

In continuation
of this office no: 6506 of 17th
Dec: 1923 Mr. Alahut Haji
Khudabek is informed, the
extra copies of plans asked
for have not been received
as yet. He is therefore
again requested to submit
them at once on receipt of
this notice.

6/5/14

al

J. Bon

8/1/14



14th
14th DECEMBER 1923.

6506 of 1923.

MEMO : -

In continuation of this Office letter No. L. 12225 dated 5th December 1923, relating to the building on plot No. 15, J-1/B, Frere Town Quarter, Mr. Allahbux Haji Khudabux is requested to submit within a Week 2 more copies of amended plan (one on tracing cloth & the other on blue print) for this Office record.

The plans should be signed by an Architect & owner as usual, out of which one copy will be returned duly signed & approved.

6.15/12/23

ASSISTANT ENGINEER.

KARACHI MUNICIPALITY.

P. L. V.
14.12.23.

Submitted. Receipt order to
remind as it is not complete
part of order
21/12.
yes. minor
as 21/12.
as

Memo

In Continuation of this
Office letter no: L. 17225. D. 5th Dec, 1923
relating to the building on Plot
no: 15 J_L₁₃ Dera Town Quarter no.
Mabrut Haji Khudabux is
requested to submit ^{within a week} 2 more
Copies of amended plan
(one on tracing cloth and one
on blue print-) for forward
this office record.

The Plans should be
signed by an architect and
owner as usual, out of which
one copy will be returned to
him duly signed and
approved.

8/14/12/23

Alh

BH

12/12

SITE PLAN-
Scale 40 FT TO AN INCH

AMENDED PLAN FOR BUILDING



ON PLOT NO. 15 SHEET NO. J. 1. 13.

FRIERE TOWN QUARTERS

Scale 8 FT TO AN INCH

NOTE


EXTENSION SHOWN IN RED COLOUR

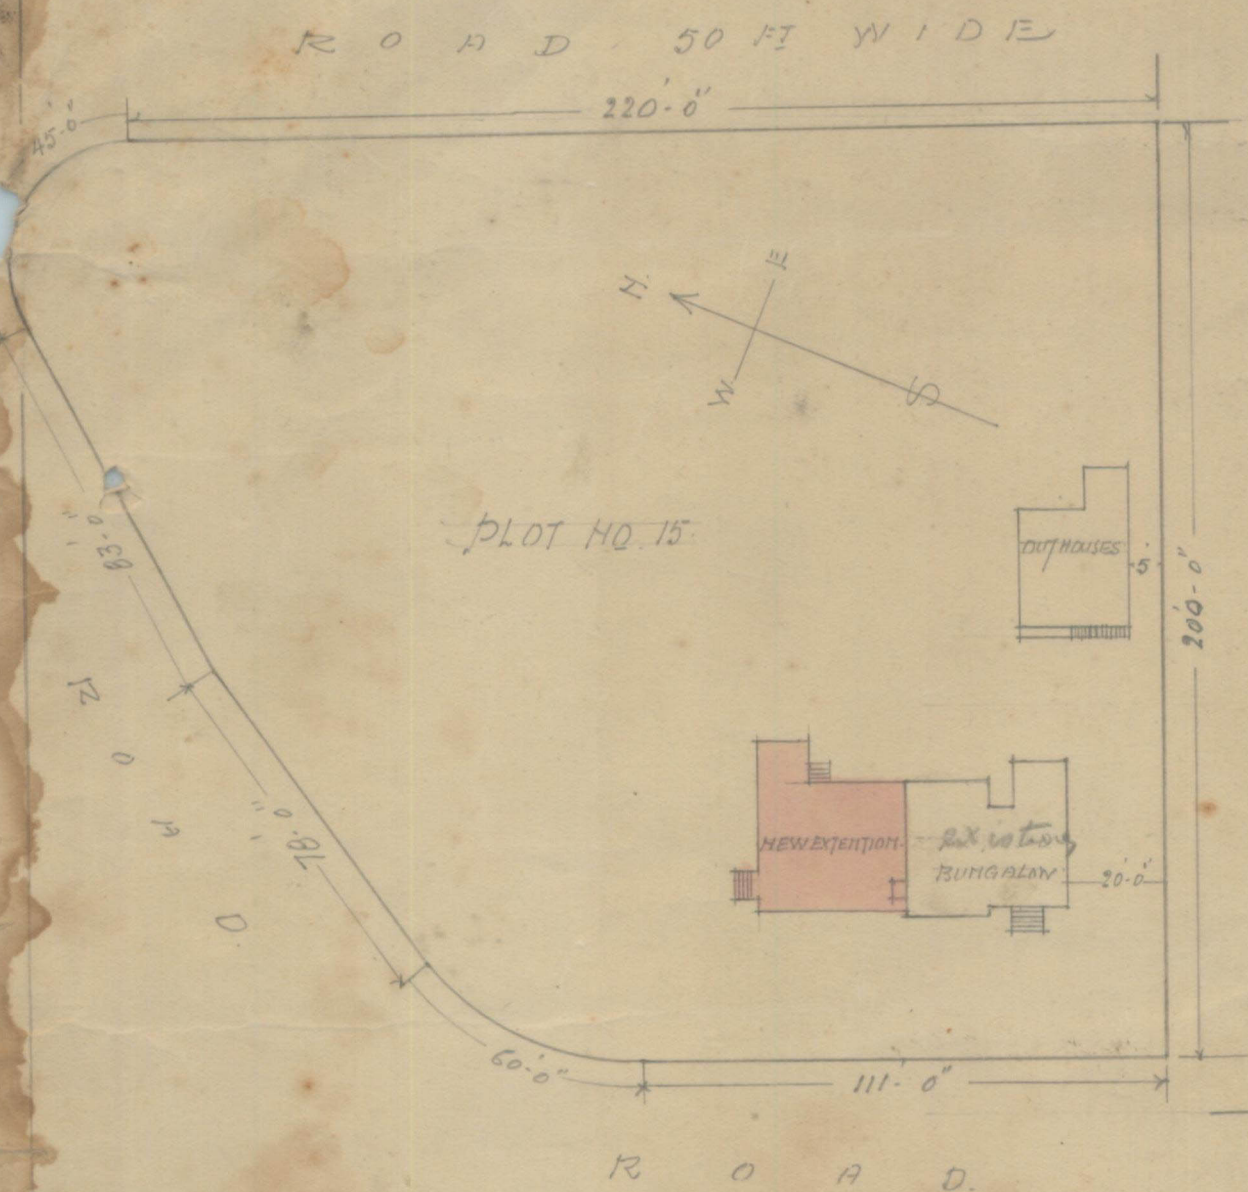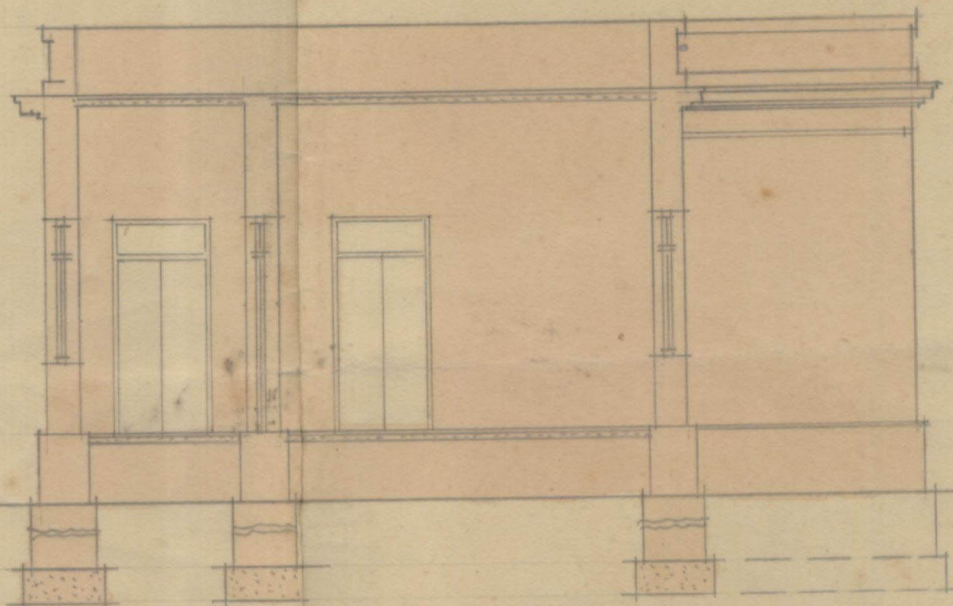

SECTION LINE ON A.B.



FRONT ELEVATION

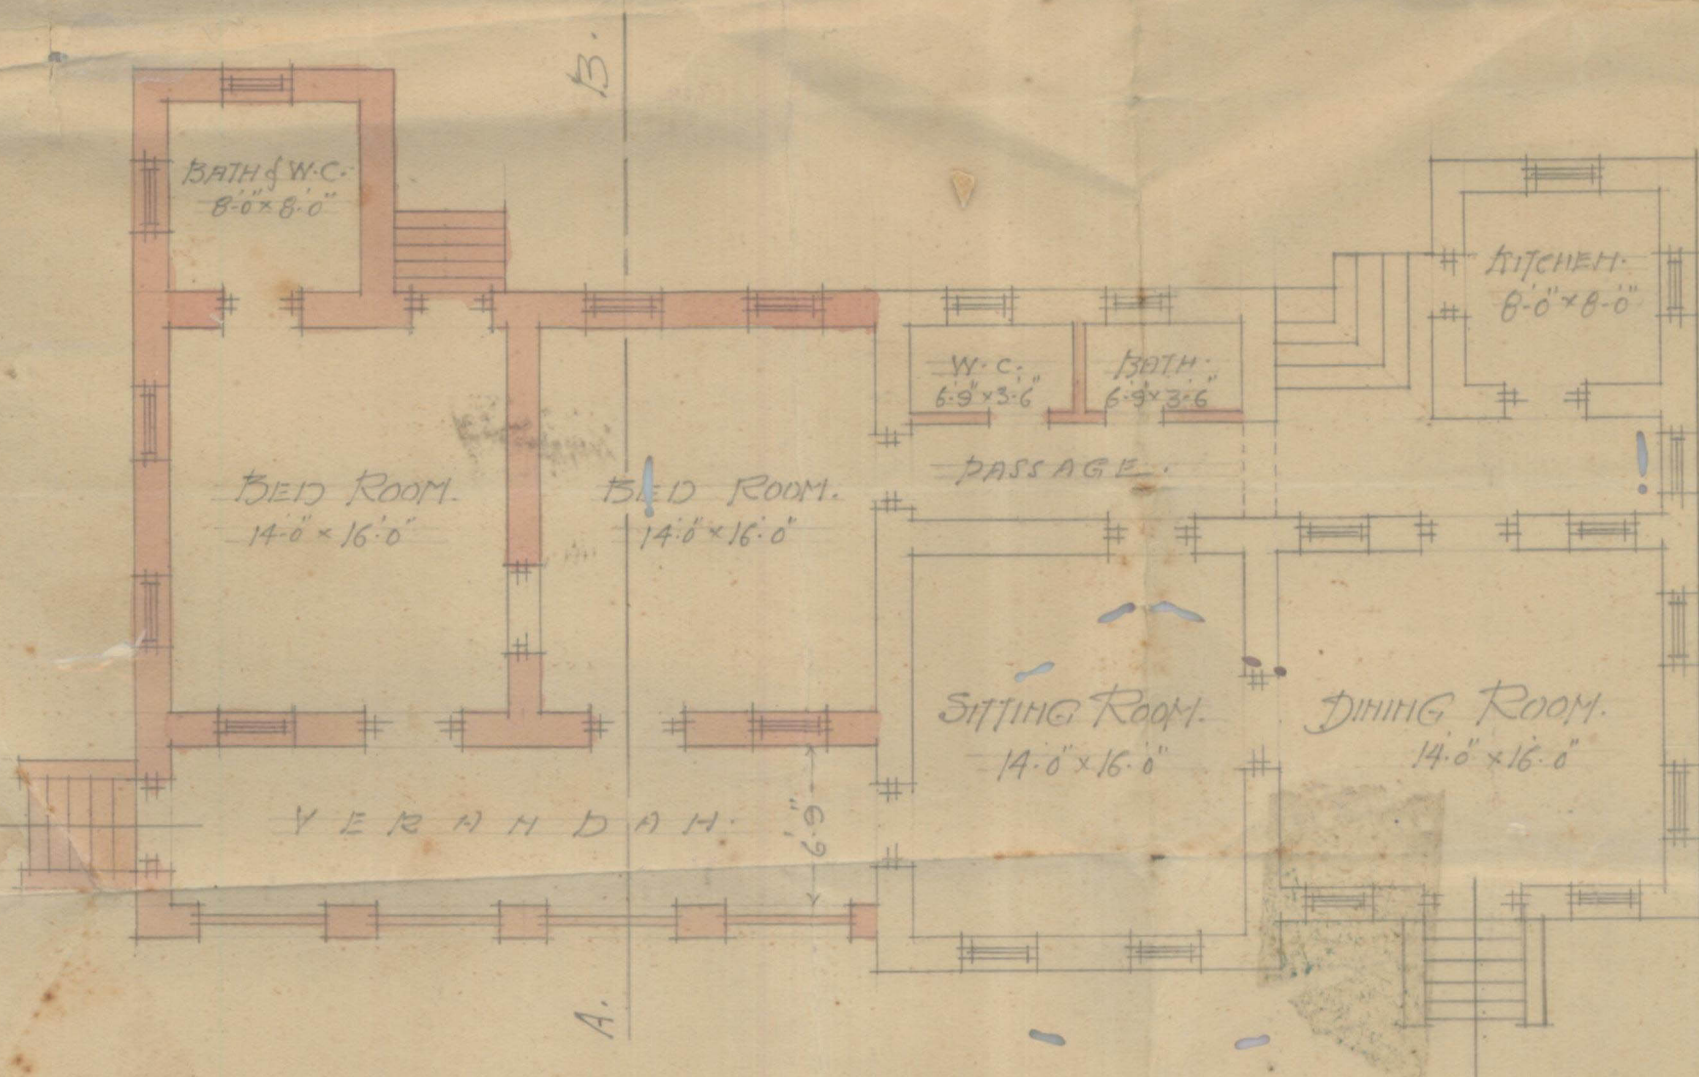

PLAN

— SCALE 40 FT TO AN INCH —

220'-0"

PLOT NO 15

R O A D

FREERE TOWN QUARTERS

— SCALE 8 FT To AN INCH —

NOTE

EXTENSION SHOWN IN RED COLOUR.

— FRONT ELEVATION —

DL-FIT

13. 14. S. L. C. E. S.

ARCHITECTS & CIVIL ENGINEERS