



Form No. 37/A-200-9-1-1924.

BUILDING COMPLETION REPORT.

MUNICIPAL ENGINEER'S OFFICE,

Karachi, 10.7.1924

To

THE ENGINEER,
KARACHI MUNICIPALITY.

SIR

I beg to report, the building work on plot No. 4C Sheet E.1
Jam Quarter owned by Mr. Maj. Suleman Khan
completed according to the plan approved by the Municipality. Orders
are requested to file the correspondence.

Yours obediently,

A. H. Q.Building Surveyor 'B' Section,
Karachi Municipality.N. L. S. 3464 of 1924.Copy to the Assessor and Collector for
information.

July
11/7/24
B.S.C., A.M. INST. C.E.,
Engineer,
Karachi Municipality.

No. L. S. *3884* OF 192*7*.

MUNICIPAL ENGINEER'S OFFICE:

Karachi *2-7-* 19*34*


MEMO:

Building Surveyor Section *B* is informed
that Mr. *Haji Sulaiman time* has been permitted
to *make additions & alterations*
his house
on plot No. *4C E1* Street
Jai Quarter, report should be made to the
undersigned when the house is completed.

[Signature]
Executive Engineer,
Karachi Municipality.




WEST ELEVATION

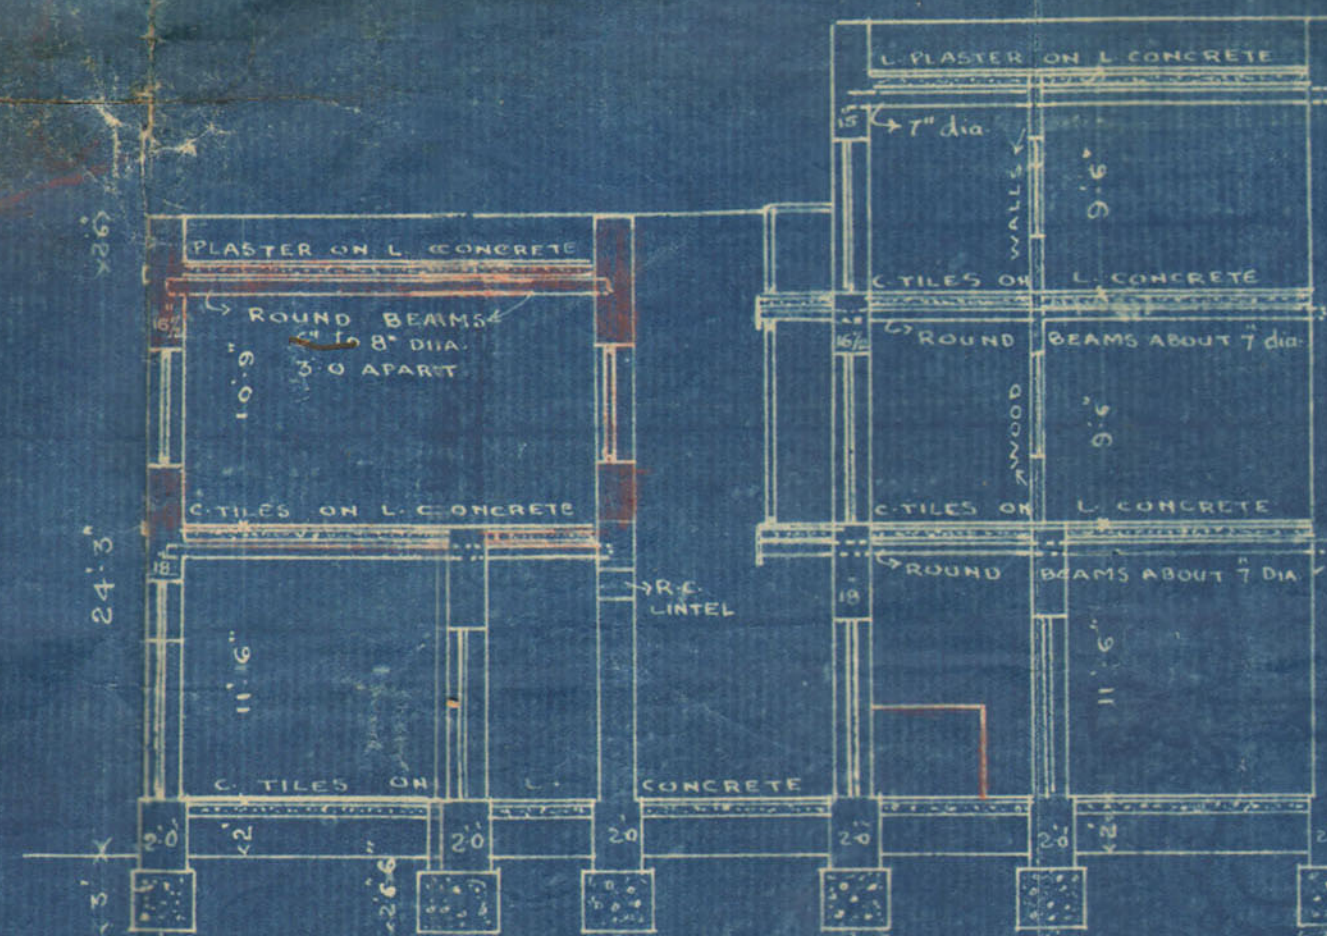

SECTION ON A-B


PLAN SHOWING ADDITIONS TO BUILDING
ON
PLOT NO 4C SHEET E-1
JAIL QR
SCALE 8"=1"

ADDITIONS SHOWN IN RED

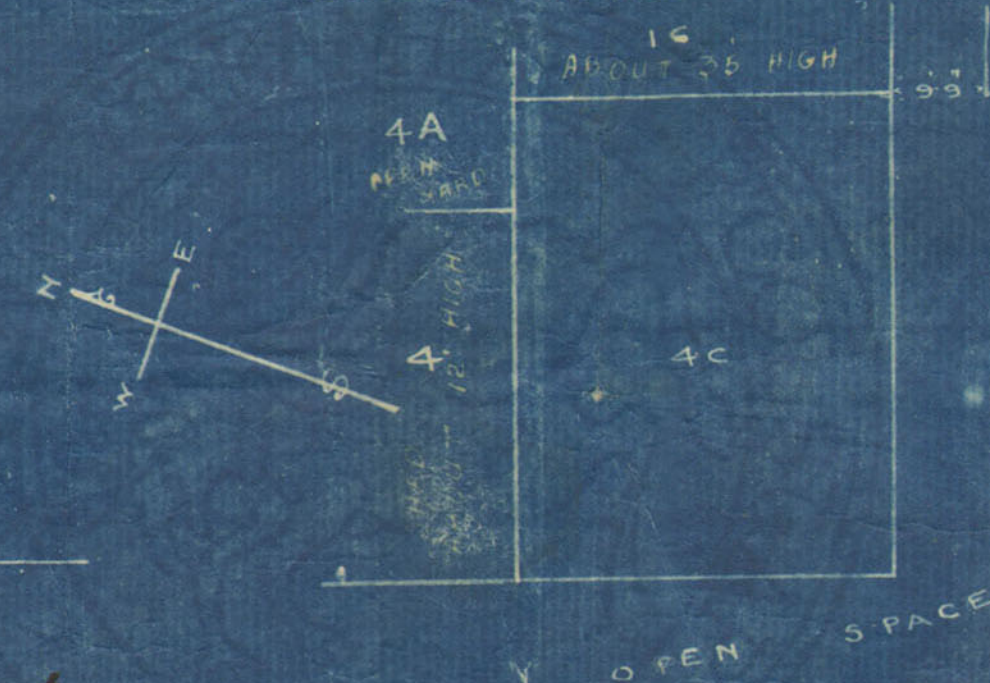


APPROVED
[Signature]
Executive Engineer,
Karachi Municipality.


BLOCK PLAN
20"=1"

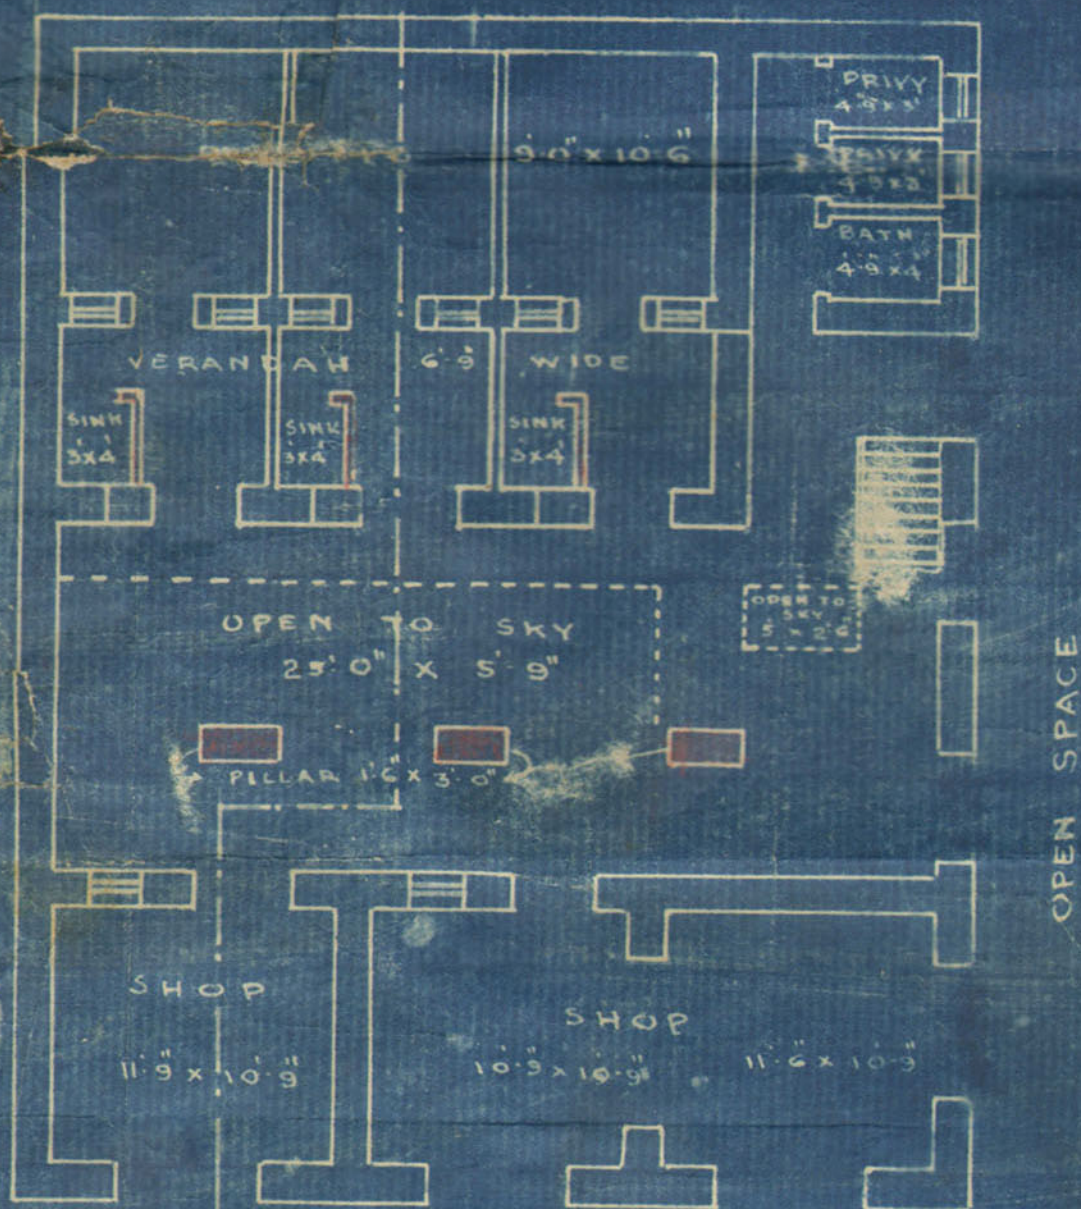

PLAN OF GROUND FLOOR

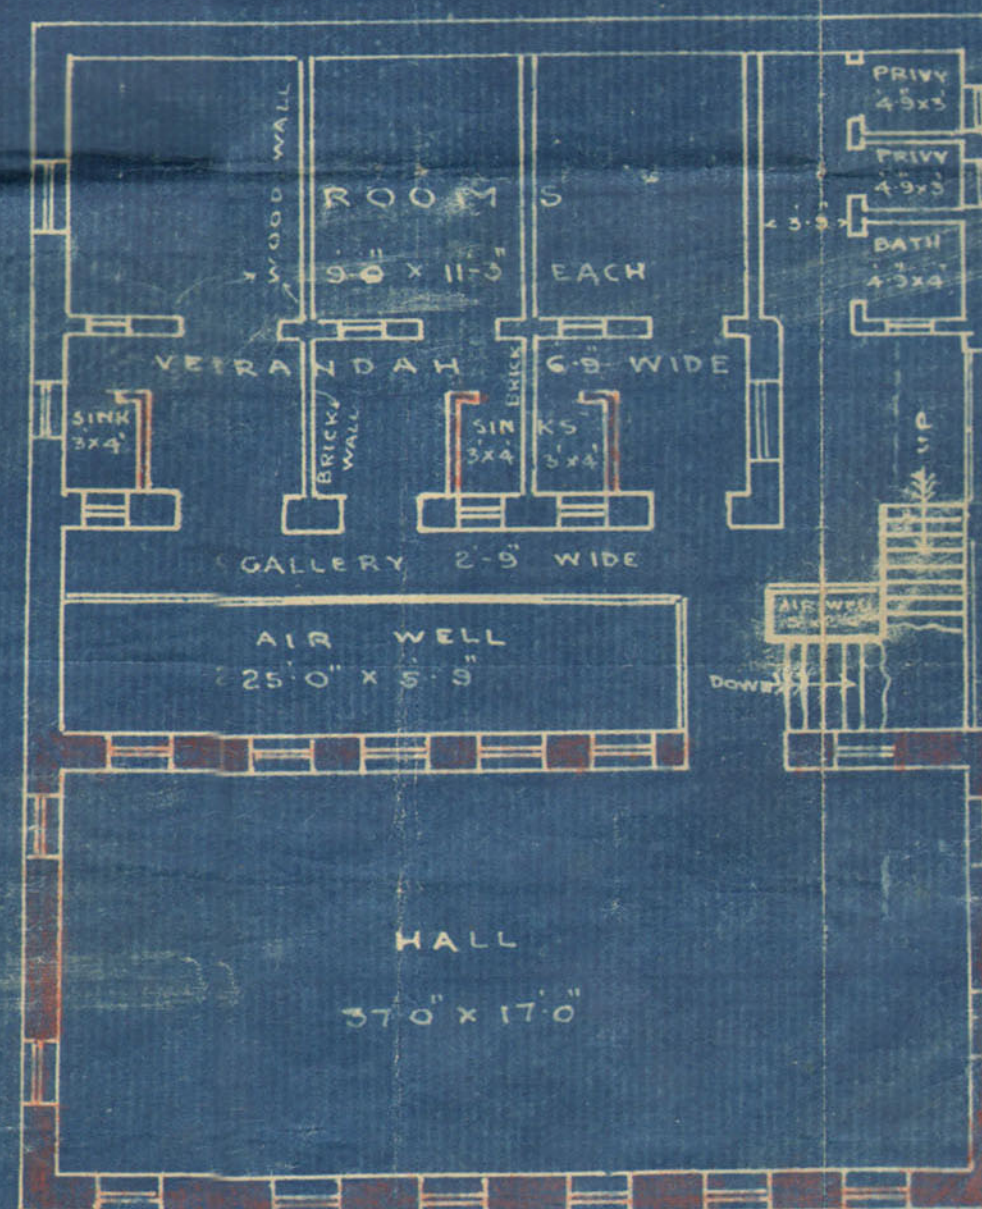

PLAN OF 1ST FLOOR

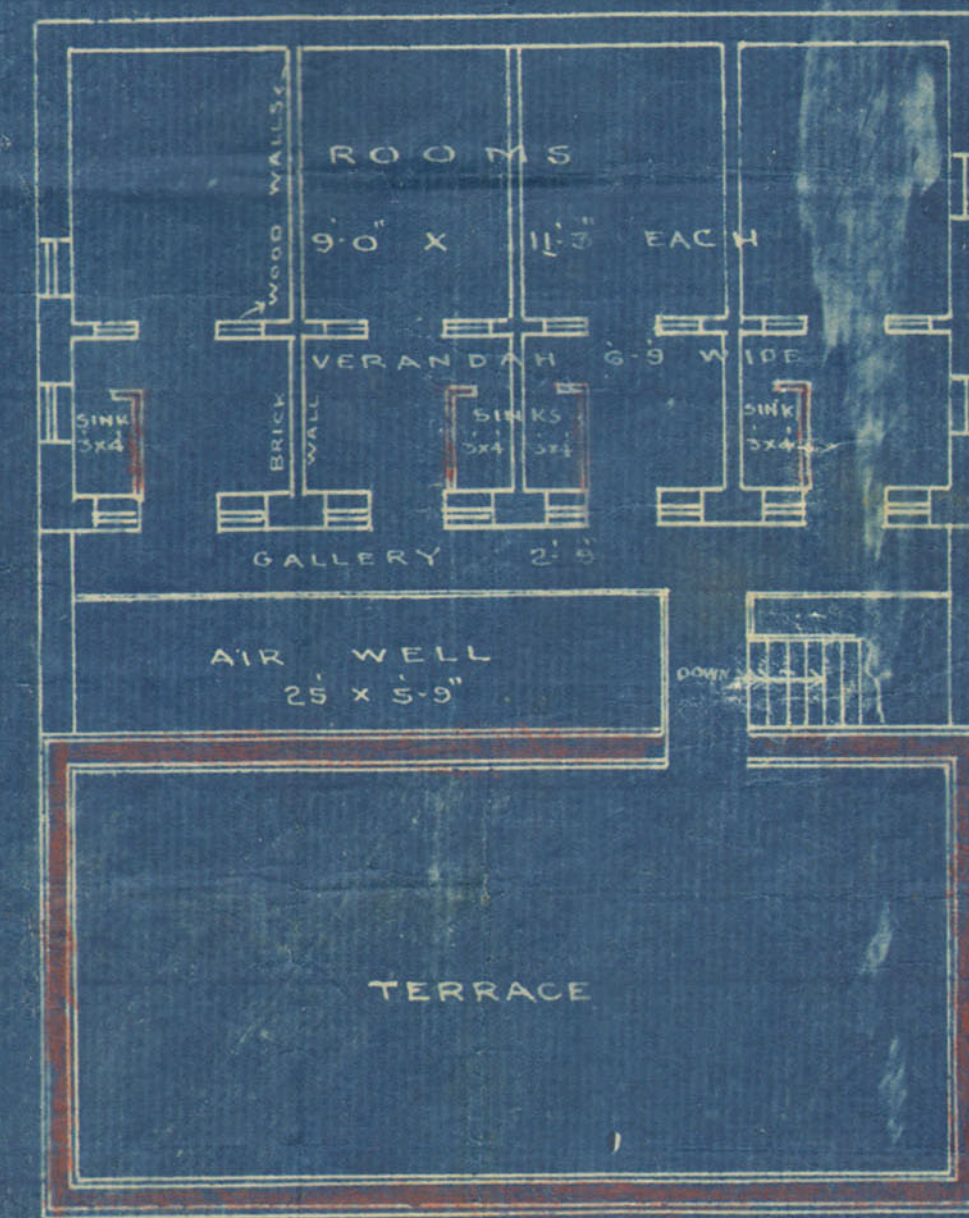

PLAN OF 2ND FLOOR

M. Nazareth
9th Mar 24

ce. Hafiz Salim