



BUILDING COMPLETION REPORT.

Land Manager and Architect's Office,

Karachi, _____ 193

Undersigned begs to report that the construction of ~~building~~ *Calum* additions & alterations on plot No. *34* Sheet *N.D. 11 Nafsin* Quarter owned by Mr. *Parmanand Gokaldas* has been completed according to plans approved by the Municipality. Orders are requested to file the correspondence.

ie B. E.,
Building Surveyor
" *B* " Section.

No. B. S. *Q. P.* *5-8* of 193*2*Karachi, *3.* *5-* 193*2*

Copy forwarded to the Assessor for information, ~~in continuation to this~~
office No. _____ dated _____

B. S. 14 { 500-8-31.
500-3-32.

St. N. J. ...
B. Sc., A. M. Inst. C. E.
Land Manager & Architect.



Heritage

KMR.CDD.NaQ.1932.02

N. J. MODI.

B. Sc., Engineering (London),
A. M. INST., C. E., L. C. E.
A. M. I. S. E., M. R. San. I.
Land Manager & Architect.

No. L. M. A/B.S. 1 68 OF 1932 .

MUNICIPAL OFFICE,

KARACHI, 8. 11 1932.

MEMO :



Building Surveyor Section B. in informed
that Mr. Perm-anand Gokaldas has been permitted
to build
his house
on plot No. 34 N. P. II Street
Napier Quarter. Report should be made to the
undersigned when house in completed.

N. J. Modi

B. SC., A. M. INST. C. E.

Land Manager & Architect.


B S. 29 { 300-3-30
300-6-31

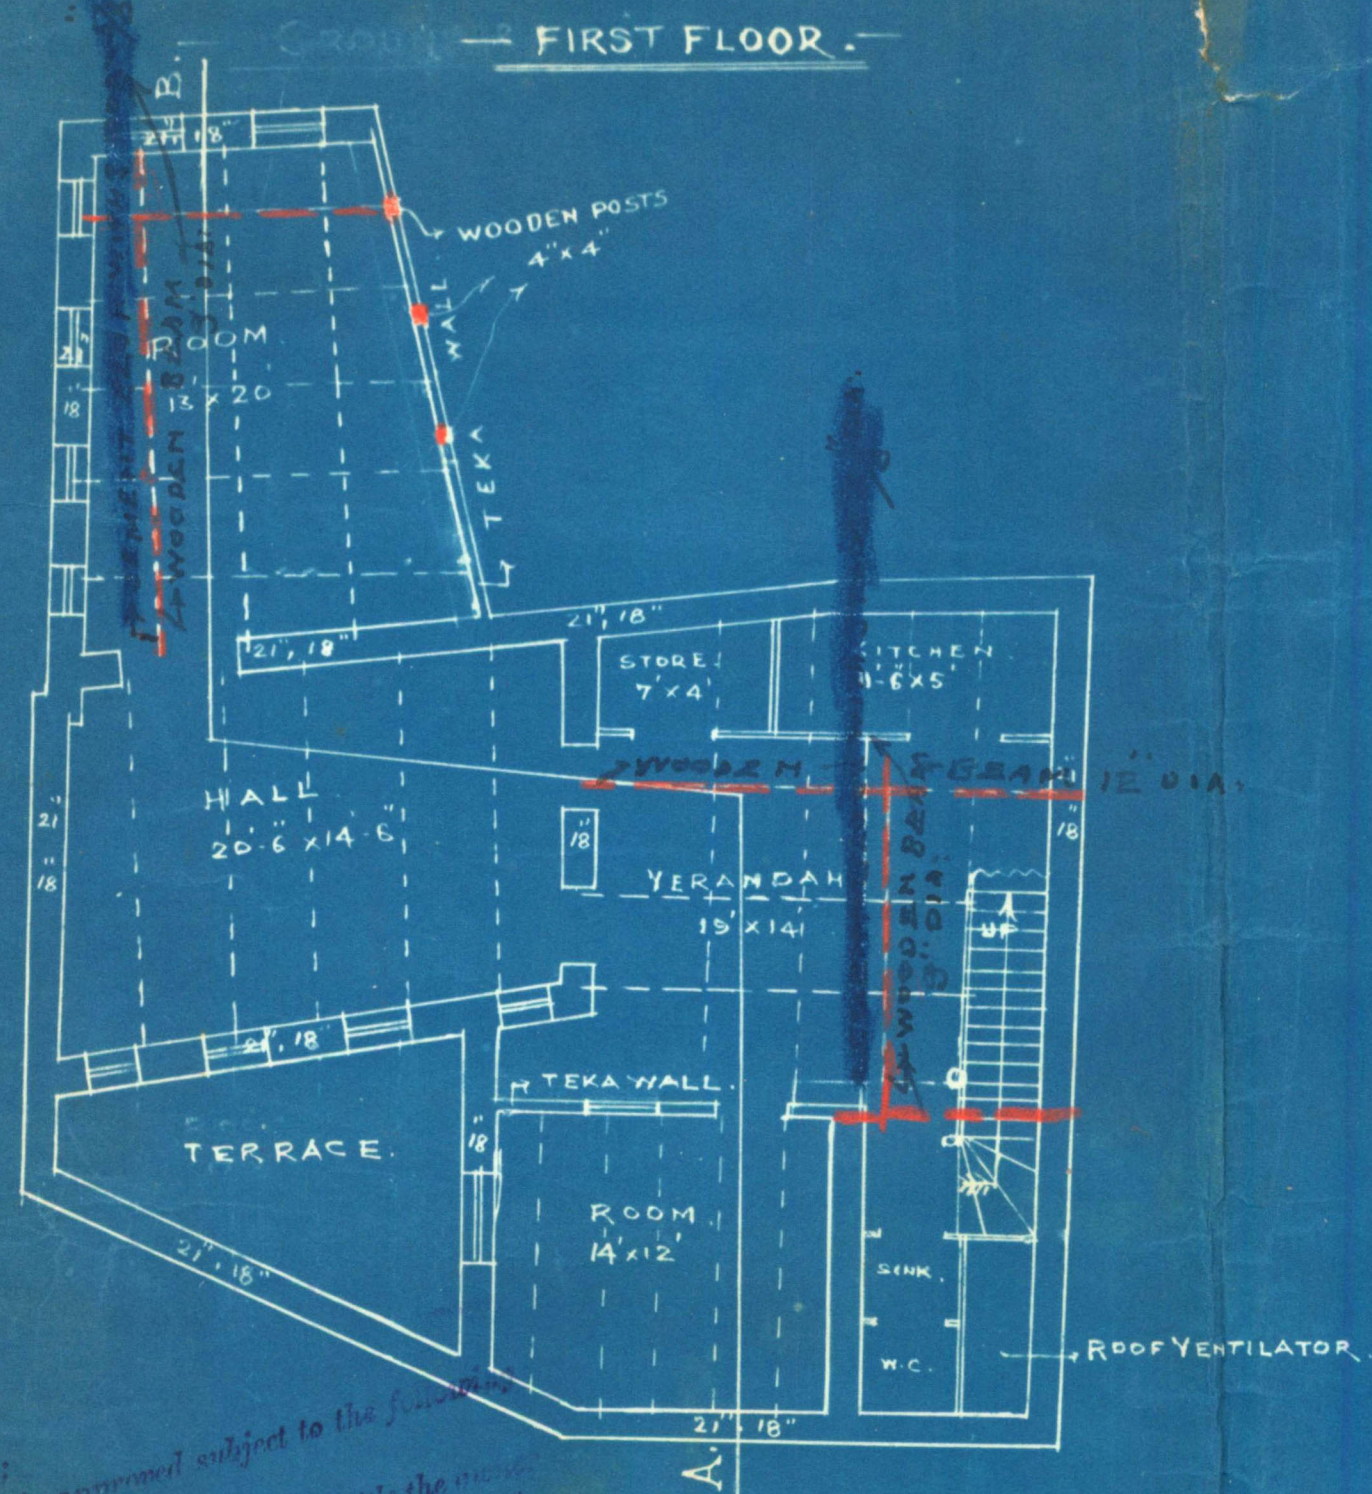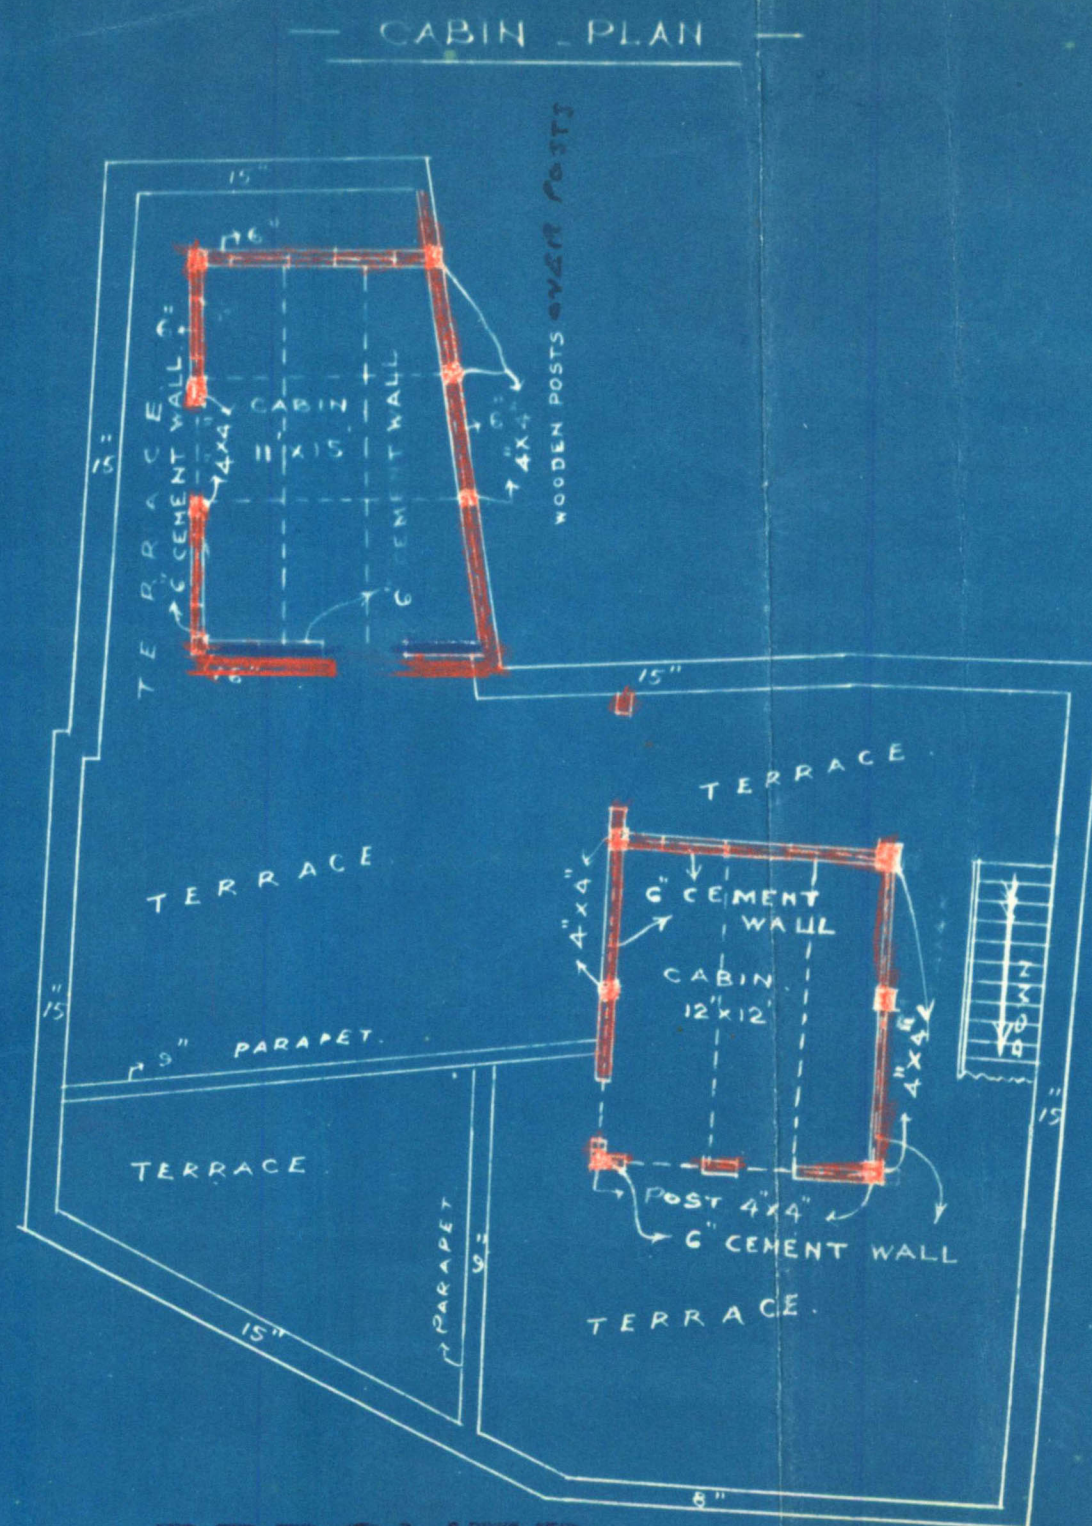

PLAN.
— SHOWING PROPOSED CABINS —
— ON PLOT NO 34 NP 11, —
— NAPIER, QTR —
— SCALE: 8' = 1" —

Note:
Plan is approved subject to the following conditions:-
1. The sanction does not entitle the owner to build on land not intended to him either by the Govt. or the Municipality by a sand or entry in a sand.


SECTION ON A.B.

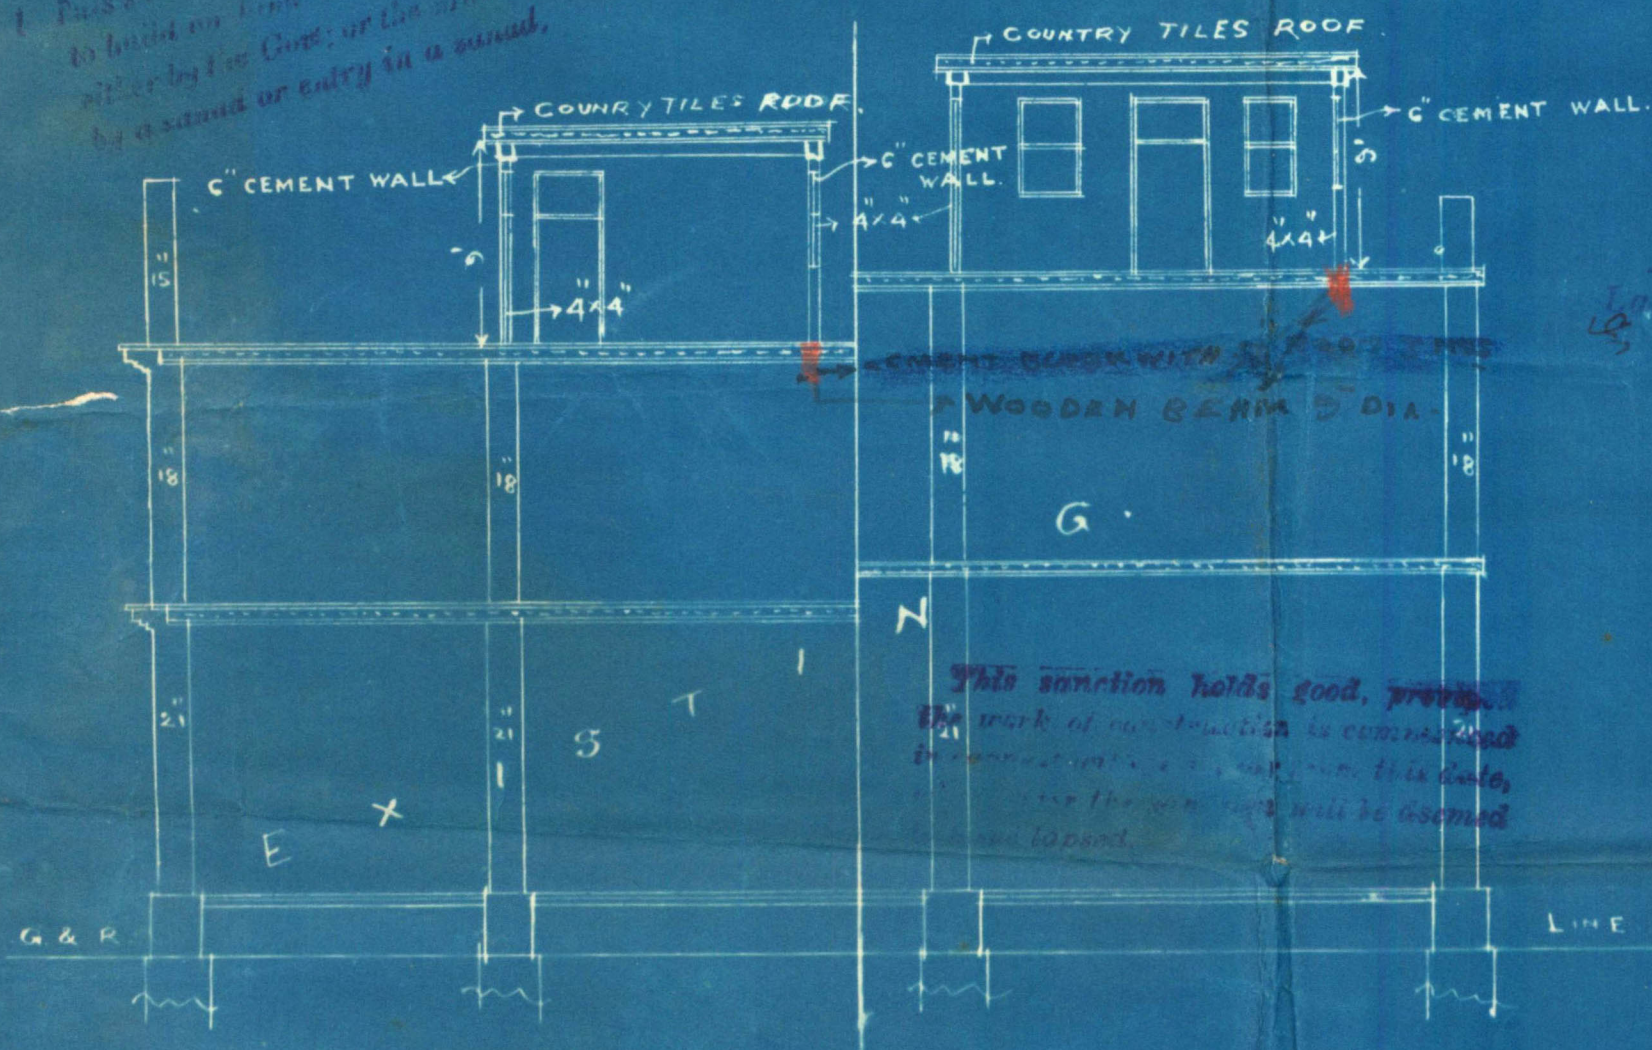


APPROVED.

B. So., A. M. Inst. C. E.,
Land Manager & Architect.

This sanction holds good, provided the work of construction is commenced in accordance with the plan, this date, and the same will be deemed to be closed.

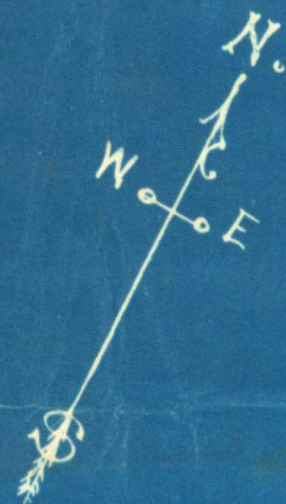

SITE PLAN
— SCALE: 20' = 1" —

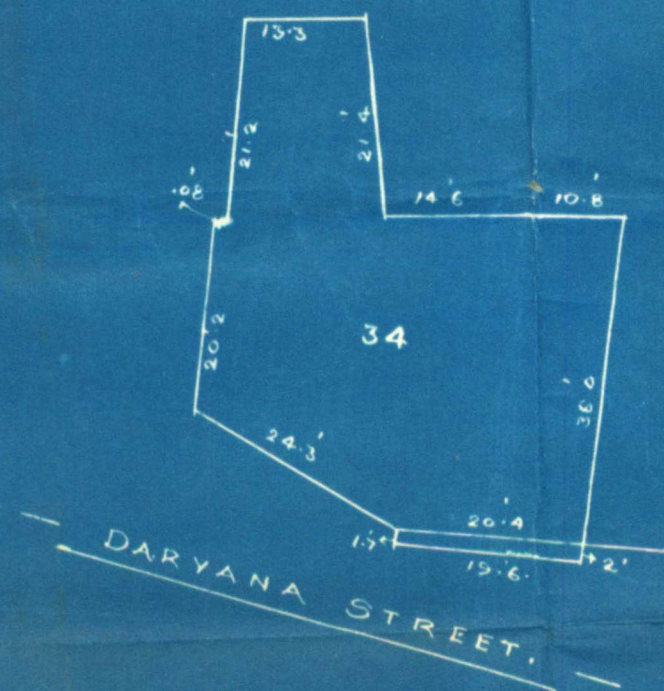

M. KHIMJI & CO.
ARCHITECTS & SURVEYORS.
WATER-COURSE ROAD.