



Heritage

KMR.CDD.NaQ.1934.01

Office Telephone Nos. 1140 & 1111.

Residence " " 199.

KUMBERALI BHALEDINO,

L. C. E.

LAND MANAGER & ARCHITECT

**MUNICIPAL CORPORATION,
KARACHI.**

REF. No. B. S. P. 537/34

MEMO :—

N.P. 12

6 - OCT 1934

Re : Plot No. 64 & 65 / Sheet

Napier Qr.

Plan for buildingon the above plot submitted by Mr. Jethanand Hiranand

have been approved by the Municipal Corporation, Karachi.

Kumberali Bhaleedino

Sd/-

Land Manager & Architect.

(3)

Copy forwarded to :—


1. Health Officer.
2. Supdt. of Machinery.
3. Assessor.
4. Building Surveyor.
5. Land Surveyor.
6. Enquiry Officer.

for information and necessary action.

AMENDED PLAN OF BUILDING ON
PLOT N^o 64+65 SHEET N.R. 12
NAPIER QUARTER
SCALE 8"=1" INCH




GROUNDPLAN

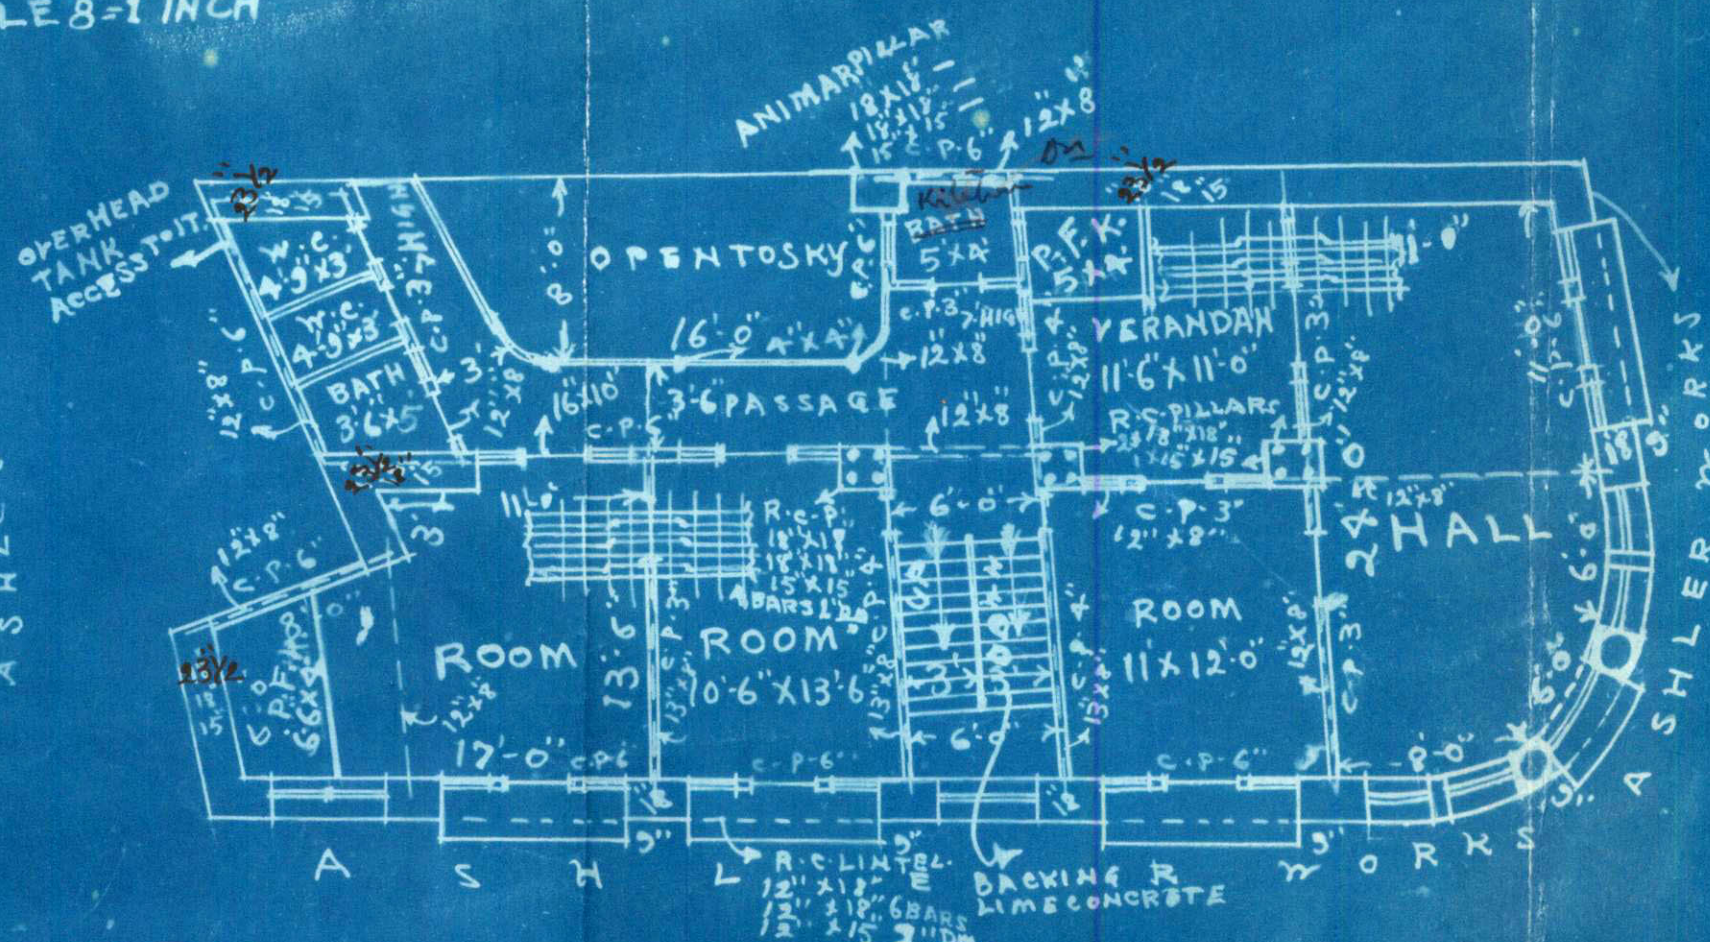


1ST 2ND & 3RD FLOOR PLAN

Lambertia. Merletia

Land Manager & Architect.

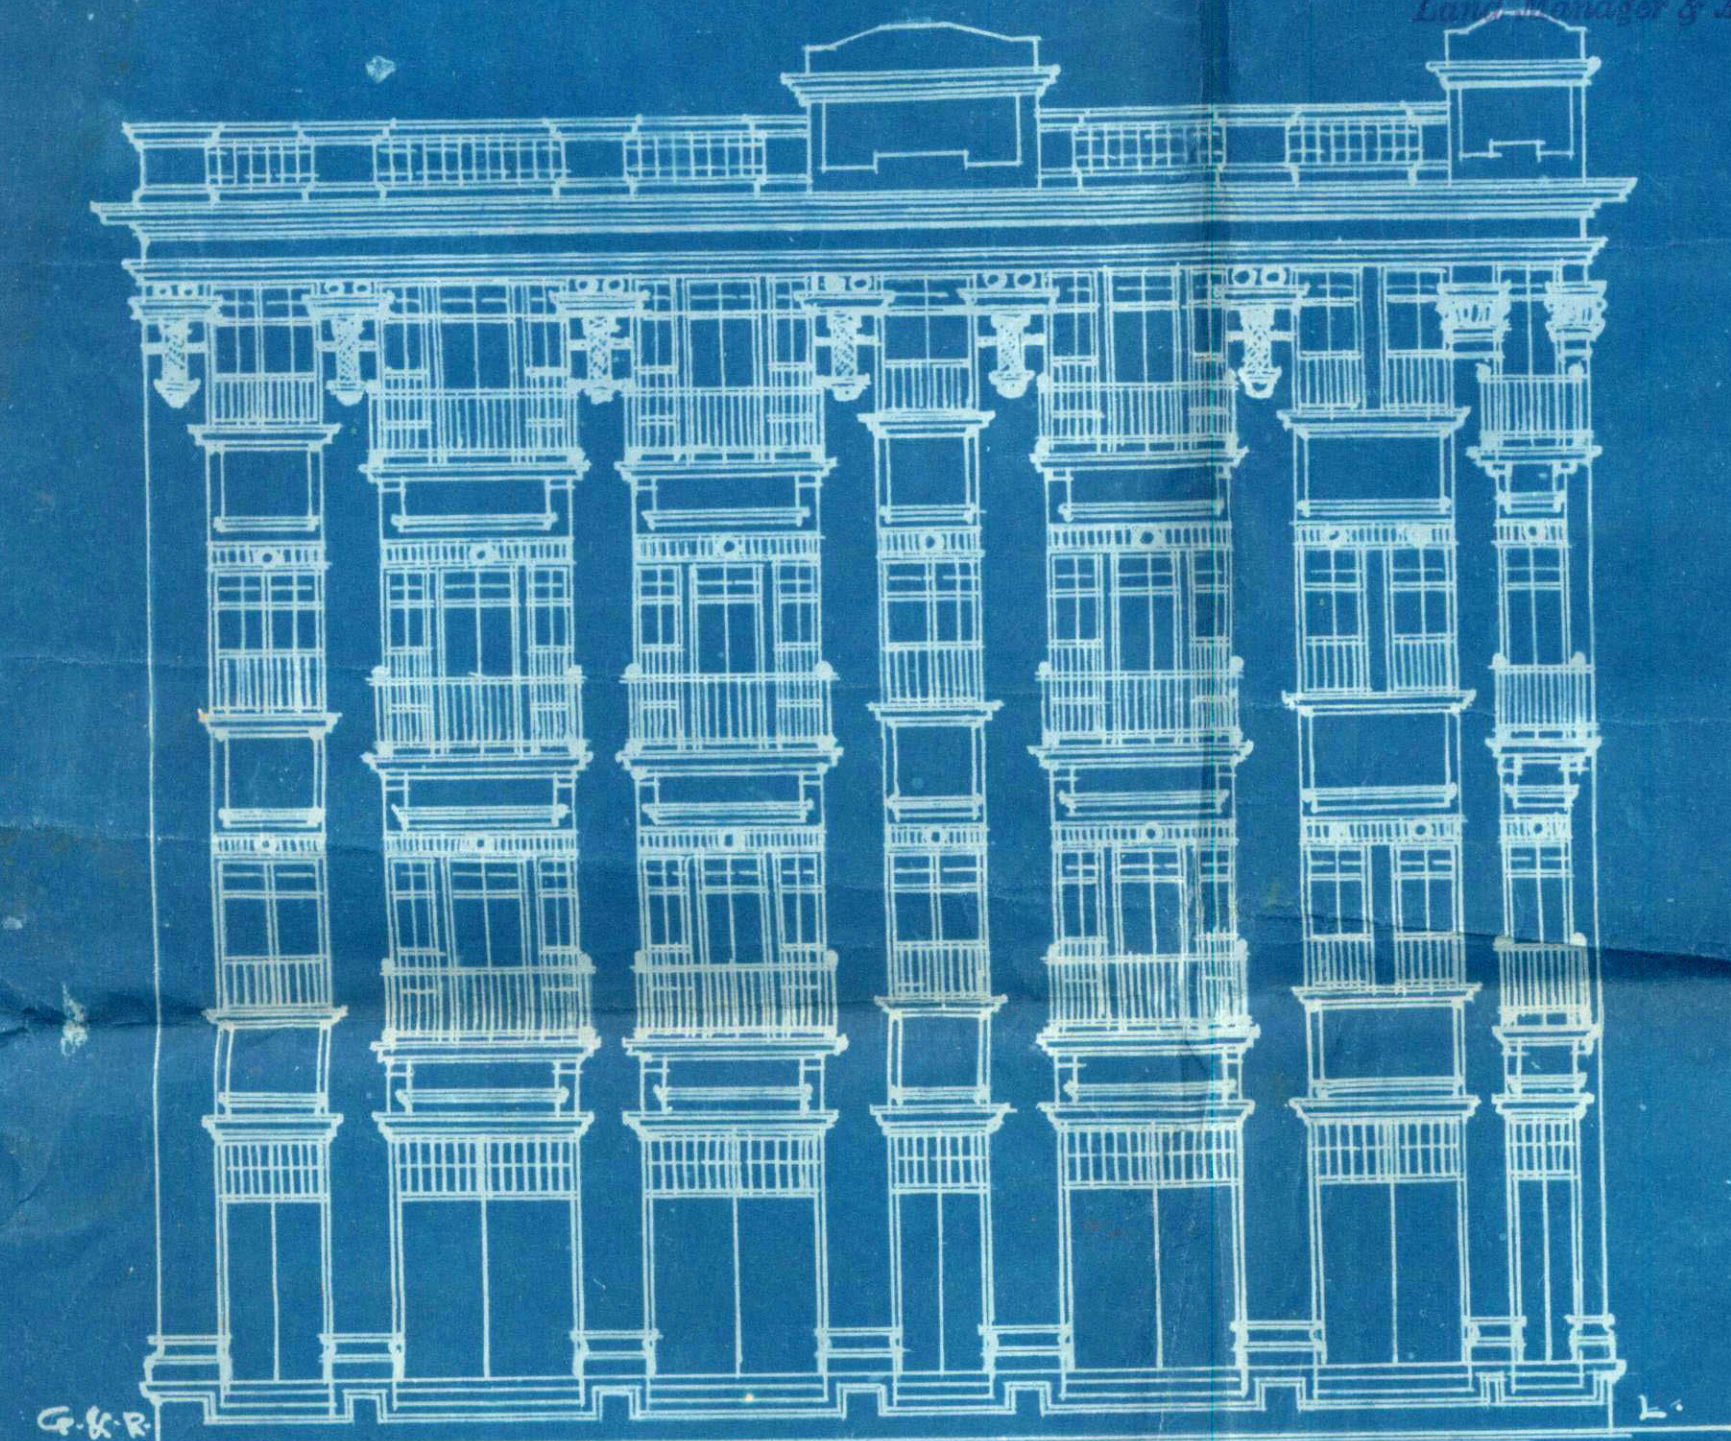


FRONT ELEVATION

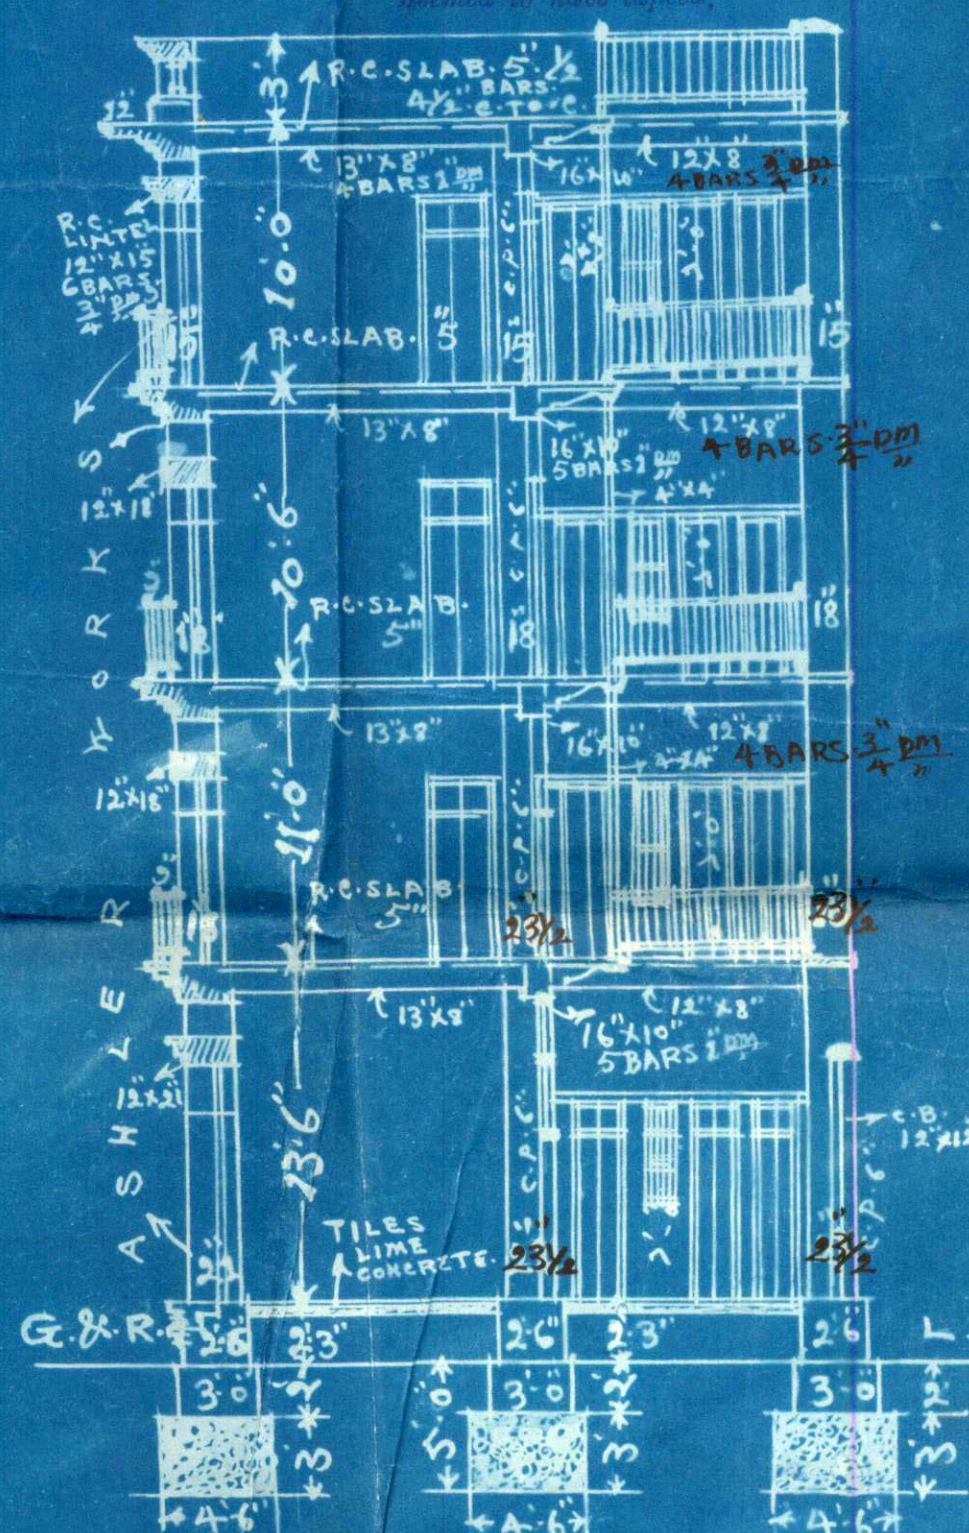

SECTION ON A. B.

BLOCK PLAN
SCALE 20'=1" INCH

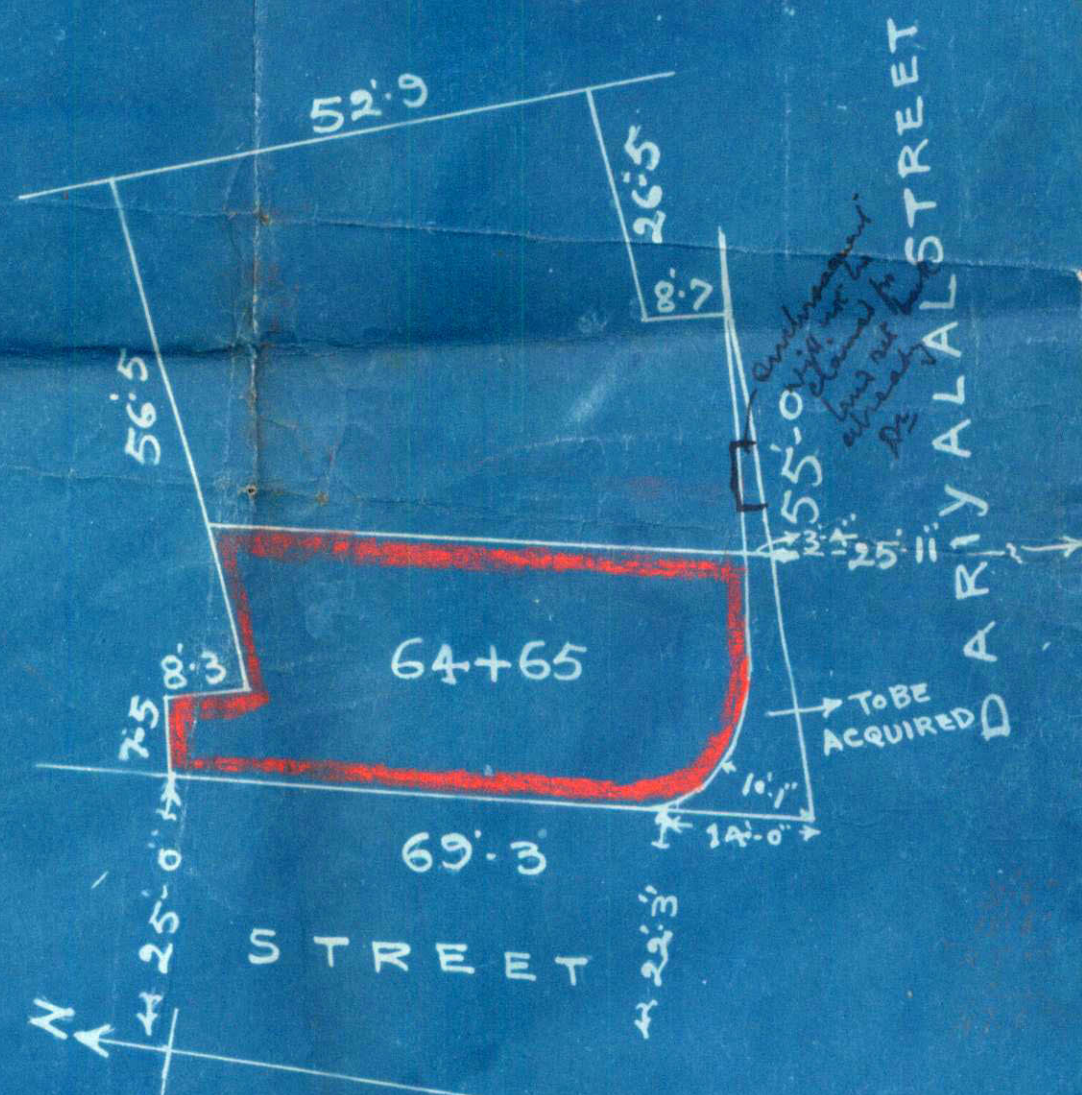

Jethanand Hiranand 10-9-34

DEVKISHINDAS & CO.

ARCHITECTS
AND
SURVEYORS.

NEAR KHORI GARDEN,



8th Oct. 1934

To

The Land Manager & Architect
Karachi Municipal Corporation

Sir

Re Plot P.O. 6426514P-12
Napier Gz

I hereby inform you that
on roof of ground floor reinforcement
has been laid. Please
depute your B.S to inspect
the same.

Yours faithfully
Devkishindas

Sent. certificate
to Mr. Khan
Buland

P.S.
me
9/10

13/11

P. attach with class
7/10

Sent.
Kala

DEVKISHINDAS & CO.

NEAR KHORI GARDEN,

ARCHITECTS
AND
SURVEYORS

LAND MANAGER &
ARCHITECT'S DEPT.
KARACHI MUNICIPALITY
31. JAN. 1935
No.

31st Jan 1935

To

The Land Manager & Architect
Karachi Municipal Corporation

Sir

Re plan no 64 H.P.-12

Napier Q^r

I hereby inform that
reinforcement has been
laid for the top floor roof
on the above plan. which
please note

Yours faithfully

Devkishindas

M. M.
- M.
1/2

P is the deviation
between providing 4" to outhaus
as the spec. the
same as the spec. the
same as the spec. the
same as the spec. the

Office Telephone Nos. 1140 & 1141.
Residence " " 199.

KUMBERALI BHALEDINO,
L. C. E.
LAND MANAGER & ARCHITECT



KMR.CDD.NaQ.1934.01

**MUNICIPAL CORPORATION,
KARACHI.**

July 1934.

Reference No. B. S. C.P. 537/34

28 FEB 1935

NOTICE OF DEVIATION FROM APPROVED PLAN

To, Mr. Jetnand Hirchand
c/o Mr. Devkishindas (Architect)
Karachi

Dear Sir,

Re:—Plot No 64365 Sheet No N.P. 12, Napier Quarter.

You are hereby informed that you are carrying out, or have carried out the construction work on the above plot in a manner contrary to approved plan, as follows—

1. ^{c.f.} 4" are provided to out-houses abutting on open spaces
The same should be 6" .

You are therefore, hereby required forthwith upon receipt of this notice to stop the work and to make the building in conformity with the approved plan.

If you fail to comply with the requirements of this notice within seven days of its receipt, prosecution will be filed against you.

Yours faithfully,

Kumberali Bhaledino

27/12
Land Manager & Architect.

Copy forwarded to Mr. Devkishindas Architect, to explain within three days of receipt of this Notice as to why he allowed the above unauthorised deviations without permission from the Municipal Corporation.

Kumberali Bhaledino

Land Manager & Architect.



DEVKISHINDAS & CO

ARCHITECTS
AND
SURVEYORS.LAND MANAGERS & ARCHITECTS
ARCHITECT'S DEPTT.
KARACHI MUNICIPALITY

1 - MAR. 1935

No. 720

BEAR KHORI GARDEN, 6

1st March 1935

To

The Land Manager & Architect
Karachi Municipal Corporation

Sir.

Re plos no 64 & 65 NP-12
Nafin Gr

With reference to your
no B S C P 537/34 dated 28th Feb
Re 4" c. P abutting on open space
I have to say that 1" cement
plaster will have to be applied
on each side of the wall and
wall will be made 6".

P.D.
me
2/3Yours faithfully
Devkishindas

This f.o. is with you

B
2/3

P. attach 4c

43

P. sub heading

2/3

DEVKISHINDAS & CO.

ARCHITECTS
AND
SURVEYORS.

NEAR KHORI GARDEN.



To

The Land Manager & Architect
Karachi Municipal Corporation

Re P O 64065 NP-12 Napier

Sir,

With reference to your
no 524/34 dated 28 Feb 1935
I have to say that your statement
of doors width being not 6'-0"
is wrong. The same could be
verified on site on any day
or hour. Everything is kept
according to approved plan.

Yours faithfully
Devkishindas

ms.
ml
2/3

This is done with you
1. attach plan 5/3
2/3

LAND MANAGER &
ARCHITECT'S DEPTT.
KARACHI MUNICIPALITY

NOTICE OF COMPLETION UNDER SECTION 187 (1) OF THE
CITY OF KARACHI MUNICIPAL ACT. 1933. No. 1481

Karachi, 8th May 1935

To,
The Chief Officer,

Karachi Municipal Corporation,

DEAR SIR,

I hereby inform you that my following building and drainage
work (insert full particulars of the work) 3 storied Building
with R.C.C. roofs on plot no 64
N.P.-12 Napier G^o

has been completed and the certificate of completion signed by the Licensed
Surveyor, who supervised the work, is submitted here-below.

Yours faithfully,

Abanand Gopal Das
Owner, *Abanand Gopal Das*
Pardandas

Address

Completion Certificate

TO BE SUBMITTED BY LICENSED SURVEYOR

BUILDING AND DRAINAGE COMPLETION CERTIFICATE.

I do hereby certify that the following building and drainage work
(insert full particulars of the work) 3 storied Building

with R.C.C. roofs on plot no 64
N.P.-12 Napier G^o

has been supervised by me and has been completed to my satisfaction, that the
workmanship and the materials used are good; and that no provision of the act
or the Bye-laws and no requisition made, condition prescribed, or order issued
thereunder has been transgressed in the course of the work

Signed.

Lentkishindas h.
Dated 8th May 1935



NOTICE OF COMPLETION UNDER SECTION 187 (1) OF THE
CITY OF KARACHI MUNICIPAL ACT, 1933.

Karachi, 8th. May 1935

To,

The Chief Officer,

Karachi Municipal Corporation,

DEAR SIR,

I hereby inform you that my following building and drainage
work (insert full particulars of the work) three storied building
with R.C.C. Roofs on plot No: 64, N.P. 12 Napier cr:

has been completed and the certificate of completion signed by the Licensed
Surveyor, who supervised the work, is submitted here-below.

Yours faithfully,

(sd) Jethanand Hiranand etc:

Owner,

Address


—: o :—

Reference No. B. S. C. P. 537/34

Municipal Office,

Karachi, 10.5.35

1. Copy forwarded to the Assessor, Karachi Municipal Corporation for information. The above notice of completion was received on 8.5.35
2. Copy forwarded to the Superintendent of Machinery, Karachi Municipal Corporation to communicate direct to the owner if there is any objection to occupy the building and to send copy of his objection to the undersigned.
3. Copy to the Land Surveyor, Karachi Municipal Corporation to take action at once if there is any encroachment on Municipal Land.

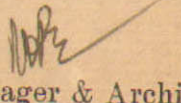
For Land Manager & Architect,
Karachi Municipal Corporation

*Pl. find info
completion report forward.
Recd. 11/5/35.*

BUILDING COMPLETION REPORT.

Land Manager & Architect's Office.

Karachi 22nd. May 1935Undersigned begs to report that the construction of buildingon lot No 64&65 Sheet N.P. 12 Napier Quarter owned byr. Jethanand Hiranandhas been completed according to plans approved by the Municipal Corporation.
Orders are requested to file the correspondence.Rozario M. Castelin B. E.

Building Surveyor

„ C „ Section

No. B. S. C. P. 537/34Karachi, 27 MAY 1935Copy forwarded to the Assessor for information in continuation to this
office No C.P. 537/34 dated 10th. May 1935*Lambert. Shurleiffe*

Land Manager & Architect.

R. B. 14 { 1000-8-34

*Rue**as*