



Heritage

KMR.CDD.MiQ.1928-1929.01

KARACHI MUNICIPALITY.

REFERENCE No. L. M. A. 1080-3417 OF 1929.

MUNICIPAL ENGINEER'S OFFICE,
KARACHI, 12/6 1929.

MEMO

Memorandum after a week the limits of the building were the same.

With reference to his application dated 24th May 1929.
with the amended plans for the building on plot No. 12, Ry-9 Sheet
4 Quarter, Mr. Khaimji J. Karia for
over is informed that a copy of the plan is

returned herewith duly signed and approved.

*Submitted if completion
report be put into*

*cc.
10/6*

[Signature] 11/6
Executive Engineer,
Karachi Municipality.

500-1-26
200-14-3-28

*Report
Completed as per plan.*

C

P. put up

forms

for

completion

MADHAVJI KHIMJI

ARCHITECT.



Heritage

KMR.CDD.MIQ1928-1929.01

Karachi Hyderabad Sind,
D/- 21st May 1929

20.

The Land Manager & Architect.
Karachi Municipality.

Sir,

I have the honor to submit
herewith plan in quadruplicate showing
R.E. floor & roof to the outhouses of the
Bungalow on Plot No 12 Check Ry: 9.
Railway Quarter for favor of your
early approval.

Submitted to Mr. R.B.
there is no objection
to aff. the roof plan
C

C

P. attach approved plan
E.B.V.
25/5

Approved plan
attached
25/5

P.R.B.
25/5

I have the honor to be
Sir,

Your most obedient Servant

M. Khimji



Reif or. J. Khimji to affd

J. Khimji

2-14-29


from Mr. R.B.
they were not being as
two to sign plans. 2/6



Heritage

KMR.CDD.MiQ.1928-1929.01

GROUND FLOOR PLAN

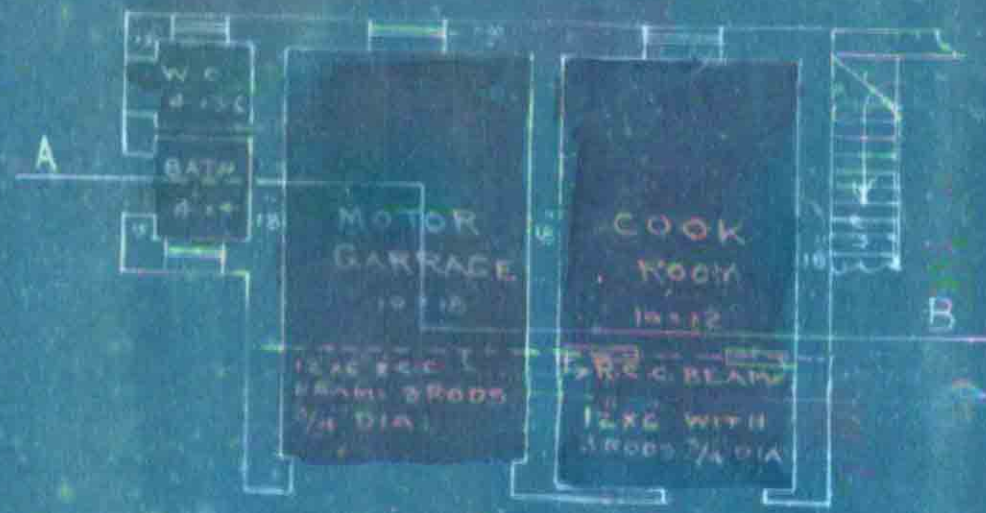


FIRST FLOOR PLAN



PROPOSED R.C.C. SLAB TO THE OUT-HOUSES OF 2ND BUNGALOW ON PLOT NO. 12 SHEET R.Y. 9 RAILWAY Q.R.

SCALE 8 1/4 INCH

SECTION ON A.B.

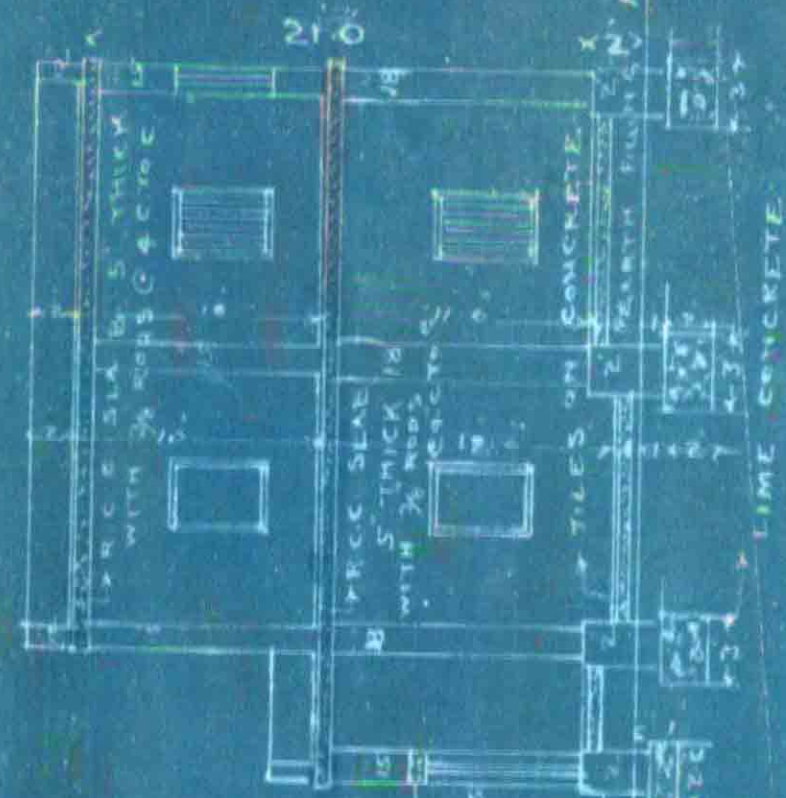

DETAILS OF 5" THICK R.C.C. SLAB

SCALE 1/4" = 1 FOOT




R.C.C. BEAM UNDER THIN PARTITION WALL OF VERANDAH 12' x 6'

3/4 DIA 5 RODS (1 BENT & 2 STRAIGHT)



Khuram Khan 23529

M. KHIMJI & CO
ARCHITECTS & SURVEYORS
WATER COURSE ROAD
KARACHI

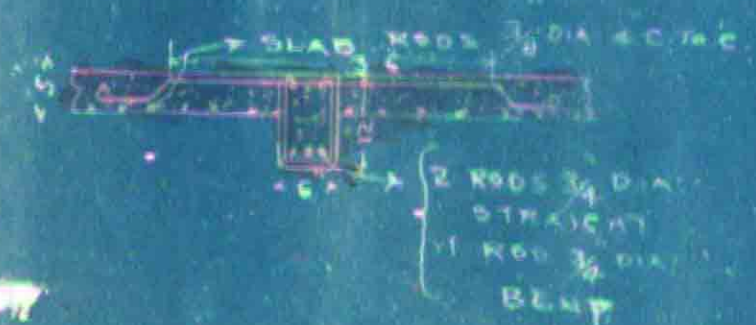




Heritage


KMR.CDD.MiQ.1928-1929.01

GROUND FLOOR PLAN

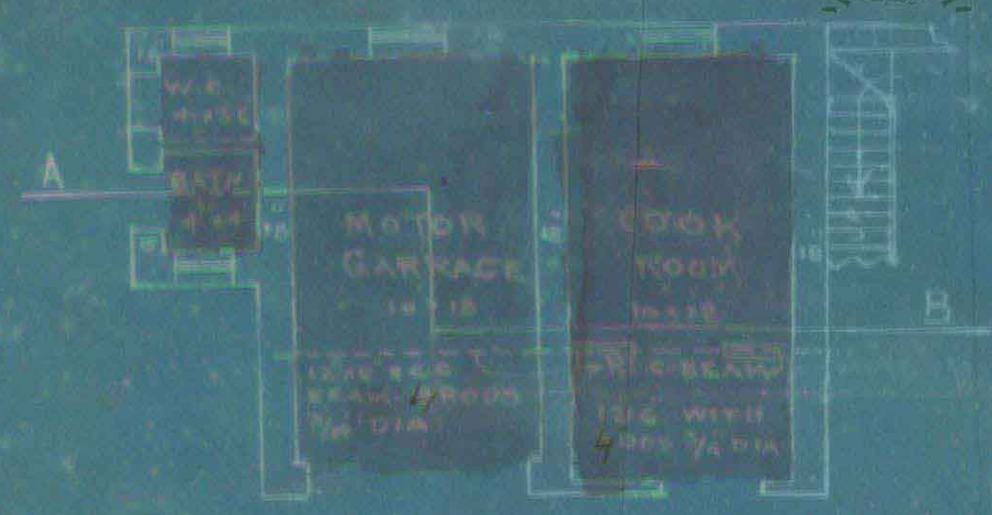


PROPOSED R.C.C SLAB TO THE OUT-HOUSES OF 2 NB BUNGALOW ON PLOT NO. 12 SHEET R.Y. 9 RAILWAY Q.N.

SCALE 8" = 1" INCH.

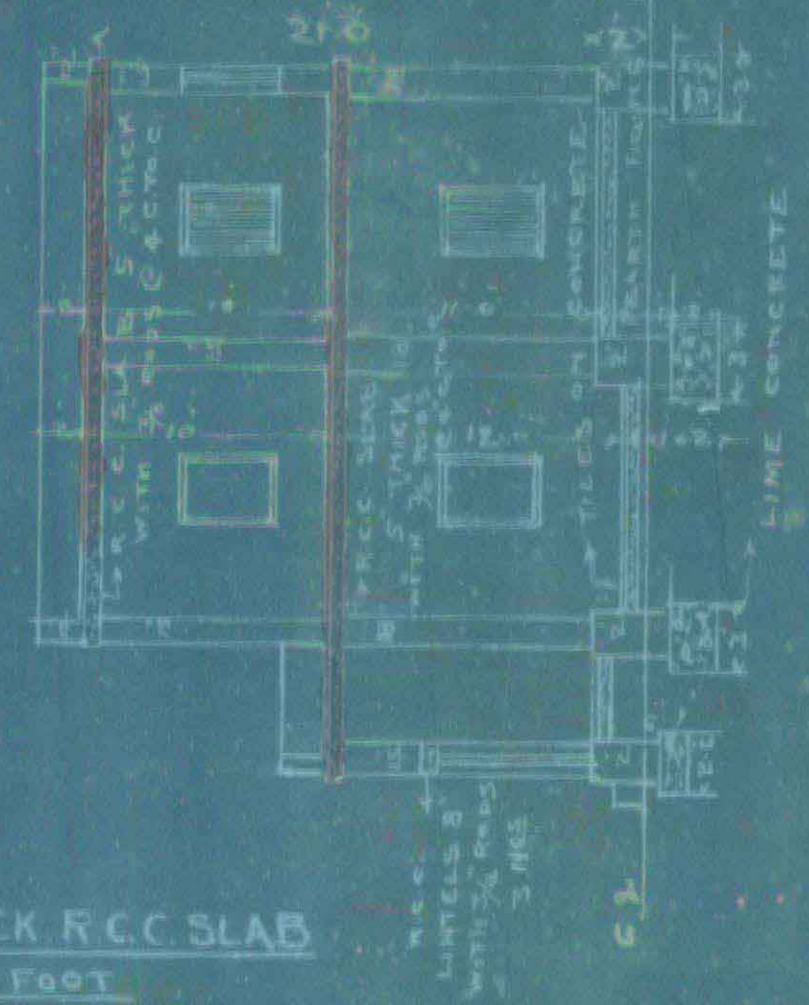


SECTION ON A.B.


FIRST FLOOR PLAN

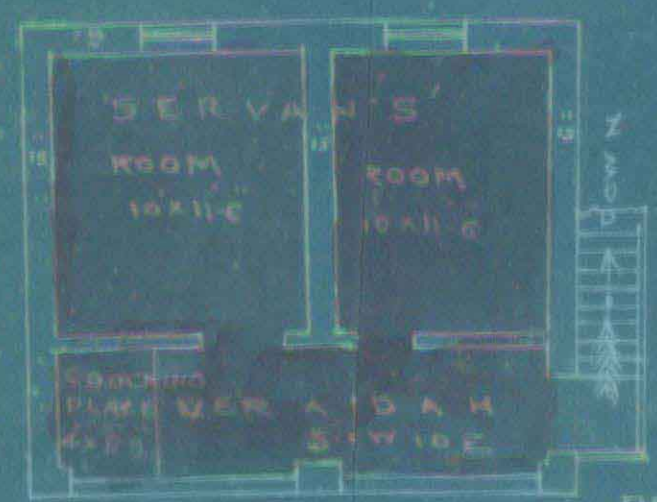

DETAILS OF 5" THICK R.C.C SLAB SCALE 1/2" = 1 FOOT

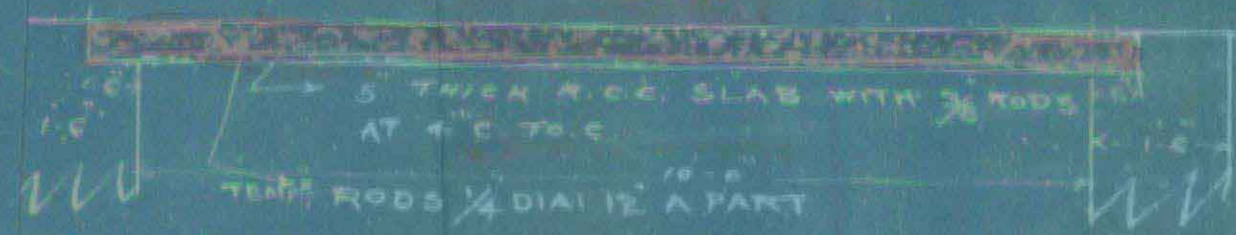

R.C.C. BEAM UNDER THIN PARTITION WALL OF VERANDAH 12" X 6"

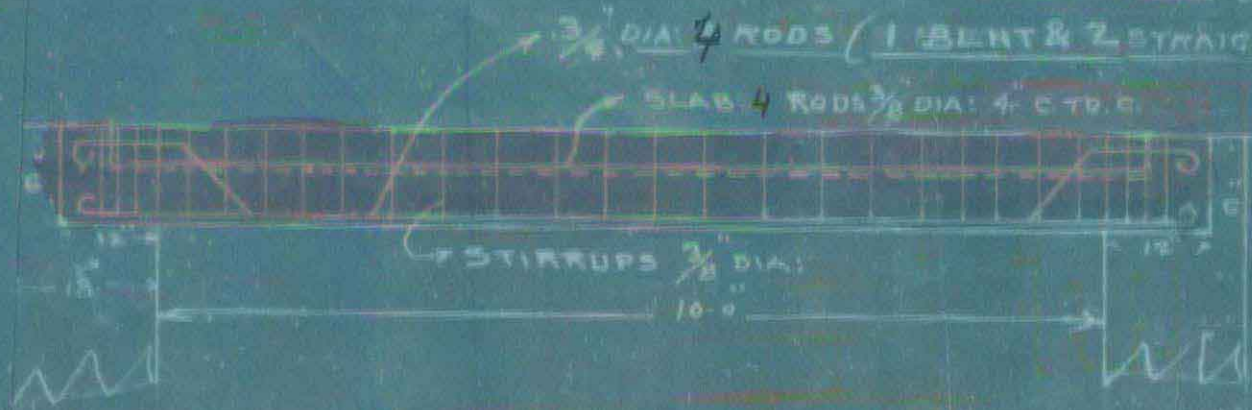

M. Khimji & Co. 23529


M. KHIMJI & CO.
ARCHITECTS & SURVEYORS
WATER COURSE ROAD
KARACHI



Heritage

KMR.CDD.MiQ.1928-1929.01

GROUND FLOOR PLAN

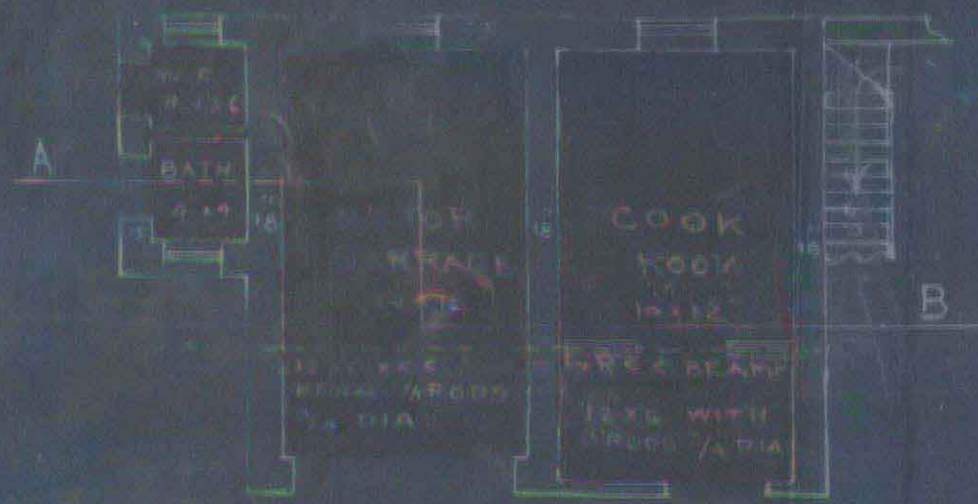


FIRST FLOOR PLAN



PROPOSED R.C.C SLAB TO THE OUT-HOUSES OF 2ND BUNGALOW ON PLOT NO. 12 SHEET R.Y.5 RAILWAY Q.R.

SCALE 8 INCH

SECTION ON A.B.

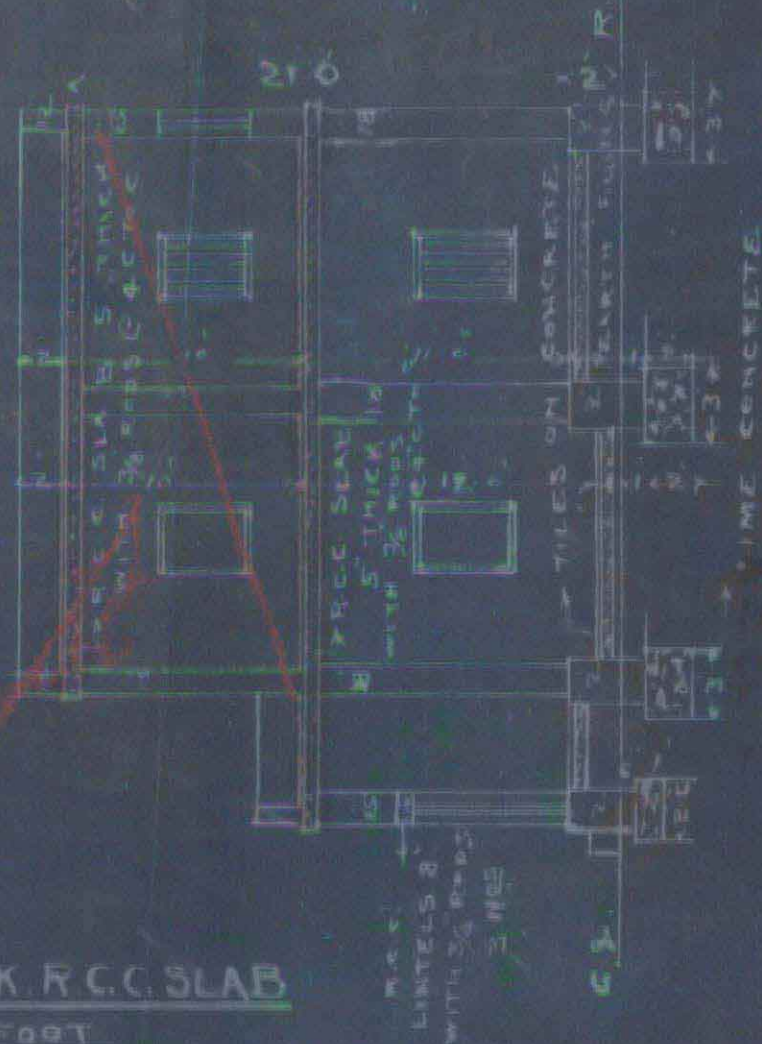

APPROVED

[Handwritten signature]

DETAILS OF 5 THICK R.C.C. SLAB

SCALE 1/2 = 1 FOOT



R.C.C. BEAM UNDER THIN PARTITION WALL OF VERANDAH 12' x 6'



3/4 DIA. 3 RODS (1 BENT & 2 STRAIGHT)

SLAB RODS 3/8 DIA. 4' C.T.O.C.

7 STIRRUPS 3/8 DIA.

[Handwritten signature] 23.5.29

M. KHIMJI & CO.
ARCHITECTS & SURVEYORS
WATER COURSE ROAD
KARACHI

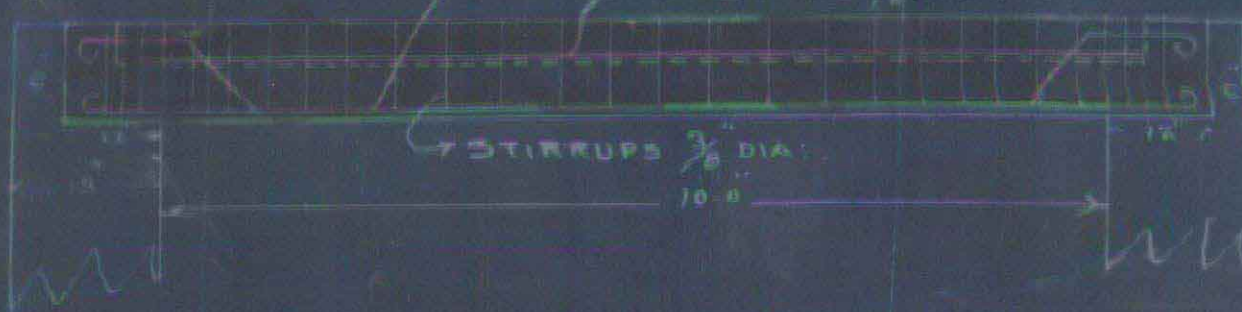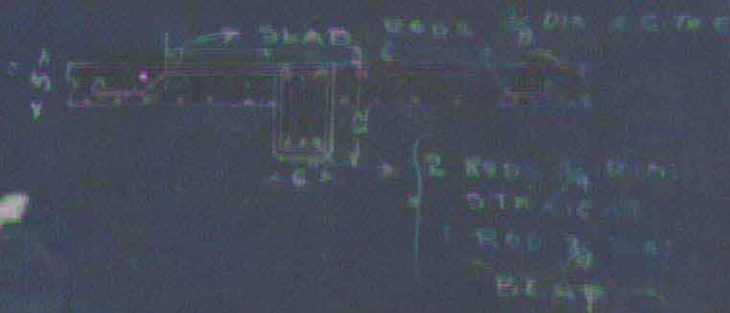



Heritage

KMR.CDD.MiQ.1928-1929.01

Form No. 6-300-28-6-27

No. L. M. A.

102. 0895 of 1929

MUNICIPAL OFFICE,

Karachi,

17/5

1929

MEMO:

Building Surveyor Section

'C'

is informed

that Mr. Abdul Majid Hassanally for self & others has been permitted
to make additions & alterations

his house

on plot No.

12

Reg - 9

Street

Railway

Quarter, report should be made to the

undersigned when house is completed.

A. J. Pindi

Executive Engineer,

Karachi Municipality.

15/5

15/5



Heritage


KMR.CDD.MiQ.1928-1929.01

DETAILS SHOWING R.C. BEAMS & SLAB
FOR BUILDING ON PLOT NO 12 - RT 9 RAILWAY QR



SCALE 2 FT = 1 INCH


Khemji Kana
10-4-29
ARCHITECT.

LONGITUDINAL SECTION OF BEAM IN BED ROOM

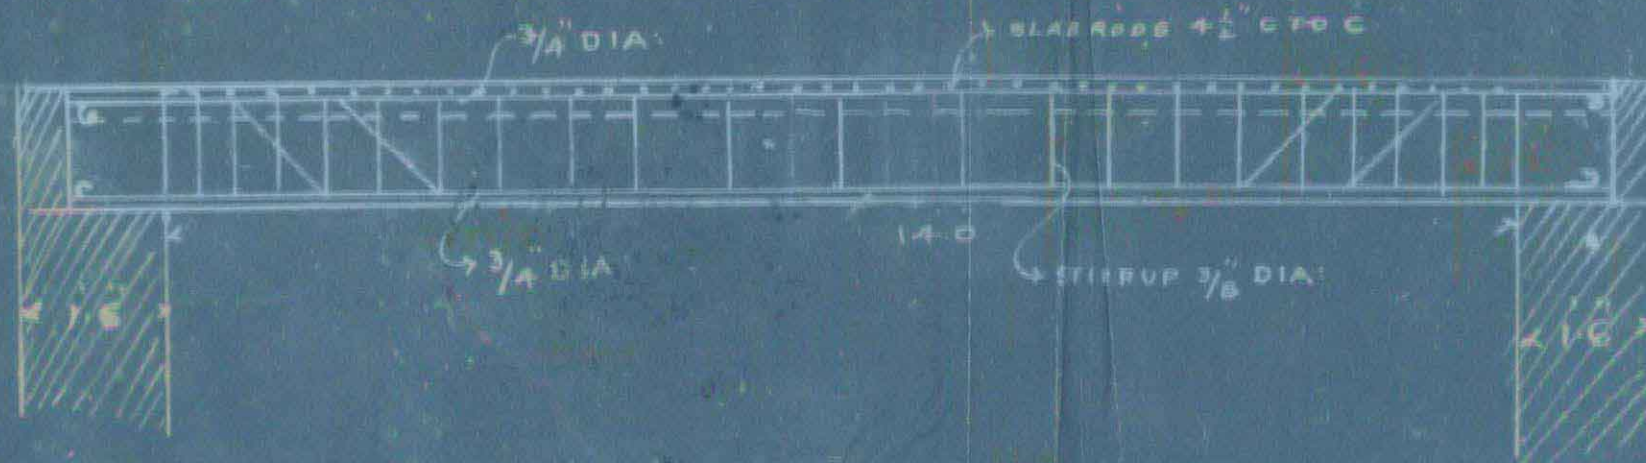

LONGITUDINAL SECTION OF BEAM IN DINING RM

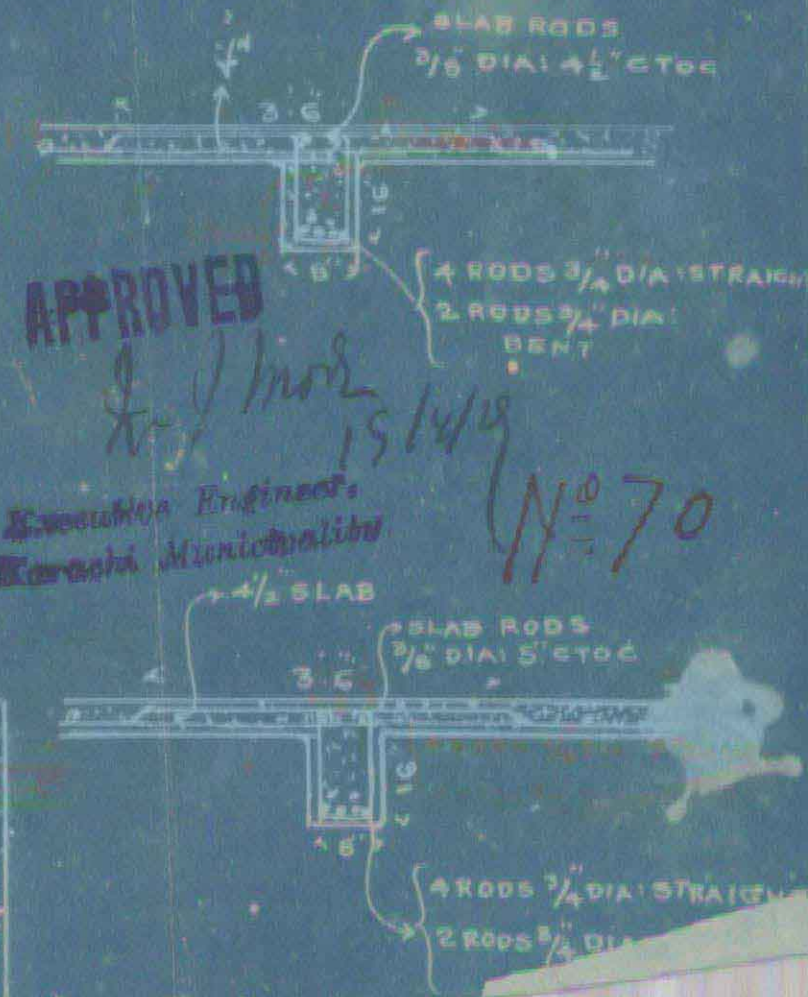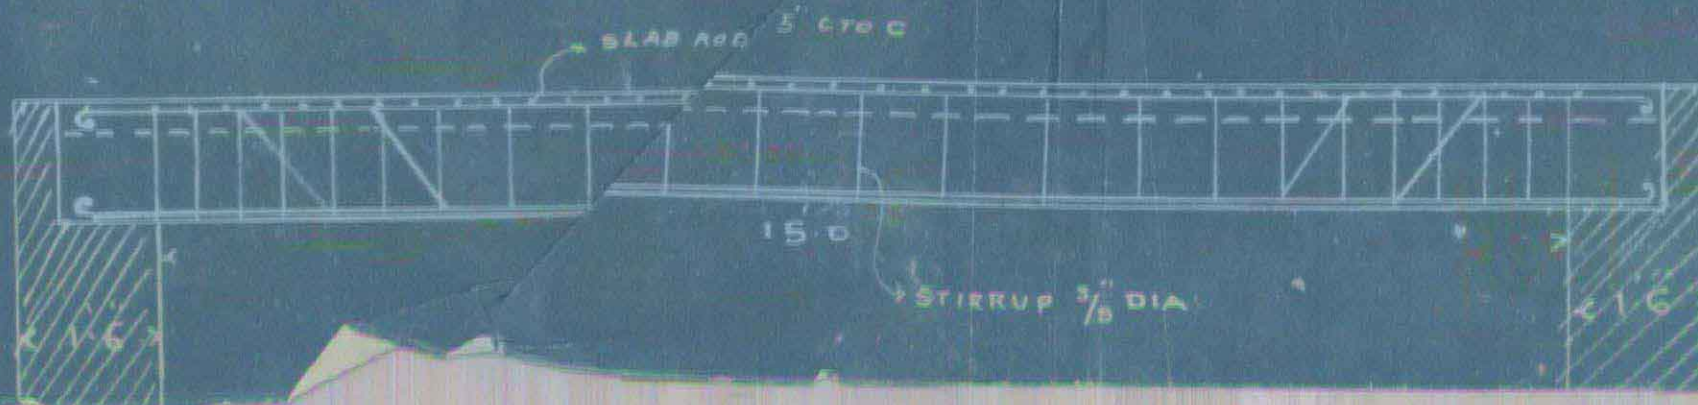

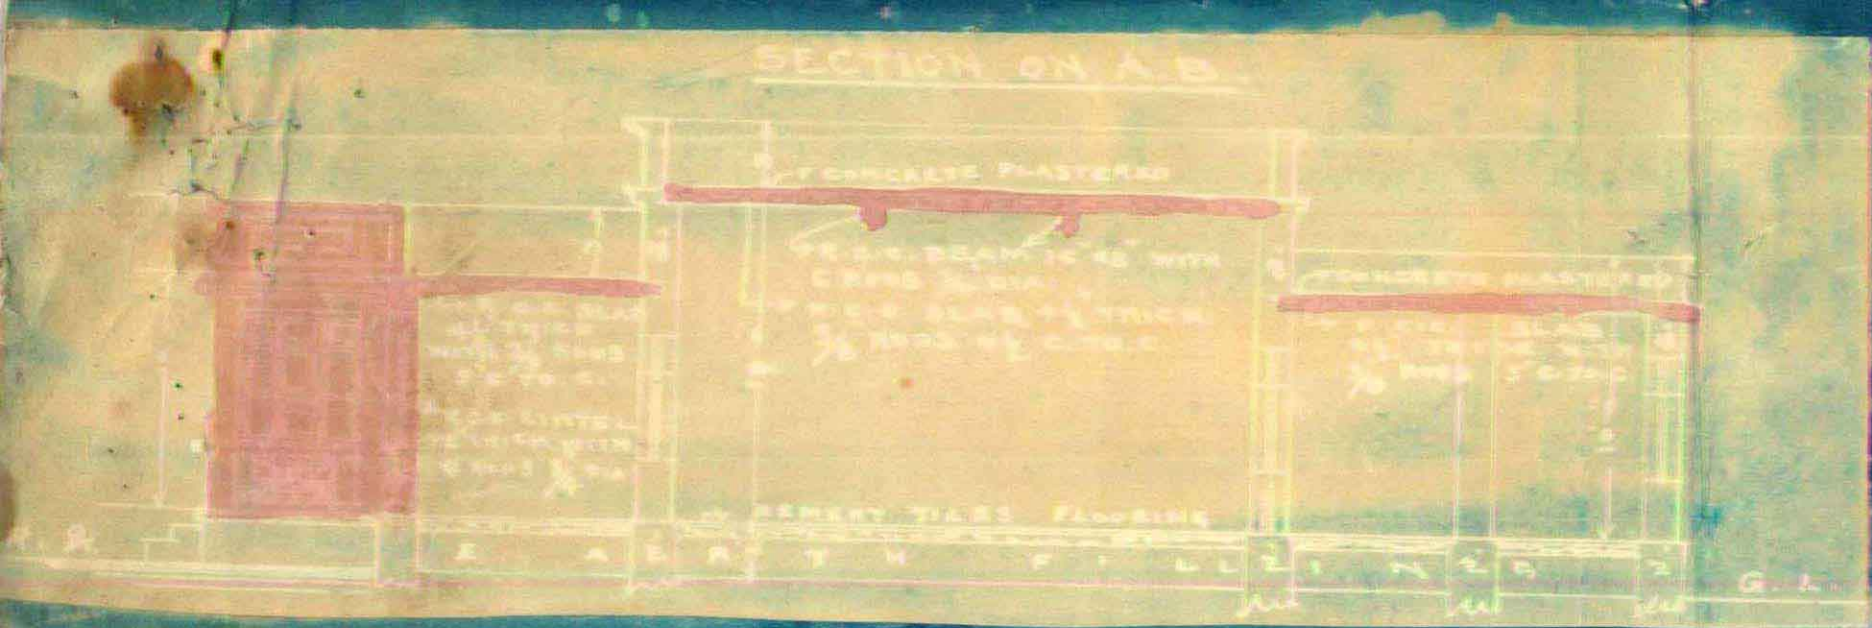

Heritage
FOUNDATION


KMR.CDD.MIQ.1928-1929.01

Plan showing proposed R.C.C. roof & bwt houses
to the existing Bungalow
on plot no 12 sheet R.Y. 9
Railway Quarter
Scale 8"=1'


Abdul Majid Hussainally
for self and others
OWNER

- 1 R.C.C. Slab front & rear verandahs & dining, dressing & bath rooms
to be $4\frac{1}{2}$ " thick $\frac{3}{8}$ " rods 5 c to c shown tinted red. Bed room slab to be $4\frac{1}{2}$ " thick $\frac{3}{8}$ " rods 4 c to c.
- 2 R.C.C. beams over dining rooms to be 16"x8" with 6 rods $\frac{3}{4}$ " dia.
- 3 Existing roof over drawing hall & bed rooms to be retained shown hatched.
- 4 Thin partitions to be of 3" cement blocks with light reinforcement.


Plan showing proposed R.C.C. roof to be the front &
Back portions

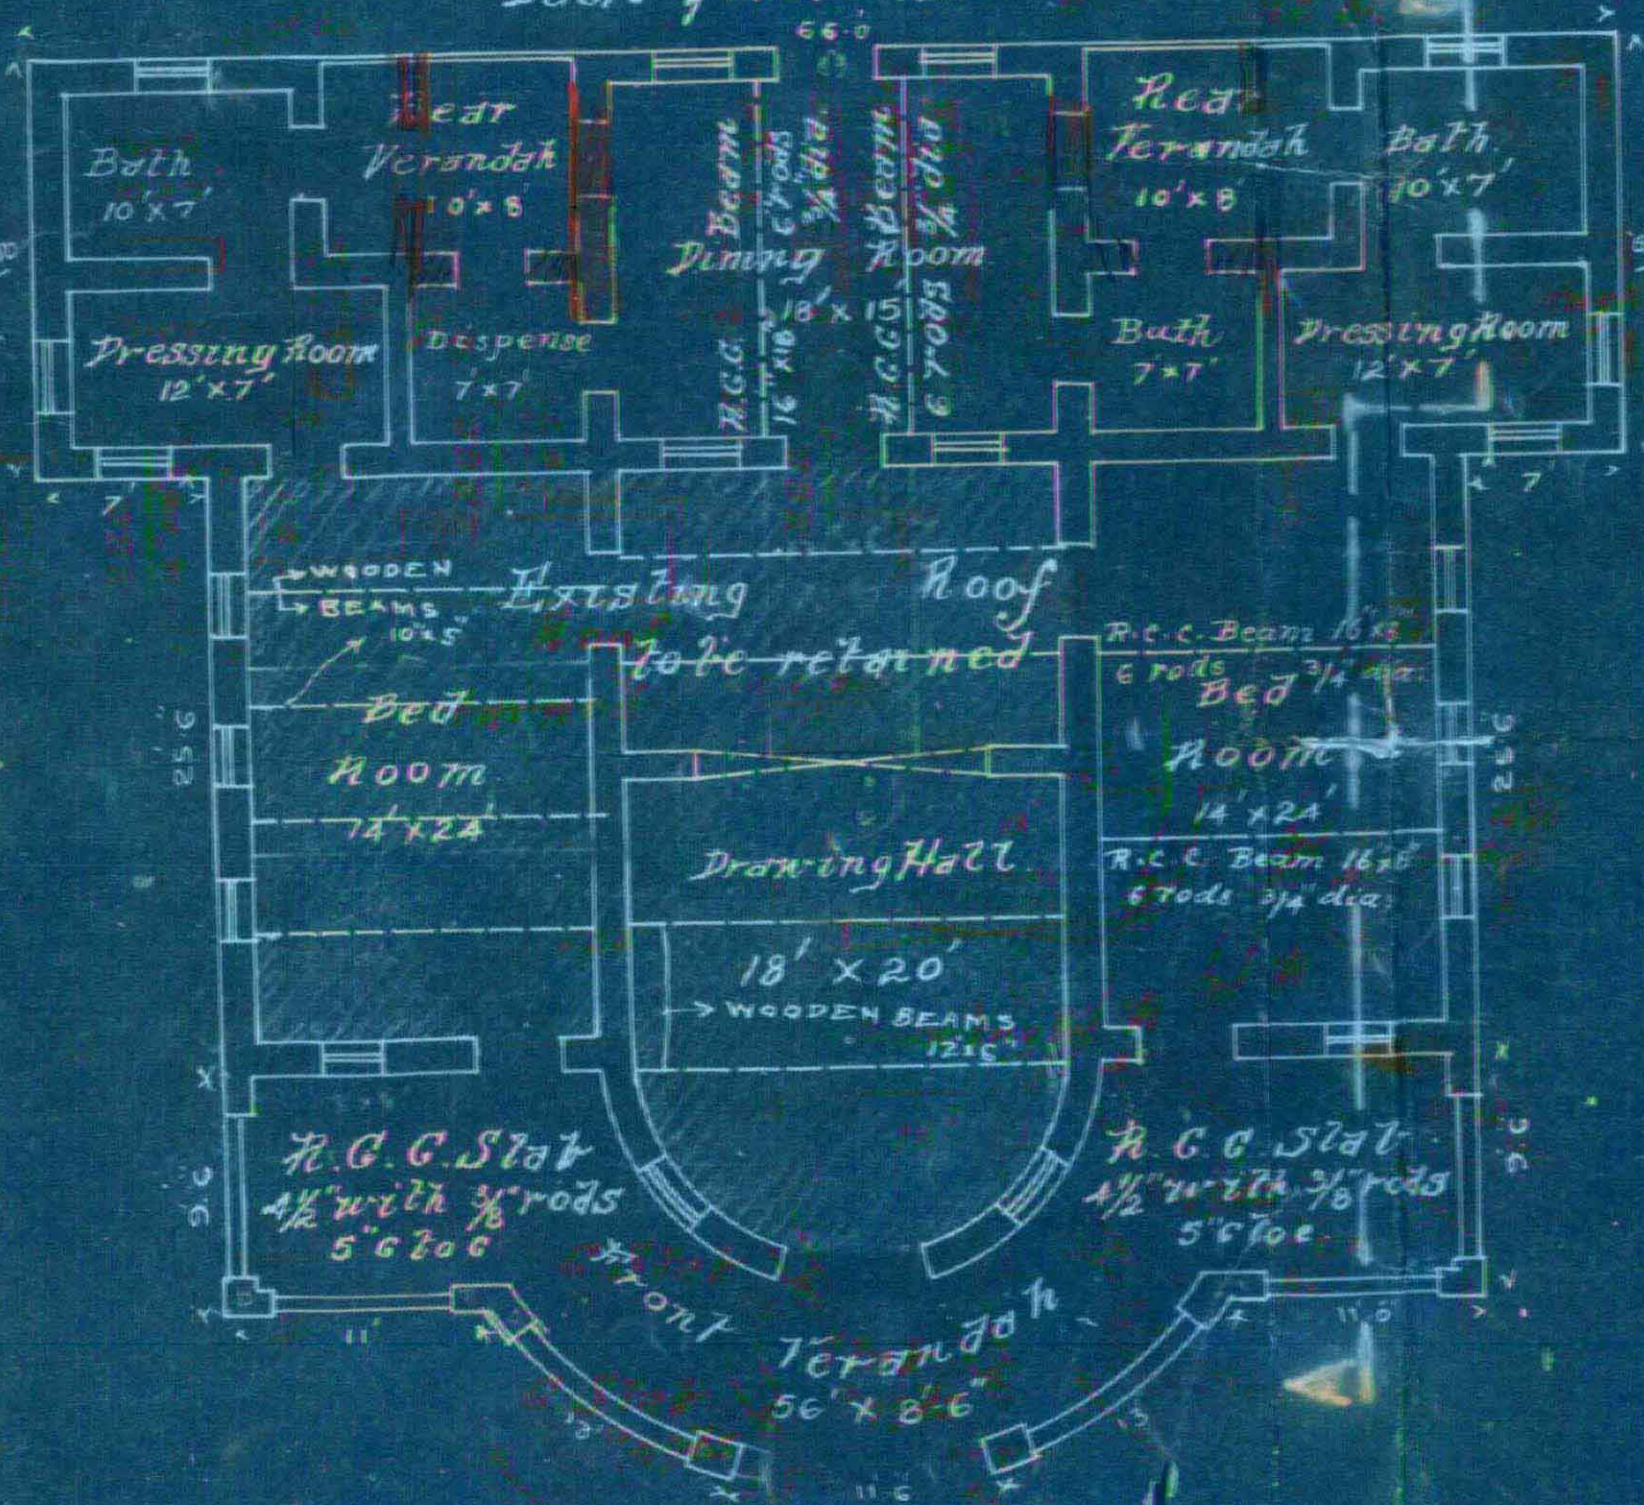


Elevation of bwt houses

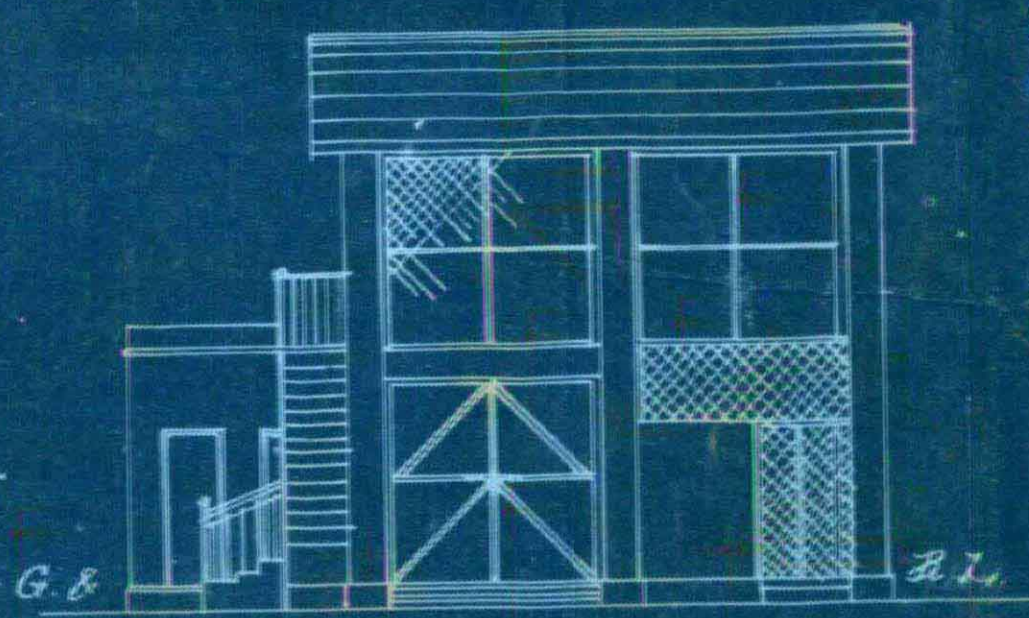

Ground Plan
of bwt houses

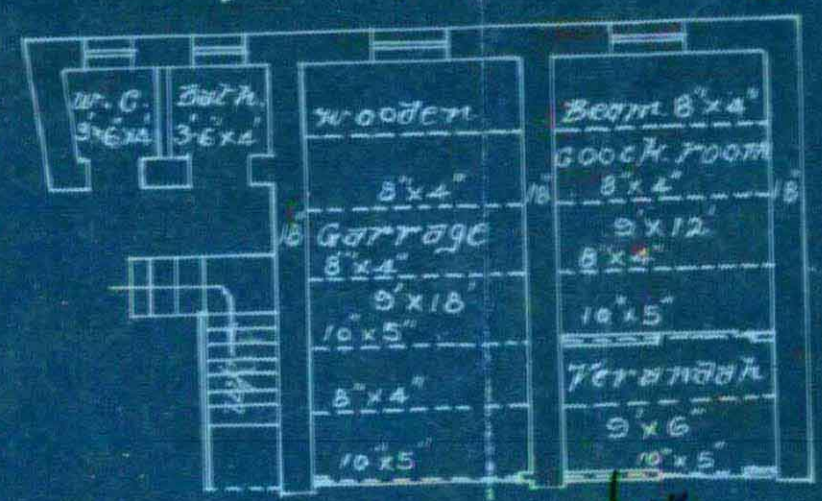

Section on A.B.

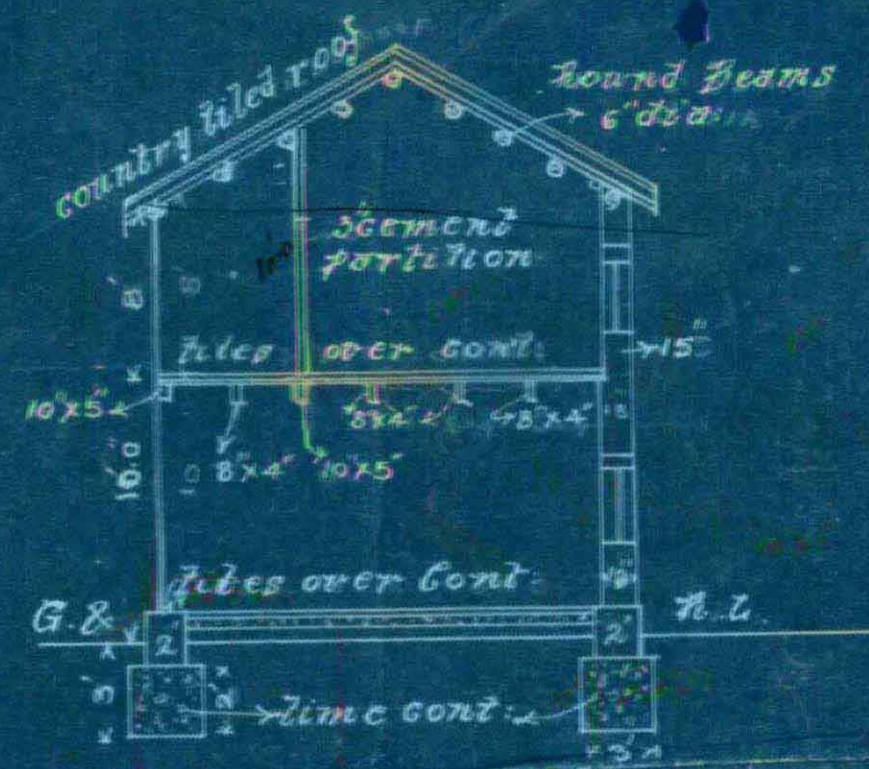

1st Floor Plan
of bwt houses.



M. Khimji & Co.
M. KHIMJI & CO.
ENGINEERS ARCHITECTS & SURVEYORS

Nº 70

APPROVED

Resident Engineer
Central Railway



Heritage

KMR.CDD.MiQ.1928-1929.01

Form No. 6—300—28-6-27

No. L. M. A / 885-2840 of 1929.



MUNICIPAL OFFICE,

Karachi, 15/5 1929

MEMO:

Building Surveyor Section "C" is informed
that Mr. Ahmed Majid Hassanally Jot self & others has been permitted
to limited additions & alterations to
_____ his house
on plot No. 12, By - 9 Street
_____ Railway Quarter, report should be made to the
undersigned when house is completed.

Executive Engineer,
Karachi Municipality.

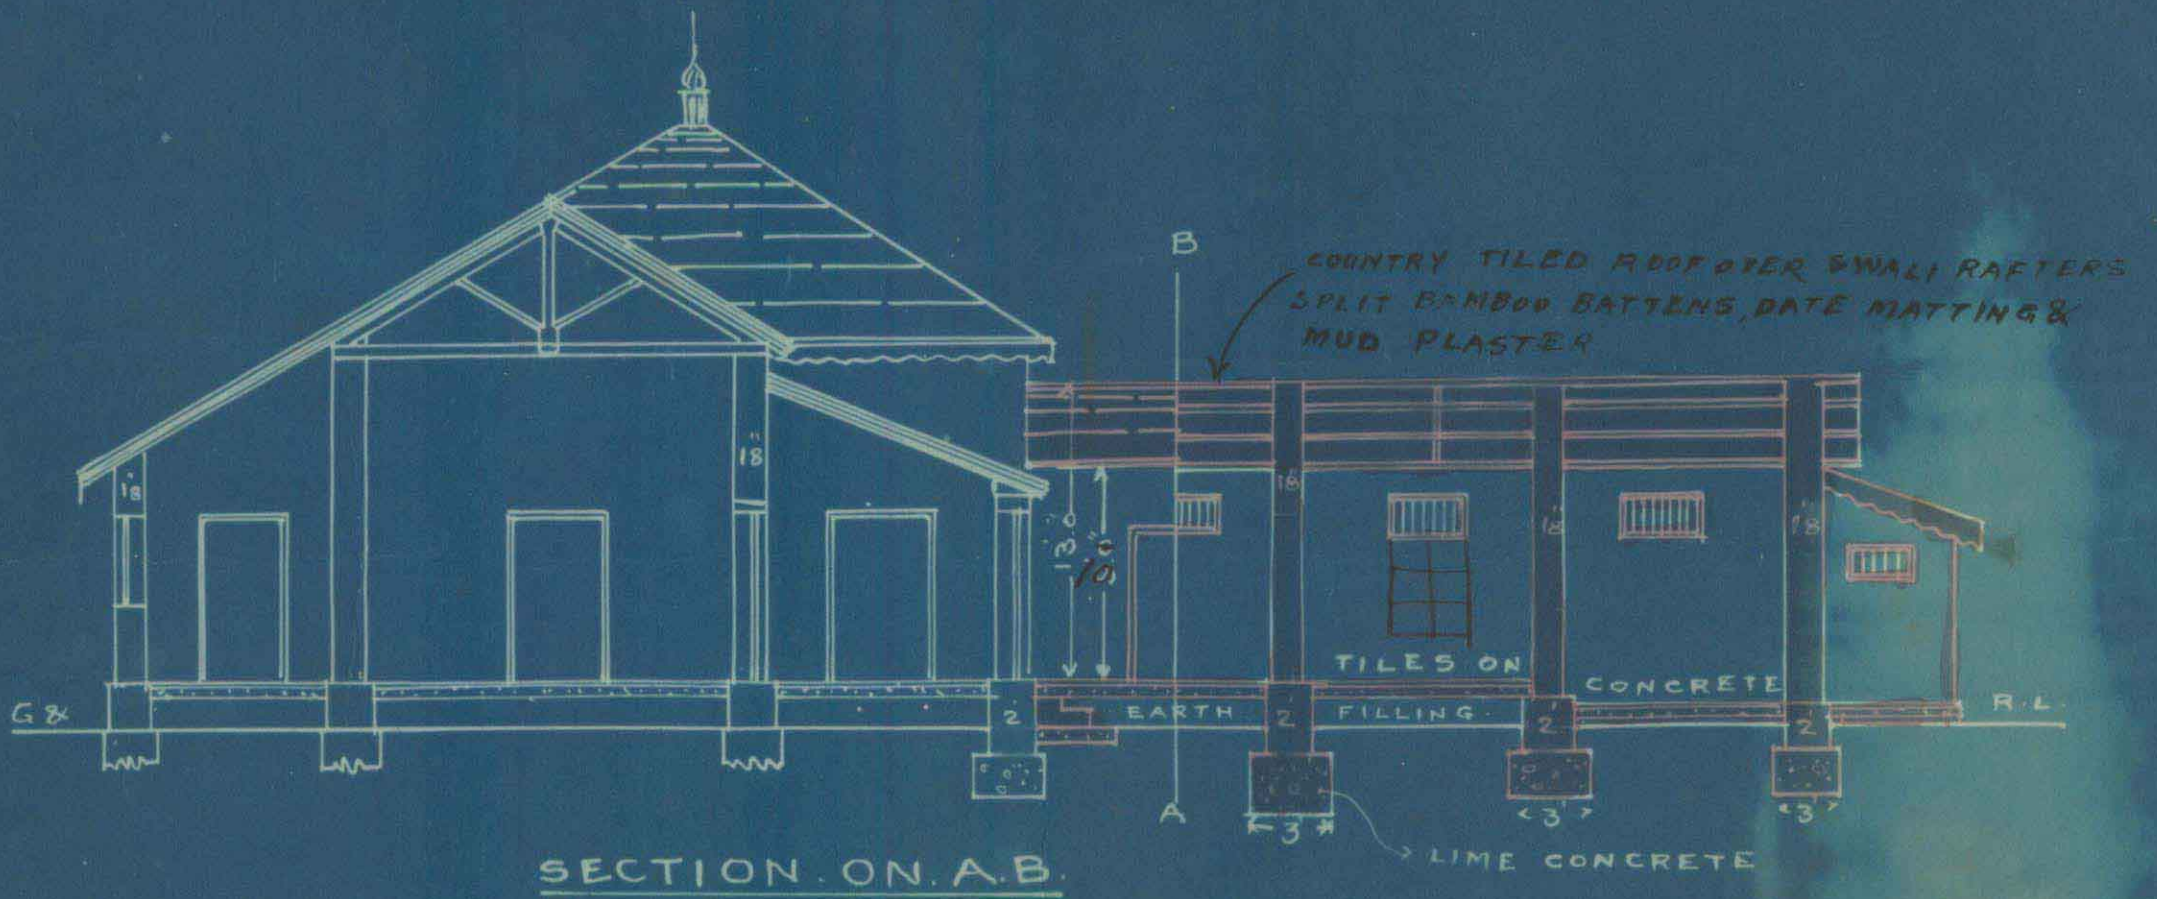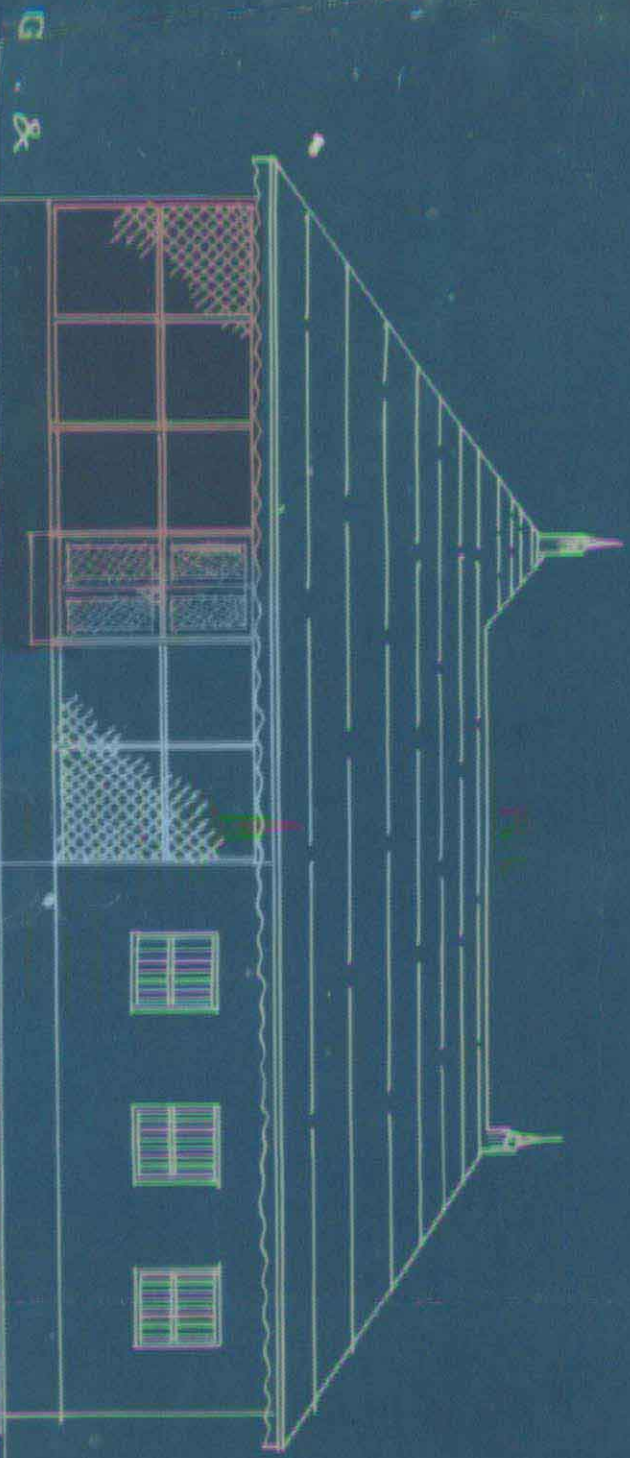

Actual height of the building for the roof work shown.

M. K. H. M. J. & Co.
 ARCHITECTS & SURVEYORS
 WATER COURSE ROAD

PLAN
 SHOWING PROPOSED ADDITIONS & ALTERATIONS
 TO BUILDING ON PLOT NO. 12-13 RAILWAY Q.R.

SCALE 8 FT. = 1 INCH



- 1 PROPOSED WORK SHOWN IN RED
- 2 THIN PARTITIONS TO BE OF 6 BRICK NOGGING
- 3 WOODEN LINTELS OVER DOORS & WINDOWS TO BE 1 INCH PER FOOT SPAN

No. 64

BLOCK PLAN

SCALE 40 FT. = 1 INCH

OPEN PLOT NO. 11

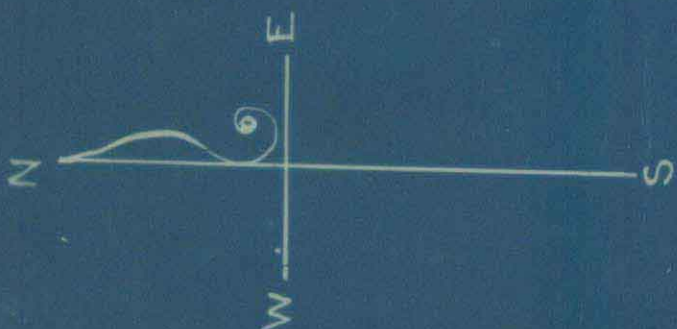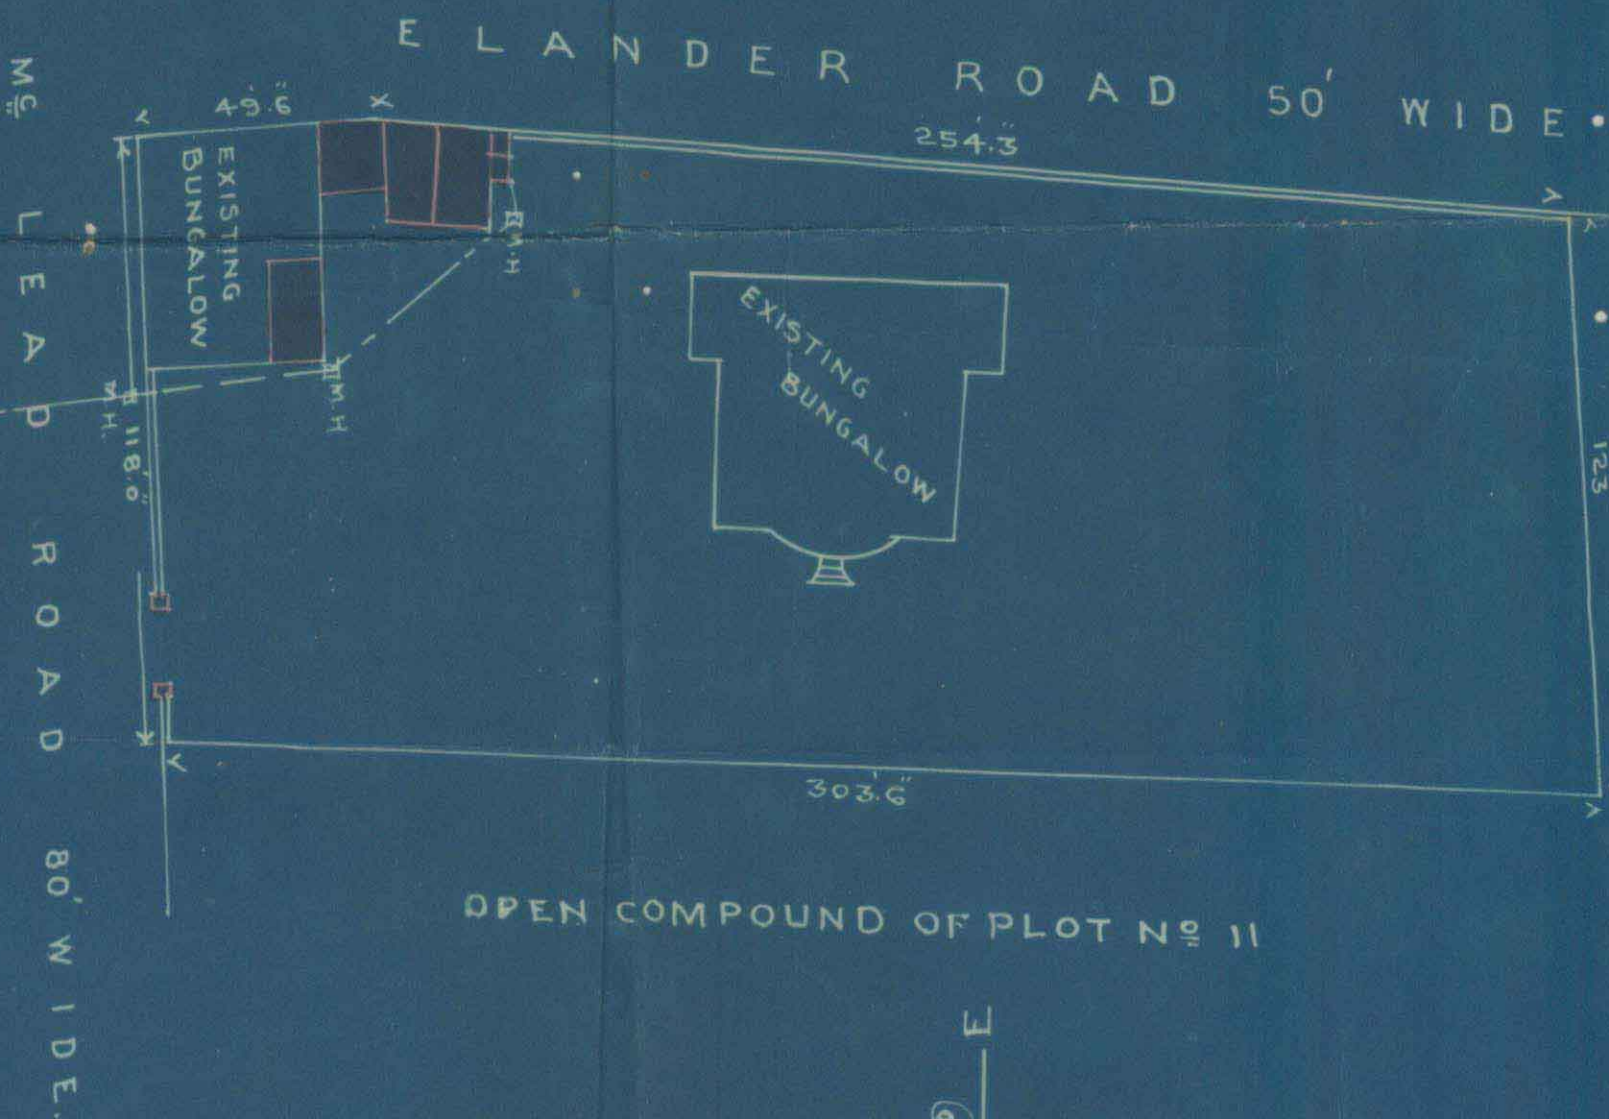



Heritage

KMR.CDD.MiQ.1928-1929.01

65



Heritage

KMR.CDD.MiQ.1928-1929.01
BUILDING COMPLETION REPORT.

LAND MANAGER AND ARCHITECT'S OFFICE,

Karachi. 192 .

To
THE LAND MANAGER AND ARCHITECT,
KARACHI MUNICIPALITY.



SIR,

I beg to report that the building work on plot No. 6 Sheet MAL
Mars. Quarter owned by Mr. Payalji Jethabhai
has been completed according to plans approved by the Municipality. Orders
are requested to file the correspondence.

Yours obediently,

APM.

Building Surveyor "B" Section, ¹⁴¹⁸
Karachi Municipality.

No. L. M. A/BS 4729 of 1929
Karachi, 12.8. 1929.

Copy to the Assessor & Collector for information,

[Signature]
15/8

B. SO. A. M. Ints. C. E.
Land Manager and Architect,
Karachi Municipality.



(2)
Submitter:

1. The measurements of the open space near the bath is wrongly written in the plan and should be got corrected.
2. On the first floor in the verandah the owner in stead of using 7"x4" beams as shown in plan has used beams 4" diameter. This is objectionable. Connection cannot be given.

Forwarded with compliments to. C.L.

c
P. attach approx
plan
d/c
4/8

B. I. C. . A. M. E. C. E.
d/c Land Manager & Architect
7/8. ~~B. I. C. A. M. E. C. E.~~ 7/8



Heritage

FORM B.

KMR.CDD.MiQ.1928-1929.01

[Vide Rule 238/A (3) (a)]

UNDER BY-LAW NO. 47 (1) UNDER
SECTION 48 (N)

Completion Certificate.

TO BE SUBMITTED BY LICENSED SURVEYOR
BUILDING AND DRAINAGE COMPLETION CERTIFICATE.

I do hereby certify that the following building and drainage work (insert full particulars of the work) Building on Sns 6 M R-1
Market Q. Top Floor on Murad Khan
Road. & Ground, 1st & 2nd Kunda Street.
has been supervised by me and has been completed to my satisfaction; that the workmanship and the materials used are good; and that no provision of the Act or the Bye-laws and no requisition made, condition prescribed, or order issued thereunder has been transgressed in the course of the work.

Approved *Alam ul Haq*

14/8

Signed

Deputy Commissioner

Dated *10th August 1929*



MRI
6

Luxiyalal 81-

	8
	6
	7

Muradkhan
pood

Kundlan 81-




Heritage

KMR.CDD.MiQ.1928-1929.01

588




FIRST FLOOR PLAN

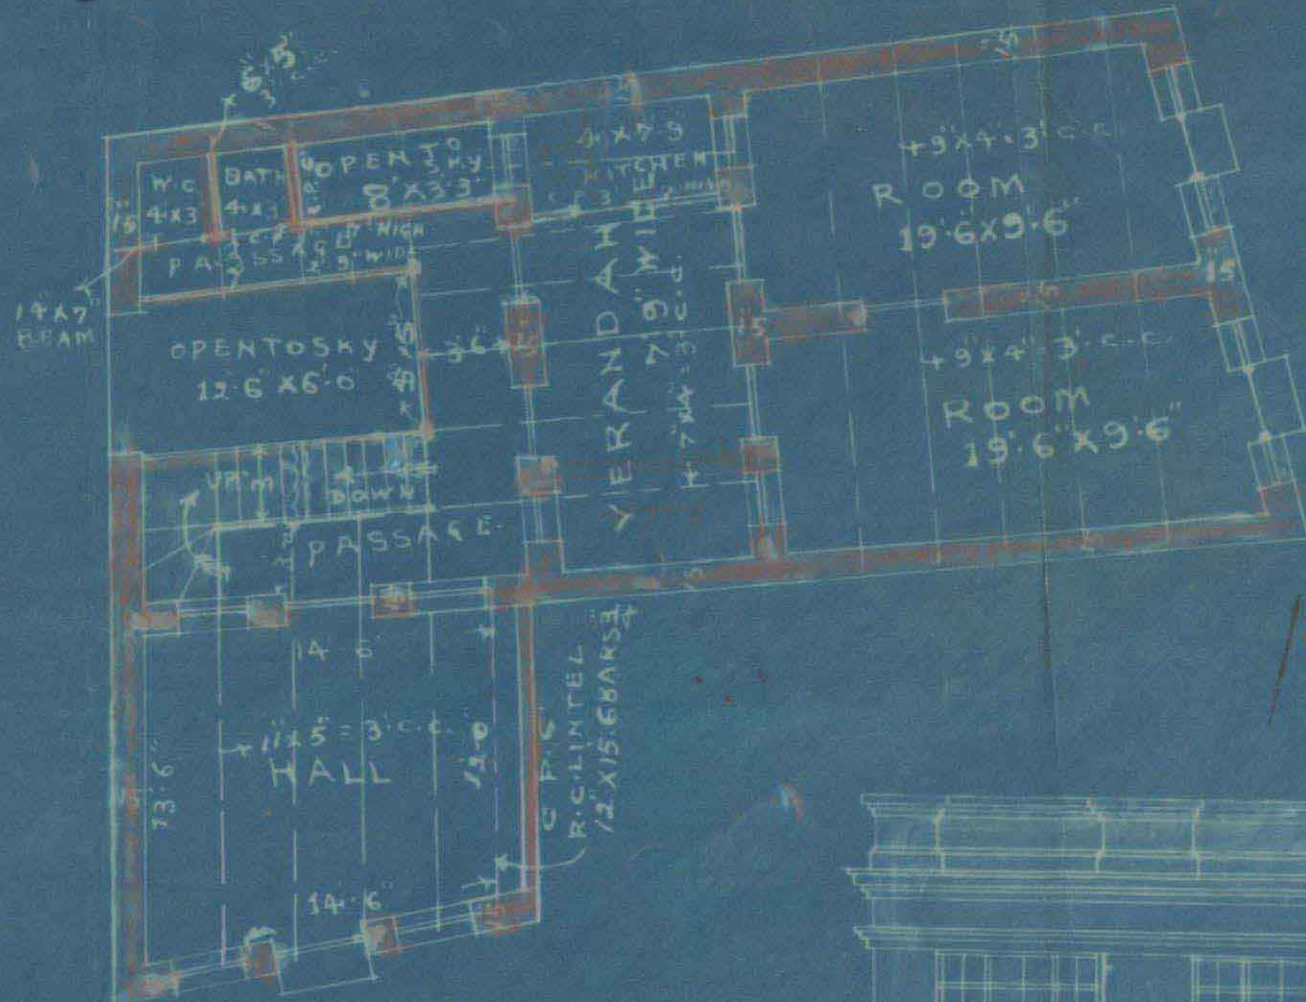

2ND FLOOR PLAN

N^o 43

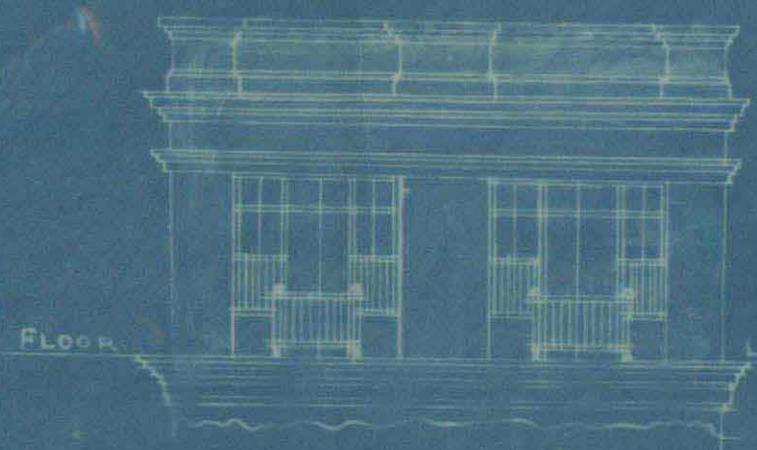

FRONT ELEVATION ON MURADKHAN ROAD



GROUND PLAN

PLAN OF PROPOSED ADDITIONS & ALTERATIONS ON TO THE BUILDING ON PLOT NO 6, MR. N. S. MARKET QUARTER SCALE 8"=1" INCH

APPROVED


C.6
5.B.

City of Jodhpur


meeta
Architect
Karanhi, Jodhpur

BLOCK PLAN


SCALE 40' = 1" INCH

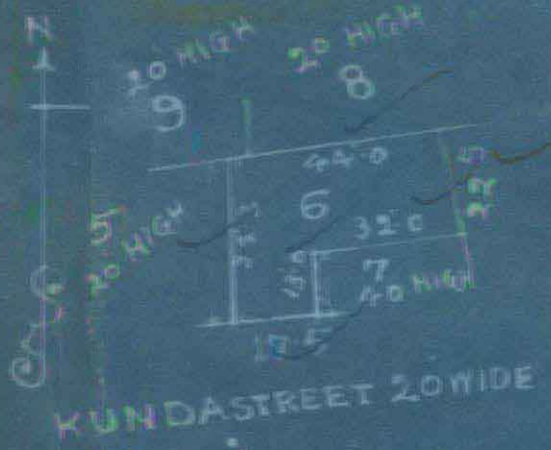


MURADKHAN ROAD 45' WIDE

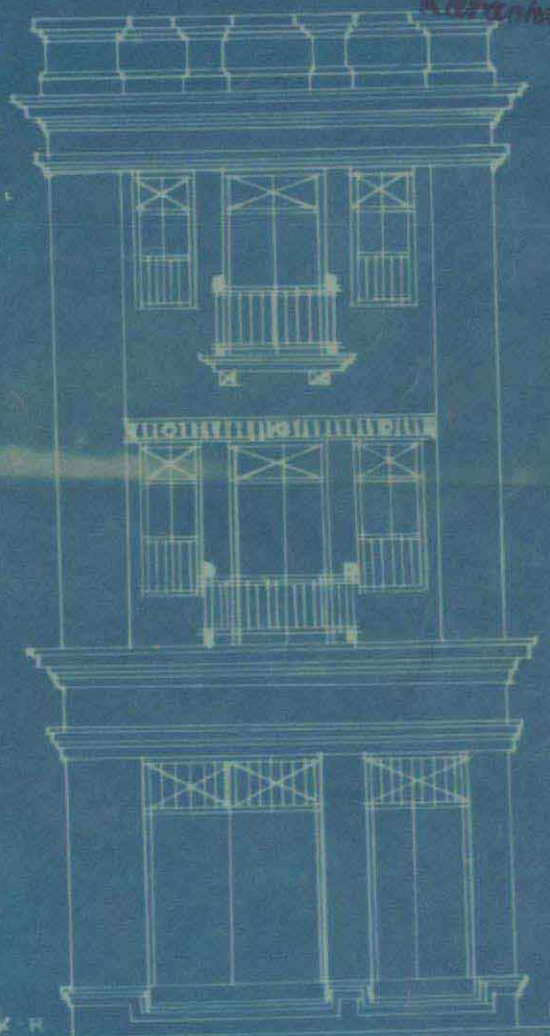

FRONT ELEVATION ON KUNDA STREET

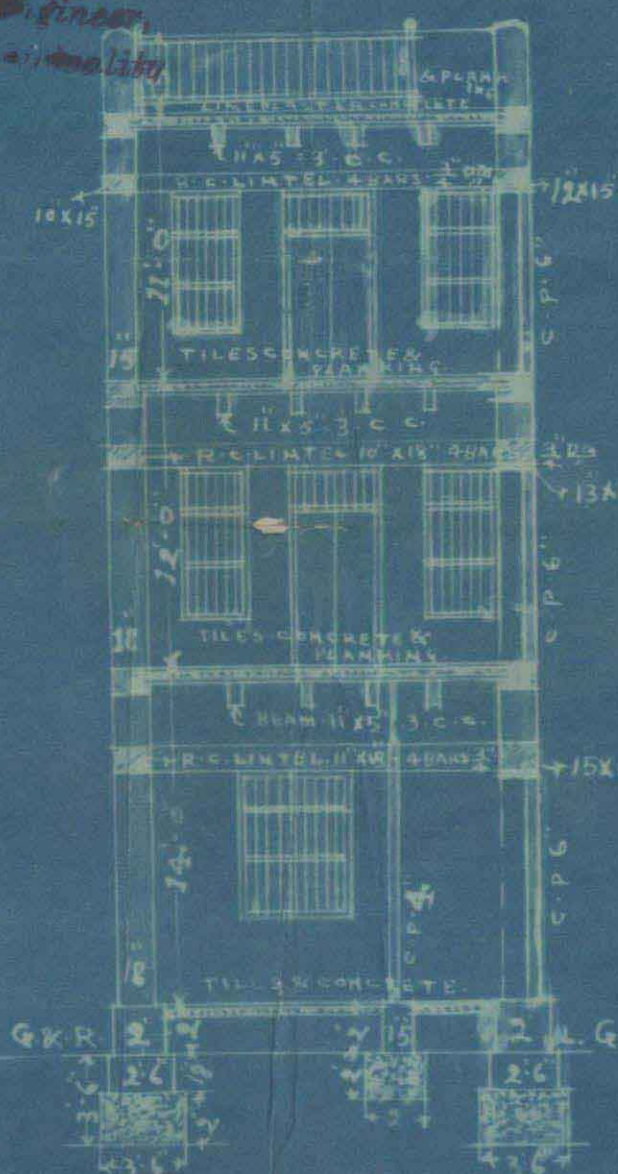

SECTION ON A.B.

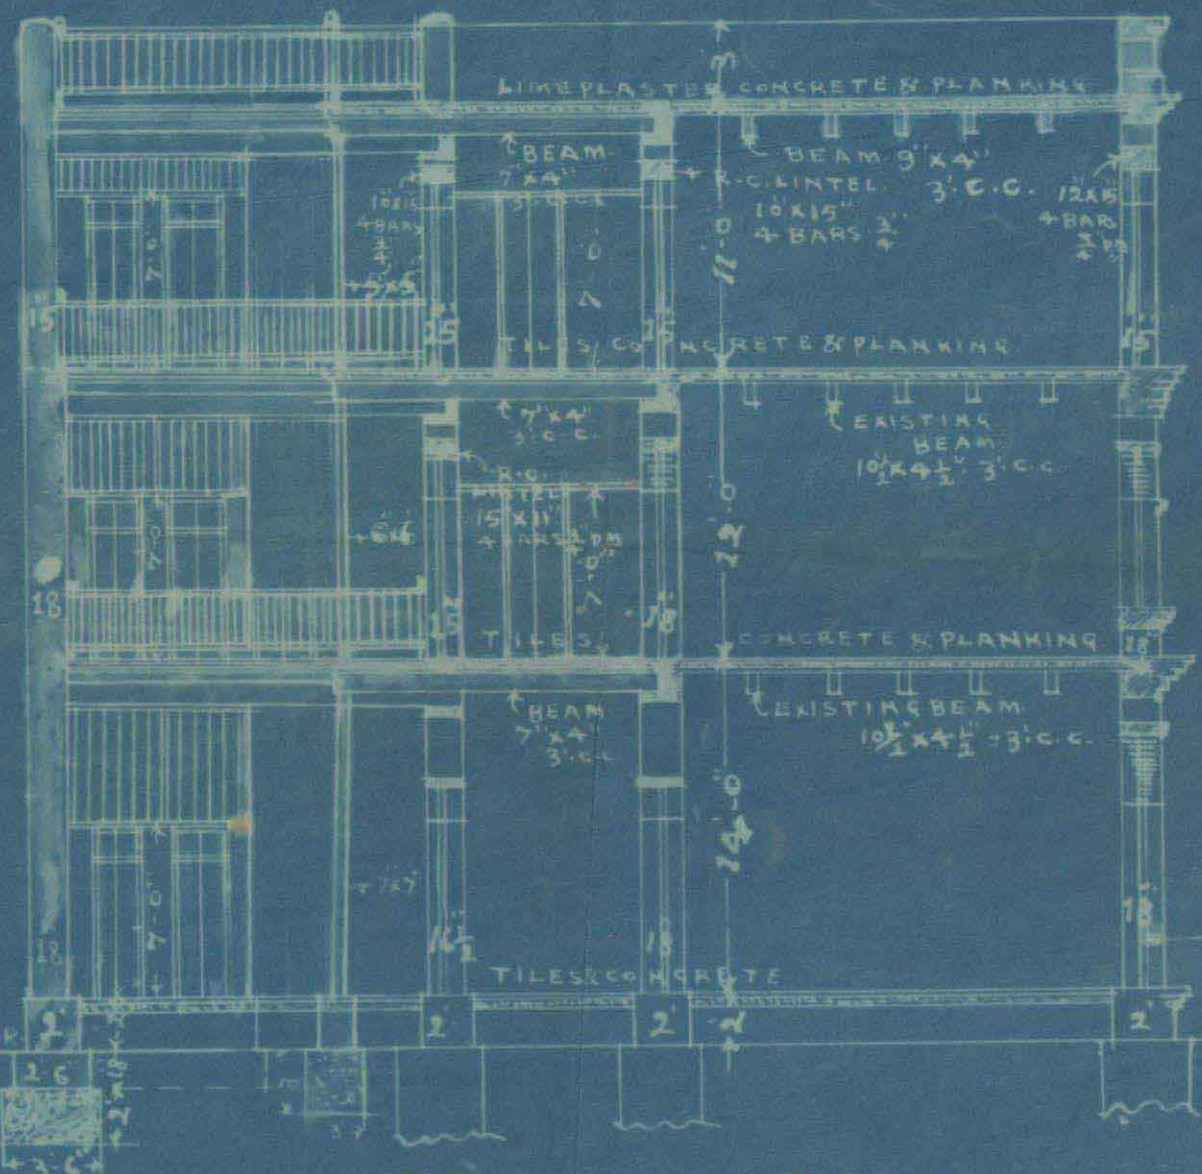

SECTION ON C.D.



Heritage

KMR.CDD.MiQ.1928-1929.01

91

No. L. M. A. B. 52166 of 1927.

MUNICIPAL OFFICE,

Karachi, 19 — 4 — 1927.

MEMO :

Building Surveyor Section Ch is informed
that Mr. Dyalji Jemalji has been permitted
to make additions & alterations
his house
on plot No 6, Ind - 1 Street
Market Quarter, report should be made to the
undersigned when house is completed

L. S.otra

G. B. V Executive Engineer,
16/4/27 Karachi Municipality.