

PLAN SHOWING PROPOSED ADDNS & ALTRNS

TO HOUSE ON PLOT NO 110-A-9


OLD TOWN QR

SCALE 8" = 1'


NOTE:-

NEW WORK IS SHOWN IN RED


BLOCK PLAN
SCALE 20" = 1'

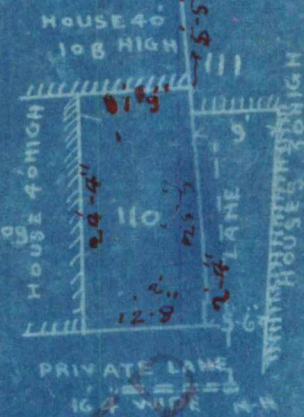

EAST ELEVATION

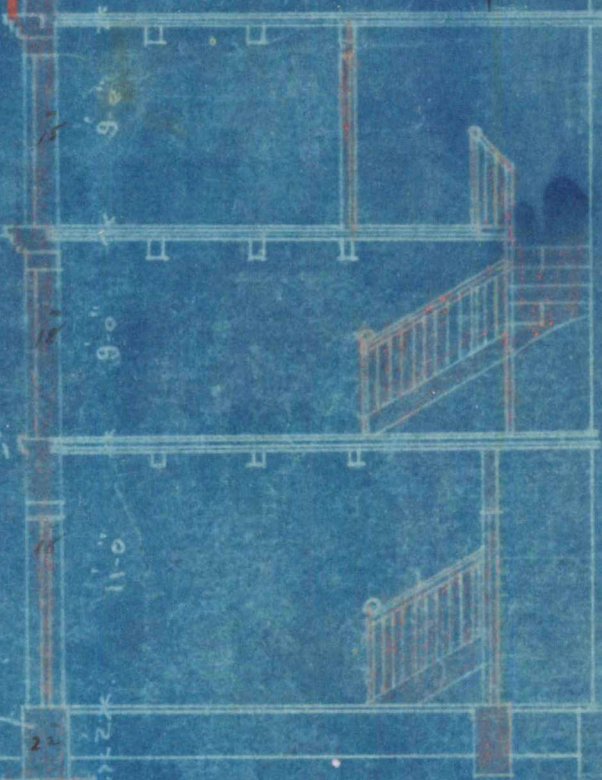


SECTION ON A-B

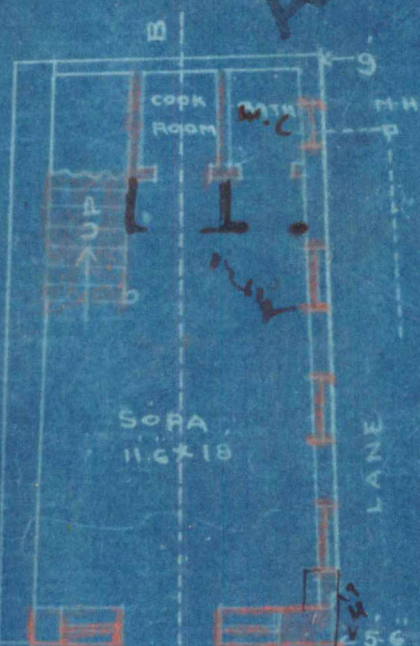


PRIVATE LANE 16'4" WIDE

PLAN OF GROUND FLOOR

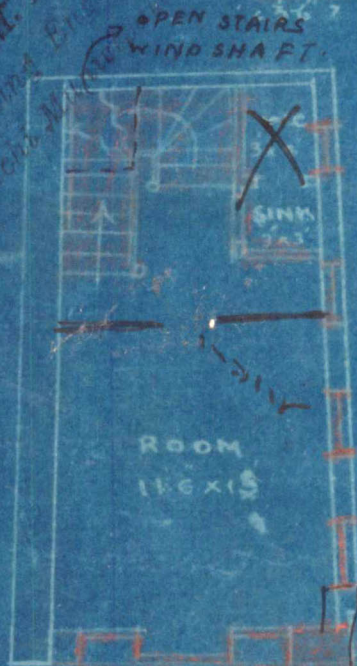

PLAN OF 1ST FLOOR

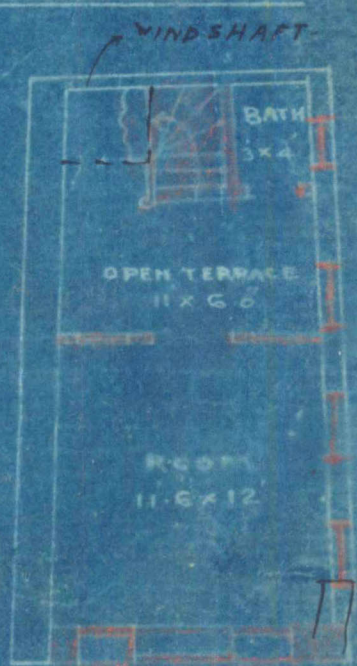

PLAN OF 2ND FLOOR

APPROVED
J. T. B.
J. T. B.
J. T. B.



Heritage

KMR.CDD.OIQ.1923-1924.02

Form No. 37/A-200-25-1.1922.

BUILDING COMPLETION REPORT.

MUNICIPAL ENGINEER'S OFFICE,

Karachi, 10.10. 1924.

To

THE ENGINEER,

KARACHI MUNICIPALITY.

SIR,

I beg to report, the building work on plot No. 110 Sheet A-2
old Mun Quarter owned by Mai Punjehai w/o Isardu is
completed according to the plan approved by the Municipality. Orders
are requested to file the correspondence.

Yours obediently,

A. H. AghaBuilding Surveyor "B" Section,
Karachi Municipality.No. L. S. 5749 of 1924Copy to the Assessor and Collector for
information.Mun 14/2/24
M.C., A.M. INST. C.E.,Engineer,
Karachi Municipality.15/10/24A.C.
file
15/10



Heritage

KMR.CDD.OIQ.1923-1924.02

Form No. 6-400-23-8-22.

No. L. S. 2966 OF 192 3.

MUNICIPAL OFFICE:

Karachi 15-6 1923.18/6

MEMO:

Building Surveyor Section B is informed
that Mr. Punjabi W/o Issa Das has been permitted
to make add & alt. in
his house
on plot No. 110-29 Street,
old Dur Quarter, report should be made to the
undersigned when the house is completed.

Engineer,
Karachi Municipality.