



Form No. 37/A—200—25-1-1922.

BUILDING COMPLETION REPORT.

MUNICIPAL ENGINEER'S OFFICE,

Karachi, 14.5.1924.
15

To

THE ENGINEER,

KARACHI MUNICIPALITY.

SIR,

I beg to report, the building work on plot No. 150 Sheet D. 3
600 Quarter owned by Mr. Wari Asghar Ali Aslam is
completed according to the plan approved by the Municipality. Orders
are requested to file the correspondence.

Yours obediently,

Building Surveyor "D" Section,
Karachi Municipality.No. L. S. 2766 of 1924Copy to the Assessor and Collector for
information.

15/5/24
M.C., A.M. INST. C.E.,
Engineer,
Karachi Municipality.

2

This Plr no 150 A3 was inspected by me
& has made no deviation in encroaching
on any br's rights.

May

5/24.

B.S.

P.J.

May

5/5/24.

150- A.3 dog

Wani bai

~~Demmer~~ Kallan

Thakondom

~~His~~ ~~Thakondom~~ &
submit his report
in the matter.
JRM 2/15/24.

Mr. apka please attach appl.
received in connection with
this obj. for the adjoining owner.

li I have already JRM 26/4/24
given to L.M.
apka L.M. H.
28/4 JRM 24/4



No. L. S. *4535* OF 192 .

MUNICIPAL OFFICE :

Karachi *15-12-* 1923 .
18


MEMO :

Building Surveyor Section *B* is informed
that *Mrs Bai Hajibai w/o Asaunae* has been permitted
to *build a* _____
_____ his house
on plot No. *150 A-3* _____ Street,
Old Town Quarter, report should be made to the
undersigned when the house is completed.

Lamner. Bunt
and Engineer,
Karachi Municipality.
17/12/23


PLAN SHOWING PROPOSED BUILDING TO BE BUILT
ON PLOT SHEET A-3, OLD TOWN QUARTER
SCALE 6"=1'

APPROVED
L. M. M. 17/1/23

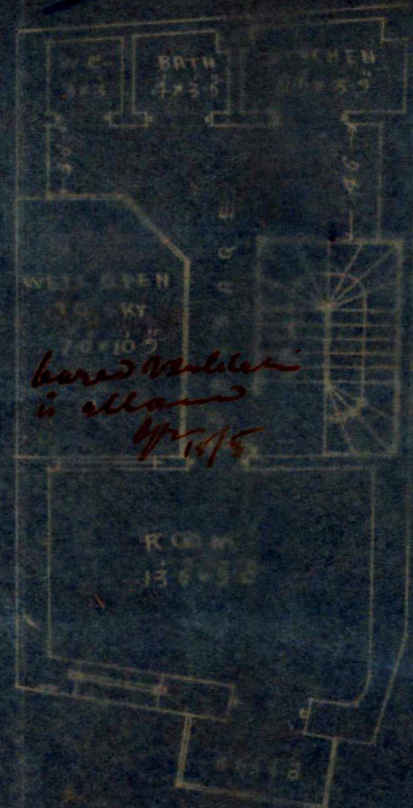


1st & 2nd FLOOR PLAN

GROUND PLAN

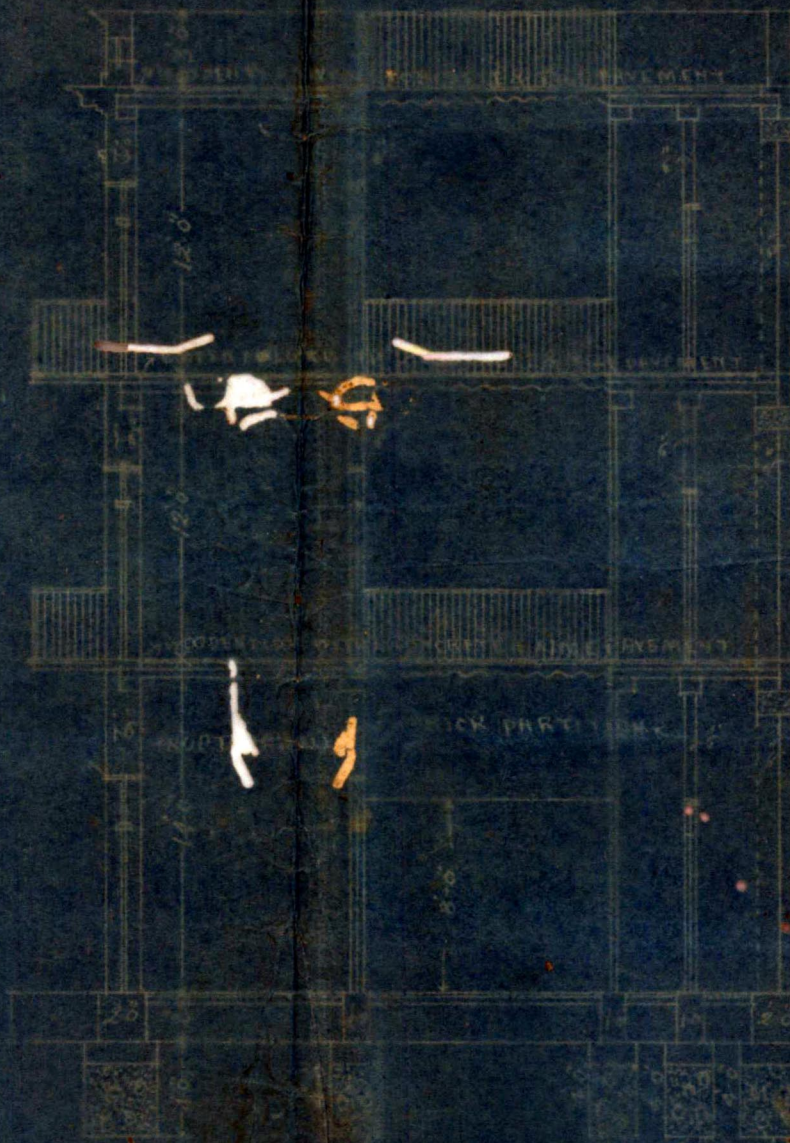

SECTION A-A

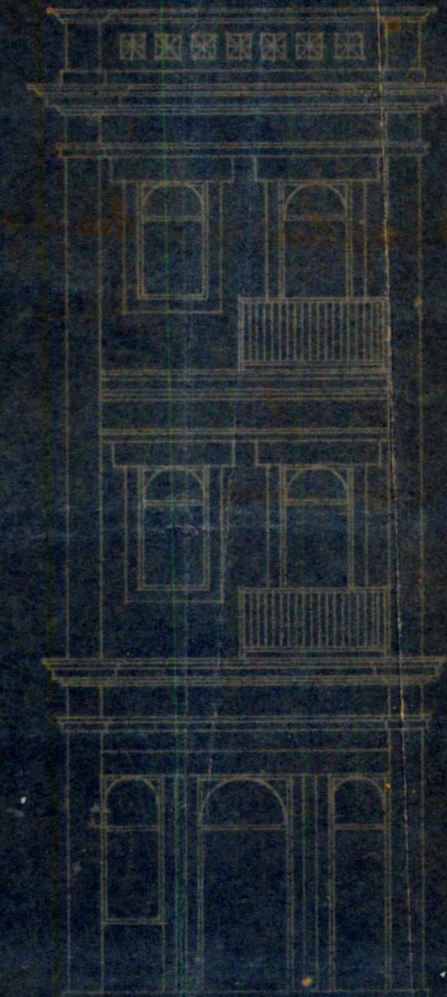

FRONT ELEVATION

SITE PLAN



Mirza Aslam Khan

OWNER

FATMA KHAN
ARCHITECT & SURVEYOR
UNDER ROAD KARACHI