

BUILDING COMPLETION REPORT.

MUNICIPAL OFFICE,

Karachi 30th June 1921

10.11

To,

THE ENGINEER,

KARACHI MUNICIPALITY.

SIR,

*RG 4100
1-9-21*

I beg to report that the building work on plot No. 86
sheet B6 Ram bough Quarter owned by
Mr. Valji Garindgi is completed
according to the plan approved by this office.

Copy to the H/c for information

P.B. Shindasan

M. C. A., M. I. C. E.,

Engineer,

Karachi Municipality

Yours obediently,

Shawani
Building Surveyor, "A" Section,
Karachi Municipality.



Heritage

KMR.CDD.RbQ.1920-1921.05

Form

No. L. S. 4843 of 1920.

MUNICIPAL OFFICE,

Karachi, 19/8 1920.

MEMO:

Inspector Building Surveyor "A" Quarter, is informed
that Mr. Valji Gaurindji has been permitted
to build
his house
on plot No. 66 B6 Harmasp Street
Ramlaugh Quarter. Report should be made to the
undersigned when the house is completed.


A.M. INST., 4. E.

ag Engineer,
Karachi Municipality.

Through the Health Officer, Karachi Municipality.

Note.—The plot is held as a temporary occupation lease and the owner agrees to remove the building at any
time on receiving a notice to do so.

GROUND PLAN

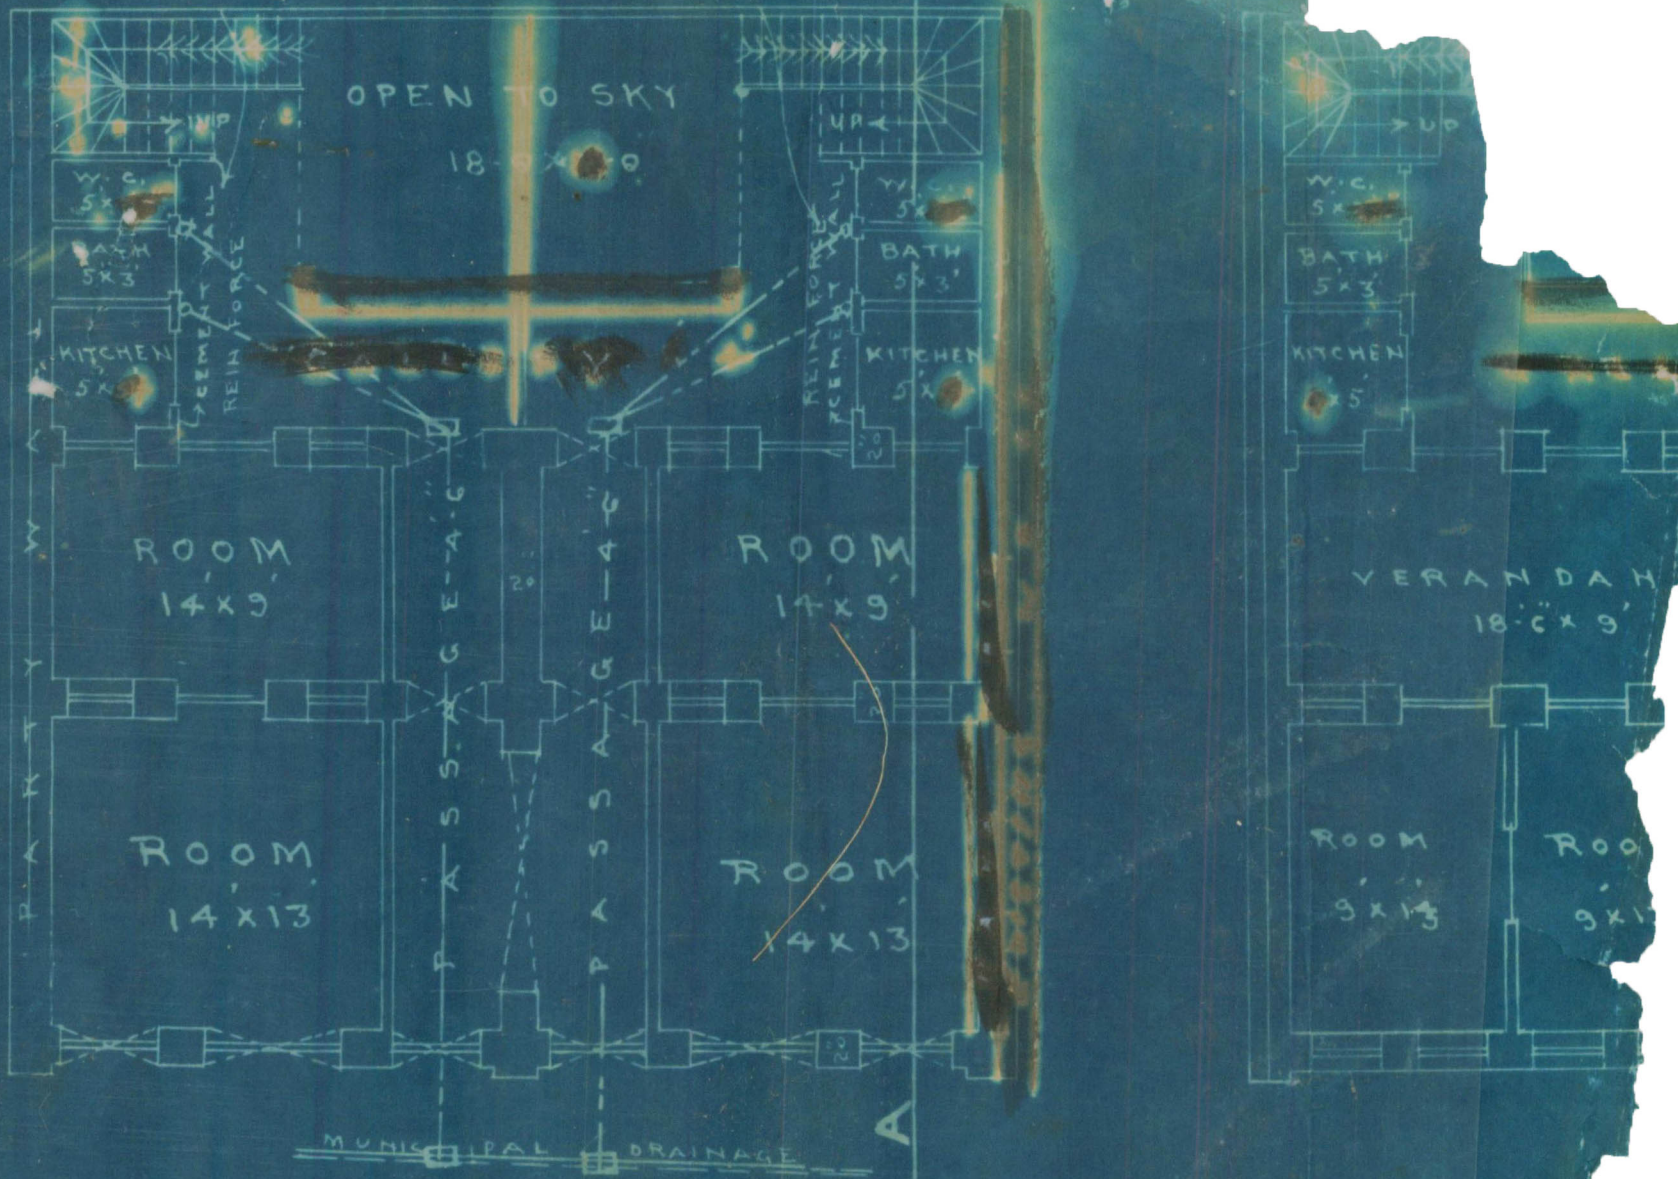

ELEVATION

