
 


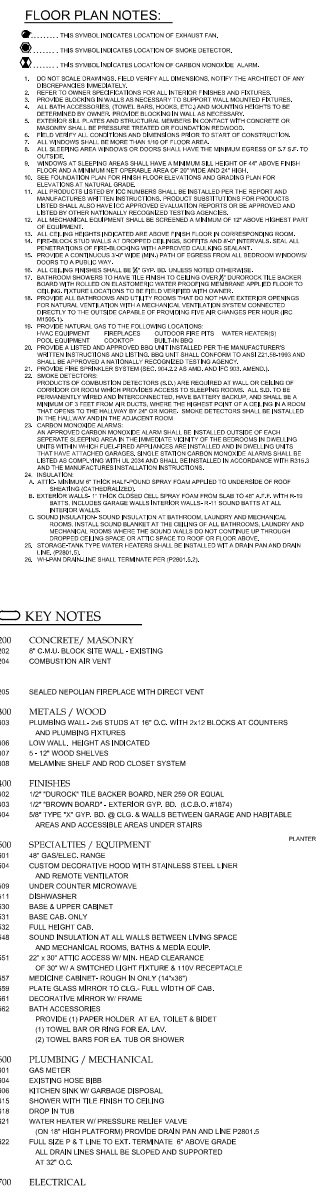

SQUARE FOOTAGE CALCS.	
LIVABLE - UPPER:	4,634 S.F.
-LOWER:	1,406 S.F.
TOTAL LIVABLE	6,040 S.F.
NON-LIVABLE:	
GARAGE:	1,373 S.F.
RAMADA:	168 S.F.
PATIO:	560 S.F.
TOTAL	2,139 S.F.
TOTAL UNDER ROOF	8,234 S.F.



19. PROVIDE NATURAL GAS TO THE FOLLOWING LOCATIONS:
- | | | | |
|----------------|------------|-------------------|-----------------|
| HVAC EQUIPMENT | FIREPLACES | OUTDOOR FIRE PITS | WATER HEATER(S) |
|----------------|------------|-------------------|-----------------|

NOTES:

NOTES:	LEGEND:
--------	---------

- | | |
|--|--|
| | |
| | |

5

...the ...

1

9

1	2	3	466
---	---	---	---	---	---	---	---	---	----	----	-----	-----	



5




100-100-

CHECKED BY: TEAM


$$1/4^s = 1 - 0^s$$

1000

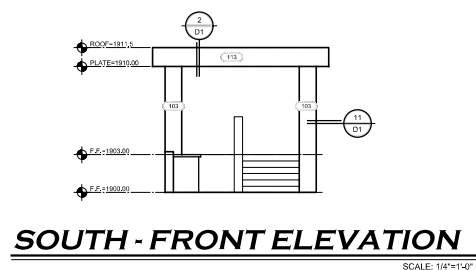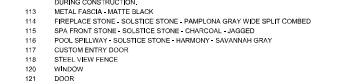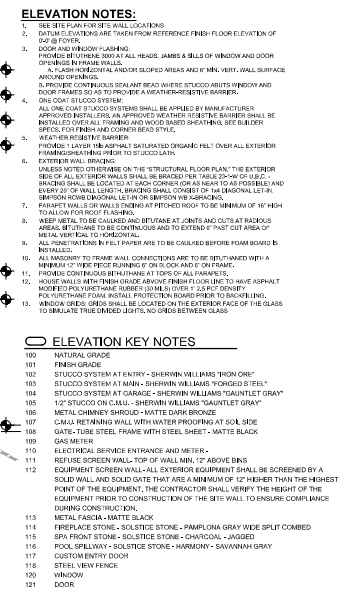

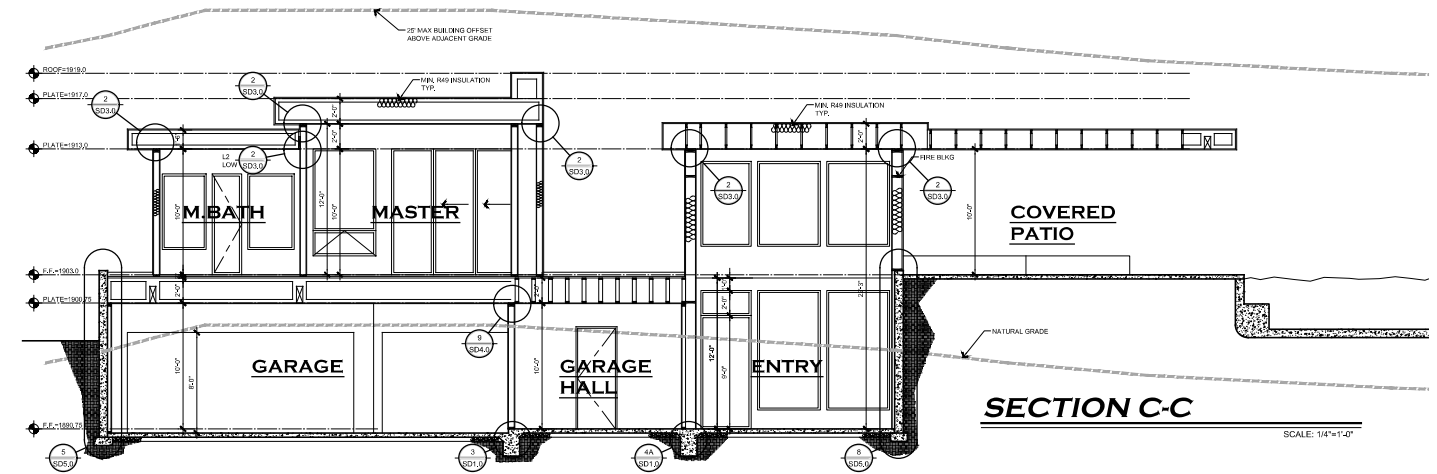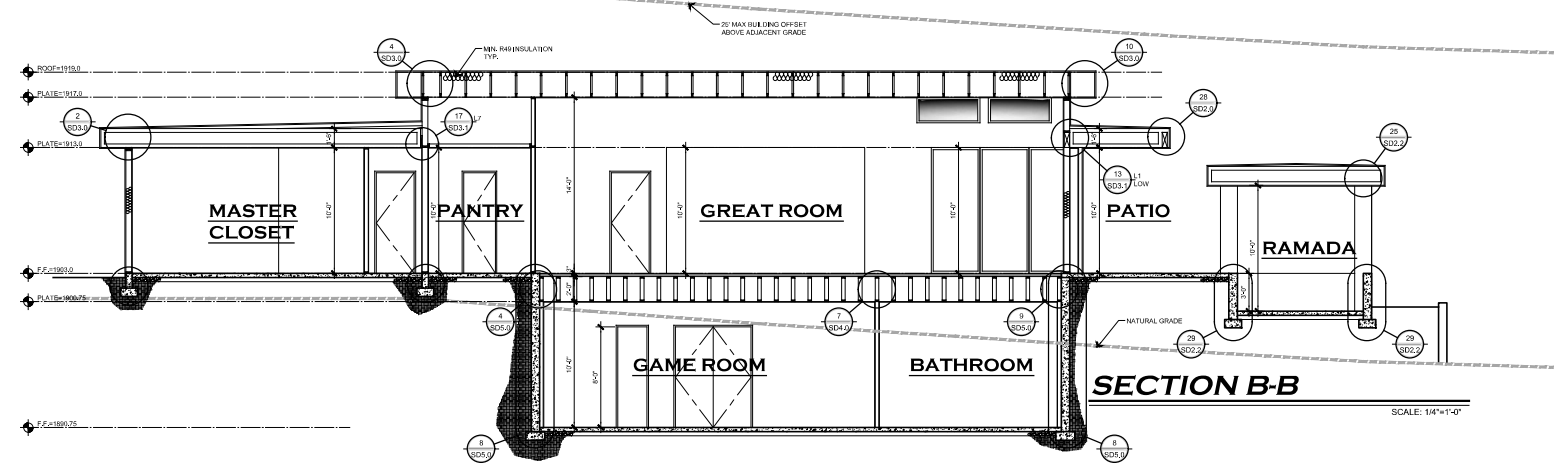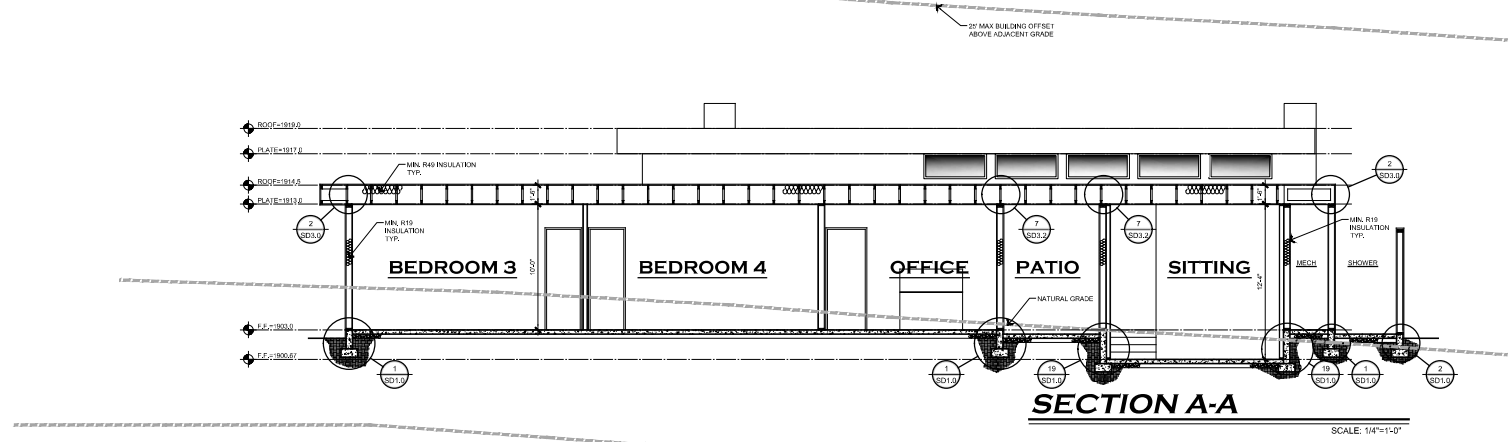

REVISIONS 1. COS 2/29/24	
The Designer hereby represents and warrants to the Client that the information contained herein is true and correct to the best of the Designer's knowledge and belief. The Designer shall not be responsible for any errors or omissions in this document or for any consequences arising therefrom. The Client shall be responsible for obtaining all necessary permits and approvals from the appropriate authorities. The Designer shall not be responsible for any construction or other costs not specifically shown on the drawings.	
THE DRAFTERY RESIDENTIAL DESIGN 100 N. HAWKINS AVE. SUITE 100, SCOTTSDALE, AZ 85259 P: 480.440.8888 E: info@thedraftery.com	
KUBITZ RESIDENCE LOT 11 OF HIDDEN HILLS 14382 EAST COYOTE ROAD SCOTTSDALE, ARIZONA 85259	
SHEET TITLE: BUILDING SECTIONS	
PRINT DATE:	3-09-2024
JOB NO.:	217-67-111
DRAWN BY:	PT
CHECKED BY:	TEAM
SCALE:	1/4"=1'-0"
SHEET NUMBER:	
A5.0 COS PLAN CHECK 8/14/2024	

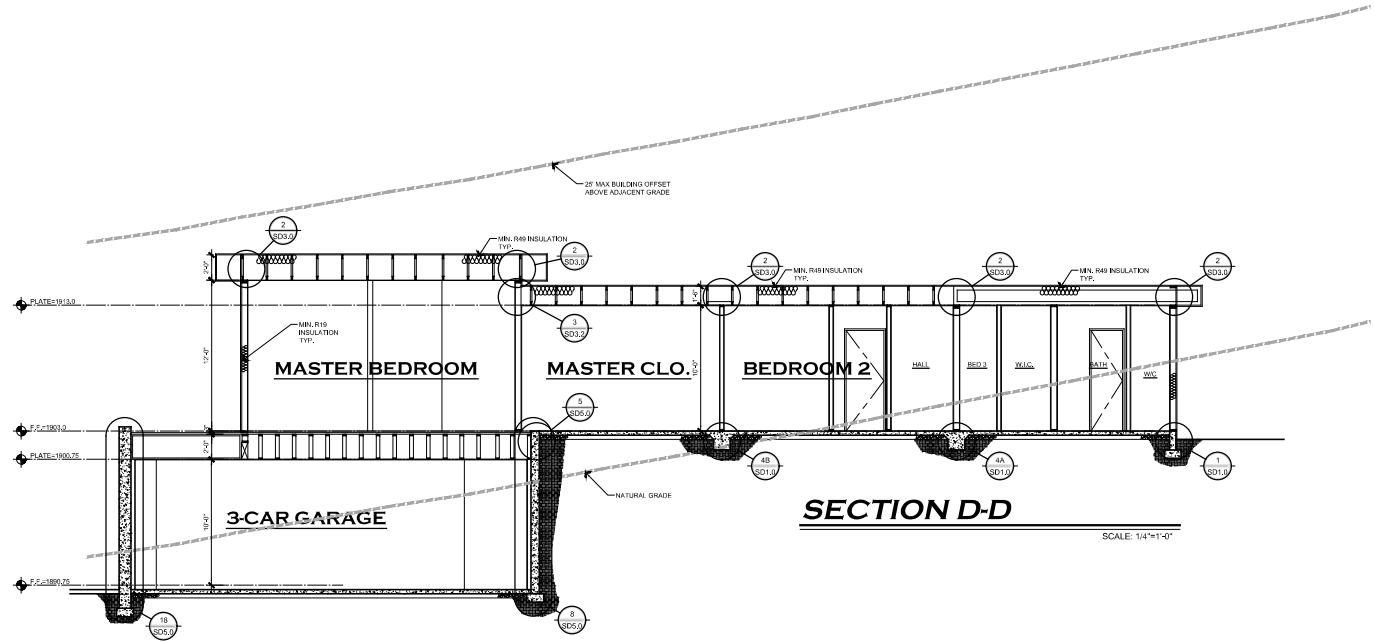

REVISIONS

NO.	DATE	DESCRIPTION
1	05/22/24	ISSUED FOR PERMITS
2		
3		
4		
5		
6		
7		
8		
9		
10		

This drawing and any other documents prepared by or for the Designer are the property of the Designer. They are to be used only for the project and site described herein. No part of this drawing may be reproduced or transmitted in any form or by any means electronic or mechanical, including photocopying, recording, or by any information storage and retrieval system, without the prior written permission of the Designer.

THE DRAFTERY
RESIDENTIAL DESIGN

100 N. HANCOCK, SUITE 100, CHANDLER, AZ 85226
P: 480.948.8888 E: info@thedraftery.com


KUBITZ RESIDENCE
LOT 11 OF HIDDEN HILLS
14382 EAST COYOTE ROAD
SCOTTSDALE, ARIZONA 85259

SHEET TITLE BUILDING SECTIONS

PRINT DATE:	3-29-2024
JOB NO.:	217-67-111
DRAWN BY:	PT
CHECKED BY:	TEAM
SCALE:	1/4"=1'-0"
SHEET NUMBER:	

A5.1

COS PLAN CHECK 8140-24

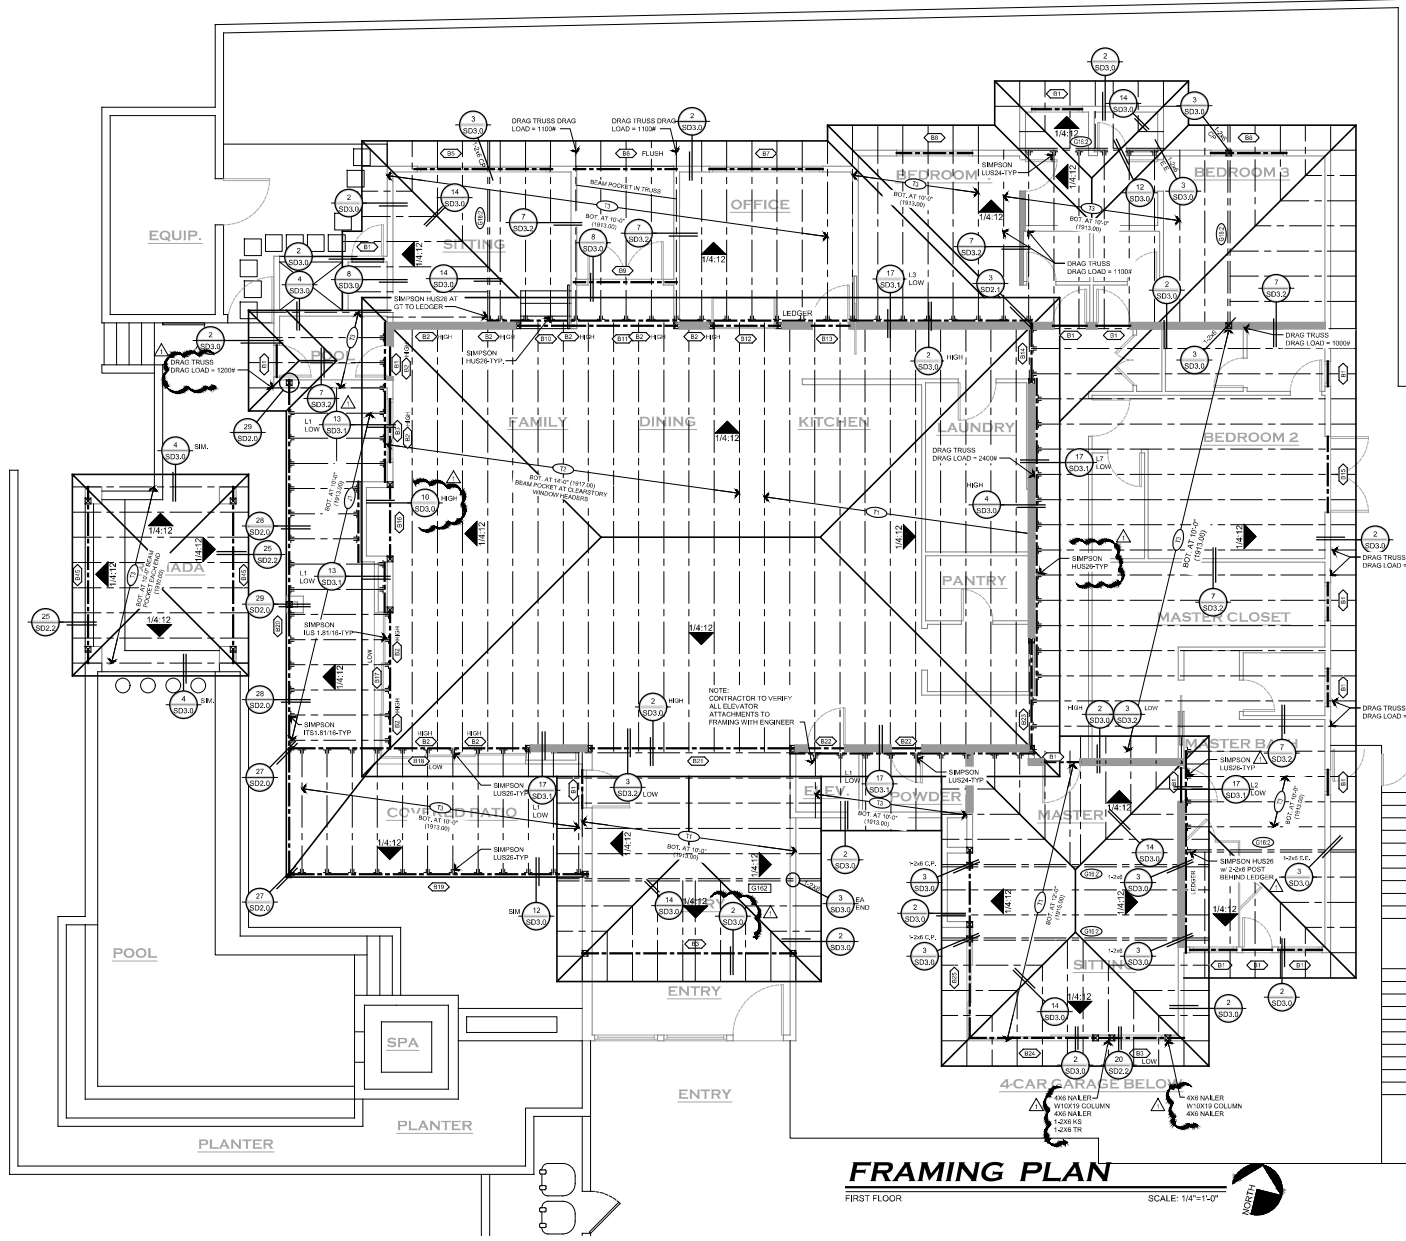

FRAMING PLAN

FIRST FLOOR

SCALE: 1/4"=1'-0"

ROOF PLAN NOTES

1. ROOF FRAMING SHALL BE AS PER PLAN. SEE STRUCTURAL NOTES FOR DESIGN REQUIREMENTS. CORNER EACH JOIST TO TOP PLATE WITH 12" SIMPSON CUP.
2. HEADERS OVER DOOR AND WINDOW OPENINGS SHALL BE (2) 2X8 MINIMUM UNJO.
3. COLLARS SHALL BE (2) 2X8 MINIMUM BEAM BRAM 14" L ON COLLARS.
4. PROVIDE A MINIMUM OF ONE 1" TRIMMER STUD AND ONE KING STUD AT ALL OPENINGS UP TO 4" SPAN, AND A MINIMUM OF 2 TRIMMER STUDS AND ONE KING STUD AT OPENINGS OVER 4" SPAN.
5. TRUSS MANUFACTURE TO VERIFY ALL DECORATIVE BEAM LOCATIONS AND ENGINEER TRUSSES FOR ADDITIONAL LOAD. ENDS OF ALL DECORATIVE BEAMS STRAPPED TO TRUSSES.
6. SHEATH NAME PLATE OF PARAPETS.
7. VERIFY ALL RAISED HEEL TRUSS CONDITIONS WITH ELEVATIONS.

FIRE BLOCKING NOTES:

- FIRE BLOCKING IS REQUIRED IN THE FOLLOWING LOCATIONS:
1. CONCEALED SPACES OF STUD WALLS AT CEILING AND FLOOR LEVELS.
 2. FINISHED SPACES AND SOFFIT AT 10' LEVELS BOTH VERTICAL AND HORIZONTAL.
 3. ALL JUNCTIONS BETWEEN CONCEALED VERTICAL AND HORIZONTAL SPACES SUCH AS OCCUR AT DROP CEILING, SOFFITS AND COVE CEILING.
 4. BETWEEN STAIR STRINGERS AT TOP AND BOTTOM OF RUN BETWEEN STUDS ALONG AND IN LINE WITH THE STRINGERS.
 5. CHIMNEYS AND CHIMNEY DUCTS, VENTS AND CHIMNEYS WITH NON-COMBUSTIBLE MATERIAL (SUCH AS UNFACED FIBERGLASS INSULATION).
 6. AT OPENINGS BETWEEN ATTIC SPACES AND THE CHIMNEY CHASE FOR FACTORY BUILT CHIMNEYS.
 7. WALLS HAVING PARALLEL OR STAGGERED STUDS FOR SOUND CONTROL SHALL HAVE FIRE BLOCKS OF MINERAL FIBER OR GLASS FIBER OR OTHER APPROVED NON-BUILD MATERIAL. THE INTEGRITY OF ALL BLOCKING AND DRIFT STUDS SHALL BE MAINTAINED.
 8. RIPPERS BUILT UP ROOF JOISTS.
 9. WHERE RIPPERS ARE ATTACHED TO TOP OF ROOF JOISTS (I.E. TO OBTAIN SLOPE FOR ORANGE), THE RIPPERS SHALL BE NAILED TO THE JOISTS WITH 16D NAILS AT 24" O.C. WHEN THE RIPPERS BECOME MORE THAN 1" OF JOIST, NAILED WITH 16D NAILS. JOISTS SHALL BE NAILED TO THE JOIST AT 48" O.C. MIN. L INTO THE JOIST AND INTO THE RIPPER.
 10. RIPPERS SHALL NOT RUN PARALLEL WITH THE CHIMNEY MEMBERS. IF RIPPERS ARE USED TO OBTAIN CROSS DRAINAGE TO MAIN FRAMING MEMBERS, THEY SHALL STAIR STEP IN HEIGHT.

BEAM / POST SCHEDULE

BEAM	DESCRIPTION	POST LEFT/RIGHT	COMMENTS
B1	2x8x10x10	12x8 TR 2x8x10x10	SEE DETAIL 21802.2
B2	2x8x10x10	12x8 TR 2x8x10x10	SEE DETAIL 21802.2
NOTES

- 1. SEE GENERAL STRUCTURAL NOTES FOR BEAM AND POST MATERIAL REQUIREMENTS.
- 2. SEE DETAIL 21802.2 FOR ALL BEAM TO POST CONNECTIONS UNO.
- 3. ALL EXPOSED EXTERIOR BEAMS TO BE ROUGH SHAVE.
- 4. ROUGH EXPOSED BEAMS TO BE THICK WITH 1/2" DIA. THROUGH BOLT AT 24" O.C. STAGGERED TOP AND BOTTOM, CORNER BOLT AND PLUG.
- 5. SAME NOTES ARE USED ON THE LEFT AND RIGHT SIDE OF BEAM ON SCHEDULE UNO.
- 6. BEAM ORIENTATION POST: L = LEFT POST, R = RIGHT POST.

TRUSS / RAFTER SCHEDULE

MARK	TRUSS TYPE	COMMENTS
T1	24" FLAT TRUSSES AT 24" O.C.	TOP CHORD BEAMS/BEAM POCKET
T2	24" FLAT TRUSSES AT 24" O.C.	TOP CHORD BEAMS/BEAM POCKET
T3	16" DEEP PLAT TRUSSES AT 24" O.C.	SEE PLAN FOR SPACING
T4	16" DEEP PLAT TRUSSES AT 24" O.C.	SEE PLAN FOR SPACING
T5	24" DEEP BLOMBING FLOOR TRUSSES FOR DECK	SEE PLAN FOR SPACING
T6	16" DEEP BLOMBING FLOOR TRUSSES FOR DECK	SEE PLAN FOR SPACING
T7	16" DEEP BLOMBING FLOOR TRUSSES FOR DECK	SEE PLAN FOR SPACING
T8	16" DEEP BLOMBING FLOOR TRUSSES FOR DECK	SEE PLAN FOR SPACING
T9	16" DEEP BLOMBING FLOOR TRUSSES FOR DECK	SEE PLAN FOR SPACING
T10	16" DEEP BLOMBING FLOOR TRUSSES FOR DECK	SEE PLAN FOR SPACING

NOTES

- 1. SEE DETAIL 21802.2 FOR ALL ORDER TO POST CONNECTIONS UNO.
- 2. SEE GENERAL STRUCTURAL NOTES FOR TRUSS MATERIAL REQUIREMENTS.
- 3. SEE PLAN FOR DRAG LOAD REQUIREMENTS.
- 4. FIELD VERIFY ALL CAN KLEVER CONDITIONS.
- 5. FIELD VERIFY BEAM POCKETS TO BE DESIGNED INTO TRUSSES.
- 6. FIELD VERIFY DUET POCKETS TO BE DESIGNED INTO TRUSSES.
- 7. CITY APPROVED TRUSS CALCULATIONS SHALL BE ON JOB SITE PRIOR TO FRAME INSPECTION.
- 8. PLAT TRUSSES AT LIVABLE AREAS TO HAVE MINIMUM 1/2" HEEL HEIGHT.
- 9. BLOMBING PLAT ROOF TRUSSES TO BE MIN. 1/2" HEEL.
- 10. REFER TO PLAN FOR HEEL HEIGHTS AT STUBBED TRUSS CONDITIONS, FIELD VERIFY.

REVISIONS	DATE	BY	CHKD
1	05/22/24		
2			
3			
4			
5			
6			
7			
8			
9			
10			



THE DRAFTERY
REGISTERED PROFESSIONAL ENGINEER
17400

KUBITZ RESIDENCE
LOT 11 OF HIDDEN HILLS
14382 EAST COVOTE ROAD
SCOTTSDALE, ARIZONA 85259

PRINT DATE: 3/29/2024
JOB NO.: 217-07-111
DRAWN BY: PT
CHECKED BY: TEAM
SCALE: 1/4"=1'-0"
SHEET NUMBER:

A6.0
COS PLAN CHECK #145024

GENERAL FRAMING NOTES

1. REFER TO STRUCTURAL NOTE SHEETS S-1 AND S-2 FOR ADDITIONAL INFORMATION.
2. REFER TO STRUCTURAL DETAIL SHEET 802.2 FOR TYPICAL CONSTRUCTION DETAILS.
3. STUD MATERIAL:

PROVIDE WALL STUD AS SHOWN BELOW UNLESS, ON PLANS OR DETAILS.

LOCATION	1. STUD
Exterior bearing wall	2X6 Service-Ready 4110 grade studs at 16" o.c.
Exterior nonbearing wall	2X6 Service-Ready 4110 grade studs at 16" o.c.
Interior bearing wall	2X6 Service-Ready 4110 grade studs at 16" o.c.
Interior nonbearing wall	2X4 Service-Ready 4110 grade studs at 16" o.c.

4. SHEATH ALL EXTERIOR WALLS WITH MIN. 5/8" APA RATED PLYWOOD SHEATHING

5. ROOF SHEATHING SHALL BE 1/2" WOOD PRODUCT PANELS WITH A SPAN INDEX OF 32/18. EXPOSURE 1. PLACE SHEETS WITH FACE GROUND PERPENDICULAR TO SUPPORT. BLOCKING IS NOT REQUIRED UNLESS NOTED ON THE FRAMING PLAN, CRICKETS AND MISCELLANEOUS FRAMING TO OVERLAY PLYWOOD SHEATHING. REFER TO DETAIL 215D2.1. TYPICAL ROOF SHEATHING KILLS SHALL BE:
80 COMMON HAS 5 1/4" 8-PHOLE O.C. ALONG ALL BOUNDARIES AND TIGES; AND 12 PHOLE O.C. IN FIELD.
ALTERNATE: 14 GAUGE 3" X 1" LONG WITH 1/16" CROWN AT 6" O.C. ALONG ALL BOUNDARIES AND EDGES AND 12" O.C. IN FIELD. BLOCKING IS NOT REQUIRED.
ALTERNATE: 16 GAUGE 3" X 1" LONG WITH 1/16" CROWN AT 6" O.C. ALONG ALL BOUNDARIES AND EDGES AND 12" O.C. IN FIELD. BLOCKING IS NOT REQUIRED.

6. LIGHT METAL PLATE CONNECTED WOOD ROOF TRUSSES SHALL BE DESIGNED TO SUPPORT THE FLOORING LOADS AND DEFLECTION REQUIREMENTS. TRUSSES SHALL BE CAMBERED.

Roof Trusses:	
Dead Load (flat roof with beam)	15 PSF
Dead Load (12/12 roof with beam)	32 PSF
Typical Live Load	20 PSF
Shoe Soffits	+15 PSF to built, chord
Lateral Load	As noted on plans or 2000K min.
Deflection Limitations, all spans:	
Vert. deflection under dead and live load	Span/240 or 3/4" max.
Vert. deflection under dead and live load	Span/360 or 3/4" max.
Vert. deflection between all trusses	1/2" max.
Wind deflection under dead and live load	3/8" max.


Roof truss camber to equal dead load deflection

Roof Trusses:	
Dead Load (1/2" high weight concrete)	31 PSF
Dead Load (walk deck)	16 PSF
Typical Live Load	40 PSF
Partitions	5 PSF
Lateral Load	As noted on plans or 2000K min.
Camber:	

Roof truss camber to equal dead load deflection

PREFABRICATED WOOD ROOF TRUSSES TO BE PROVIDED BY AN APPROVED FABRICATOR WITH THE SHOP DRAWINGS AND CALCULATIONS SEALED BY AN ARIZONA REGISTERED ENGINEER. TRUSS DIAGRAMS AND KEYED LISTS SHALL BE AVAILABLE TO THE FIELD INSPECTOR AT THE JOB SITE AT THE TIME OF ROOF FRAMING INSPECTION.

BEAM / POST SCHEDULE		
BEAM / DESCRIPTION	POST LEFT/RIGHT	COMMENTS
B1 2X6 HDR	2X6 TR 2X6 KS EACH END UNO	
B2 2X6 HDR	2X6 TR 2X6 KS EACH END UNO	TYPE CLEANSITY HEADER
B3 2X6 HDR	2X6 TR 2X6 KS EACH END UNO	
B4 2X6 HDR	2X6 TR 2X6 KS EACH END UNO	
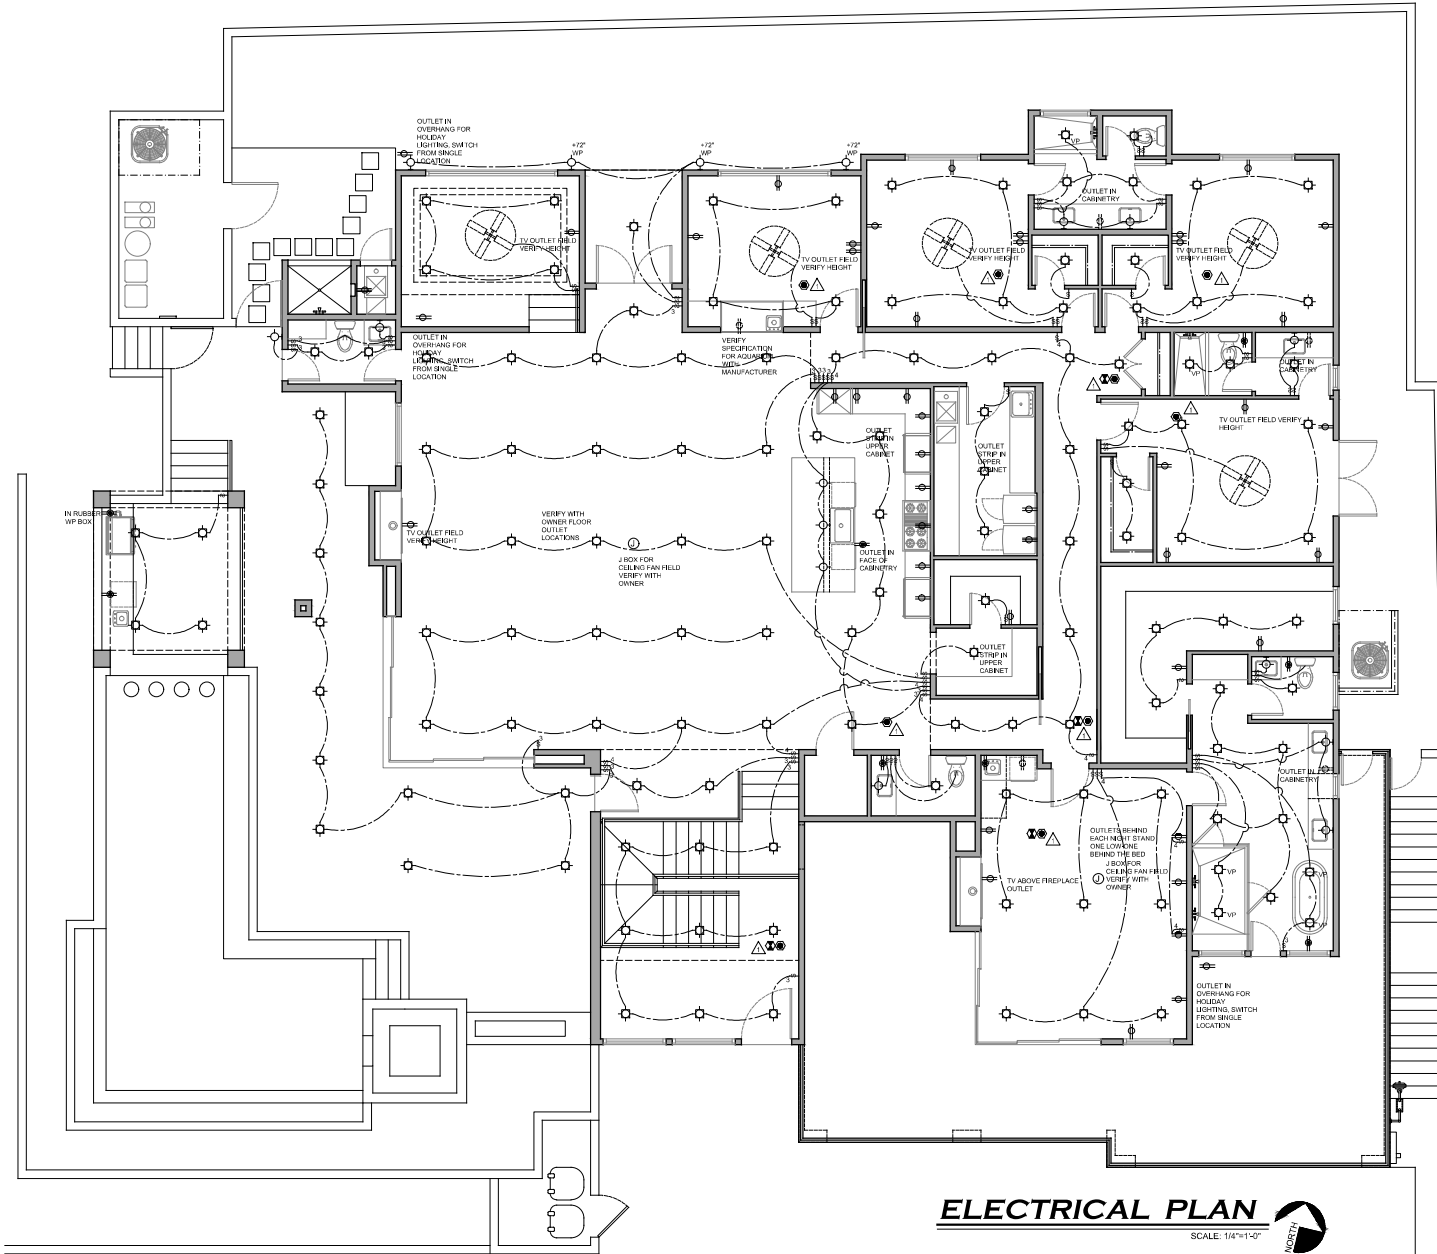

ELECTRICAL PLAN
SCALE: 1/4"=1'-0"
NORTH

ELECTRICAL NOTES:

1. PRIOR TO INSTALLATION OF ELECTRICAL SYSTEM, THE ELECTRICAL PLAN SHALL BE COORDINATED WITH HOME OWNER FOR REVIEW TO CONFIRM LIGHTING FEATURE, CHOICE, LOCATION, CHOICE OF BULBS, AND LOCATION OF RECEPTACLES.
2. ALL FLUORESCENT LIGHTING SHALL BE ENERGY SAVING BALLAST.
3. OPENING AROUND ELECTRICAL PENETRATION THROUGH FIRE RATED WALLS, PARTITIONS, FLOORS OR CEILING (GAPFILL) SHALL BE FIRE STOPPED USING APPROVED METHODS TO MAINTAIN THE FIRE-RESISTIVE RATING.
4. J-BOX TO BE ATTACHED IN MANNER TO ADEQUATELY SUPPORT WEIGHT OF FIXTURE SELECTED BY OWNER.
5. LIGHTS AND FIXTURES INSTALLED OUTSIDE MUST COMPLY WITH 2017 NEC FOR DAMP LOCATIONS.
6. A MINIMUM OF 80 PERCENT OF THE LAMPS IN PERMANENTLY INSTALLED LIGHTING FIXTURES SHALL BE HIGH-EFFICIENCY LAMPS OR A MINIMUM OF 30 PERCENT OF THE PERMANENTLY INSTALLED LIGHTING FIXTURES SHALL CONTAIN ONLY HIGH-EFFICIENCY LAMPS, (NATIONAL).
7. PROVIDE TAMPER RESISTANT RECEPTACLES IN AREAS AS SPECIFIED IN IRC 4100.141.
8. PROVIDE METAL OR OTHER MATERIALS LISTED FOR USE BETWEEN THE DOWLING AND DAMAGE AND IN THE GARAGE CEILING LISTED FOR USE INTENDED (IRC R302.2).

CITY OF SCOTTSDALE NOTES:

6. EXTERIOR LIGHTING OVER 20 WATTS SHALL INCLUDE AN AUTOMATIC SHUT-OFF, (INITIALS).
7. ALL PERMANENTLY INSTALLED LIGHTING FIXTURES SHALL CONTAIN ONLY HIGH-EFFICIENCY LAMPS, (NATIONAL).
8. ALL PERMANENTLY INSTALLED INTERIOR LIGHTING FIXTURES SHALL BE CONTROLLED WITH EITHER A DIMMER, AN OCCUPANT SENSOR CONTROL, OR OTHER CONTROLS, SUCH AS AN AUTOMATIC TIMER SHUT-OFF SWITCH. EXCEPTIONS INCLUDE BATHROOMS AND HALLWAYS, (INITIALS).
9. TERRESTRIAL SURGE PROTECTION, ALL ELECTRICAL SERVICES SUPPLYING ONE- AND TWO-FAMILY DWELLING UNITS SHALL BE PROVIDED WITH A SURGE PROTECTIVE DEVICES (SPD) INSTALLED IN ACCORDANCE WITH SECTION C900.1.1 THROUGH C900.1.3, (NEW ELECTRICAL PANELS).
10. ELECTRIC VEHICLE CHARGING CAPACITY, RESERVE ELECTRICAL SERVICE PANEL SPACE FOR FULL SIZE 240V CIRCUIT BREAKER LABELED 'FUTURE EV CHARGING'. A BACKWIRE SHALL BE INSTALLED FROM THE ELECTRICAL SERVICE PANEL TO A LOCATION WITHIN THE GARAGE, WHERETIT SHALL TERMINATE IN A JUNCTION BOX OR OUTLET AND BE LABELED 'FUTURE EV CHARGING'.
11. 'SOLAR-READY' ZONES - MINIMUM 10% OF ROOF AREA BUT NOT LESS THAN 300 SQ. FT. FREE AND CLEAR OF OBSTRUCTIONS INCLUDING MECHANICAL EQUIPMENT AND VENTS, PROVIDE ELECTRICAL PATHWAY FOR CONDUIT RUN FROM SOLAR-READY ZONE TO ELECTRICAL SERVICE PANEL WITH RESERVED SPACE FOR CABLE CIRCUIT BREAKER, CAPPED ROOF PENETRATION SLEEVE SHALL BE PROVIDED ON ROOFS WITH A SLOPE OF 1 IN 12 OR LESS.
12. EXHAUST AIR FROM BATHROOMS, KITCHENS AND TOILET ROOMS SHALL BE EXHAUSTED DIRECTLY TO THE OUTDOORS. NOT RECALCULATED OR DISCHARGED INDOORS. (M1507.2 AMENDED).
13. EXHAUST FANS IN BATHROOMS WITH A SHOWER OR TUB SHALL BE PROVIDED WITH A 'DELAY' TIMER OR HUMIDITY/CONDENSATION CONTROL SENSOR. EXHAUST FANS SHALL BE SWITCHED SEPARATELY FROM LIGHTING SYSTEMS. (R303.3) AMENDED.

ELECTRICAL SYMBOL LEGEND

	SWITCH SINGLE POLE @ 14" A.F.F. UNLESS NOTED OTHERWISE
	LIGHT, CLG MOUNTED
	LIGHT, WALL MOUNTED - HEIGHT AS INDICATED
	9" RECESSED LIGHT IN CLG. WITH HALOGEN BULB
	FLUORESCENT LIGHT, SURFACE MTL. (A TUBE UNLESS NOTED OTHERWISE)
	12"Ø" FLUSH MOUNTED
	OUTLET 120V RECEPTACLE @ 14" UNLESS NOTED OTHERWISE
	OUTLET CLG. REC. (8" ABOVE COUNTER TOP LOCATION)
	EXHAUST FAN
	SMOKE DETECTOR
	CARBON MONOXIDE ALARM

REVISIONS

NO.	DATE	DESCRIPTION
1	05/22/24	ISSUED FOR PERMIT

This drawing is the property of the City of Scottsdale. It is to be used only for the project and location specified on the title block. It is not to be reproduced, copied, or otherwise used without the written permission of the City of Scottsdale.


THE DRAFTERY
RESIDENTIAL DESIGN
1000 N. MCDONALD AVE. SUITE 100, SCOTTSDALE, AZ 85259
TEL: 480.340.0000 | E: info@thedraftery.com

KUBITZ RESIDENCE
LOT 11 OF HIDDEN HILLS
14382 EAST COYOTE ROAD
SCOTTSDALE, ARIZONA 85259

ELECTRICAL PLAN - 1ST FLOOR

PRINT DATE: 3-29-2024
JOB NO.: 217-67-111
DRAWN BY: PT
CHECKED BY: TEAM
SCALE: 1/4"=1'-0"
SHEET NUMBER:

E1.0
COS PLAN CHECK #145-24

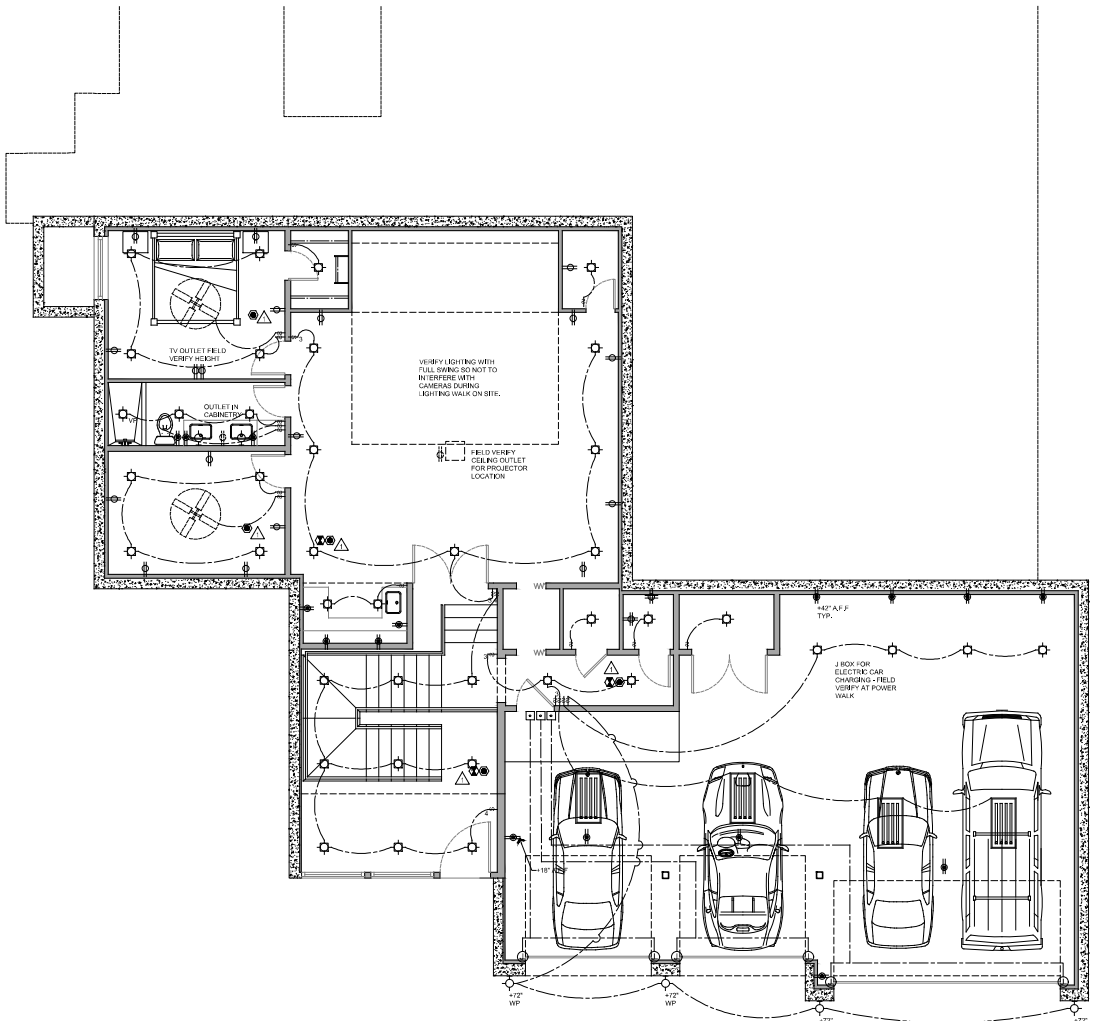

ELECTRICAL PLAN
SCALE: 1/4"=1'-0"

ELECTRICAL NOTES:

1. POWER TO BE INSTALLED BY ELECTRICAL CONTRACTOR.
2. ALL FLUORESCENT LIGHTING SHALL BE ENERGY SAVING.
3. OPENING AROUND ELECTRICAL PENETRATION THROUGH FIRE RATED WALLS, PARTITIONS, FLOORS OR CEILINGS (GARAGE) SHALL BE FIRE STOPPED USING APPROVED METHODS TO MAINTAIN THE FIRE-RATING OF THE RATING.
4. -BOX TO BE ATTACHED IN MANNER TO ADEQUATELY SUPPORT WEIGHT OF FIXTURES SELECTED BY OWNER.
5. LIGHTS AND FIXTURES INSTALLED OUTSIDE MUST COMPLY WITH 2017 NEC FOR DAMP LOCATIONS.
6. A MINIMUM OF 90 PERCENT OF THE LUMPS IN PERMANENTLY INSTALLED LIGHTING FIXTURES SHALL BE ENERGY EFFICIENT LAMPS OR A MINIMUM OF 90 PERCENT OF THE PERMANENTLY INSTALLED LIGHTING FIXTURES SHALL CONTAIN ONLY 1 HIGH-EFFICIENCY LAMPS, (IN 104.1).
7. PROVIDE TAMPER RESISTANT RECEPTACLES IN AREAS AS SPECIFIED IN IRC 4002.141.
8. PROVIDE 18" X 14" OR 24" X 18" METAL BOXES FOR USE BETWEEN THE DWELLING AND GARAGE AND IN THE GARAGE CEILING LISTED FOR USE INTENDED (IRC 4002.4.2).


ELECTRICAL SYMBOL LEGEND	
	SWITCH, SINGLE POLE @ 48" A.F.F. UNLESS NOTED OTHERWISE
	LIGHT, CLG. MOUNTED
	LIGHT, WALL MOUNTED - HEIGHT AS INDICATED
	1" RECESSED LIGHT IN CLG. WITH HALOGEN BULB
	FLUORESCENT LIGHT, SURFACE MTD. 4 TUBE (UNLESS NOTED OTHERWISE)
	"ABOX" FLUSH MOUNTED
	DUPLEX 110V RECEPTACLE @ 1'-2" UNLESS NOTED OTHERWISE
	G.F.I. REC. (8" ABOVE COUNTER TOP LOCATION)
	EXHAUST FAN
	SMOKE DETECTOR
	CARBON MONOXIDE ALARM

CITY OF SCOTTSDALE NOTES:

6. EXTERIOR LIGHTING OVER 30 WATTS SHALL INCLUDE AN AUTOMATIC DARKNESS CONTROL.
7. ALL PERMANENTLY INSTALLED LIGHTING FIXTURES SHALL CONTAIN ONLY HIGH-EFFICIENCY LAMPS, (IN 104.1).
8. ALL PERMANENTLY INSTALLED INTERIOR LIGHTING FIXTURES SHALL BE CONTROLLED BY EITHER A DIMMER, AN OCCUPANCY SENSOR CONTROL, OR OTHER CONTROL, SUCH AS AN AUTOMATIC TIME-ON/OFF SWITCH, EXCEPTING INCLUDE BATHROOMS AND HALLWAYS, (IN 104.2).
9. SINKS SURGE PROTECTION, ALL ELECTRICAL SERVICES SUPPLYING ONE- AND TWO-FAMILY DWELLING UNITS SHALL BE PROVIDED WITH A SURGE PROTECTIVE DEVICE (SPD) INSTALLED IN ACCORDANCE WITH SECTIONS E3006.5.1 THROUGH E3006.5.4, (NEW ELECTRICAL PANELS).
10. ELECTRIC VEHICLE CHARGING CAPACITY, RESERVE ELECTRICAL SERVICE PANEL SPACE FOR FULL SIZE SINGLE CIRCUIT BREAKER LABELED "FUTURE EV CHARGING". A RACEWAY SHALL BE INSTALLED FROM THE ELECTRICAL SERVICE PANEL TO A LOCATION WITHIN THE GARAGE, WHERE IT SHALL TERMINATE IN A JUNCTION BOX OR OUTLET AND BE LABELED "FUTURE EV CHARGING".
11. SOLAR READY ZONES - 18% MINIMUM 10% OF ROOF AREA BUT NOT LESS THAN 300 SQ. FT. FREE AND CLEAR OF OBSTRUCTING INCLUDING MECHANICAL EQUIPMENT AND VENTS, PROVIDE ELECTRICAL PATHWAY FOR CONDUIT RUN FROM SOLAR READY ZONE TO ELECTRICAL SERVICE PANEL WITH RESERVED SPACE FOR SINGLE CIRCUIT BREAKER, CAPPED ROOF FROM TRAILING ELEMENT SHALL BE PROVIDED ON ROOFS WITH A SLOPE OF 1/4" 12 OR LESS.
12. EXHAUST FANS IN BATHROOMS, KITCHENS AND TOILET ROOMS SHALL BE EXHAUSTED DIRECTLY TO THE OUTDOORS, NOT RECALCULATED OR DISCHARGED INTO ROOMS, (IN 104.2 AMENDED).
13. EXHAUST FANS IN BATHROOMS WITH A SHOWER OR TUB SHALL BE PROVIDED WITH A DELAY TIMER OR HUMIDITY/CONDENSATION CONTROL SENSOR, EXHAUST FANS SHALL BE SWITCHED SEPARATELY FROM LIGHTING SYSTEMS, (IRC 4002.3 AMENDED).

LOAD CALCS

PROJECT DESCRIPTION	SF	QUANTITY X WATT	TOTAL KUBITZ
LIVABLE	3040	3	18120
SMALL APPLIANCE CIRCUITS		3	1500
GENERAL LAUNDRY		2	1500
DRYER - GAS		1	8000
DISHWASHER		1	1500
DISHWASHER		1	720
MICROWAVE		2	1200
OPEN-ELECTRIC COOKTOP - GAS		1	5000
WOOD		1	10000
REFRIGERATOR		1	1200
REFRIGERATOR		1	1500
FREEZER		1	1500
ICE MAKER		0	800
WARMING DRAWER		0	1400
WINDUP POOL TUB		0	1500
WATER HEATER - GAS		2	4500
CENTRAL VAC SYSTEM		0	1500
LANDSCAPE LIGHTING		1	900
PAINTED HEATERS		0	3000
GARAGE DOOR OPENERS		2	1200
GARAGE CIRCUITS		2	2400
SUB-TOTAL			10640
FIRST 100W @ 100%			10000
REMAINER @ 40%			24336.000000
TOTAL LIGHTING AND APPLIANCE LOAD			34336.000000
REMAINING LOADS			
AIR HANDLERS	2	1200	2400
1.5 TON A/C	0	0	0
2 TON A/C	0	2000	0
3 TON A/C	0	3450	0
4 TON A/C	0	4650	0
5 TON A/C	2	8550	11700
POOL FILTER	1	1500	1500
SPA HEATER - GAS	0	11500	0
POOL LIGHTS	1	1800	1800
POOL COVER	0	1200	0
SUB-TOTAL			17400
NET LOAD IN WATTS			51736.000000
NET LOAD IN AMPS (WATTS/240)			215.57

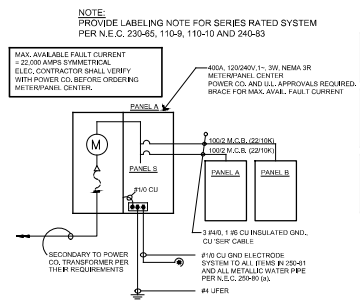

REVISIONS

1	2024-03-29	1
2	2024-03-29	1
THE DRAFTERY
RESIDENTIAL DESK

14362 EAST COYOTE ROAD
SCOTTSDALE, ARIZONA 85259

100% WORKING ON A LOCAL CITY TOWN HALL AZ
100% WORKING ON A LOCAL CITY TOWN HALL AZ

KUBITZ RESIDENCE
LOT 11 OF HIDDEN HILLS
14362 EAST COYOTE ROAD
SCOTTSDALE, ARIZONA 85259

ELECTRICAL PLAN - BASEMENT

SHEET TITLE

PRINT DATE: 2024-03-29

JOB NO.: 217-67-111

DRAWN BY: PT


CHECKED BY: TEAM

SCALE: 1/4"=1'-0"

SHEET NUMBER:

E1.1

COS PLAN CHECK #145-24

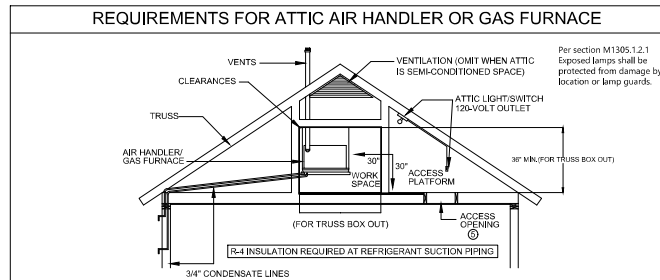

SUPPLY GRILL NOTES

SUPPLY GRILL SHALL BE BAR FACED REGISTERS

SUPPLY GRILLS SHALL BE 4 WAY ADJUSTABLE

SUPPLY GRILLS SHALL INCLUDE OPPOSED BLADE DAMPER

SUPPLY GRILLS MANUFACTURED BY TRUE-AIR, PRO-SELECT OR EQUIVALENT

UNLESS OTHERWISE NOTED ON THE PLAN, THE RETURN GRILLS SHALL BE SIZED ACCORDING TO THE BELOW MENTIONED CHART:

SUPPLY GRILL SIZES

FLEX DUCT SIZE	4 WAY CEILING	4 WAY SIDEWALL
4"	6" X 6"	6" X 8"
5"	6" X 6"	6" X 8"
6"	8" X 8"	6" X 10"
7"	10" X 10"	6" X 12"
8"	12" X 12"	6" X 12"
9"	12" X 12"	6" X 14"
10"	14" X 14"	8" X 14"

UNLESS OTHERWISE NOTED ON THE PLAN, THE RETURN GRILLS SHALL BE SIZED ACCORDING TO THE BELOW MENTIONED CHART:

RETURN REGISTERS - GRILLS

DUCT SIZE	GRILL SIZE	DUCT SIZE	GRILL SIZE
8"	12" X 12"	14"	20" X 20"
9"	12" X 12"	16"	25" X 20"
10"	14" X 14"	18"	30" X 20"
12"	14" X 14"	20"	40" X 20"

RETURN GRILL NOTES

RETURN GRILLS SHALL BE BAR FACED FILTER GRILLS

CEILING GRILLS SHALL BE A MINIMUM OF 200 SQ. IN. PER 12,000 BTU'S OF TOTAL EQUIPMENT RATED COOLING OUTPUT

FILTER FRAMES SHALL HAVE A MERV 7 FILTER

VERTICAL UNITS TO INCLUDE FILTER BASES WITH RETURN BAR FACED RETURN GRILLS WITHOUT FILTER FRAMES

ACTUAL RETURN CFM PER ACCA RIGHT-SUITE MANUAL D REPORT

ROOM PRESSURE & PRESSURE BALANCING

JUMP DUCTS OR RETURNS SHALL BE PLACED IN BEDROOMS TO INSURE ROOM PRESSURE AT POST TESTING WITH A PRESSURE TEST BETWEEN 0.0 PA AND 3.0 PA.

BEDROOM JUMP DUCT SIZING SHALL ALLOW FOR EQUAL OR GREATER CFM AIR MOVEMENT THAN THE TOTAL SUPPLY CFM ENTERING THE CLOSED ROOMS

WHEN POSSIBLE, MULTIPLE BEDROOM JUMP DUCTS MAY BE INSTALLED INTO 1 PROPERLY SIZED COMMON AREA BOOT BOX

JUMP DUCTS ARE NOT REQUIRED WHEN PROPERLY SIZED RETURNS ARE INSTALLED IN THE BEDROOMS

SEE HOOD AND DRYER FOR MAKE UP AIR REQUIREMENTS.

A COMBUSTIBLE APPLIANCE ZONE TEST SHALL BE PERFORMED UNDER WORST CASE SCENARIO AND BPI CAZ STANDARD MUST BE ADHERED TO.

DUCTWORK

ALL JOINTS, SEAMS, CONNECTIONS, TRANSITIONS IN DUCT WORK SHALL BE SECURELY FASTENED AND SEALED WITH A MECHANICAL FASTENER, APPROVED MASTIC AND TAPE.

ALL DUCT LOCATED IN A VENTED ATTIC OR IN SPACE OUTSIDE OF THE THERMAL ENVELOPE (AFTER A CONTINUOUS INSULATION) SHALL BE INSULATED TO A MINIMUM OF R-6.

ALL DUCTS LOCATED WITHIN AN ENCAPSULATED ATTIC (UNDERNEATH CATHEDRAL FOAM INSULATION) MAY BE INSULATED TO A MINIMUM OF R-4.2.

DUCTS NOT BE INSTALLED WITHIN 12" OF THE ROOF OR CEILING DECK

CONSTRUCT ALL DUCT WORK TO INSURE MINIMUM RESISTANCE AND NOISE

PLATFORM RETURNS MUST BE SEALED WITH DUCT BOARD AND MASTIC

FLEX DUCT

DUCTS SHALL BE INSULATED FLEX DUCT UNLESS OTHERWISE SPECIFIED

ALL DUCT WORK SHALL BE INSTALLED WITHOUT KINKS OR BENDS WITH EVEN TURNS.

A MINIMUM OF 36" LONG SHEET METAL SUPPLY PLENUM AND A MINIMUM OF 24" LONG SHEET METAL RETURN PLENUM SHALL BE INSTALLED AT THE EQUIPMENT.

ALL DUCTS SHALL BE SUPPORTED NO LESS THAN EVERY 4' BY APPROVED STRAP.

RIGID DUCT

RIGID DUCT WORK SHALL BE GALVANIZED LOCK FORMING SHEET METAL.

SIZES SHALL BE CLEAR INSIDE DIMENSIONS


RETURN DUCTS REQUIRE INSULATION LINEAR ON THE FIRST 10'

RIGID DUCT WORK SHALL BE INSTALLED IN STRICT CONFORMANCE WITH THE LATEST SMACNA MANUAL AND LOCAL CODES FOR LOW VELOCITY DUCT CONSTRUCTION STANDARDS.


TURNING VEINS SHALL BE UTILIZED WHERE APPROPRIATE.

ALL RIGID DUCTS SHALL BE SUPPORTED BY HANGERS NO LESS THAN EVERY 8'.

ATTIC ACCESS CATWALK

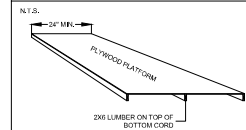

THE ACCESS CATWALK MUST BE A MIN. OF 24" WIDE CONTINUOUS FLOORING NOT MORE THAN 20 FEET IN LENGTH. UNLESS THE ENTIRE APPLIANCE CAN BE SERVICED FROM THE ATTIC ACCESS OPENING. PROVISIONS MUST BE MADE FOR PROPER INSULATION TO BE INSTALLED UNDER THE PLATFORM.

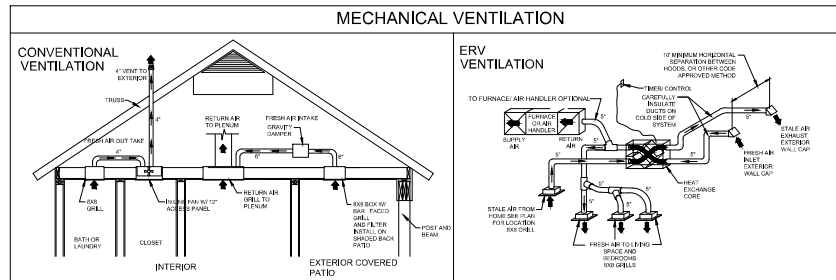

M1505.4.3(1) CONTINUOUS WHOLE-HOUSE MECHANICAL VENTILATION SYSTEM AIR FLOW RATE REQUIREMENTS (IRC 2021)

DWELLING UNIT FLOOR AREA (SQUARE FEET)	NUMBER OF BEDROOMS				
	0 TO 1	2 TO 3	4 TO 5	6 TO 7	> 7
< 1,500	30	45	60	75	90
1,501 - 3,000	45	60	75	90	105
3,001 - 4,500	60	75	90	105	120
4,501 - 6,000	75	90	105	120	135
6,001 - 7,500	90	105	120	135	150
> 7,500	105	120	135	150	165

THE WHOLE-HOUSE VENTILATION SYSTEM SHALL CONSIST OF ONE OR MORE SUPPLY OR EXHAUST FANS, OR A COMBINATION OF SUCH, AND ASSOCIATED DUCTS AND CONTROLS. LOCAL EXHAUST OR SUPPLY FANS ARE PERMITTED TO SERVE AS SUCH A SYSTEM. OUTDOOR AIR DUCTS CONNECTED TO THE RETURN SIDE OF AN AIR HANDLER SHALL BE CONSIDERED AS PROVIDING SUPPLY VENTILATION. M1505.4.1

THE WHOLE-HOUSE MECHANICAL VENTILATION SYSTEM SHALL BE PROVIDED WITH CONTROLS THAT ENABLE MANUAL OVERRIDE PER M1505.4.2

THE WHOLE-HOUSE MECHANICAL VENTILATION SYSTEM SHALL PROVIDE OUTDOOR AIR AT A CONTINUOUS RATE OF NOT LESS THAN THAT DETERMINED IN ACCORDANCE WITH TABLE M1505.4.3(1)

BLOWER DOOR TEST SHALL BE PERFORMED TO COMPLY WITH SECTION N1102.4.1.1 AND N1102.4.3.2. THE SEALING METHODS BETWEEN DISSIMILAR MATERIALS SHALL ALLOW FOR DIFFERENTIAL EXPANSION AND CONTRACTION.

DUCTS, AIR HANDLERS AND FILTER BOXES SHALL BE SEALED. JOINTS AND SEAMS SHALL COMPLY WITH SECTION M1601.4.1. DUCT TIGHTNESS TEST SHALL BE CONDUCTED PER N1103.3.3 OR OTHER ADOPTED METHOD.

CLOTHES DRYER EXHAUST AND MAKE-UP AIR REQUIREMENTS SHALL COMPLY WITH IRC G2439.

MECHANICAL VENTILATION SYSTEM FANS SHALL MEET THE EFFICACY REQUIREMENTS OF TABLE N1103.6.1

CONDENSATE SYSTEM


CONDENSATE FROM ALL COOLING AND EVAPORATORS SHALL CONSIST OF 3/4" PVC PIPING WITH A MINIMUM SLOPE IN THE DIRECTION OF THE DISCHARGE NOT LESS THAN 1/8" VERTICAL FALL OVER EACH 12" SECTION OF PIPE. SUCH PIPE SHALL BE CONNECTED TO THE PRIMARY DRAIN PAN OUTLET TO THE APPROVED PLACE OF DISPOSAL.

A CLEAR 3/4" CLEAR P-TRAP WITH BRUSH ATTACHMENT SHALL BE INSTALLED ON THE PRIMARY DRAIN LINE.

A EZ-TRAP MODEL EZT626 OR EQUIVALENT SAFETY OVERFLOW SWITCH SHALL BE INSTALLED ON THE SECONDARY DRAIN OUTLET.


A SECONDARY DRAIN PAN SHALL BE INSTALLED ON HORIZONTAL UNITS INSTALLED OVER IN THE ATTIC. A 3/4" PVC PIPING WITH A MINIMUM SLOPE IN THE DIRECTION OF THE DISCHARGE NOT LESS THAN 1/8" VERTICAL FALL OVER EACH 12" SECTION OF PIPE. SUCH PIPE SHALL BE CONNECTED TO THE PRIMARY DRAIN PAN OUTLET TO THE APPROVED PLACE OF DISPOSAL.

TRUSS BOX OUT CLEARANCE

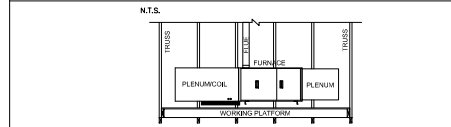

BOX OUT CLEARANCE FOR ATTIC INSTALLED FURNACE TO BE MIN. 102X1 PER UNIT OR 6X3 FOR ELECTRIC AIR HANDLER UNIT. THE REQUIRED MAINTENANCE PLATFORM MUST BE NO LESS THAN 30" IN DEPTH FOR THE ENTIRE SERVICE SIDE OF THE UNIT WITH A MIN. HEIGHT CLEARANCE OF 30".

MAKE UP AIR FOR HOODS 400 CFM AND OVER

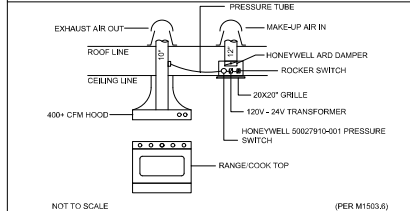

NOT TO SCALE (PER M1503.6)


HOOD

MAKE-UP AIR DIFFUSER MUST BE LOCATED WITHIN 8' OF HOOD

MAKE UP AIR DETAIL SHALL BE INSTALLED WHEN THE KITCHEN EXHAUST HOOD EXCEEDS 400CFM

THE MINIMUM REQUIRED LOCAL EXHAUST RATE AT THE KITCHEN SHALL BE 100CFM INTERMITTENT OR 25CFM CONTINUOUS. (M1505.4.4)

DRYER BOX DETAIL

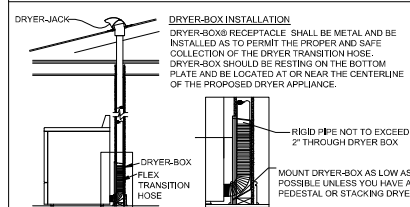

DRYER DUCT

INSTALL DRYER BOX DVLX100M6 1.5" OFF THE FLOOR HEIGHT OR PER BUILDER SPECIFICATION

4" RIGID DRYER VENT SHALL BE A MAXIMUM LENGTH OF 35' FROM THE DRYER TO THE OUTLET TERMINAL (WALL CAP WITH BACKDRAFT DAMPER OR NON-SCREENED T-TOP). WHERE FITTINGS ARE USED, THE MAXIMUM DRYER DUCT LENGTH SHALL BE REDUCED AS FOLLOWS: 2.5' FOR EVERY 45 DEGREE ELBOW AND 5' FOR EVERY 90 DEGREE ELBOW

IRC 2021