

To: All Plan Holders and Prospective Bidders

Re: State Center Fire Department  
Renovation & Addition – Redesign  
109 E Main Street  
State Center, Iowa 50247

## ADDENDUM #02

January 09, 2026

This addendum incorporates the following changes to the bid documents dated 18 December 2025. To be considered, bidders shall indicate on the Bid Form that this communication was received and that all changes were included in their bid total. It is the responsibility of the contractor to contact the owner's representative prior to bid date to verify the issuing of any and all clarifying addenda.

These items shall supersede all statements to the contrary in the drawings and project manual (specifications) and shall take precedence over those documents. These items are not listed in any particular order and are intended to add, omit, revise and/or clarify the original scope of work.

Addendum #2: **25 Pages Total**

Please feel free to contact me via phone at 515-460-5431 or email at [chris@studiomelie.com](mailto:chris@studiomelie.com) if you have any questions or comments concerning this addendum or if you require additional information/clarification.

Respectfully submitted,



Christopher P. Wernimont, AIA

---

Architectural Addendum:

Item #A1: **087100 – ELECTRIFIED DOOR OPERATOR SUBSTITUTIONS**

1. **Approved Manufacturer's:**

- a. Horton Automatics
- b. Stanley Access Technologies

2. **Note:** See approval note on substitution request forms (attached).

Item #A2: **133400 – METAL PANEL ACCESSORY CLARIFICATIONS & SUBSTITUTIONS**

1. **Omit** paragraph 2.6.A. Anti-Condensation Felt, for underside of steel panels– **product not used.**

2. **Approved Manufacturer & Products:**

- a. American Building Components (ABC):
  - i. Metal Panel 2A (Field): AVP Exposed Fastener Wall Panel.  
Finish: Ash Gray or as selected by Architect from mfg's full color line.
  - ii. Metal Panel 2B (Accent): AVP Exposed Fastener Wall Panel.  
Finish: Scarlet Red or as selected by Architect from mfg's full color line.
  - iii. Metal Panel 2C (Roof): PBR Exposed Fastener Roof Panel.  
Finish: Ash Gray or as selected by Architect from mfg's full color line.
  - iv. Metal Liner Panels (MLP): PBD Exposed Fastener Liner Panel (for walls).  
Finish: Polar White or as selected by Architect from mfg's full color line.
  - v. Metal Liner Panels (MLP): PBR (reversed rolled) Exposed Fastener Liner Panel (for roof).  
Finish: Polar White or as selected by Architect from mfg's full color line.

Item #A3: **SHEET A0.2 – REVISE ASSEMBLIES**

1. **Assembly C1A/B:**

- a. **Omit** Anti-Condensation Felt Backing from assembly **C1A**.
- b. **Add** 10-mil poly vapor barrier to assembly **C1B**. Vapor barrier to be located between GWB and wood framing.

2. **Assemblies W5A/B, W5C, W5D/E:**

- a. **Revise** framing type from metal stud framing to **wood stud framing**.

Item #A4: **SHEET A4.1 and SHEET A8.1 – REVISE SOFFIT ASSEMBLY TYPE @ INSET WINDOW**

1. **Revise** 1/A4.1 soffit assembly from S1 to **C1A** at soffit of inset window- S1 not used.

2. **Revise** 1/A8.1 soffit assembly from S1 to **C1A** at soffit of inset window- S1 not used.

Item #A5: **SHEET A9.1 – FINISH SCHEDULE – RM #114 REVISE CEILING FINISH**

1. **Revise** room #114 Apparatus Storage ceiling finish to **MLP**.

- a. **Note:** ceiling finish shown correctly on A8.1 Ceiling Plan.

---

Item #A6: **SHEET A9.1 – FINISH LEGEND REVISIONS**

1. Revise manufacturer listing for 'MLP', 'MRP', 'MWP-1', 'MWP-2', 'PFIN-1', and 'PFIN2' from Butler MFG. to McElroy Metal.
2. Revise description listing for MWP-1 from Metal Wall Panel – Type 1 to Metal Wall Panel – Type 2A (field).
3. Revise description listing for MWP-2 from Metal Wall Panel – Type 2 to Metal Wall Panel – Type 2B (accent).

Item #A7: **BIDDER QUESTIONS & DESIGN TEAM RESPONSES**

1. Q: Will a water softener be needed since specification mentions use of salt pellets?  
A: A water softener is not needed since the City of State Center has a city-wide R/O system.
2. Q: Please provide clarification on where accent metal finishes are located.  
A: Accent metal panels and trims are anticipated at Chief Office inset window and at overhead door openings- reference elevations 2 &3/A2.1 and details 8/A5.2 & 5/A5.3.

End of Architectural Addendum

**SUBSTITUTION REQUEST FORM**

We hereby submit for your review & consideration the following product in lieu of the specified item for the following project:

**PROJECT TITLE:** State Center Fire Department – Renovation & Addition – Redesign

<u>SPECIFICATION</u>	<u>SECTION</u>	<u>TITLE</u>	<u>PARAGRAPH</u>	<u>ITEM</u>
	<i>133400</i>	<i>MLP</i>	<i>D</i>	<i>Wall liner</i>
<u>DRAWING</u>	<u>NUMBER</u>	<u>TITLE</u>	<u>ITEM</u>	
		<b>PBD</b>		
Proposed Substitution:	<i>29 gauge Euro panel For wall liner</i>			

Complete the attached information on changes to the Specifications and/or Drawings for the proposed substitution. Provide additional information for any changes required for proper installation of the proposed substitution.

Submit, as requested, all necessary samples and backup information to prove equal quality and performance to that which is specified. Clearly mark manufacturer's literature to indicate equality in performance. Failure to do so will result in a returned, non-reviewed substitution request form.

Substitutions of the materials and equipment described in the Bid Documents will be considered during the bidding period only. Substitution requests shall be reviewed and approved by the Design Professional prior to the date set for receipt of bids as described in the front end of the specification.

**CERTIFICATION OF EQUAL PERFORMANCE AND ASSUMPTION OF LIABILITY FOR EQUAL PERFORMANCE**

The undersigned states that the function, appearance, and quality are equivalent or superior to the specified item.

Submitted by: *Jasons Liner*

Signature: *John M* Title: *President*

Organization: *The Liner Building Co. of Jasons*

Address: *1365 Hwy 63 New Sharon ME 04207*

Telephone: *641-637-4035* Email: *jbliner@msn.com* Date: *1/9/26*

Signature shall be by person having authority to legally bind his firm to the above terms. Failure to provide legally binding signature will result in retraction of approval.

For Use by Design Professional:

Approved  X Approved as Noted  
 Not Approved  Received Too Late

Signed by: *Jeff Smith* Date: *09 Jan. 2026*

**SUBSTITUTION REQUEST FORM**

We hereby submit for your review & consideration the following product in lieu of the specified item for the following project:

**PROJECT TITLE: State Center Fire Department – Renovation & Addition – Redesign**

<u>SPECIFICATION</u>	<u>SECTION</u>	<u>TITLE</u>	<u>PARAGRAPH</u>	<u>ITEM</u>
	<i>133400</i>	<i>Prefinished materials 2.5</i>		<i>A, B &amp; C</i>
<u>DRAWING</u>	<u>NUMBER</u>	<u>TITLE</u>	<u>ITEM</u>	

**Proposed Substitution:** *PBR Roof panels & AVP wall panels from American Building Components*

Complete the attached information on changes to the Specifications and/or Drawings for the proposed substitution. Provide additional information for any changes required for proper installation of the proposed substitution.

Submit, as requested, all necessary samples and backup information to prove equal quality and performance to that which is specified. Clearly mark manufacturer's literature to indicate equality in performance. Failure to do so will result in a returned, non-reviewed substitution request form.

Substitutions of the materials and equipment described in the Bid Documents will be considered during the bidding period only. Substitution requests shall be reviewed and approved by the Design Professional prior to the date set for receipt of bids as described in the front end of the specification.

**CERTIFICATION OF EQUAL PERFORMANCE AND ASSUMPTION OF LIABILITY FOR EQUAL PERFORMANCE**

The undersigned states that the function, appearance, and quality are equivalent or superior to the specified item.

Submitted by: *Jason Larue* \_\_\_\_\_.

Signature: *Joe M* \_\_\_\_\_ Title: *President* \_\_\_\_\_.

Organization: *The Larue Building Co of Jason* \_\_\_\_\_.

Address: *1385 Hwy 63 New Sharon Job 58207* \_\_\_\_\_.

Telephone: *641-637-4035* \_\_\_\_\_ Email: *jlarue@pbco.com* Date: *1/9/26* \_\_\_\_\_.

Signature shall be by person having authority to legally bind his firm to the above terms. Failure to provide legally binding signature will result in retraction of approval.

For Use by Design Professional:

\_\_\_\_ Approved       Approved as Noted  
\_\_\_\_ Not Approved      \_\_\_\_\_ Received Too Late

Signed by: *[Signature]* \_\_\_\_\_ Date: *09 Jan. 2026* \_\_\_\_\_.

SUBSTITUTION REQUEST FORM

We hereby submit for your review & consideration the following product in lieu of the specified item for the following project:

PROJECT TITLE: State Center Fire Department – Renovation & Addition – Redesign

<u>SPECIFICATION</u>	<u>SECTION</u>	<u>TITLE</u>	<u>PARAGRAPH</u>	<u>ITEM</u>
	<u>133400</u>	<u>Utility Liner</u>	<u>D page B</u>	<u>Liner for Ceiling</u>
<u>DRAWING</u>	<u>NUMBER</u>	<u>TITLE</u>	<u>ITEM</u>	

Proposed Substitution: Utility R 26 gauge Reverse Roll for Ceiling Liner

Complete the attached information on changes to the Specifications and/or Drawings for the proposed substitution. Provide additional information for any changes required for proper installation of the proposed substitution.

Submit, as requested, all necessary samples and backup information to prove equal quality and performance to that which is specified. Clearly mark manufacturer's literature to indicate equality in performance. Failure to do so will result in a returned, non-reviewed substitution request form.

Substitutions of the materials and equipment described in the Bid Documents will be considered during the bidding period only. Substitution requests shall be reviewed and approved by the Design Professional prior to the date set for receipt of bids as described in the front end of the specification.

CERTIFICATION OF EQUAL PERFORMANCE AND ASSUMPTION OF LIABILITY FOR EQUAL PERFORMANCE

The undersigned states that the function, appearance, and quality are equivalent or superior to the specified item.

Submitted by: Jason L. Rue

Signature: JKR Title: President

Organization: The In-Line Building Co. of Iowa

Address: 1585 Hwy 63 New Sharon IA 50207

Telephone: 641-637-4035 Email: jlarue@linco.com Date: 11/9/26

Signature shall be by person having authority to legally bind his firm to the above terms. Failure to provide legally binding signature will result in retraction of approval.

For Use by Design Professional:

Approved  Approved as Noted  
Not Approved  Received Too Late

Signed by: [Signature] Date: 09 Jan. 2026

# SUBSTITUTION REQUEST

## (During the Bidding/Negotiating Phase)



PROJECT: State Center Fire Department Renovation & Addition

SUBSTITUTION REQUEST NUMBER: na

TO: Chris Wernimont

FROM: James Moland

RE: Automatic Operators

DATE: 1/7/26

A/E PROJECT NUMBER: SCFD-Renovation & Addition

SPECIFICATION TITLE: Door Hardware

DESCRIPTION: Electrohydraulic Door Operators

SECTION: 087100 PAGE: 15 & 16

ARTICLE/PARAGRAPH: 2.13

PROPOSED SUBSTITUTION: Horton HD Swing 4100 LE

MANUFACTURER: Horton Automatics

ADDRESS: 4242 Baldwin Blvd Corpus Christi Tx 78405

PHONE: 800-531-3111

TRADE NAME: Horton HD Swing 4100 LE

MODEL NO.: 4100 LE

Attached data includes product description, specifications, drawings, photographs, and performance and test data adequate for evaluation of the request; applicable portions of the data are clearly identified.  
Attached data also includes a description of changes to the Contract Documents that the proposed substitution will require for its proper installation.

The Undersigned certifies:

- Proposed substitution has been fully investigated and determined to be equal or superior in all respects to specified product.
- Same warranty will be furnished for proposed substitution as for specified product.
- Same maintenance service and source of replacement parts, as applicable, is available.
- Proposed substitution will have no adverse effect on other trades and will not affect or delay progress schedule.
- Proposed substitution does not affect dimensions and functional clearances.
- Payment will be made for changes to building design, including A/E design, detailing, and construction costs caused by the substitution.

SUBMITTED BY: James Moland

SIGNED BY:

FIRM: Basepoint Building Automations

ADDRESS: 6200 Thornton Ave. Suite 190

TELEPHONE: 515-558-9474

### A/E's REVIEW AND RECOMMENDATION:

Approve Substitution—Make submittals in accordance with Specification Section 01 33 00 Submittal Procedures.

Approve Substitution as noted—Make submittals in accordance with Specification Section 01 33 00 Submittal Procedures.

Reject Substitution—Use specified materials.

Substitution Request received too late—Use specified materials.

Door hardware supplier shall provide all necessary components for a complete and operational installation.  
Door hardware installer shall coordinate install with all other door hardware, door & frame mfgs/installers, and with all other trades. Architect shall select hardware finish and accessories from mfg. full line of finishes and accessory offerings.

SIGNED BY:

DATE: 09 Jan. 2026

SUPPORTING DATA ATTACHED:  Drawings  Product Data  Samples  Tests  Reports  \_\_\_\_\_

# SUBSTITUTION REQUEST

## (During the Bidding/Negotiating Phase)



PROJECT: State Center Fire Department Renovation & Addition

SUBSTITUTION REQUEST NUMBER: na

TO: Chris Wernimont

FROM: James Moland

RE: Automatic Operators

DATE: 1/7/26

A/E PROJECT NUMBER: SCFD-Renovation & Addition

SPECIFICATION TITLE: Door Hardware

DESCRIPTION: Electrohydraulic Door Operators

SECTION: 087100

PAGE: 15 & 16

ARTICLE/PARAGRAPH: 2.13

PROPOSED SUBSTITUTION: Stanley Magic Force

MANUFACTURER: Stanley Access Technologies

ADDRESS: 65 Scott Swamp Rd Farmington, Ct 06032

PHONE: 1-800-722-2377

TRADE NAME: Stanley Access Technologies

MODEL NO.: Magic Force

Attached data includes product description, specifications, drawings, photographs, and performance and test data adequate for evaluation of the request; applicable portions of the data are clearly identified.  
Attached data also includes a description of changes to the Contract Documents that the proposed substitution will require for its proper installation.

The Undersigned certifies:

- Proposed substitution has been fully investigated and determined to be equal or superior in all respects to specified product.
- Same warranty will be furnished for proposed substitution as for specified product.
- Same maintenance service and source of replacement parts, as applicable, is available.
- Proposed substitution will have no adverse effect on other trades and will not affect or delay progress schedule.
- Proposed substitution does not affect dimensions and functional clearances.
- Payment will be made for changes to building design, including A/E design, detailing, and construction costs caused by the substitution.

SUBMITTED BY: James Moland  
*James Moland*  
SIGNED BY:  
FIRM: Basepoint Building Automations  
ADDRESS: 6200 Thornton Ave. Suite 190  
TELEPHONE: 515-558-9474

### A/E's REVIEW AND RECOMMENDATION:

Approve Substitution—Make submittals in accordance with Specification Section 01 33 00 Submittal Procedures.

Approve Substitution as noted—Make submittals in accordance with Specification Section 01 33 00 Submittal Procedures.  
Door hardware supplier shall provide all necessary components for a complete and operational installation.  
Door hardware installer shall coordinate install with all other door hardware, door & frame mfgs/installers, and with all other trades. Architect shall select hardware finish and accessories from mfg. full line of finishes and accessory offerings.

Reject Substitution—Use specified materials.

Substitution Request received too late—Use specified materials.

SIGNED BY: *Jeff*

DATE: 09 Jan. 2026

SUPPORTING DATA ATTACHED:  Drawings  Product Data  Samples  Tests  Reports  \_\_\_\_\_



## SCFD – Addendum #2 Changes

- Sheet S001
  - Revised Note S.2 in Concrete and Reinforcement General Notes to indicate drainage fill thickness under floor slab
- Sheet S101
  - No changes
- Sheet S102
  - No changes
- Sheet S201
  - Revised notes and shaded area to more accurately reflect approximate over-excavation locations
- Sheet S501
  - Revised Details 6, 7, & 8 to clarify trench footing construction if unsuitable soils are found. Option of extended footing or using lean concrete through unsuitable soils down to suitable soils are given. This is also found in the geotechnical report.
- Sheet S502
  - No changes

SPECIAL INSPECTION SCHEDULE: CONCRETE CONSTRUCTION			
INSPECTION TASK	REQUIRED	FREQUENCY	
		CONTINUOUS	PERIODIC
INSPECT REINFORCEMENT, INCLUDING PRESTRESSING TENDONS, AND VERIFICATION PLACE	X	-	X
REINFORCING BAR WELDING			
1. VERIFY WELDABILITY OF REINFORCING BARS OTHER THAN ASTM A706	X	-	X
2. INSPECT SINGLE-PASS FILLET WELDS, MAXIMUM 5/16"	X	-	X
3. INSPECT ALL OTHER WELDS	X	X	-
INSPECT ANCHORS CAST IN CONCRETE	X	-	X
INSPECT ANCHORS POST-INSTALLED IN HARDENED CONCRETE MEMBER			
1. CONCRETE <ul style="list-style-type: none"> <li>a. MIX DESIGNS WITH TESTING DATA</li> <li>b. REINFORCEMENT SIZE AND PLACEMENT</li> </ul>	X	X	-
2. MASONRY <ul style="list-style-type: none"> <li>a. GROUT AND MORTAR MIX DESIGNS</li> <li>b. UNIT MATERIAL PROPERTIES (COMPRESSIVE STRENGTH, ETC)</li> <li>c. UNIT LAYOUT</li> <li>d. REINFORCEMENT SIZE AND PLACEMENT</li> <li>e. BOND BEAM LINTEL DETAILS</li> </ul>			
3. COLD FORMED FRAMING <ul style="list-style-type: none"> <li>a. PRODUCT DATA DETAILS</li> </ul>			
PRIOR TO CONCRETE PLACEMENT, FABRICATE SPECIMENS FOR STRENGTH TESTS, PERFORM SLUMP AND AIR CONTENT TESTS, AND DETERMINE THE TEMPERATURE OF THE CONCRETE	X	X	-
INSPECT CONCRETE AND SHOTCRETE PLACEMENT FOR PROPER APPLICATION TECHNIQUES	X	X	-
VERIFY MAINTENANCE OF SPECIFIED CURING TEMPERATURE AND TECHNIQUES	X	-	X
INSPECT PRESTRESSED CONCRETE FOR <ul style="list-style-type: none"> <li>1. APPLICATION OF PRESTRESSING FORCES</li> <li>2. GROUTING OF BONDED PRESTRESSING TENDONS</li> </ul>	X	X	-
INSPECT ERECTION OF PRECAST CONCRETE MEMBERS	X	-	X
VERIFY IN-SITU CONCRETE STRENGTH, PRIOR TO STRESSING OF TENDONS AND POST-TENSIONED CONCRETE AND PRIOR TO REMOVAL OF SHORES AND FORMS FROM BEAMS AND STRUCTURAL SLABS	X	-	X
INSPECT FORMWORK FOR SHAPE, LOCATION AND DIMENSIONS OF THE CONCRETE MEMBER BEING FORMED	X	-	X

SPECIAL INSPECTION SCHEDULE: COLD FORMED METAL FRAMING			
INSPECTION TASK	REQUIRED	FREQUENCY	
		CONTINUOUS	PERIODIC
INSPECT MATERIAL GRADE AND THICKNESS	X	-	X
INSPECT FRAMING AND DETAILS	X	-	X
1. FRAMING LAYOUT, MEMBER SIZES AND BEARING LENGTHS	X	-	X
2. BLOCKING, BRIDGING AND WEB STIFFENERS	X	-	X
3. HOLES	X	-	X
INSPECT CONNECTIONS			
1. BOLTED AND SCREWED CONNECTIONS, INCLUDING DIAMETER, LENGTH, SPACING AND EDGE DISTANCE	X	-	X
2. WELDED CONNECTIONS	X	-	X
3. PROPRIETARY HANGERS AND FRAMING ANCHORS, INCLUDING FASTENER SIZES AND QUANTITIES	X	-	X
4. TIE-DOWN ANCHORS, INCLUDING ANCHOR ROD SIZES AND FASTENER SIZES AND QUANTITIES	X	-	X
INSPECT SHEAR WALLS AND DIAPHRAGMS			
1. PANEL GRADE AND THICKNESS	X	-	X
2. STEEL STRAPPING SIZE, GRADE AND THICKNESS	X	-	X
3. FASTENER SIZE, LENGTH AND SPACING	X	-	X
4. FRAMING MEMBER SIZES AT PANEL EDGES	X	-	X
5. BLOCKING AT PANEL EDGES	X	-	X
INSPECT COLD FORMED METAL TRUSSES			
1. TEMPORARY INSTALLATION RESTRAINT/BRACING FOR TRUSSES SPANNING 60 FEET OR MORE	X	-	X
2. PERMANENT INDIVIDUAL TRUSS MEMBER RESTRAINT/BRACING FOR TRUSSES SPANNING 30 FEET OR MORE	X	-	X

SPECIAL INSPECTION SCHEDULE: CIP FOUNDATION ELEMENTS			
INSPECTION TASK	REQUIRED	FREQUENCY	
		CONTINUOUS	PERIODIC
ISOLATED SPREAD CONCRETE FOOTINGS	X	-	X
CONTINUOUS CONCRETE FOOTINGS SUPPORTING WALLS	X	-	X
CONCRETE FOUNDATION WALLS	X	-	X

**CONCRETE AND REINFORCEMENT:**

- A. CONCRETE SHALL CONFORM TO CHAPTER 19 OF THE IBC AND BE PLACED IN ACCORDANCE WITH BUILDING CODE REQUIREMENTS FOR STRUCTURAL CONCRETE (ACI 318) AND "SPECIFICATIONS FOR STRUCTURAL CONCRETE FOR BUILDINGS (ACI 301)" U.N.O.
- B. MINIMUM 28 DAY COMPRESSIVE STRENGTH (fc):
  - 1. FOOTINGS: 3,500 psi
  - 2. FOUNDATION WALLS: 4,000 psi
  - 3. ALL OTHER CONCRETE: 4,000 psi
- C. MAXIMUM WATER/CEMENT RATIO FOR GIVEN fc:
  - 1. 3,500 psi: 0.50
  - 2. 4,000 psi: 0.45
  - 3. 5,000 psi: 0.40
- D. CONCRETE SLUMP:
  - 1. WITHOUT WATER REDUCER: 3"-5"
  - 2. WITH WATER REDUCER: 6"-8"
- E. AIR CONTENT:
  - 1. EXPOSED TO EARTH OR WEATHER: 6% PLUS OR MINUS 1.5%
  - 2. ALL OTHER CONCRETE: NATURAL
- F. MATERIAL REQUIREMENTS:
  - 1. PORTLAND CEMENT: ASTM C595, TYPE I
  - 2. NORMAL WEIGHT AGGREGATES: ASTM C33
  - 3. MAXIMUM AGGREGATE SIZE: 1"
  - 4. PORTLAND CEMENT: ASTM C44
  - 5. DEFORMED BARS: ASTM A615, GRADE 60
  - 6. WELDED DEFORMED BARS: ASTM A708, GRADE 60
  - 7. WELDED WIRE FABRIC (MATS ONLY): ASTM A185
- G. CONCRETE COVER OVER REINFORCING:
  - 1. CAST AGAINST AND PERMANENTLY EXPOSED TO EARTH: 3"
  - 2. EXPOSED TO EARTH OR WEATHER: 2"
  - 3. NOT EXPOSED TO EARTH OR WEATHER OR IN CONTACT WITH THE GROUND: 2"
- H. FLY ASH SHALL NOT EXCEED 15% OF ALL CEMENTIMENTOUS MATERIALS FOR ALL CONCRETE.
- I. ALL ADMIXTURES TO BE INCLUDED IN THE CONCRETE MIX DESIGN SUBMITTAL FOR REVIEW/APPROVAL, NO ADMIXTURES TO BE USED WITHOUT APPROVAL BY STRUCTURAL ENGINEER.
- J. NO ADDITIVES OR MATERIALS CONTAINING CALCIUM CHLORIDE, SALT OR ANTIFREEZE IS PERMITTED TO BE USED IN CONCRETE.
- K. DETAIL AND PLACE REINFORCING STEEL IN ACCORDANCE WITH "DETAILS AND DETAILED OF CONCRETE REINFORCEMENT" (ACI 318) U.N.O.
- L. REINFORCING STEEL SHALL BE SECURED IN PLACE AND PROPERLY SUPPORTED PRIOR TO PLACING CONCRETE.
- M. REINFORCING SPLICES SHALL HAVE CLASS B TENSION SPLICES U.N.O.
- N. CORNER BARS TO BE PROVIDED AT ALL INTERSECTIONS OF HORIZONTAL REINFORCING IN WALLS AND FOOTINGS. LAP CORNER BARS 2'-0" EACH SIDE, MATCH SIZE AND SPACING OF SPACING OF HORIZONTAL BARS.
- O. VERTICAL REINFORCING TO BE CONTINUOUS WITHOUT SPLICES, U.N.O.
- P. HORIZONTAL REINFORCING TO BE CONTINUOUS THROUGH PILASTERS, COLUMNS, AND WALL INTERFACINGS.
- Q. PROVIDE 2 1/8" #5 X 1/8" DIAGONAL BARS AT EACH OPENING CORNER IN WALLS AND FLOOR SLABS U.N.O. DIAGONAL BARS SHALL BE CENTERED AT OPENING CORNERS.
- R. ALL EXPOSED EDGES TO HAVE A 3/4" CHAMFER, U.N.O.
- S. SLABS-ON-GRADE:
  - 1. POORLY COMPACTED FILL SOILS THAT REQUIRE FULL OVER EXCAVATION AND BACKFILL ARE KNOWN TO BE IN THE AREA. EXISTING SITE SOILS ARE NOT SUITABLE FOR BACKFILL. THE AREA NEAR THE SW CORNER OF THE ADDITION, BORING #1 IN THE GEOTECHNICAL REPORT, IS WHERE THESE SOILS WERE FOUND. EXTENTS ON THE SITE ARE UNKNOWN, BUT ARE TO BE DETERMINED DURING SPECIAL INSPECTIONS. CONTRACTOR TO PROVIDE COST ON A PER-UNIT BASIS DURING BIDDING.
  - 2. NEW IMPORTED BACKFILL TO BE COMPACTED IN LOOSE LIFTS WHERE LARGE CONSTRUCTION EQUIPMENT IS USED, AND 4"-LOOSE LIFTS WHERE MANUAL EQUIPMENT IS USED.
  - 3. NEW SLAB CONSTRUCTION SHALL BE 6" THICK OVER VAPOR BARRIER (SEE ARCHITECT) OVER 4' MIN. GRANULAR DRAINAGE FILL OVER NEW COMPACTED BACKFILL. SLAB SHALL BE REINFORCED WITH #4 @ 18" O.C. PLACED ON CHAIRS TO LOCATE THE REINFORCEMENT 1 1/2" FROM THE TOP OF SLAB. LOCATED AT MID-SLAB THICKNESS AT CONSTRUCTION JOINTS.
  - 4. TOPPING SLAB OVER EXISTING SLAB ON GRADE SHALL BE 4" THICK OVER BOND BREAKER. SLAB SHALL BE REINFORCED WITH 6xW2.9xW2.9 WWF PLACED ON CHAIRS TO LOCATE THE REINFORCEMENT 1 1/2" AWAY FROM THE TOP OF SLAB. LOCATED AT MID-SLAB THICKNESS AT CONSTRUCTION JOINTS.
  - 5. WET BACKFILL CURE IS STRONGLY RECOMMENDED FOR ALL SLABS ON GRADE AND NEW CONCRETE TOPPING SLAB. ALTERNATES MAY BE PROVIDED BY THE CONTRACTOR.
  - 6. PROVIDE 1/2" EXPANSION JOINT BETWEEN SLABS-ON-GRADE AND ALL COLUMNS, WALLS, AND VERTICAL SURFACES.
  - 7. PROVIDE 1/8" X 1/4" DEEP CONTROL JOINTS OR FULL DEPTH CONSTRUCTION JOINTS IN SLABS-ON-GRADE. MAXIMUM SPACING IN OF CONTROL/CONSTRUCTION JOINTS TO BE 30 TIMES THE SLAB THICKNESS.
  - 8. CONSTRUCTION JOINTS IN SLABS-ON-GRADE SHALL BE AT CONTROL JOINT LOCATIONS AS IDENTIFIED ABOVE WHEN ENTIRE FLOOR SLAB IS NOT PLACED IN ONE SEQUENCE. SEE DETAILS FOR PLATE DOWEL REQUIREMENTS.
  - 9. SEE ARCHITECTURAL DRAWINGS FOR SLAB SLOPES AND DEPRESSIONS.
  - 10. USE IMPORTED SAND FOR EXPOSED SLAB ON GRADE AND FOUNDATION WALLS.
- T. FLOOR PLATES:
  - 1. GENERAL: (OFFICE) (CARPET):
    - A. OVERALL FF-25
    - B. OVERALL FL-20
    - C. LOCAL FF-35
    - D. LOCAL FL-20
- PRE-ENGINEERED BUILDING:
  - A. PRE-ENGINEERED BUILDINGS (PEB) SHALL CONFORM TO CHAPTER 22 OF THE IBC AND APPLICABLE BUILDING SYSTEMS MANUAL.
  - B. PEB FRAMING MATERIALS AND STRENGTHS:
    - 1. BY PEB MANUFACTURER.
  - C. CONNECTIONS SHALL BE AS DIRECTED IN PEB DOCUMENTS.
  - D. TEMPORARY BRACING OF STRUCTURAL ELEMENTS IS THE RESPONSIBILITY OF THE CONTRACTOR. STRUCTURAL STABILITY SHALL BE MAINTAINED AT ALL TIMES DURING THE ERECTION PROCESS. CONSTRUCTION SHALL CONFORM TO OSHA GUIDELINES.
  - E. NOTIFY SUPPLIER AND ENGINEER OF ANY FABRICATION OR ERECTION ERRORS OR DEVIATIONS. WRITTEN APPROVAL IS REQUIRED BEFORE ANY FIELD CORRECTIONS ARE MADE.
  - F. PROVIDE ONE SHOT COAT OF PRIMER ON ALL STEEL EXCEPT FOR ITEMS TO BE HOT-DIP GALVANIZED OR SPRAY FIREPROOFED.
  - G. DIMENSIONS, BUILDING SIZE, COLUMN LOCATIONS, AND WALL SIZE TO MATCH AND BE COORDINATED WITH ARCHITECTURAL AND STRUCTURAL DRAWINGS. DEVIATION REQUESTS MUST BE SUBMITTED FOR APPROVAL PRIOR TO CHANGES BEING MADE.
  - H. ALL COMPONENTS AND ASSEMBLIES TO BE DESIGNED AND DETAILED BY THE MANUFACTURER TO RESIST THE LOADING ON THE DRAWINGS. NOTE THAT SOME MUNICIPALITIES DEVIATE SNOW AND OTHER LOADING FROM THE IBC AND SHALL BE INCLUDED IN THE DESIGN.
  - I. MAXIMUM ALLOWABLE DEFLECTION LIMITS:
    - 1. ARCHITECTURE:
      - a. ROOF PLATES: SPAN / 240
      - b. ROOF PANELS: SPAN / 180
      - c. WALL FRAMING: SPAN / 240
      - d. WALL FRAMING WITH BRICK: SPAN / 600
      - e. RIGID FRAME DRIFT: HEIGHT / 400
    - J. MEMBERS SUPPORTING BRICK AND OTHER BRITTLE CLADDING SHALL BE DESIGNED FOR HORIZONTAL AND VERTICAL DEFLECTION: SPAN / 600.
    - K. DEFLECTION OF PRIMARY MEMBERS SHALL BE ACCOMMODATED WITHIN DESIGN OF OTHER FRAMING COMPONENTS AND SYSTEMS.
    - L. ADJACENT BUILDING IS PRESENT:
      - 1. YES. A BUILDING EXPANSION JOINT IS REQUIRED BETWEEN THE BUILDING TO ACCOUNT FOR 2" OF BUILDING DIFFERENTIAL MOVEMENT UNLESS PEB SUPPLIER ENGINEER DESIGNS THE BUILDINGS TO CONNECT, ACT, AND MOVE CONGRUENTLY.

**COLD FORMED METAL FRAMING (CFMF)**

- A. COLD FORMED METAL FRAMING SHALL CONFORM TO CHAPTER 22 OF THE IBC.
- B. ALL COLD FORMED METAL FRAMING SHALL BE FABRICATED AND ERECTED IN ACCORDANCE WITH MANUFACTURER'S RECOMMENDATIONS AND IN ACCORDANCE WITH THE LATEST EDITION OF THE NORTH AMERICAN SPECIFICATIONS FOR THE DESIGN OF COLD-FORMED STEEL STRUCTURAL MEMBERS BY AISI.
- C. THESE STRUCTURAL DRAWINGS TYPICALLY SHOW ONLY THE PRIMARY STRUCTURAL FRAMING ELEMENTS OF THE SYSTEM. CONTRACTOR SHALL PROVIDE ALL ACCESSORIES INCLUDING TRACKS, WEB STIFFENERS, BLOCKING, HEADERS, CLIP ANGLES, REINFORCEMENTS, FASTENING DEVICES, BRACING, AND OTHER ACCESSORIES AS RECOMMENDED BY THE MANUFACTURER TO PROVIDE A COMPLETE FRAMING SYSTEM.
- F. THE COLD FORMED METAL STUD FRAMING CONTRACTOR IS RESPONSIBLE FOR THE DESIGN OF COLD FORMED METAL FRAMING AS INDICATED IN THE SUBMITTALS SECTION OF THE GENERAL CONTRACTOR'S DRAWINGS. CONTRACTOR SHALL PROVIDE ALL ACCESSORIES LISTED, SHOT BLAST DRAWINGS SHOWING ELEVATIONS, ETC. AND DETAILS AS DETERMINED BY THE CONTRACTOR. CONTRACTOR SHALL PROVIDE ALL ACCESSORIES LISTED, SHOT BLAST DRAWINGS SHOWING ELEVATIONS, ETC. AND DETAILS AS DETERMINED BY THE CONTRACTOR.
- G. FASTENING OF COMPONENTS SHALL BE WITH SELF-TAPPING SCREWS OR WELDS. ALL WELDS OF GALVANIZED FRAMING SHALL BE TOUCHED UP WITH ZINC-RICH PAINT. ALL WELDS OF CARBON SHEET STEEL SHALL BE TOUCHED UP WITH RUST INHIBITIVE PAINT.
- H. SCREWS WHICH ARE REMOVED SHALL BE REPLACED BY A SCREW OF A LIGHTER DIAMETER WHERE THE REPLACEMENT IS MADE INTO AN EXISTING HOLE. REPLACE ALL SCREWS WHICH STRIP OUT MATERIAL. SCREWS SHALL BE SPACED NO CLOSER THAN 5/8" ON CENTER AND WITH A MINIMUM FREE EDGE DISTANCE OF 1/2".
- I. ALL WELDING SHALL BE PERFORMED BY WELDERS EXPERIENCED IN COLD-FORMED METAL FRAMING WORK. ALL WELDING SHALL USE E60 SERIES ELECTRODES AND SHALL BE PERFORMED IN ACCORDANCE WITH THE AMERICAN WELDING SOCIETY STANDARDS.
- J. DO NOT CUT OR OTHERWISE DAMAGE LOAD-BEARING STUDS, JOISTS, OR RAFTERS DURING INSTALLATION OF WORK BY OTHER TRADES.
- K. EXTERIOR WALL STUDS:
  - 1. THE MINIMUM SIZE AND SPACING SHALL BE AS INDICATED IN THE PLANS.
  - 2. ALL STUDS SHALL BE SECURELY SEALED FOR FULL BEARING ON TOP AND BOTTOM TRACK. PROVIDE DOUBLE STUDS AT ALL JAMBS, CORNERS, INTERSECTIONS, AND BEAM BEARING LOCATIONS, UNLESS NOTED OTHERWISE.
  - 3. WALL STUD BRIDGING AS RECOMMENDED BY THE STUD MANUFACTURERS SHALL BE INSTALLED TO PREVENT BOTH WAXIS BENDING AND STUD ROTATION AT 4"-0" MAX INTERVALS. WALLS 8'-0" AND SHORTER SHALL HAVE A SINGLE ROW OF BRIDGING AT MID-HEIGHT. ADDITIONALLY, BRIDGING SHALL BE PROVIDED AT ROOF LINES AND WHERE NOTED ON THE PLANS. SOLID BRIDGING SHALL BE INSTALLED IN LIEU OF BRIDGING WHEN NOT PROVIDED ON DRAWINGS.
  - 4. BRIDGING, FASTBRIDGE CLIPS FB43 WITH #2 @ #10 SCREWS PER CLIP, UNO, OR UNLESS PART OF DEFERRED SUBMITTAL.
  - 5. WALL STUDS SHALL BE LIMITED IN DEFLECTION TO:
    - a. WALLS WITH BRICK: HEIGHT/600
    - b. WALLS WITH STUCCO: HEIGHT/360
    - c. OTHER WALLS: HEIGHT/240
  - 6. WALL STUDS SHALL ALIGN WITH FLOOR AND ROOF FRAMING MEMBERS IN LOAD-BEARING STUD APPLICATIONS.
- L. JOISTS AND RAFTERS:
  - 1. THE MINIMUM SIZE AND SPACING SHALL BE AS INDICATED IN THE PLANS.
  - 2. JOISTS SHALL BE REINFORCED WITH WEB STIFFENERS AT ALL LOAD-BEARING JOISTS.
  - 3. JOIST FLANGES MUST BE FASTENED TO ALL SUPPORTS.
  - 4. STRAPPING OR FULL-HEIGHT BLOCKING SHALL BE LOCATED AT 8'-0" ON CENTER MAXIMUM WHEN SHEATHING IS APPLIED ONLY TO THE COMPRESSION FLANGE. IF STRAPPING IS USED, FULL-HEIGHT BLOCKING BETWEEN JOISTS AT 10'-0" ON CENTER IS REQUIRED ALONG THE LENGTH OF THE STRAPPING.
  - 5. FLOOR JOISTS SHALL BE LIMITED IN DEFLECTION TO:
    - a. TOTAL LOAD: SPAN/240
    - b. LIVE LOAD: SPAN/480
    - c. LIVE LOAD: SPAN/360
- M. BUILT-UP MEMBERS (MULTIPLE MEMBERS) MUST BE FASTENED TOGETHER TO ACT AS ONE UNIT TO RESIST THE APPLIED LOADING. THIS IS TO BE DESIGNED BY THE COMPONENT DESIGNER, UNLESS DETAILED OTHERWISE ON THE DRAWINGS.

**FOUNDATIONS:**


- A. EXCAVATIONS OF BURIED ITEMS, KNOWN OR UNKNOWN PRIOR TO CONSTRUCTION, SHALL BE PAOILLED WITH ENGINEERED FILL IN COMPACTED LOOSE LIFTS OF 12" OR LESS, OR AS GUIDED BY THE GEOTECHNICAL ENGINEER.
- B. FOUNDATIONS SHALL BEAR ON NATIVE SOIL OR ON COMPACTED ENGINEERED FILL. BEARING CAPACITY AND EXPANSIVE SOIL PROPERTIES TO BE VERIFIED BY QUALIFIED GEOTECHNICAL ENGINEER AS PART OF THE SPECIAL INSPECTION AND TESTING PROGRAM PRIOR TO INSTALLATION OF FOOTINGS/FOUNDATIONS.
- C. EXPANSIVE SOILS THAT REQUIRE OVER EXCAVATION AND BACKFILL ARE KNOWN TO BE IN THE AREA. REQUIRED DEPTH OF OVER EXCAVATION AND ENGINEERED FILL REQUIREMENTS TO BE DETERMINED BY GEOTECHNICAL ENGINEER AS PART OF THE SPECIAL INSPECTION AND TESTING PROGRAM.
- D. ALL EXTERIOR FOOTINGS TO EXTEND BELOW FROST LINE. SEE DESIGN REQUIREMENTS FOR FROST LINE. PROVIDE 12" OF EXCAVATION FOR CONCRETE FOUNDATION AND 12" BELOW FROST LINE. CONTACT STRUCTURAL ENGINEER FOR REVISED REINFORCING.
- E. IF INDICATED ON ARCHITECTURAL DRAWINGS, PROVIDE 2" RIGID INSULATION ON INSIDE FACE OF FOUNDATION WALL/FOOTINGS EXTENDING FROM TOP OF FOUNDATION TO FROST DEPTH, AND EXTENDING FROM INSIDE EDGE OF FOUNDATION TO 24" TOWARD MIDDLE OF THE STRUCTURE BELOW FLOOR SLAB.
- F. FOOTINGS TO BE CENTERED UNDER WALLS/COLUMNS U.N.O.
- G. DO NOT BACKFILL WALLS UNTIL BOTH TOP AND BOTTOM OF WALLS ARE ADEQUATELY BRACED BY SLAB OR FLOOR FRAMING. ANY REQUIRED TEMPORARY BRACING FOR BACKFILLING OF WALLS IS THE RESPONSIBILITY OF THE CONTRACTOR.
- H. COORDINATE ALL CLEANOUTS, CONNECTIONS, AND DISCHARGE OF DRAIN TILE WITH CIVIL AND MECHANICAL DRAWINGS.

**GENERAL:**

- A. THESE DRAWINGS REPRESENT THE COMPLETED PROJECT WHICH HAS BEEN DESIGNED FOR THE LOADS AND MATERIALS INDICATED ON THE DRAWINGS. THE STRUCTURAL ENGINEER HAS ONLY REVIEWED STABILITY OF THE STRUCTURE IN ITS COMPLETED FORM. DETERMINATION OF ALLOWABLE CONSTRUCTION LOADS AND DESIGN OF CONSTRUCTION FALSEWORK, FORMWORK, STAGING, BRACING, SHEETING AND SHORING, ETC. IS SOLELY THE CONTRACTOR'S RESPONSIBILITY.
- B. STRUCTURAL ENGINEER IS NOT RESPONSIBLE FOR THE DESIGN OF SYSTEMS NOT SHOWN ON THE STRUCTURAL DOCUMENTS, INCLUDING BUT NOT LIMITED TO STEEL STAIRS, HANDRAILS, PRE-ENGINEERED WOOD BUILDING, CURTAINWALL/WINDOW WALL SYSTEMS, OR COLD-FORMED METAL FRAMING. SUCH SYSTEMS SHALL BE DESIGNED, FURNISHED, AND INSTALLED BY OTHER STRUCTURAL ENGINEER OF RECORD IS NOT RESPONSIBLE FOR CONNECTIONS. THESE SYSTEMS TO THE CONTRACTOR. THESE SYSTEMS DESIGNERS SHALL CONFORM WITH THE DESIGN INTENT DEPICTED IN THE STRUCTURAL DOCUMENTS. REVIEW OF SHOP DRAWINGS FOR SUCH SYSTEMS BY THE STRUCTURAL ENGINEER OF RECORD SHALL BE FOR GENERAL CONFORMANCE WITH THE PROJECT PARAMETERS AS INDICATED ON THE DRAWINGS AND IN THE STRUCTURAL NOTES.
- C. ALTERNATE PRODUCTS OF SIMILAR STRENGTH, NATURE AND FORM FOR SPECIFIED ITEMS MAY BE SUBMITTED WITH SUPPORTING TECHNICAL DOCUMENTATION, INCLUDING CALCULATIONS AS APPLICABLE, TO THE STRUCTURAL ENGINEER FOR REVIEW.
- ALTERNATES THAT DEVIATE SIGNIFICANTLY FROM THE DESIGN INTENT MAY BE REJECTED.
- ALTERNATES THAT REQUIRE SUBSTANTIAL REVIEW TIME WILL NOT BE REVIEWED UNLESS AUTHORIZED BY THE OWNER.
- D. IF APPLICABLE, EXISTING BUILDING INFORMATION SHOWN IS AS INDICATED ON EXISTING CONDITIONS, DIMENSIONS, AND ELEVATIONS. NOTIFY ARCHITECT AND STRUCTURAL ENGINEER OF ANY DISCREPANCIES PRIOR TO STARTING WORK.
- E. DO NOT CUT/MODIFY ANY BEAMS, COLUMNS, JOISTS, AND SLABS WITHOUT WRITTEN APPROVAL FROM THE STRUCTURAL ENGINEER.
- F. CONTRACTOR HAS SOLE RESPONSIBILITY FOR MEANS AND METHODS, SAFETY, TECHNIQUES, SEQUENCES, AND PROCEDURES OF CONSTRUCTION. CONTRACTOR HAS SOLE RESPONSIBILITY TO COMPLY WITH ALL OSHA REGULATIONS.
- G. DO NOT SCALE DRAWINGS OR MEASURE OBJECTS IN ELECTRONIC FILES TO DETERMINE DIMENSIONS. NOTIFY ARCHITECT/STRUCTURAL ENGINEER OF ANY DISCREPANCIES OR REQUIREMENTS FOR ADDITIONAL DIMENSIONS NOT SHOWN.
- H. WHERE CONFLICTS EXIST BETWEEN STRUCTURAL DOCUMENTS THE STRICTEST
- I. CONTRACTOR SHALL NOTIFY ARCHITECT AND STRUCTURAL ENGINEER OF DISCREPANCIES WITHIN STRUCTURAL DOCUMENTS AND BETWEEN DISCIPLINES OF THE DESIGN TEAM.
- J. STRUCTURE/F ENGINEERING DOES NOT PROVIDE ANY WARRANTY, EXPRESSED OR IMPLIED. FOR CAD OR BIM FILES PROVIDED TO THE CONTRACTOR NOR ANY GUARANTEE OF THE ACCURACY OF INFORMATION FURNISHED VIA ELECTRONIC FORM. IN ALL CASES, THE HARD COPY OF THE STRUCTURAL CONTRACT DOCUMENTS SUPERSEDES ANY AND ALL CAD OR BIM FILES.

**GENERAL NOTES:**

1. THESE DRAWINGS ARE AN INSTRUMENT OF CONTRACT AND SHALL NOT BE REPRODUCED OR COPIED EXCEPT AS PERMITTED BY THE CONTRACT. NEITHER PROJECT PLANS NOR DRAWINGS MAY BE COPIED, REPRODUCED, OR OTHERWISE USED IN WHOLE OR IN PART, OR OTHERWISE ALTERED, OR OTHERWISE MODIFIED, OR OTHERWISE ADAPTED, OR OTHERWISE USED IN WHOLE OR IN PART, OR OTHERWISE ALTERED, OR OTHERWISE MODIFIED, OR OTHERWISE ADAPTED, OR OTHERWISE USED IN WHOLE OR IN PART, OR OTHERWISE ALTERED, OR OTHERWISE MODIFIED, OR OTHERWISE ADAPTED, OR OTHERWISE USED IN WHOLE OR IN PART, OR OTHERWISE ALTERED, OR OTHERWISE MODIFIED, OR OTHERWISE ADAPTED

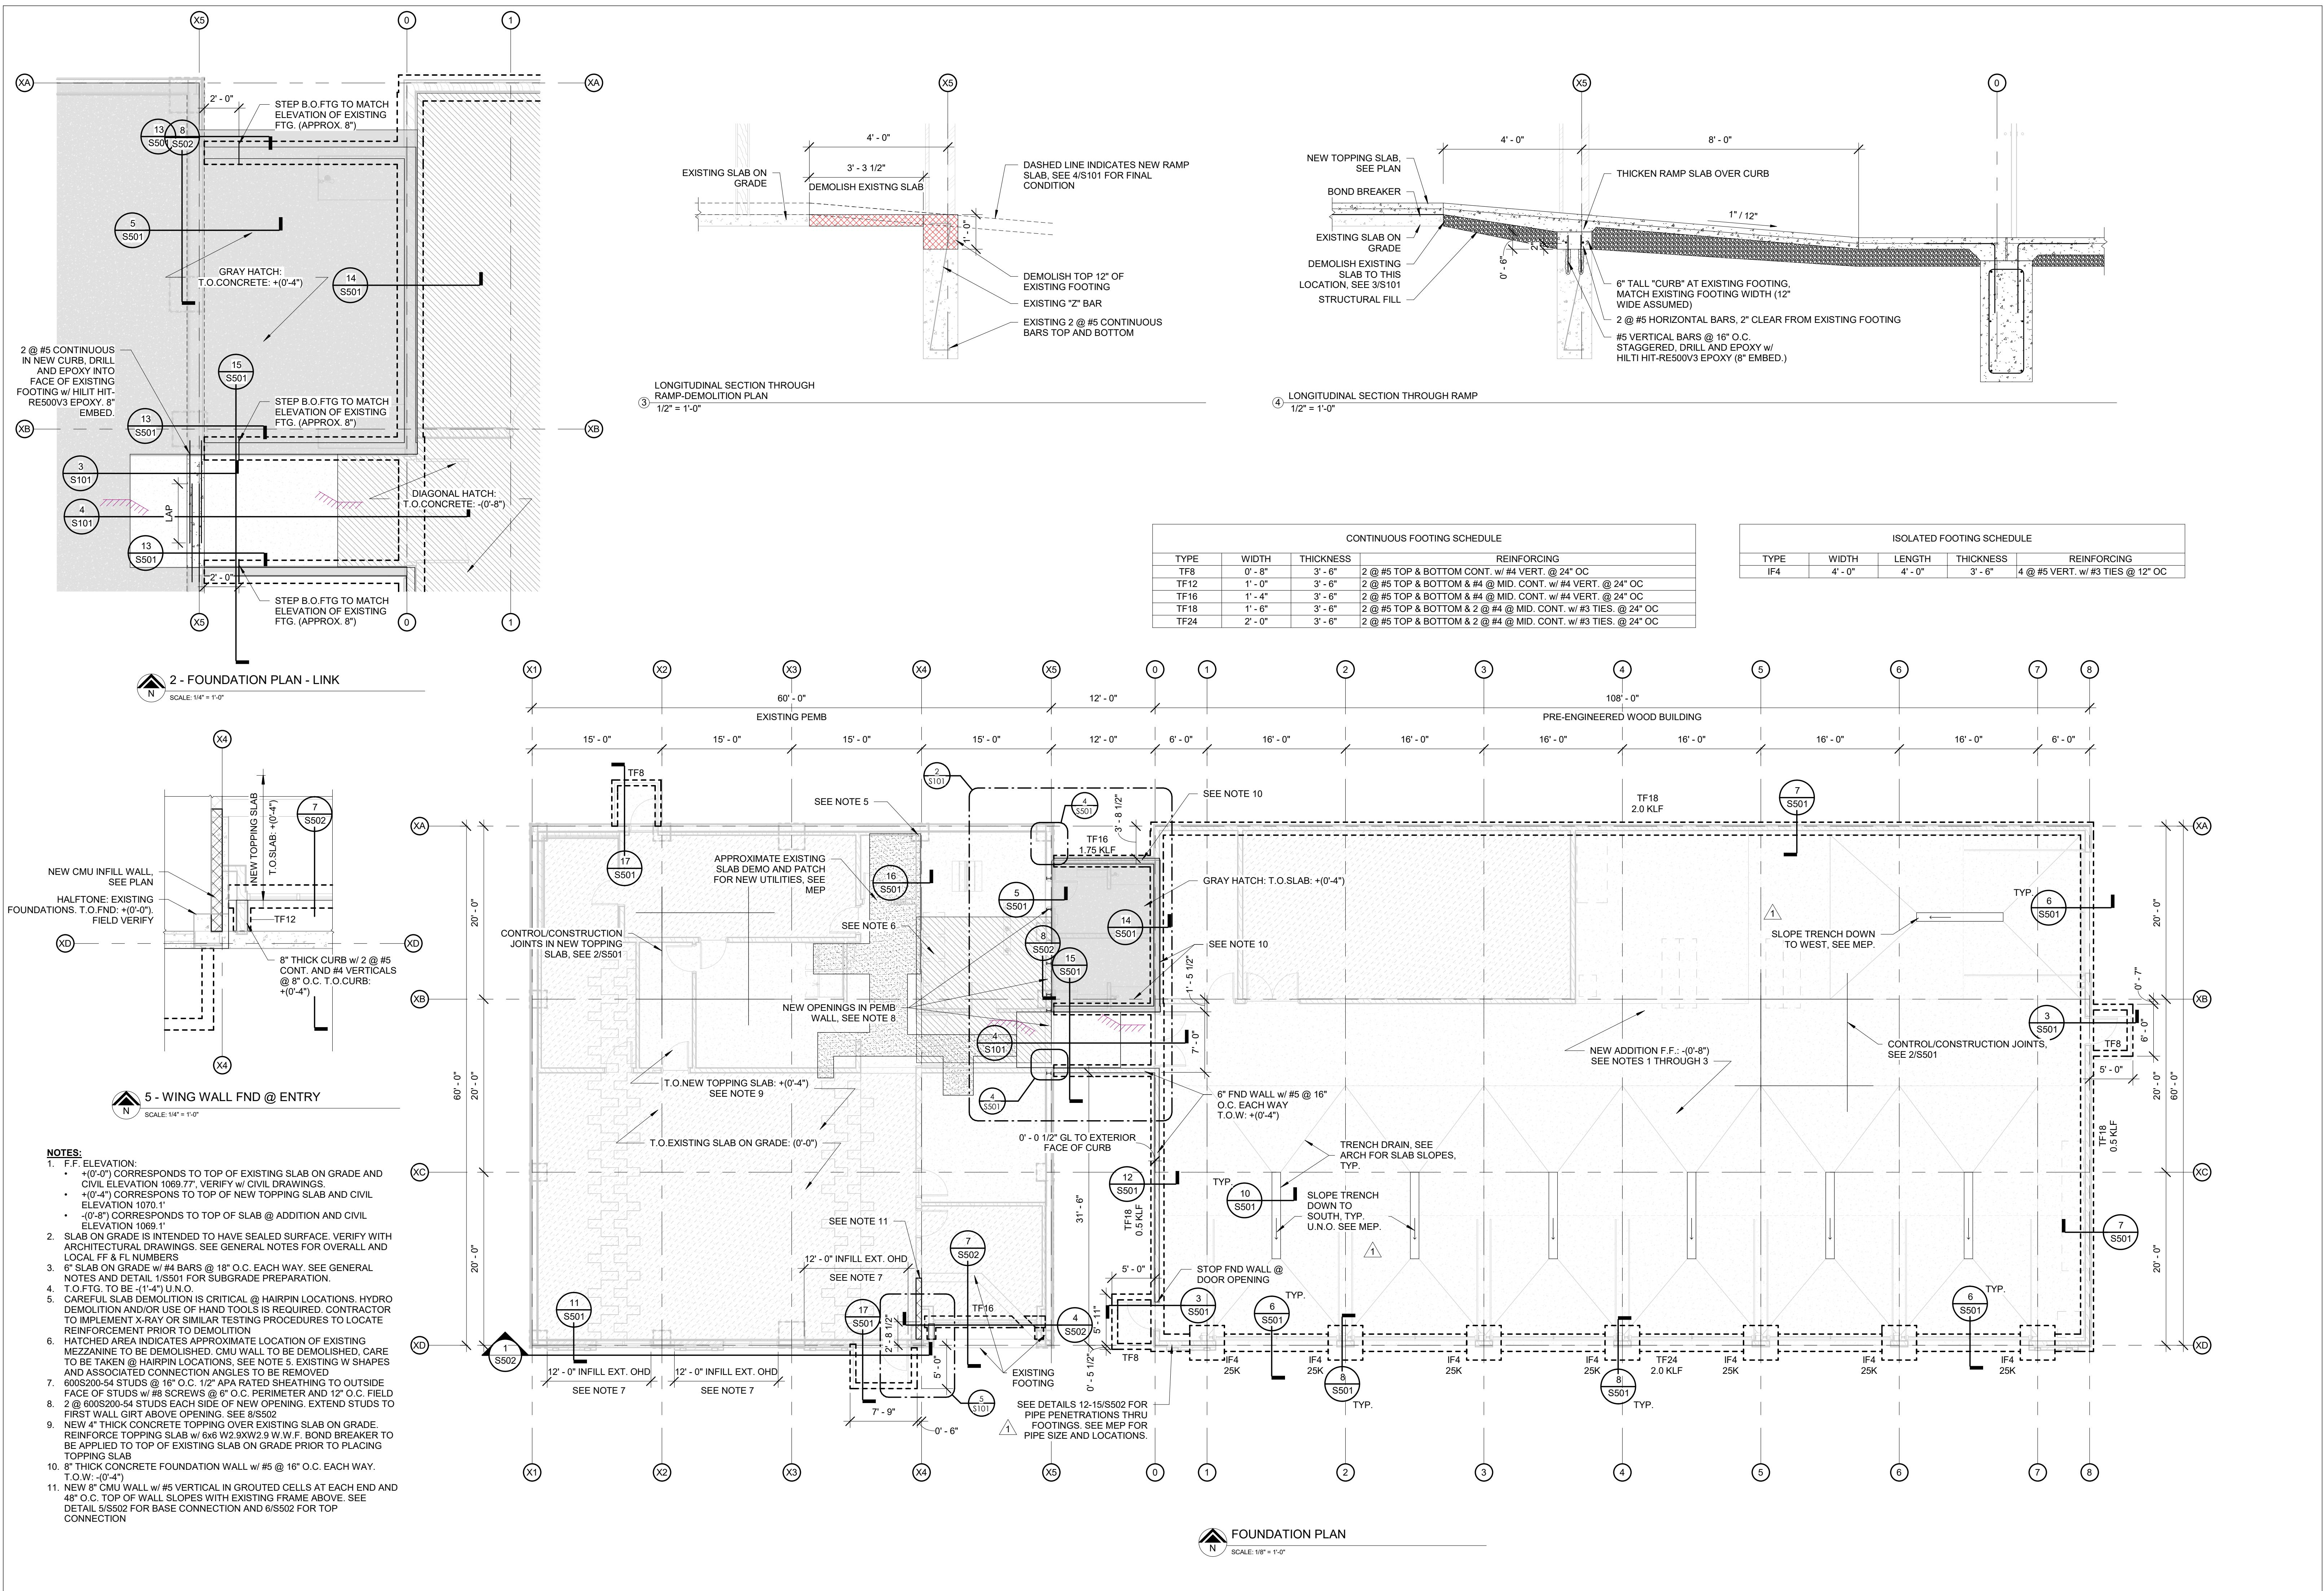

CFMF BOX HEADER SCHEDULE			
MARK	VERTICAL MEMBERS	HORIZONTAL MEMBERS	JAMB
H1	2 @ 800S162-54	2 @ 600T200-54	2 @ 600S162-54 (KING STUDS)

LINTEL SCHEDULE	
MARK	SIZE
L1	2 @ L3 1/2x3 1/2x5/16

WOOD HEADER SCHEDULE	
MARK	SIZE
WH1	3 @ 11 7/8" LVL

CFMF BOX HEADER NOTES


1. HEADERS ARE FOR THE WALL FRAMING BELOW THE LEVEL SHOWN
2. EACH MEMBER OF MULTI MEMBER HEADERS/JAMBS TO BE FASTENED TOGETHER WITH 2 @ #12 SCREWS @ 12" O.C. U.N.O.


LINTEL NOTES


1. LINTELS ARE FOR THE WALL FRAMING BELOW THE LEVEL SHOWN
2. LINTELS TO BEAR A MINIMUM OF 1" PER FOOT OF OPENING LENGTH OR 6", EACH END
3. SEE GENERAL NOTES FOR LINTEL NOT CALLED OUT ON PLAN


WOOD HEADER NOTES

1. HEADERS ARE FOR WALL FRAMING BELOW THE LEVEL SHOWN
2. ALL HEADERS TO BE SUPPORTED BY A MINIMUM OF (3) STUDS U.N.O. (1 KING, 2 JACK)
3. ALL MULTI-PLY FLUSH (F) HEADERS TO BE FASTENED TOGETHER w/ 3 ROWS OF SIMPSON SDW2250 SCREWS @ 12" O.C. U.N.O.

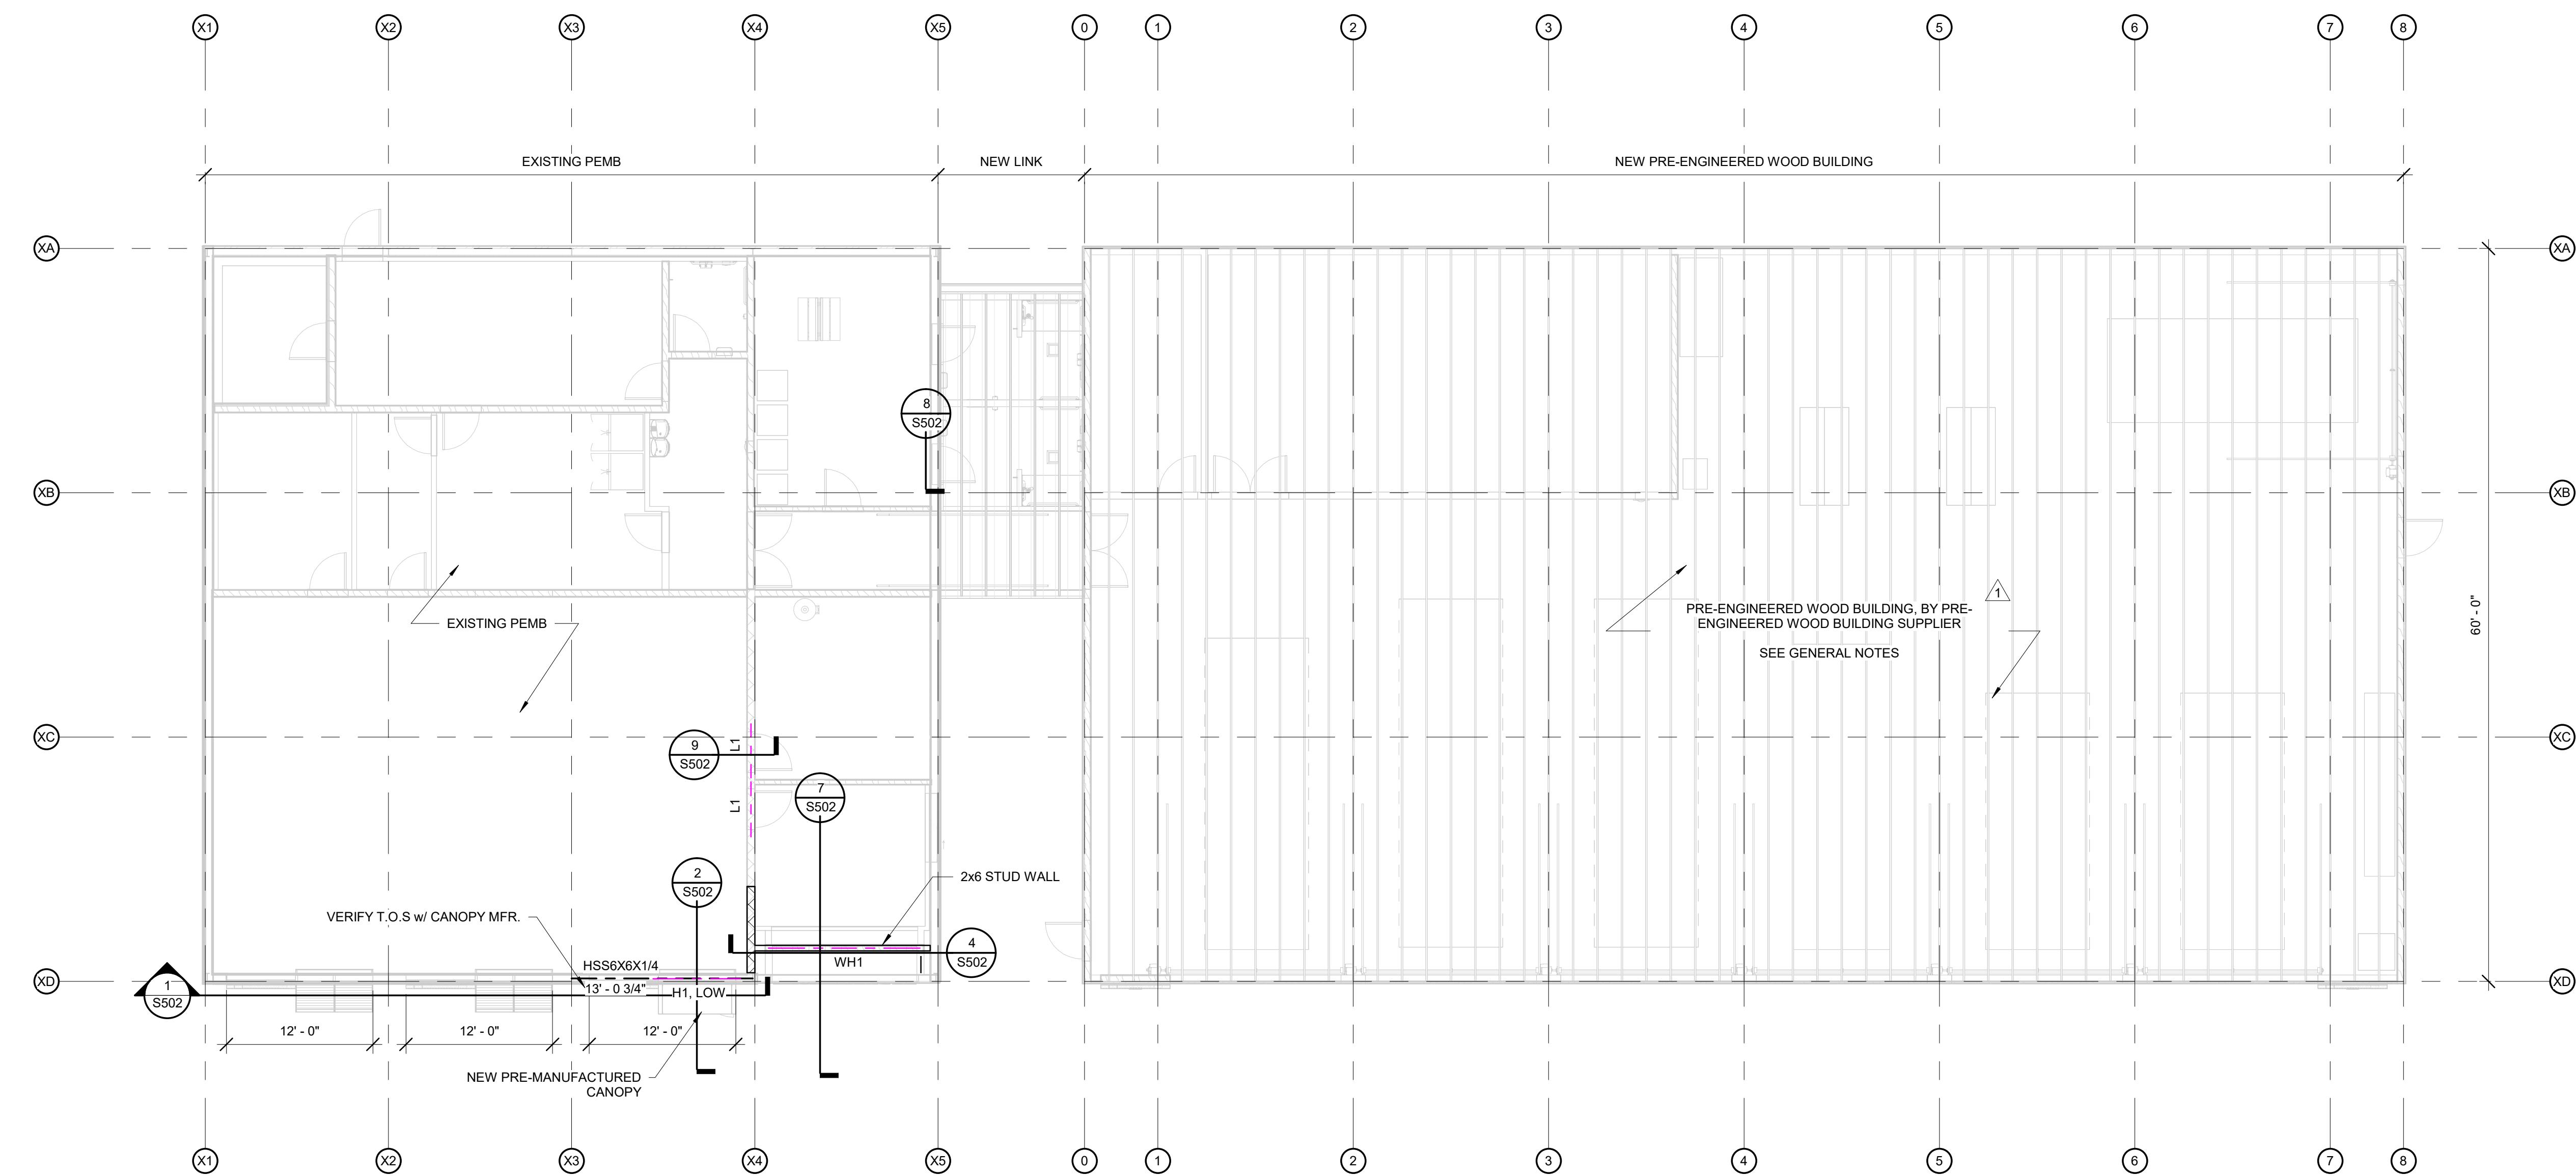

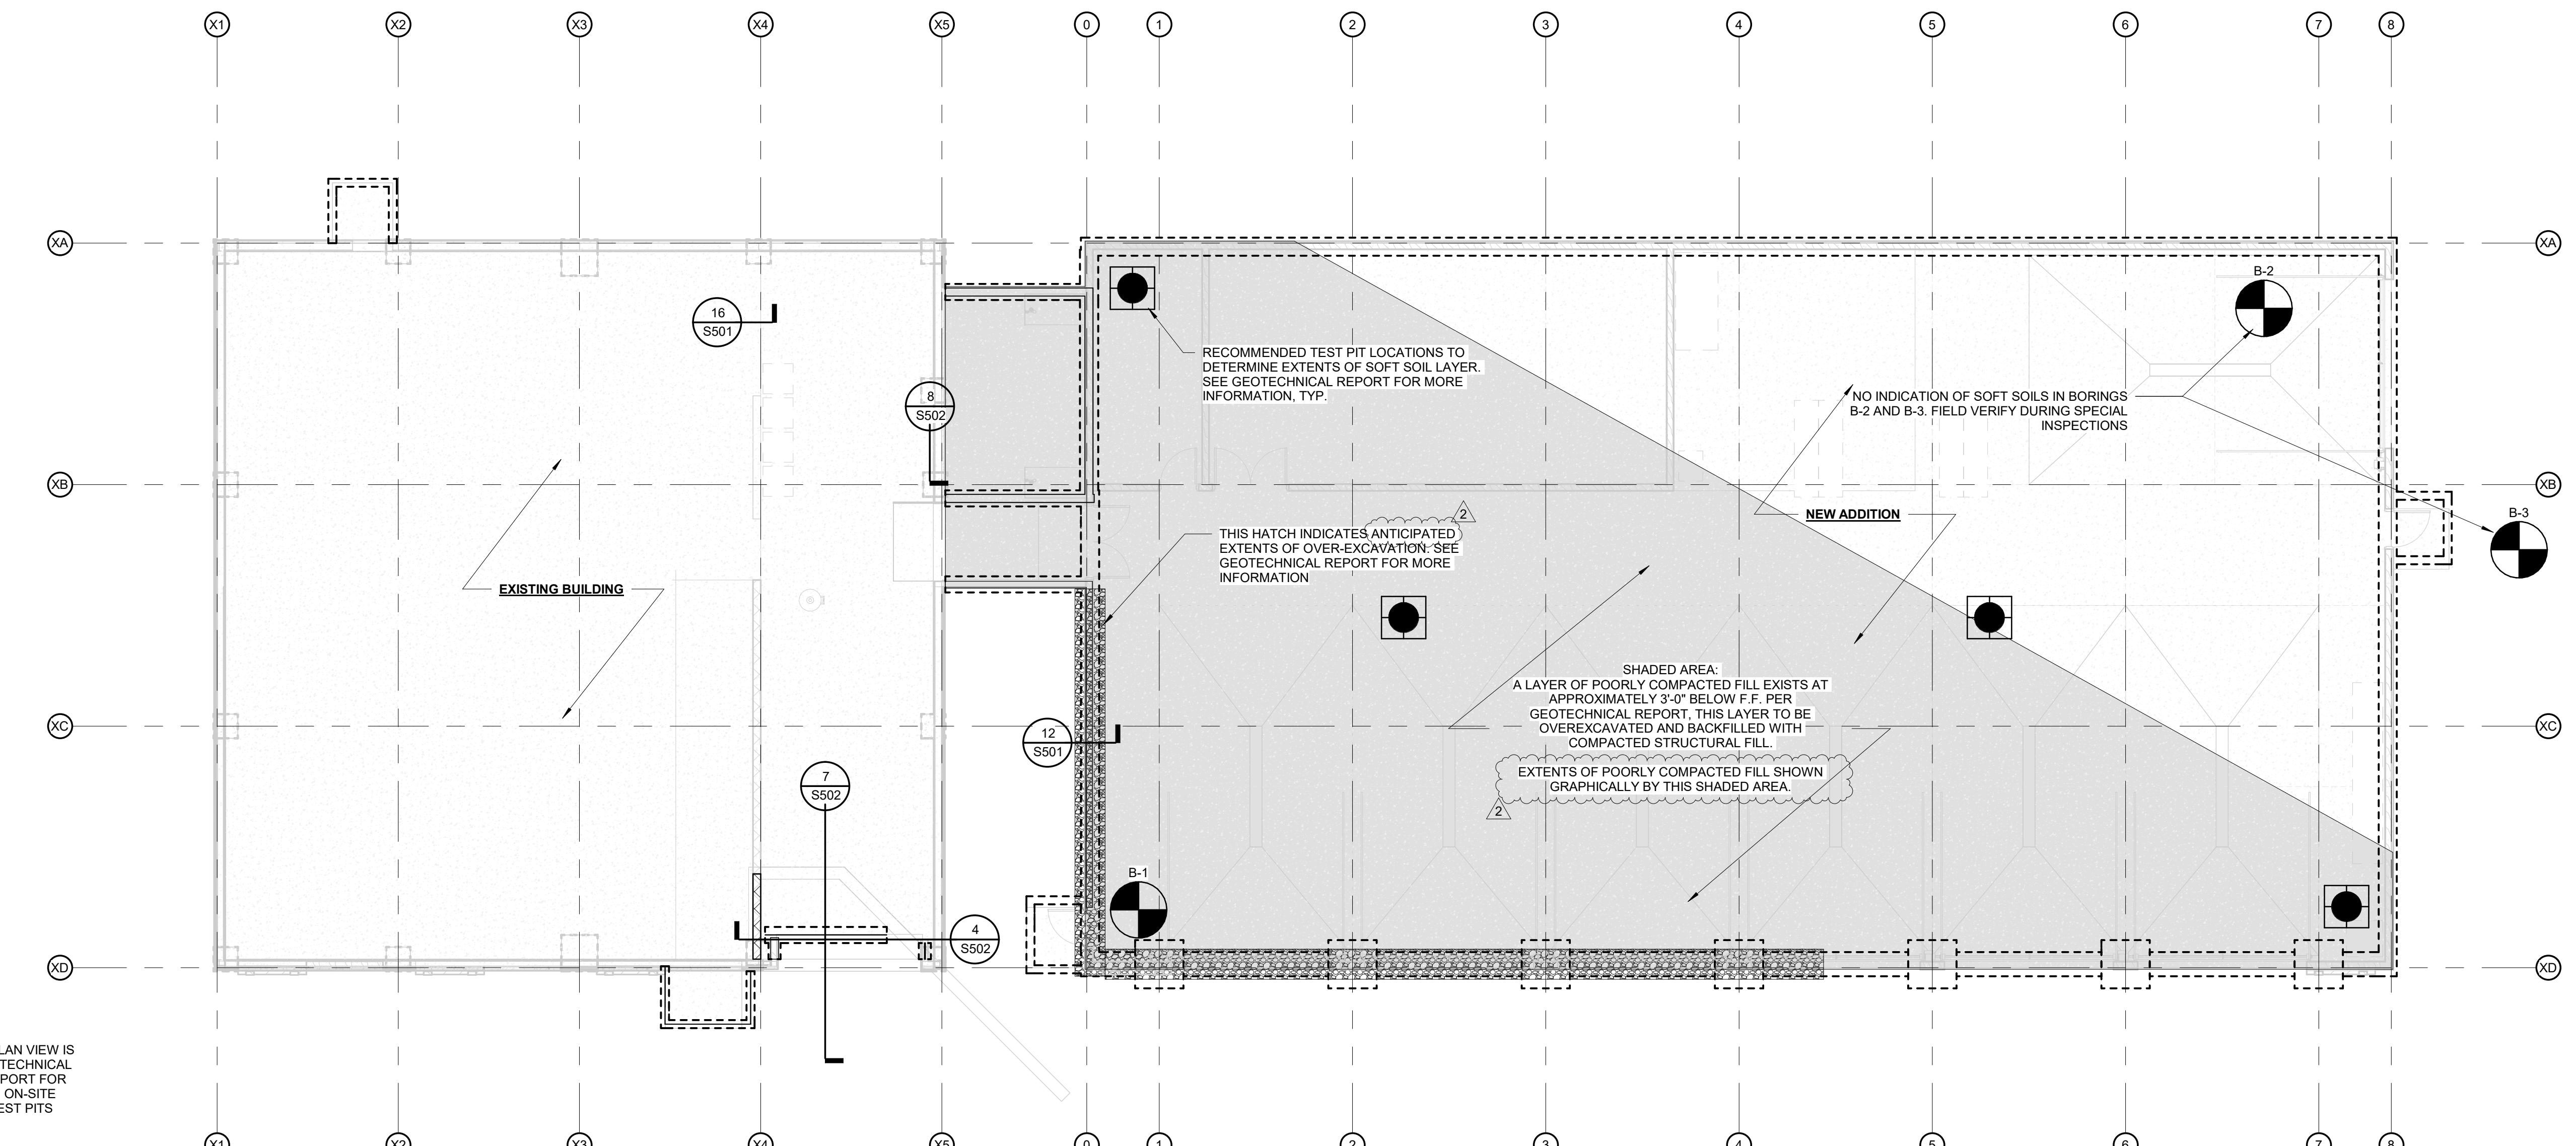

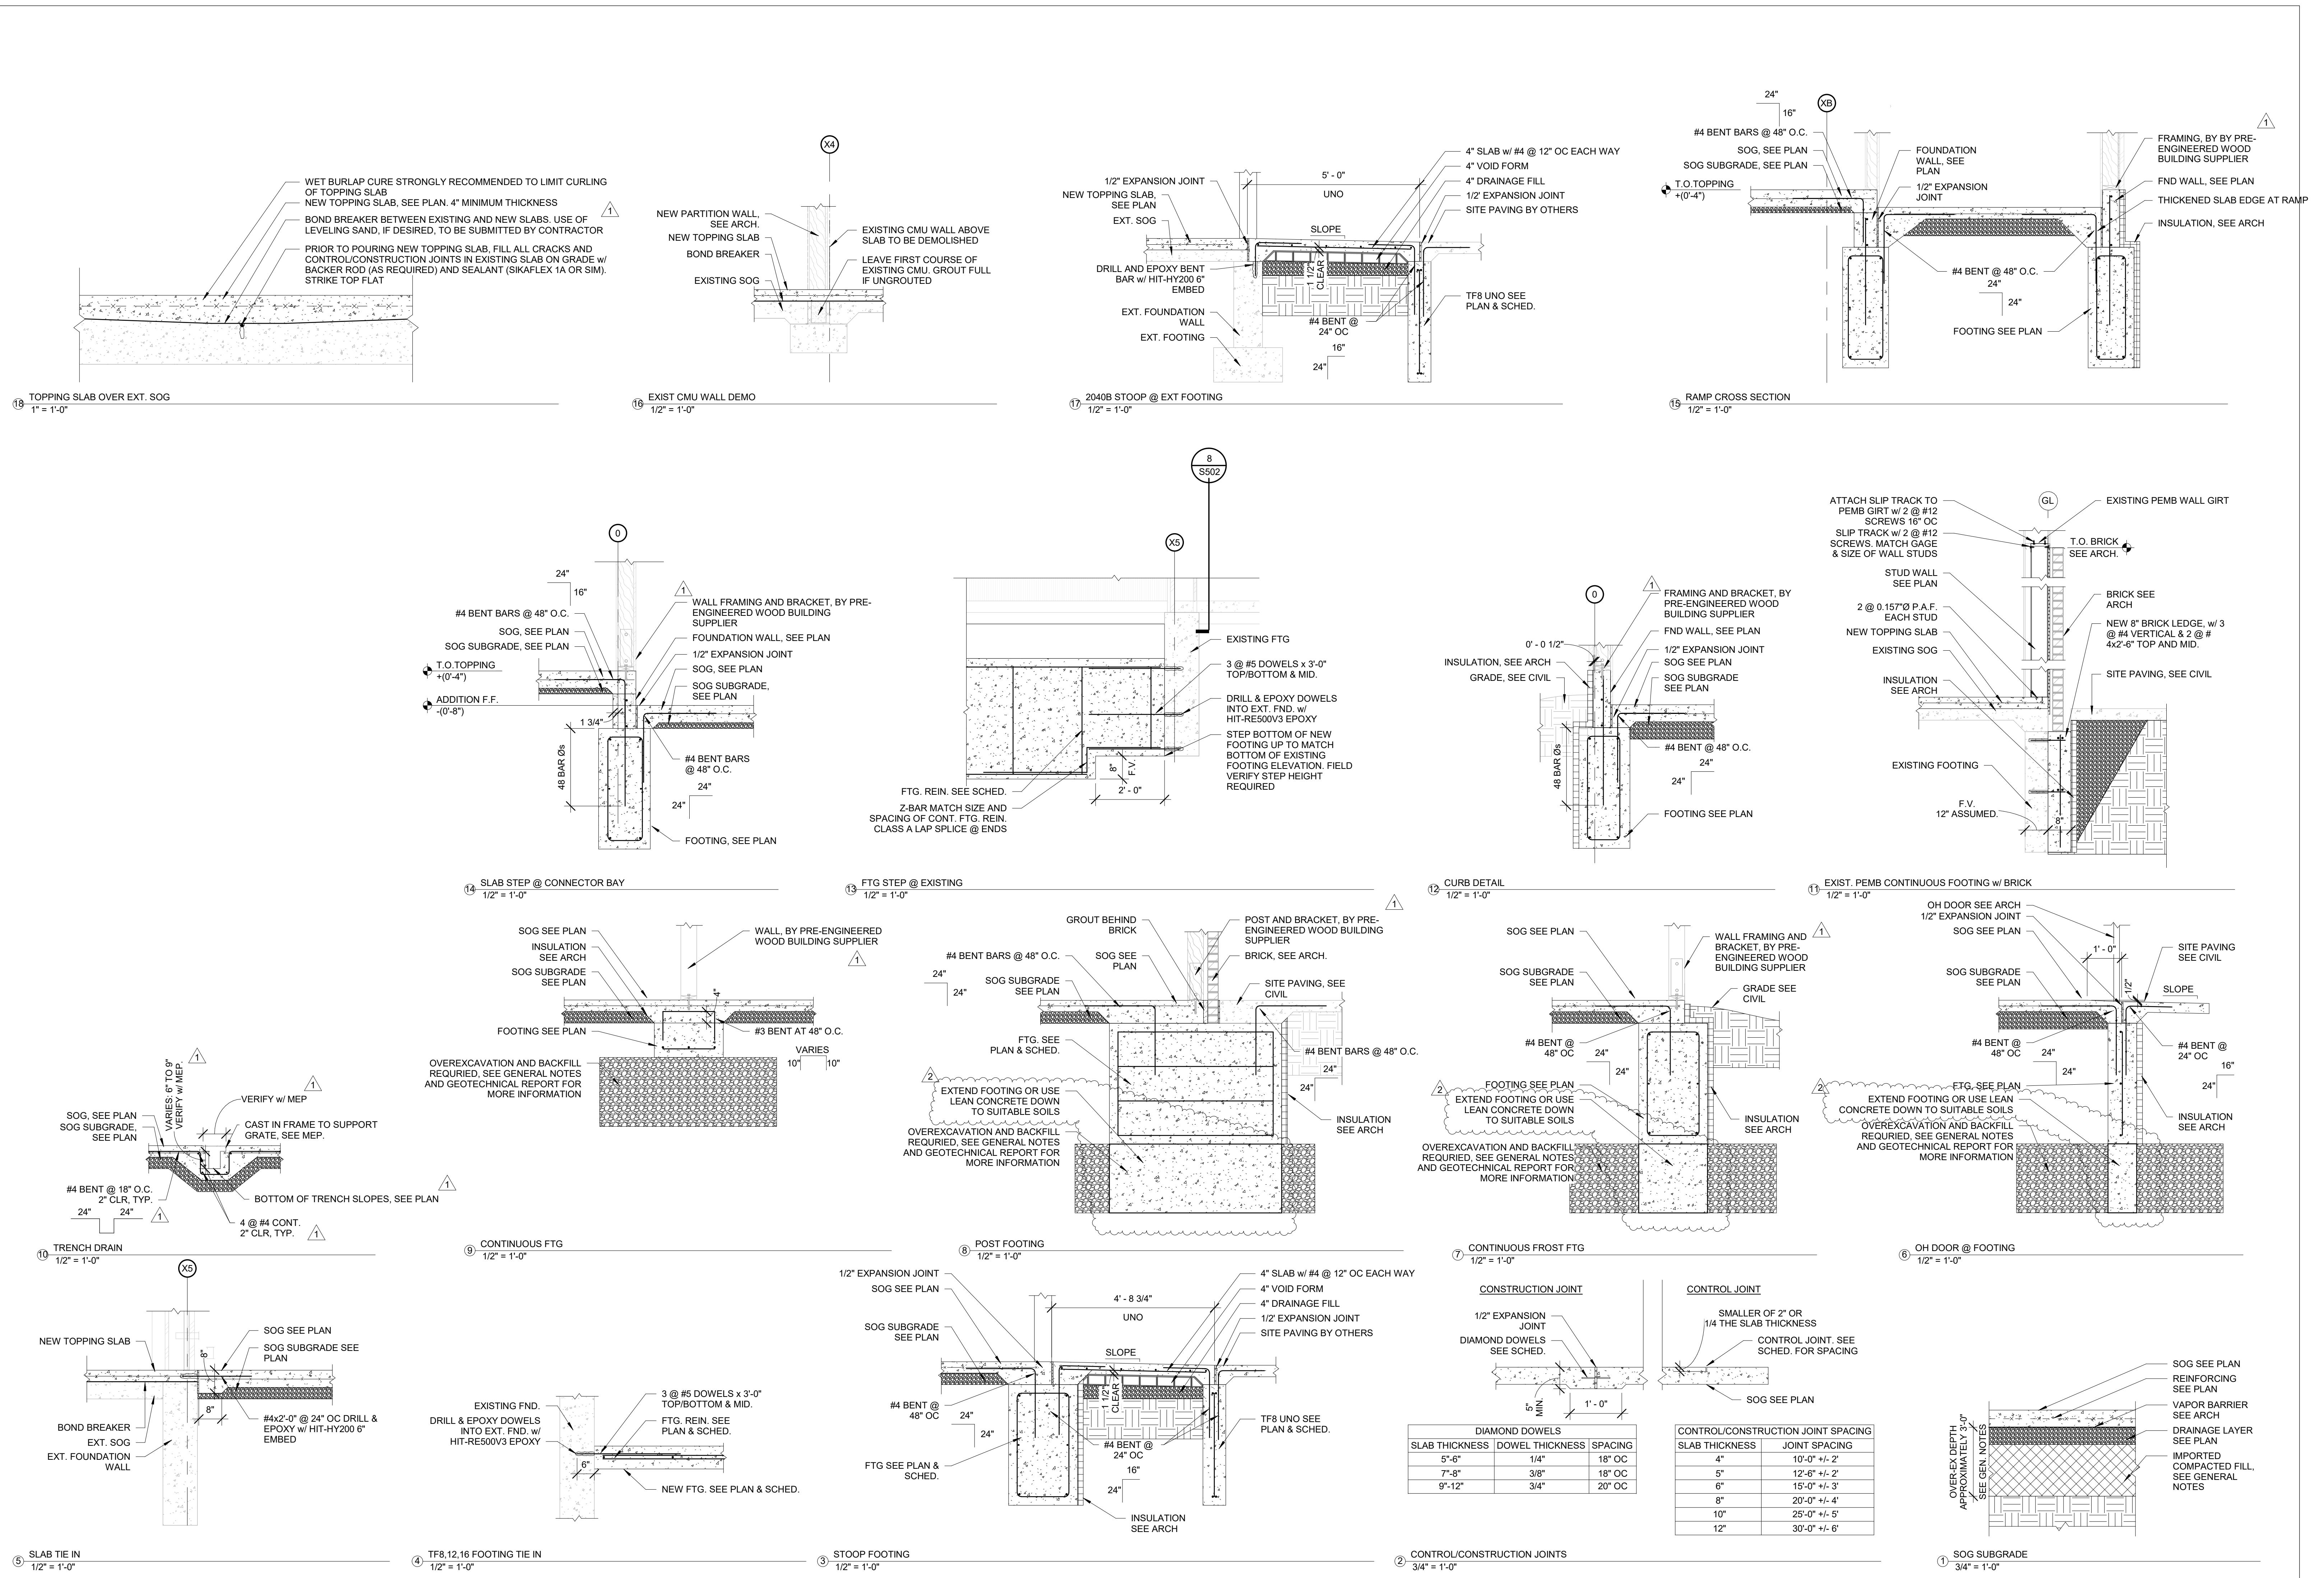

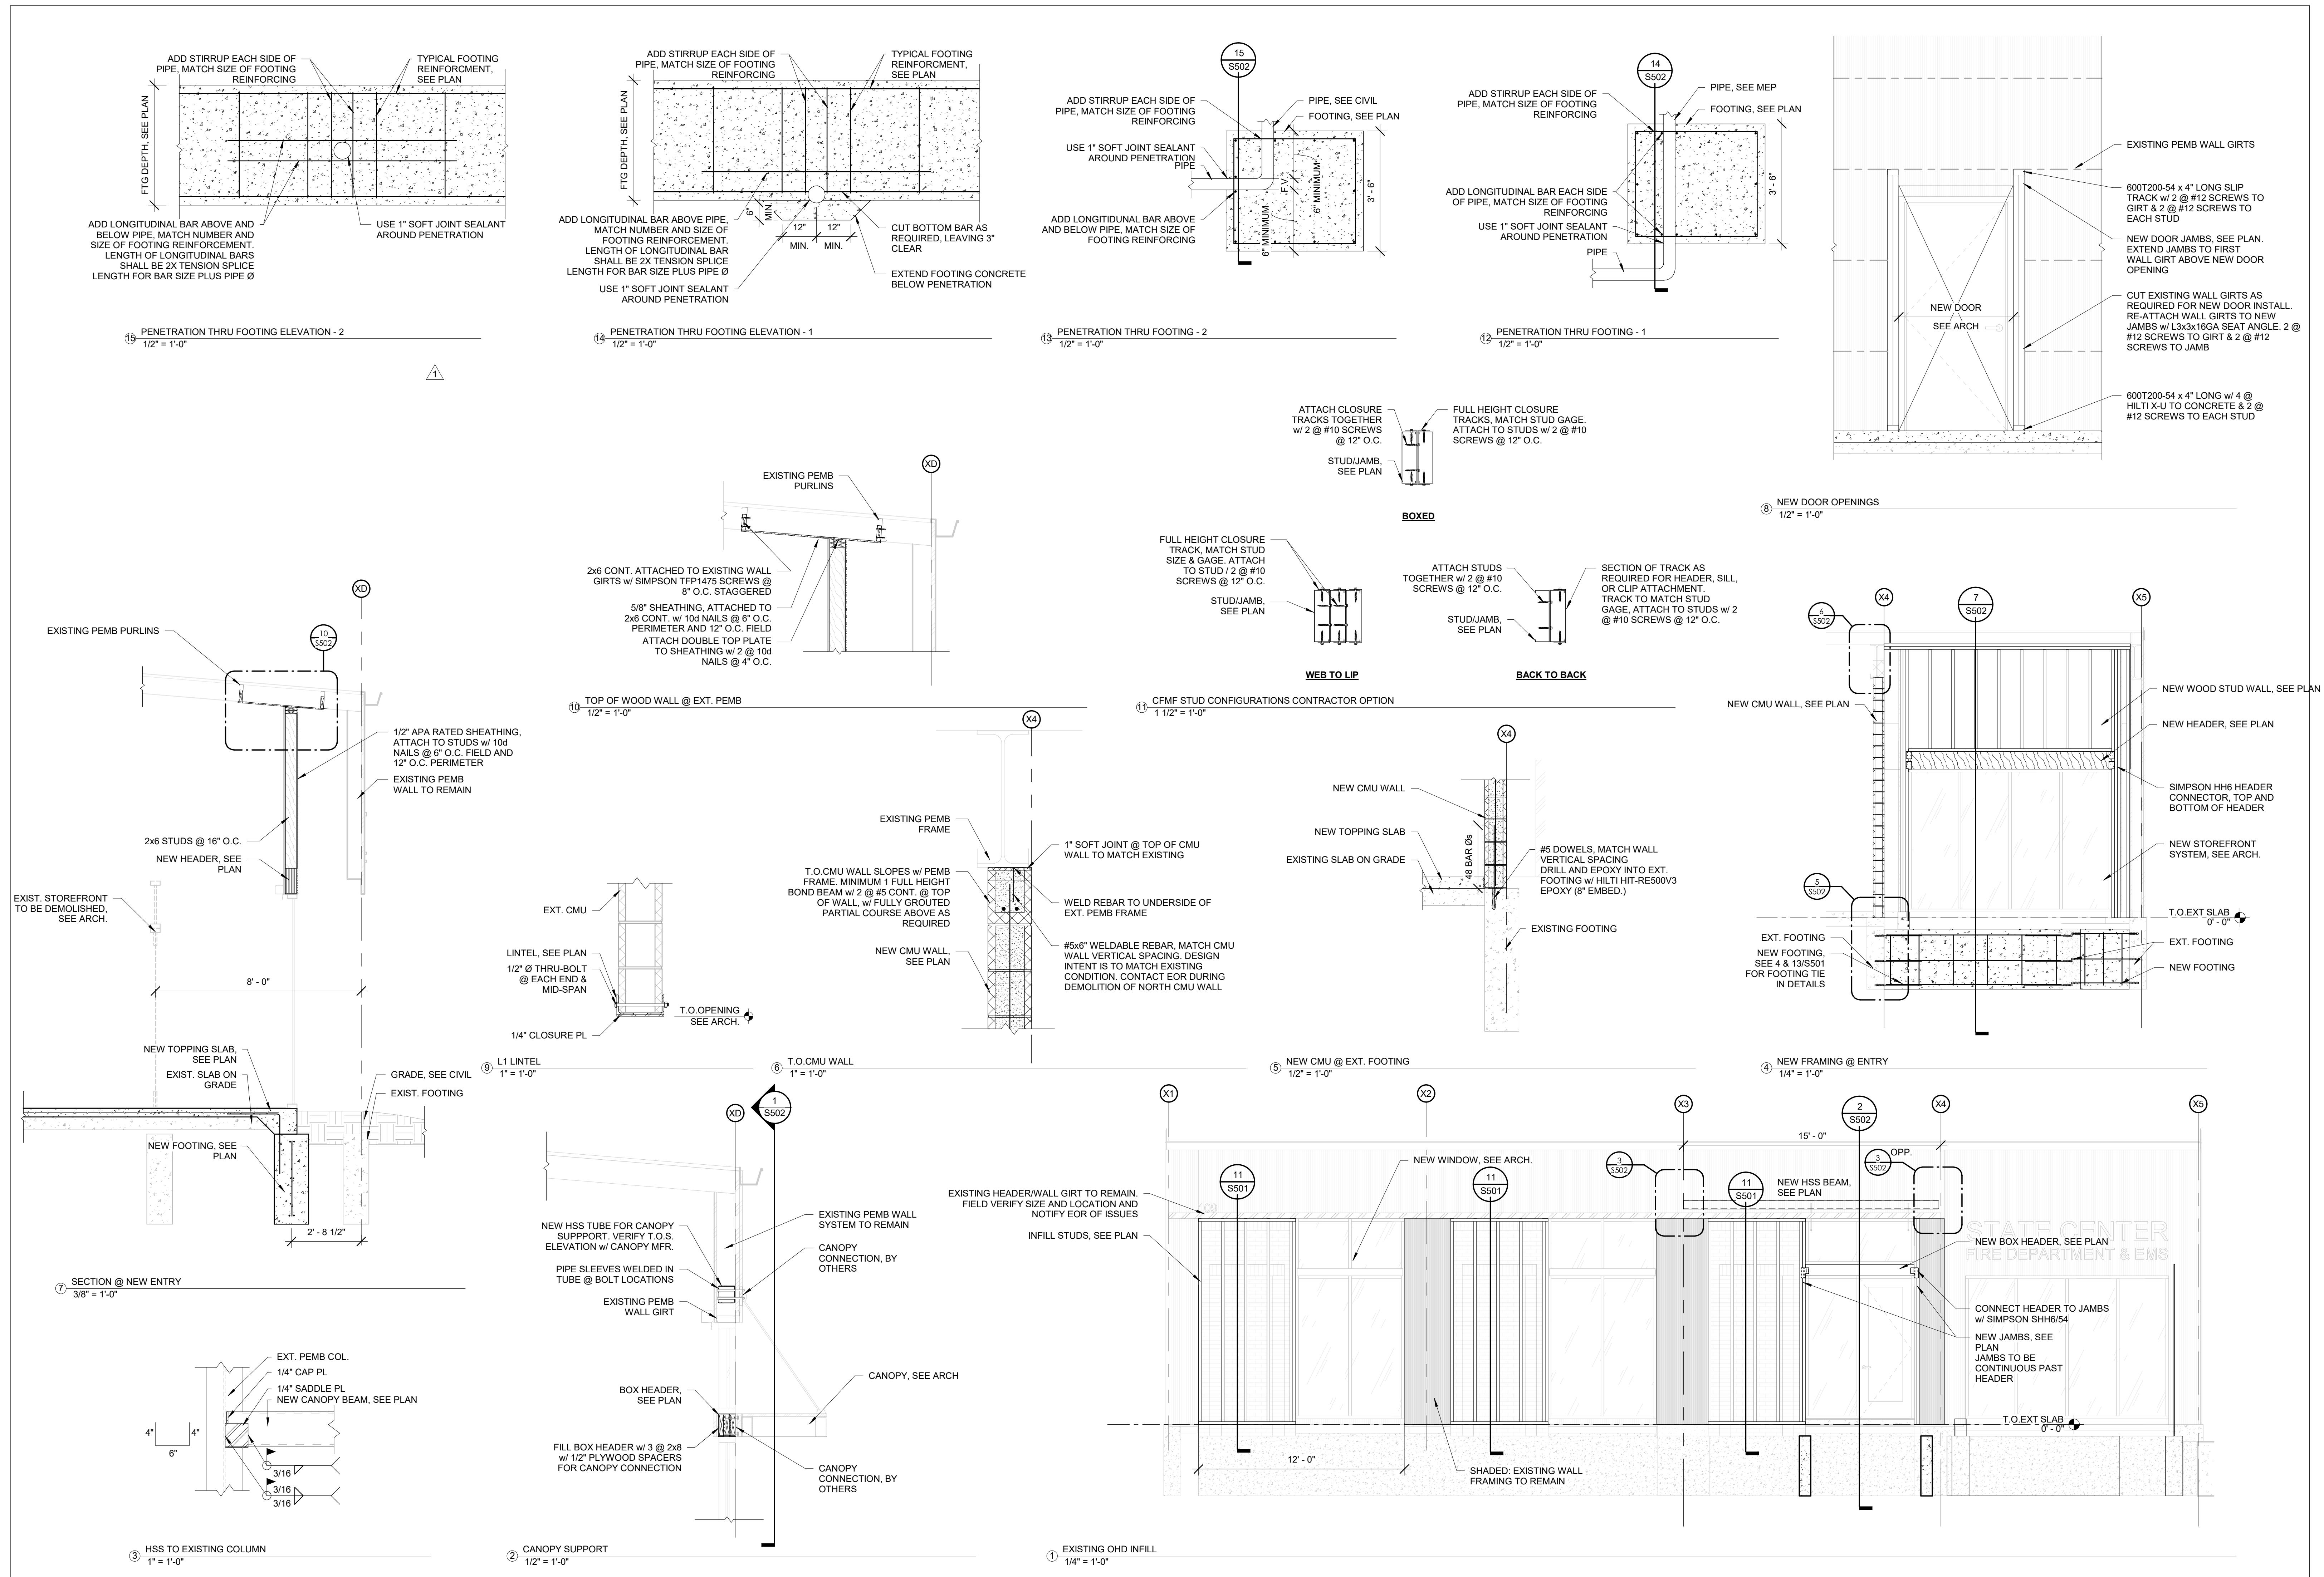

Project: State Center Fire Station

Project Number: 23-006

Date: January 9, 2026

Note *This addendum has been issued to modify and/or interpret the bidding documents, including the drawings and specifications. Unless otherwise instructed, the information contained on the addendum shall take precedence over anything contrary on the original bidding documents and shall be hereinafter considered as a party of the bidding documents.*

## Specifications

### Section 22 3000 – Plumbing Equipment

1. **DELETE** Part 1.01.C Water Softener.
2. **DELETE** Part 1.07.B.
3. **DELETE** Part 1.07.C.
4. **DELETE** Part 1.08 Maintenance Products.
5. **DELETE** Part 1.09 Extra Materials.

### Section 23 1123 – Natural Gas Piping

1. **REVISE** Part 3.02.C. to read, "Any charges by the gas utility company to provide service to the building shall be billed directly to the Owner."

## Plans

### Sheet P1.0 – Piping Underfloor Plan

1. Mech/Storage 103
  - A. **REVISE** sanitary piping to line up with Janitor Sink and Floor Drain locations.
2. RR 110
  - A. **REVISE** sanitary piping to line up Floor Drain location.
3. RR 111
  - A. **REVISE** sanitary piping to line up Floor Drain location.

### Sheet P5.1 – Piping Details

1. Gas Metering Detail
  - A. **REVISE** gas pressure outlet to 1/2 psi.

### Sheet P6.1 – Plumbing Schedules

1. Plumbing Specialties Schedule
  - A. **ADD** Sand Oil Interceptor SOI-1 to be 500-gallon precast tank with traffic rated covers as described in schedule.

### Sheet M1.1 – Mechanical Plan

1. EMT Storage 113
  - A. **ADD** return grille high in stud wall.
2. Apparatus Storage 114
  - A. **ADD** return grille low in stud wall.

- B. **ADD** exhaust fan EF-6 and associated exhaust duct, controls, and accessories.
- C. **ADD** Referenced Note 26.
- 3. Referenced Notes
  - A. **ADD** Note 26 to read, "Install high/low grilles in stud space of wall for EF-6 makeup air."

#### Sheet M6.1 – Mechanical Schedules

- 1. Exhaust Fan Schedule
  - A. **ADD** exhaust fan EF-6.
  - B. **REVISE** Note 2 to read, "EF-1, EF-2, EF-3, EF-6 shall operate with wall switch. refer to electrical plans."

#### Sheet E1.1 – Electrical Power Plan

- 1. Electrical Plan
  - A. **ADD** referenced note 17 tag to exhaust fans in RR 108, RR 110, and RR 111.
  - B. **ADD** line voltage toggle switch and associated Referenced Note 16 tag for exhaust fan control in Apparatus Storage 114.
  - C. **ADD** power for exhaust fan EF-6 in Apparatus Storage 114.
- 2. Referenced Notes
  - A. **ADD** referenced note 16 that reads "PROVIDE LINE VOLTAGE TOGGLE SWITCH FOR CONTROL OF APPARATUS STORAGE EXHAUST FAN. SWITCH SHALL BE GANGED WITH ROOM LIGHT SWITCH AND CEILING FAN CONTROL SWITCH."
  - B. **ADD** referenced note 17 that reads "SEE ELECTRICAL LIGHTING PLAN FOR INFORMATION ON EXHAUST FAN CONTRTOL."

#### Sheet E2.1 – Electrical Lighting Plan

- 1. Lighting Plan
  - A. **ADD** referenced note 7 tag to lighting control switches in RR 108, RR 110, and RR 111.
- 2. Referenced Notes
  - A. **ADD** referenced note 7 that reads "CONTROL DEVICE SHALL HAVE AN ADDITIONAL AUXILIARY RELAY FOR CONTROL OF RESTROOM EXHAUST FAN. EXHAUST FAN SHALL OPERATE WITH THE LIGHTING."

#### Sheet E6.1 – Electrical Schedules

- 1. MDP Panel Schedule
  - A. **REVISE** circuits MDP-58 – MDP-64 to include branch circuit for exhaust fan EF-6 and (6) spare 20A-1P spare breakers.
- 2. Lighting Fixture Schedule
  - A. **ADD** Day-Brite CFI as an approved manufacturer for type PA.
  - B. **ADD** the following equal manufacturers:
    - a. Type DA – Nora
    - b. Type EA – Exitronix
    - c. Type EB – Exitronix
    - d. Type EC – Exitronix
    - e. Type PA – ILP, Day-Brite CFI
    - f. Type PB – Trace-Lite
    - g. Type RA – Trace-Lite
    - h. Type RB – Trace-Lite
    - i. Type ZA – Lumencia
    - j. Type ZB – Lumencia
    - k. Type ZC – Lumencia

**Attachments**

Sheet P1.0 – Piping Underfloor Plan... (24 x 36)

Sheet P6.1 – Plumbing Schedules... (24 x 36)


Sheet M1.1 – Mechanical Plan... (24 x 36)

Sheet M6.1 – Mechanical Schedules... (24 x 36)

Sheet E1.1 – Electrical Power Plan... (24 x 36)

Sheet E2.1 – Electrical Lighting Plan... (24 x 36)

Sheet E6.1 – Electrical Schedules... (24 x 36)

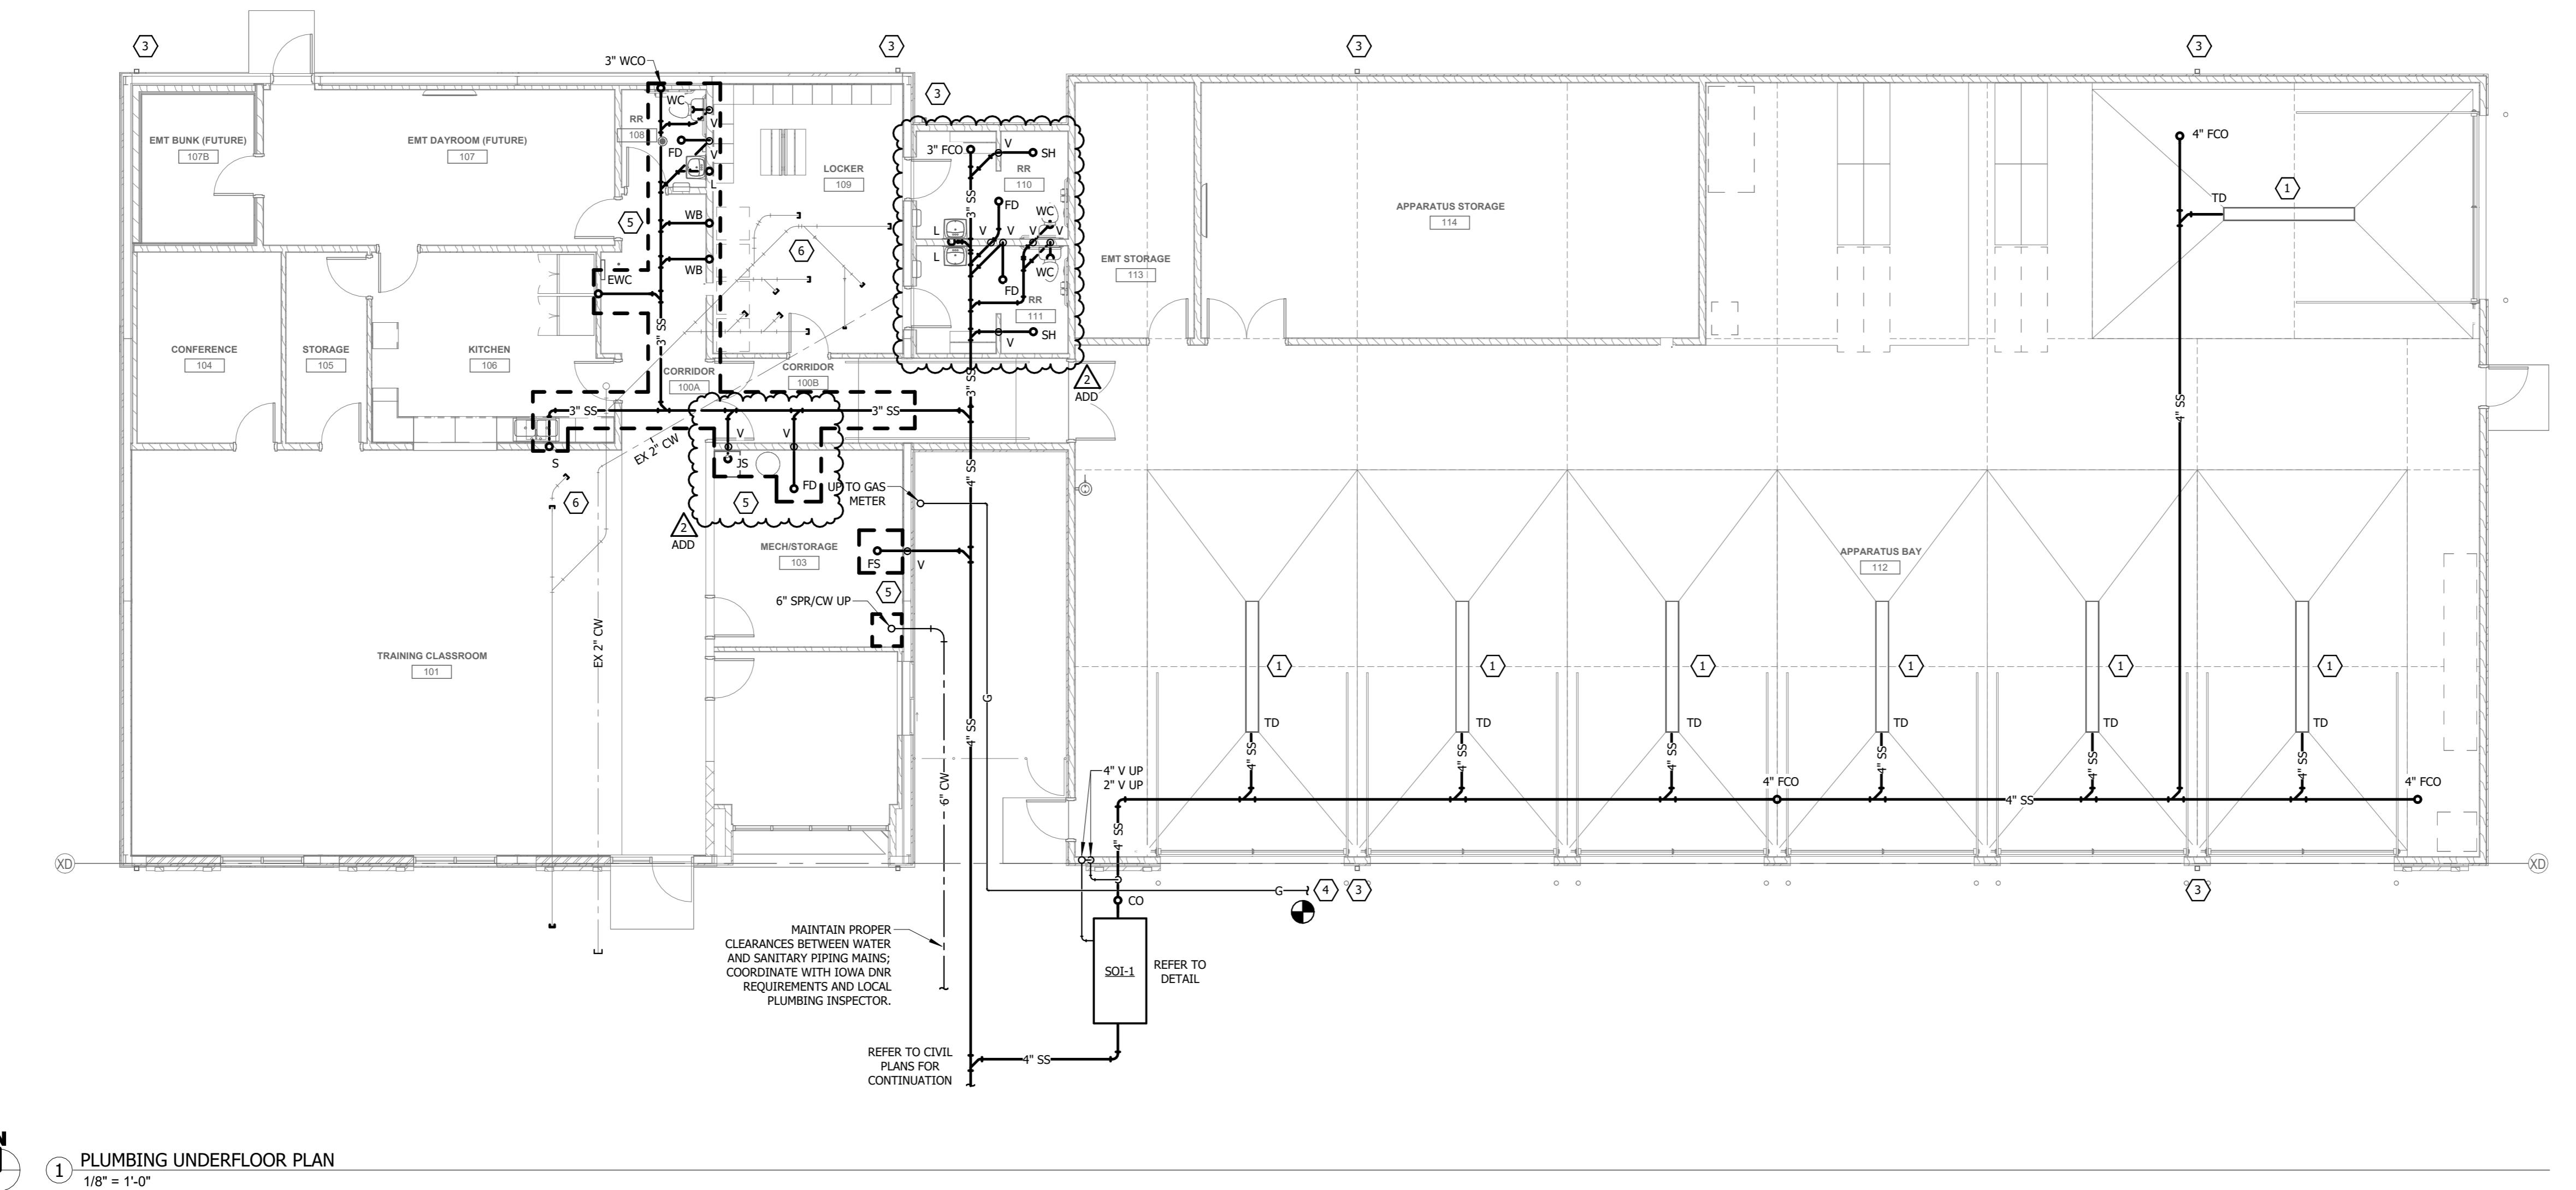

## **GENERAL NOTES:**

INSTALLATION PLANS ARE SCHEMATIC IN NATURE. CONTRACTOR TO VERIFY PLACEMENT OF NEW EQUIPMENT/FIXTURES PRIOR TO INSTALLATION.

MAINTAIN SERVICE CLEARANCE AROUND ALL MECHANICAL EQUIPMENT AND ABOVE ELECTRICAL EQUIPMENT. DO NOT ROUTE PIPING IN CLEARANCE SPACE.

COORDINATE PIPING LAYOUT AND ELEVATIONS WITH FOOTINGS, FLOW LINES, LOCAL PLUMBING CODE AND THE SPECIFICATIONS.

VERIFY ALL SITE CONDITIONS PRIOR TO START OF WORK.

COORDINATE ALL PLUMBING AND PIPING ROUTING WITH BUILDING STRUCTURE AND OTHER TRADES PRIOR TO INSTALLATION TO ALLOW FOR PROPER CLEARANCES AND FLOW REQUIREMENTS.

ALL CONDENSATE DRAIN PIPING SHALL BE 3/4" COPPER WITH INSULATION UNLESS NOTED OTHERWISE. WHITE IN APPARATUS BAY AND BLACK IN ADMIN ADDITION.

COORDINATE ALL VENTS THROUGH ROOF WITH STRUCTURAL DRAWINGS AND MAINTAIN 10FT REQUIRED DISTANCE FROM MECHANICAL EQUIPMENT INTAKES. OFFSET PIPING AS NECESSARY.

COORDINATE ALL EXPOSED PIPE ROUTING WITH DESIGN TEAM PRIOR TO ROUGH-IN. SPECIFIC RACKING REQUIREMENTS MAY BE REQUIRED.

COORDINATE ALL FLOOR DRAIN LOCATIONS WITH MECHANICAL EQUIPMENT AND RESPECTIVE TRADES PRIOR TO ROUGH-IN.

COORDINATE STORM AND SANITARY SEWER CONNECTIONS WITH STRUCTURAL & CIVIL DRAWINGS TO MAINTAIN REQUIRED SLOPING AND PROPER ELEVATIONS.

SEE PLUMBING FIXTURE CONNECTION SCHEDULE FOR FIXTURE CONNECTION SIZES.

FIELD VERIFY ALL NEW AND EXISTING PIPE ROUTING WITH EXISTING CONDITIONS PRIOR TO ROUGH-IN. MAKE NECESSARY OFFSETS AS REQUIRED.

COORDINATE ALL WALL CLEANOUT LOCATIONS WITH DESIGN TEAM PRIOR TO ROUGH-IN. COORDINATE ALL FLOOR CLEANOUT LOCATIONS BEING INSTALLED IN CARPET OR OTHER SPECIALTY FLOOR AREAS WITH DESIGN TEAM PRIOR TO ROUGH-IN.

PROVIDE ISOLATION BALL VALVES ON BRANCH PIPING TAPS FROM MAIN ON ALL COLD AND HOT WATER PIPES. ENSURE VALVES ARE INSTALLED IN ACCESSIBLE LOCATIONS.

PROVIDE A INSULATED PLUMBING VENT BOOT FLASHING IN LOCATIONS THRU THERMAL ENVELOPE.

ALL ROOF PENETRATIONS TO OCCUR NORTH OF ROOF RIDGE OR THRU EXTERIOR WALLS. ANY PENETRATIONS NOT SHOWN ON ARCHITECTURAL ELEVATIONS SHALL BE COORDINATED WITH ARCHITECT & ENGINEER PRIOR TO INSTALLATION.

PROFESSIONAL SERVICE AND SHALL  
REMAIN THE PROPERTY OF MELLE, LLC.  
THEY HAVE BEEN PREPARED SPECIFICALLY  
FOR THIS PROJECT AND SHALL NOT BE  
USED ON ANY OTHER PROJECTS OR IN  
ANY OTHER LOCATIONS WITHOUT  
OBTAINING PRIOR WRITTEN CONSENT  
OF MELLE, LL, UNAUTHORIZED  
REPRODUCTION IS PROHIBITED.

## **REFERENCED NOTES:**

- NEW TRENCH DRAINS AND CATCH BASINS. REFER TO ARCHITECTURAL DOCUMENTS FOR MORE INFORMATION ON PROPOSED SLOPED FLOOR SLAB EXTENTS & PROPOSED TRENCH DRAIN RIM ELEVATIONS.
- EXTEND 2" CW UNDERSLAB TO NEW METER AND BACKFLOW LOCATION.
- COORDINATE STORM DOWNSPOUT PIPING WITH CIVIL SITE PLANS.
- COORDINATE NEW GAS PIPE ROUTING WITH CIVIL SITE PLANS. CONNECT TO EXISTING GAS MAIN.
- CUT AND PATCH EXISTING FLOOR SLAB TO MATCH EXISTING. REFER TO ALL BID DOCUMENTS FOR ADDITIONAL INFORMATION.
- CAP EXISTING UNDERFLOOR PIPING BELOW FLOOR IN EXISTING BUILDING AFTER PIPING IS BLOWN OUT AND COMPLETELY DISCONNECTED FROM SYSTEM MAINS. PATCH CONCRETE TO MATCH EXISTING.

PROJECT: STATE CENTER FIRE STATION  
ADDRESS: 109 E MAIN STREET; STATE CENTER, IA 50247  
CLIENT: STATE CENTER FIRE DEPARTMENT

## CLIMBING FIXTURE CONNECTION SCHEDULE

ITEM	WASTE SIZE	VENT SIZE	WATER SIZE	
			HOT	COLD
MASTER CLOSET (TANK)	3"	2"	-	3/4"
LAVATORY	1-1/2"	1-1/2"	1/2"	1/2"
SINK	1-1/2"	1-1/2"	1/2"	1/2"
ANITOR SINK	3"	1-1/2"	3/4"	3/4"
WASHING FOUNTAIN	1-1/2"	1-1/2"	-	1/2"
SHOWER	2"	1-1/2"	3/4"	3/4"
WASHER BOX	2"	1-1/2"	1/2"	1/2"
ALL WASTE STACK	4"	-	-	-
ALL VENT STACK		2"		

ALL SANITARY SEWER BELOW GRADE SHALL BE A MINIMUM OF 3" UNLESS OTHERWISE NOTED.  
ALL VENT DRAVINGS SHALL BE A MINIMUM OF 3" UNLESS OTHERWISE NOTED.

PLUMBING FIXTURE SCHEDULE										
UNIT TAG	TYPE	MANUFACTURER	MODEL	MATERIAL	COLOR	ADA	FIXTURE DESCRIPTION	MISCELLANEOUS	TRIM	APPROVED EQUALS
EEW-1	EMERGENCY EYE WASH	HAWS	7260BT-7270BT	ABS & CHROME	GREEN	-	WALL MOUNTED EYE/FACE WASH SHALL INCLUDE A GREEN ABS PLASTIC 11" BOWL. AN AXION® MSR EYE/FACE WASH HEAD SHALL FEATURE INVERTED DIRECTIONAL LAMINAR FLOW WHICH ACHIEVES ZERO VERTICAL VELOCITY™ SUPPLIED BY AN INTEGRAL 3.7 GPM FLOW CONTROL, CHROME PLATED BRASS STAY-OPEN BALL VALVE EQUIPPED WITH STAINLESS STEEL BALL AND STEM, TAIL PIECE AND TRAP, AND CHROME-PLATED BRASS IN-LINE 50 X 50 MESH WATER STRAINER. UNIT SHALL ALSO INCLUDE CAST-ALUMINUM CHROMATE PROTECTED WALL BRACKET, YELLOW PLASTIC POP-OFF DUST COVER FOR EYEWASH HEAD, DRAIN TRAP AND TAILPIECE, UNIVERSAL SIGN, 1/2" NPT INLET, AND 1-1/2" NPT WASTE.	HAWS MIXING VALVE MODEL 921EW MOUNTED ON THE WALL IN A STAINLESS STEEL BOX.	-	BRADLEY, GUARDIAN
EWC-1	ELECTRIC WATER COOLER	ELKAY	EZSTL8WSLK	STAINLESS STEEL/PLASTIC	STEEL	YES	BI-LEVEL ELECTRIC WATER COOLER WITH NON-FILTERED INTEGRAL AIR-COOLED CHILLER, AUTOMATIC STREAM REGULATOR, FLEXI-GUARD SAFETY BUBBLER WITH STREAM GUARD BOTTLE FILL WITH ACTIVATION, 20 SEC AUTO SHUT-OFF, NON-FILTERED	CAPACITY: 8.0 GPH OF 50 DEGREE FARENHEIGHT WATER WITH INLET AT 80 DEGREE FARENHEIGHT AND ROOM TEMP OF 50 DEGREE FARENHEIGHT, MAX 1/5 HP COMPRESSOR, 120V/1PHASE, WARRANTY: 1 YEAR ELECTRONIC COMPONENT, 5 YEAR REFRIGERATION SYSTEM	-	HALSEY TAYLOR, ENGINEER APPROVED EQUAL
JS-1	JANITORIAL SINK	FIAT	MSBIDTG2424	MOLDED STONE	WHITE	NO	MOLDED STONE 24" x 24" x 10" DEEP FLOOR MOUNTED MOP SERVICE BASIN WITH 1" WIDE SHOULDERS, 3" INTEGRAL DRAIN	MOP HANGER (889-CC), SST WALL GUARD (MSG2424), VINYL BUMPERGUARD (E-77-AA), HOSE/HOSE BRACKET (832-AA) AND FAUCET (830AA)	JSF-1	STERN WILLIAMS, PROFO ENGINEER APPROVED EQUAL
L-1	LAVATORY	KOHLER	KINGSTON K-2005-0	VITREOUS CHINA	WHITE	YES	21-1/4" X 18-1/8" WALL MOUNTED LAVATORY, THREE HOLE, 4" CENTERS	WATTS WCA-411 FLOOR MOUNTED LAVATORY CARRIER, VERIFY MOUNTING HEIGHT WITH ARCHITECTURAL DRAWINGS.	LF-1	AMERICAN STANDARD, SLOAN
SH-1	SHOWER	FREEDOM	APFQ6233BF875	ACRYLIC	WHITE	YES	62" x 323/4" x 785/8" ONE-PIECE ADA SHOWER ANSI COMPLIANT, SMOOTH WALLS, TEXTURED FLOOR, FOLD UP SEAT, GRAB BARS, BARRIER FREE, CENTER DRAIN 1.28 GPF, FLOOR MOUNTED, SIPHON JET, CLASS FIVE FLUSHING SYSTEM, LEFT-HAND TRIP LEVER	PROVIDE FLOOR DRAIN COMPATIBLE WITH SHOWER BASE, VERIFY TRIM MOUNTING HEIGHT WITH ARCHITECT CLOSE COUPLED TANK AND SUPPLY WITH LOOSE KEY STOP	SHV-1	ENGINEER APPROVED EQUAL
WC-1	WATER CLOSET	KOHLER	HIGHLINE K-3999-0	VITREOUS CHINA	WHITE	YES			WCA-1	AMERICAN STANDARD, SLOAN

NOTES:

1. VERIFY SLAB RECESS REQUIREMENTS FOR BARRIER-FREE ADA COMPLIANT INSTALLATION WITH MFG PRIOR TO INSTALLATION OF SH-1.

PLUMBING FIXTURE TRIM SCHEDULE										
UNIT	TYPE	MANUFACTURER	MODEL	COLOR	FIXTURE DESCRIPTION	MISCELLANEOUS	APPROVED EQUALS			
JSF-1	SERVICE SINK FAUCET	FIAT	830AA	CHROME	EXPOSED WALL MOUNT, TWO HANDLE, CHROME PLATED WITH VACUUM BREAKER, INTEGRAL STOPS, ADJUSTABLE WALL BRACE, PAIL HOOK, AND 3/4" HOSE THREAD ON SPOUT, 8" CENTERS	FIAT #1453-BB STAINLESS STRAINER	DELTA, ENGINEER APPROVED EQUAL			
LF-1	LAVATORY FAUCET	KRAUS	KSB-10001	CHROME	SENSOR OPERATED CENTER SET ELECTRONIC HAND WASHING FAUCET, 1.2 GPM LAMINAR FLOW VANDAL-RESISTANT AERATOR, 4AA BATTERIES AND CONTROL BOX	METAL GRID STRAINER WITH 1-1/2" 17 GA CHROME PLATED P-TRAP, OFFSET TAILPIECE AS REQUIRED, TRU-BRO LAV GUARD, 1/4 TURN LOOSE KEY STOPS, [DESIGNER NOTE: ONLY SLOAN OFFERS BLUETOOTH CONNECTIVITY. INCLUDE THE FOLLOWING BLURB ONLY IF SOLE-SOURCING SLOAN, BLUETOOTH CONNECTIVITY VIA SLOAN CONNECT APP]	ENGINEER APPROVED EQUAL			
SHV-1	SHOWER SYSTEM	SYMONS	9605-PLR	CHROME	SHOWER SYSTEM WITH 1.5 GPM TEMPTROL PRESSURE BALANCING VALVE, LEVER HANDLE, SEPARATE LEVER DIVERTER, SINGLE MODE SHOWERHEAD 889-CC AND PLATE, HAND SHOWER WITH METAL HOSE, INLINE VACUUM BREAKER AND WALL CONNECTION, 36" ADA SLIDE BAR, INTEGRAL CHECK STOPS	OATEY SHOWER DRAIN WITH STAINLESS STEEL STRAINER	POWERS, ENGINEER APPROVED EQUAL			
WCA-1	SEAT	CHURCH	380TCA	WHITE	CLOSED FRONT SEAT WITH COVER, ELONGATED, SELF-SUSTAINING CHECK HINGE, STAINLESS STEEL BOLTS		BEMIS, ENGINEER APPROVED EQUAL			

PLUMBING SPECIALTIES SCHEDULE										
UNIT	TYPE	MANUFACTURER	MODEL	DESCRIPTION	MISCELLANEOUS & ACCESSORIES	APPROVED EQUALS				
FD-1	FLOOR DRAIN	ZURN	Z415B	EPOXY COATED CAST IRON BODY, ANCHOR FLANGE, REVERSIBLE CLAMPING COLLAR, PRIMARY AND SECONDARY WEPP HOLES, ADJUSTABLE 7" DIAMETER CHROME PLATED BRONZE STRAINER.	PROVIDE WITH MEMBRANE CLAMP ON ALL FLOOR DRAINS INSTALLED ABOVE SLAB ON GRADE. PROVIDE WITH STRAINER EXTENSION TO ACCOMMODATE THICK FILLS AS REQUIRED. [PROVIDE IN-DRAIN TRAP SEAL RECTORSEAL, OATEY, OR ENGINEER APPROVED EQUAL.] CONTRACTOR TO SELECT OUTLET TYPE, OUTLET SIZE AS NOTED ON DRAWINGS.	SMITH, WATTS, JOSAM, WADE, SUN DRAINAGE, ENGINEER APPROVED EQUAL				
FS-1	FLOOR SINK	ZURN	Z1901	FLOOR SINK WITH ANCHOR FLANGE AND CLAMP COLLAR, WHITE ACID RESISTANT PORCELAIN ENAMEL COATED INTERIOR, LOOSE SET PORCELAIN ENAMEL COATED CAST IRON GRATE AND ALUMINUM ANTI-SPLASH INTERIOR BOTTOM DOME STRAINER, ASME A112.6.3. PROVIDE WITH ALUMINUM SEDIMENT BUCKET AND FLANGE WITH WEPP HOLES.	3/4 GRATE, CONTRACTOR TO SELECT OUTLET TYPE, OUTLET SIZE AS NOTED ON DRAWINGS.	SMITH, WATTS, JOSAM, WADE, SUN DRAINAGE, ENGINEER APPROVED EQUAL				
HB-1	HOSE BIBB	WOODFORD	B24	INTERIOR: BRASS WITH INTEGRAL MOUNTING FLANGE, REPLACEABLE HEXAGONAL DISC, HOSE THREAD SPOUT, METAL HANDLE, VACUUM BREAKER IN CONFORMANCE WITH ASSE 1014.	CHROME FINISH	PRIER, ENGINEER APPROVED EQUAL				
SOI-1	SAND/OIL INTERCEPTOR	JENSON	JP-500	500 GALLON PRECAST TANK WITH 4 INCH ASSEMBLY 24" E, 24" E SINGLE BAFFLE, TRAFFIC RATED COVERS. PROVIDE EXTENSIONS AS REQUIRED FOR PROPER DRAINS FROM TRENCH DRAINS TO SITE SANITARY MAIN.	TRAFFIC RATED COVERS, VENT PIPING	ZURN, STRIEL, LISTER, ENGINEER APPROVED EQUAL				
TD-1	TRENCH DRAIN GRATES	ZURN	Z712-HDG	PROVIDE MULTIPLE 12" WIDE X 24" LONG, RATED LOAD CLASS E HEAVY DUTY DURICLE IRON SLOTTED GRATES TO MATCH LENGTH OF CONCRETE TRENCH DRAINS.	REFER TO STRUCTURAL AND ARCHITECTURAL DRAWINGS FOR TRENCH DRAIN LENGTHS PRIOR TO ORDERING.	JOSAM, WATTS, ENGINEER APPROVED EQUAL				
VB-1	ICE MAKER VALVE BOX	GUY GRAY	MIB1AB	WHITE POWDER COATED STEEL ICE MAKER OUTLET BOX WITH LEAD FREE VALVE.		IPS, GUY GRAY, OATEY, ENGINEER APPROVED EQUAL				
WB-1	WASHER BOX	GUY GRAY	MWB30	CENTER DRAIN WHITE POWDER COATED METAL WASHING MACHINE OUTLET BOX WITH 1/4 TURN VALVES AND WATER HAMMER ARRESTORS		IPS, GUY GRAY, OATEY, ENGINEER APPROVED EQUAL				
WH-1	WALL HYDRANT	WOODFORD	B67	ASSE 1019 NON-FREEZE, SELF-DRAINING TYPE WITH LOCKABLE RECESSED BOX HOSE THREAD SPOUT, LOCKSHIELD AND REMOVABLE KEY WITH INTEGRAL DOUBLE CHECK BACKFLOW PREVENTER, 3/4" INLET AND OUTLET.	CHROME FINISH	PRIER, ENGINEER APPROVED EQUAL				

GAS WATER HEATER SCHEDULE									
UNIT TAG	MANUFACTURER	MODEL	STORAGE CAPACITY (GAL)	FUEL TYPE	INPUT (MBH)	MIN RECOVERY 90°F RISE (GPH)	FIRST HOUR RECOVERY	VOLTAGE/Ø	
GWH-1	STATE	GS6 50 YBVIS	50	NATURAL GAS	40	44.7	90	120/1	


NOTES:  
1. POWER VENT COMMERCIAL-GRADE RESIDENTIAL WATER HEATER WITH 3-POSITION ROTATABLE BLOWER OUTLET.

PUMP SCHEDULE									
UNIT TAG	MANUFACTURER	MODEL	SYSTEM	LOCATION	FLOW RATE (GPM)	TOTAL HEAD (FT)	MOTOR SPEED (RPM)	MOTOR PHASE	VOLTAGE
CP-1	BELL AND GOSSETT	PL-36	DOMESTIC HOT WATER	WATER/UTIL 103	2	14	3300	120/1	

PROJECT: STATE CENTER FIRE STATION  
ADDRESS: 109 E MAIN STREET; STATE CENTER, IA 50247  
CURE: STATE CENTER FIRE DEPARTMENT

PRINT DATE: 12.8.2025  
SHEET NAME: PLUMBING SCHEDULES  
PHASE: CD

**WATERLOO | DES MOINES | IOWA CITY**  
214 EAST 4TH ST. 130 EAST 3RD ST. 118 EAST COLLEGE ST.  
WATERLOO, IOWA DES MOINES, IOWA IOWA CITY, IOWA  
(319) 235-0650 (515) 251-7280 (319) 248-4800

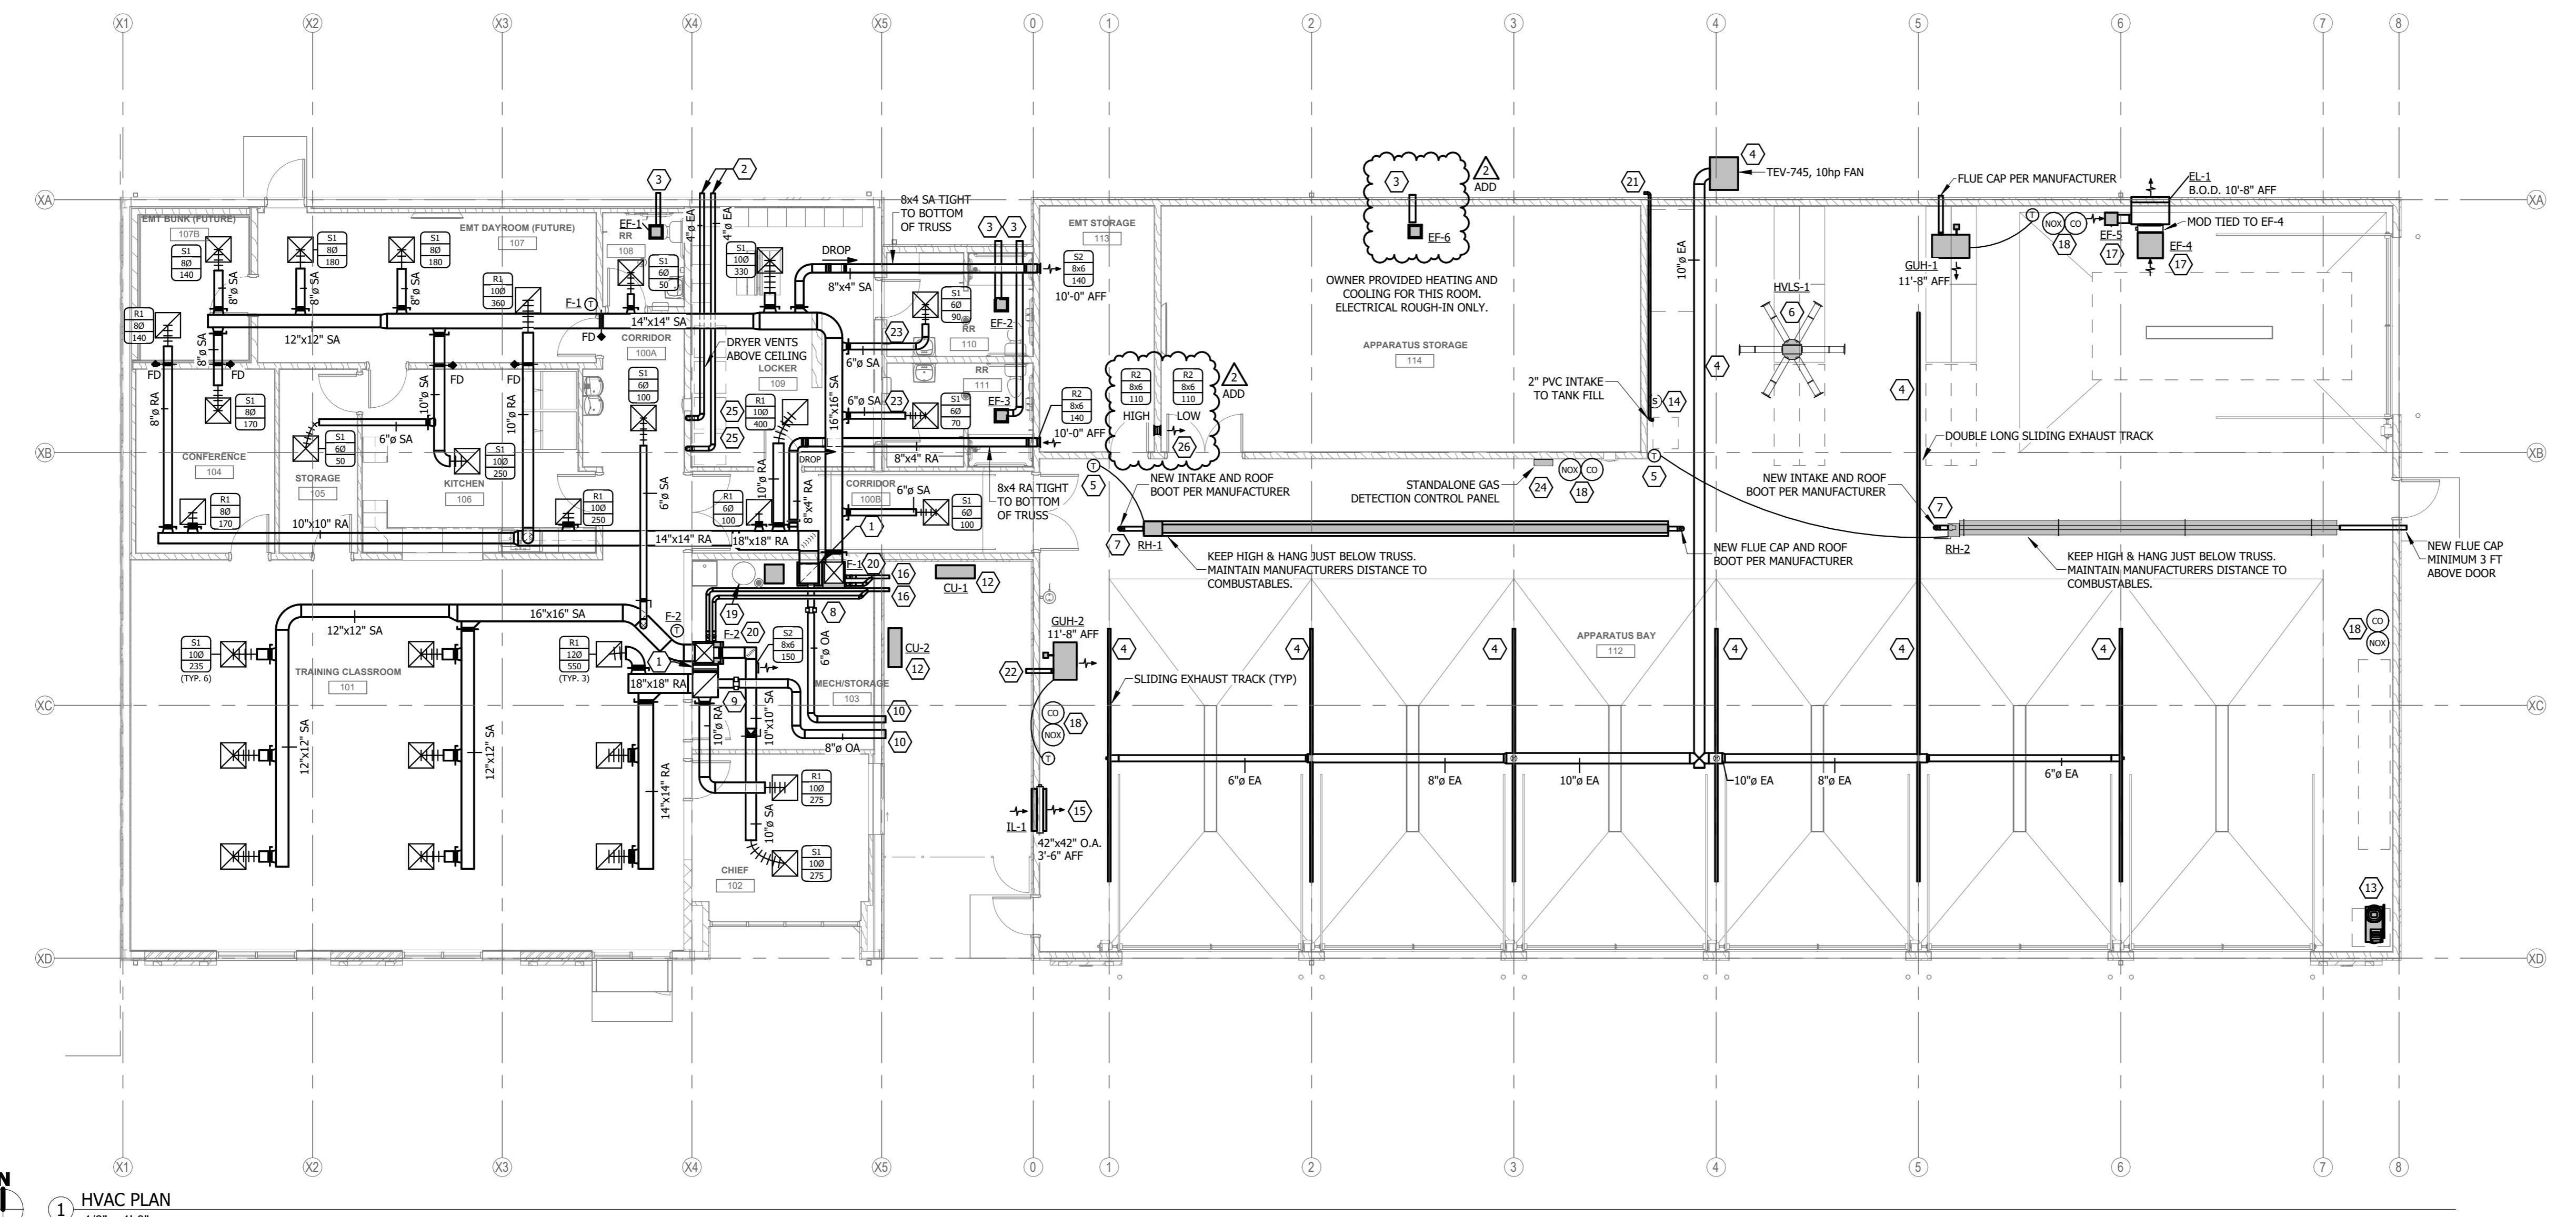

EXHAUST FAN SCHEDULE												
UNIT TAG	MANUFACTURER	MODEL	SERVES	AIRFLOW (CFM)	ESP (IN. WG)	MOTOR WATTS	FAN SPEED (RPM)	DRIVE TYPE	_SOUND LEVEL (SONES)	MCA	MOP	V/C/P
EF-1	BROAN	QTXE6090	BATHROOMS	80	0.10	23.9	-	DIRECT	0.4	0.2	20	115/60/1
EF-2	BROAN	QTXE6110	BATHROOMS	110	0.10	23.9	-	DIRECT	0.4	0.3	20	115/60/1
EF-3	BROAN	QTXE6110	BATHROOMS	110	0.10	23.9	-	DIRECT	0.4	0.3	20	115/60/1
EF-4	GREENHECK	SQ-160-VG	APPARATUS BAY PURGE	4000	0.35	2 HP	1473	DIRECT	18.7	15.6	25	208/60/1
EF-5	BROAN	L300EL	APPARATUS BAY CONSTANT	265	0.125	0.2 AMPS	1256	DIRECT	5	0.2	20	115/60/1
EF-6	BROAN	QTXE6110	STORAGE 114	110	0.10	23.9	-	DIRECT	0.4	0.3	20	115/60/1

NOTES:  
1. PROVIDE AND INSTALL NEOPRENE ISOLATION HANGERS OR OPEN SPRING ISOLATION HANGERS FOR EF-4 & EF-5.  
2. EF-1, EF-2, EF-3, EF-6 SHALL OPERATE WITH WALL SWITCH. REFER TO ELECTRICAL PLANS.  
3. EF-4 SHALL BE CONTROLLED BY GAS DETECTION CONTROL PANEL.  
4. PROVIDE A MOTORIZED CONTROL DAMPER WITH EF-4 TO OPEN WITH EF-4 IS RUNNING AND CLOSED WHEN EF-4 IS OFF.  
5. EF-5 SHALL RUN CONTINUOUSLY.

ADD

FURNACE SCHEDULE															
UNIT TAG	MANUFACTURER	MODEL	FAN SECTION			GAS HEATING SECTION			COOLING PERFORMANCE			ELECTRICAL			
			AIRFLOW (CFM)	ESP (IN. WG)	HP	FILTER	FUEL	INPUT CAPACITY	OUTPUT CAPACITY	STAGES	TOTAL CAPACITY (MBH)	STAGES	MCA	MOCP	VOLTAGE/PHASE
F-1	DAIKIN	DR96TN0804CN	1800	0.6	.75	MERV 8	GAS	80	76.8	TWO	53	VARIABLE	11.4	20	120/1
F-2	DAIKIN	DR96TN1005CN	1995	0.6	1	MERV 8	GAS	100	96	TWO	53	VARIABLE	14.4	25	120/1

NOTES:  
1. PROVIDE AND INSTALL WITH DAIKIN AHRI MATCHED CASED COIL WITH ELECTRONIC EXPANSION VALVE.  
2. PROVIDE AND INSTALL DAIKIN ONE THERMOSTAT. SET TARGET HUMIDITY TO 50%. COORDINATE FINAL LOCATIONS WITH OWNER PRIOR TO INSTALLATION.  
3. PROVIDE AND INSTALL CONCENTRIC WALL VENT KITS.

GAS UNIT HEATER SCHEDULE												
UNIT TAG	MANUFACTURER	MODEL	FAN SECTION			HEATING SECTION			ELECTRICAL			VOLTAGE/PHASE
			AIRFLOW (CFM)	TEMP RISE	FUEL	INPUT CAPACITY (MBH)	OUTPUT CAPACITY (MBH)	STAGES	MCA	MOCP	VOLTAGE/PHASE	
GUH-1	MODINE	PTP	2140	53	NAT. GAS	150	123	SINGLE	-	15	120/1	
GUH-2	MODINE	PTP	2140	53	NAT. GAS	150	123	SINGLE	-	15	120/1	

NOTES:  
1. PROVIDE FACTORY WALL OR CEILING HANGER KIT.  
2. PROVIDE FACTORY DISCONNECT.  
3. PROVIDE STANDALONE WALL MOUNTED THERMOSTAT FOR EACH UNIT.

LOUVER SCHEDULE												
UNIT TAG	MANUFACTURER	MODEL	UNIT SERVED	FACE VELOCITY (FPM)	AIFLOW (CFM)	PRESSURE DROP (IN WG)	LOUVER WIDTH (IN)	LOUVER HEIGHT (IN)	FREE AREA (SQ FT)			
EL-1	RUSKIN	ELF520DD	EF-4	909	4000	0.21	36	36	4.40			
IL-1	RUSKIN	ELF520DD	PURGE INTAKE	643	4000	0.10	42	42	6.22			


NOTES:  
1. CUSTOM COLOR SELECTION BY ARCHITECT. COLOR SHALL MATCH METAL SIDING.

RADIANT HEATER SCHEDULE												
UNIT TAG	MANUFACTURER	MODEL	HEATING SECTION			ELECTRICAL			VOLTAGE/PHASE			
			FUEL	INPUT CAPACITY (MBH)	STAGES	MCA	MOCP	VOLTAGE/PHASE				
RH-1	DETROIT RADIANT	DES3-30-75	NAT. GAS	75	ONE	4.8	15	120/1				
RH-2	DETROIT RADIANT	DES3-40-75	NAT. GAS	75	ONE	4.8	15	120/1				

GRILLES, REGISTERS, AND DIFFUSERS SCHEDULE												
UNIT TAG	MANUFACTURER	MODEL	MATERIAL	SYSTEM TYPE	NECK SIZE	FACE SIZE	RANGE	MAX N.C.	NOTE			
S1	TITUS	OMNI	STEEL	SUPPLY	SEE DWG	24x24	SEE DWG	20	1,2			
S2	TITUS	300FL	ALUMINUM	SUPPLY	8x6		SEE DWG	20	1			
R1	TITUS	OMNI	STEEL	RETURN	SEE DWG	24x24	SEE DWG	20	1,2			
R2	TITUS	301FL	ALUMINUM	RETURN	8x6	-	SEE DWG	20	1			

NOTES:  
1. COLOR TO BE WHITE UNLESS OTHERWISE NOTED ON PLANS.  
2. VERIFY CEILING TYPE WITH ARCHITECTURAL PLANS FOR BORDER TYPE NEEDED PRIOR TO ORDERING.

CONDENSING UNIT SCHEDULE												
UNIT TAG	MANUFACTURER	MODEL	CAPACITY (MBH)	REFRIGERANT	COMPRESSOR TYPE	CAPACITY STEPS	MCA	MOCP	VOLTAGE/PHASE	WEIGHT (LBS)		
CU-1	DAIKIN	DC6VS	45.5	R-32	SWING	VARIABLE	31.8	35	208/1	163		
CU-2	DAIKIN	DC6VS	53.5	R-32	SWING	VARIABLE	37.5	40	208/1	174		

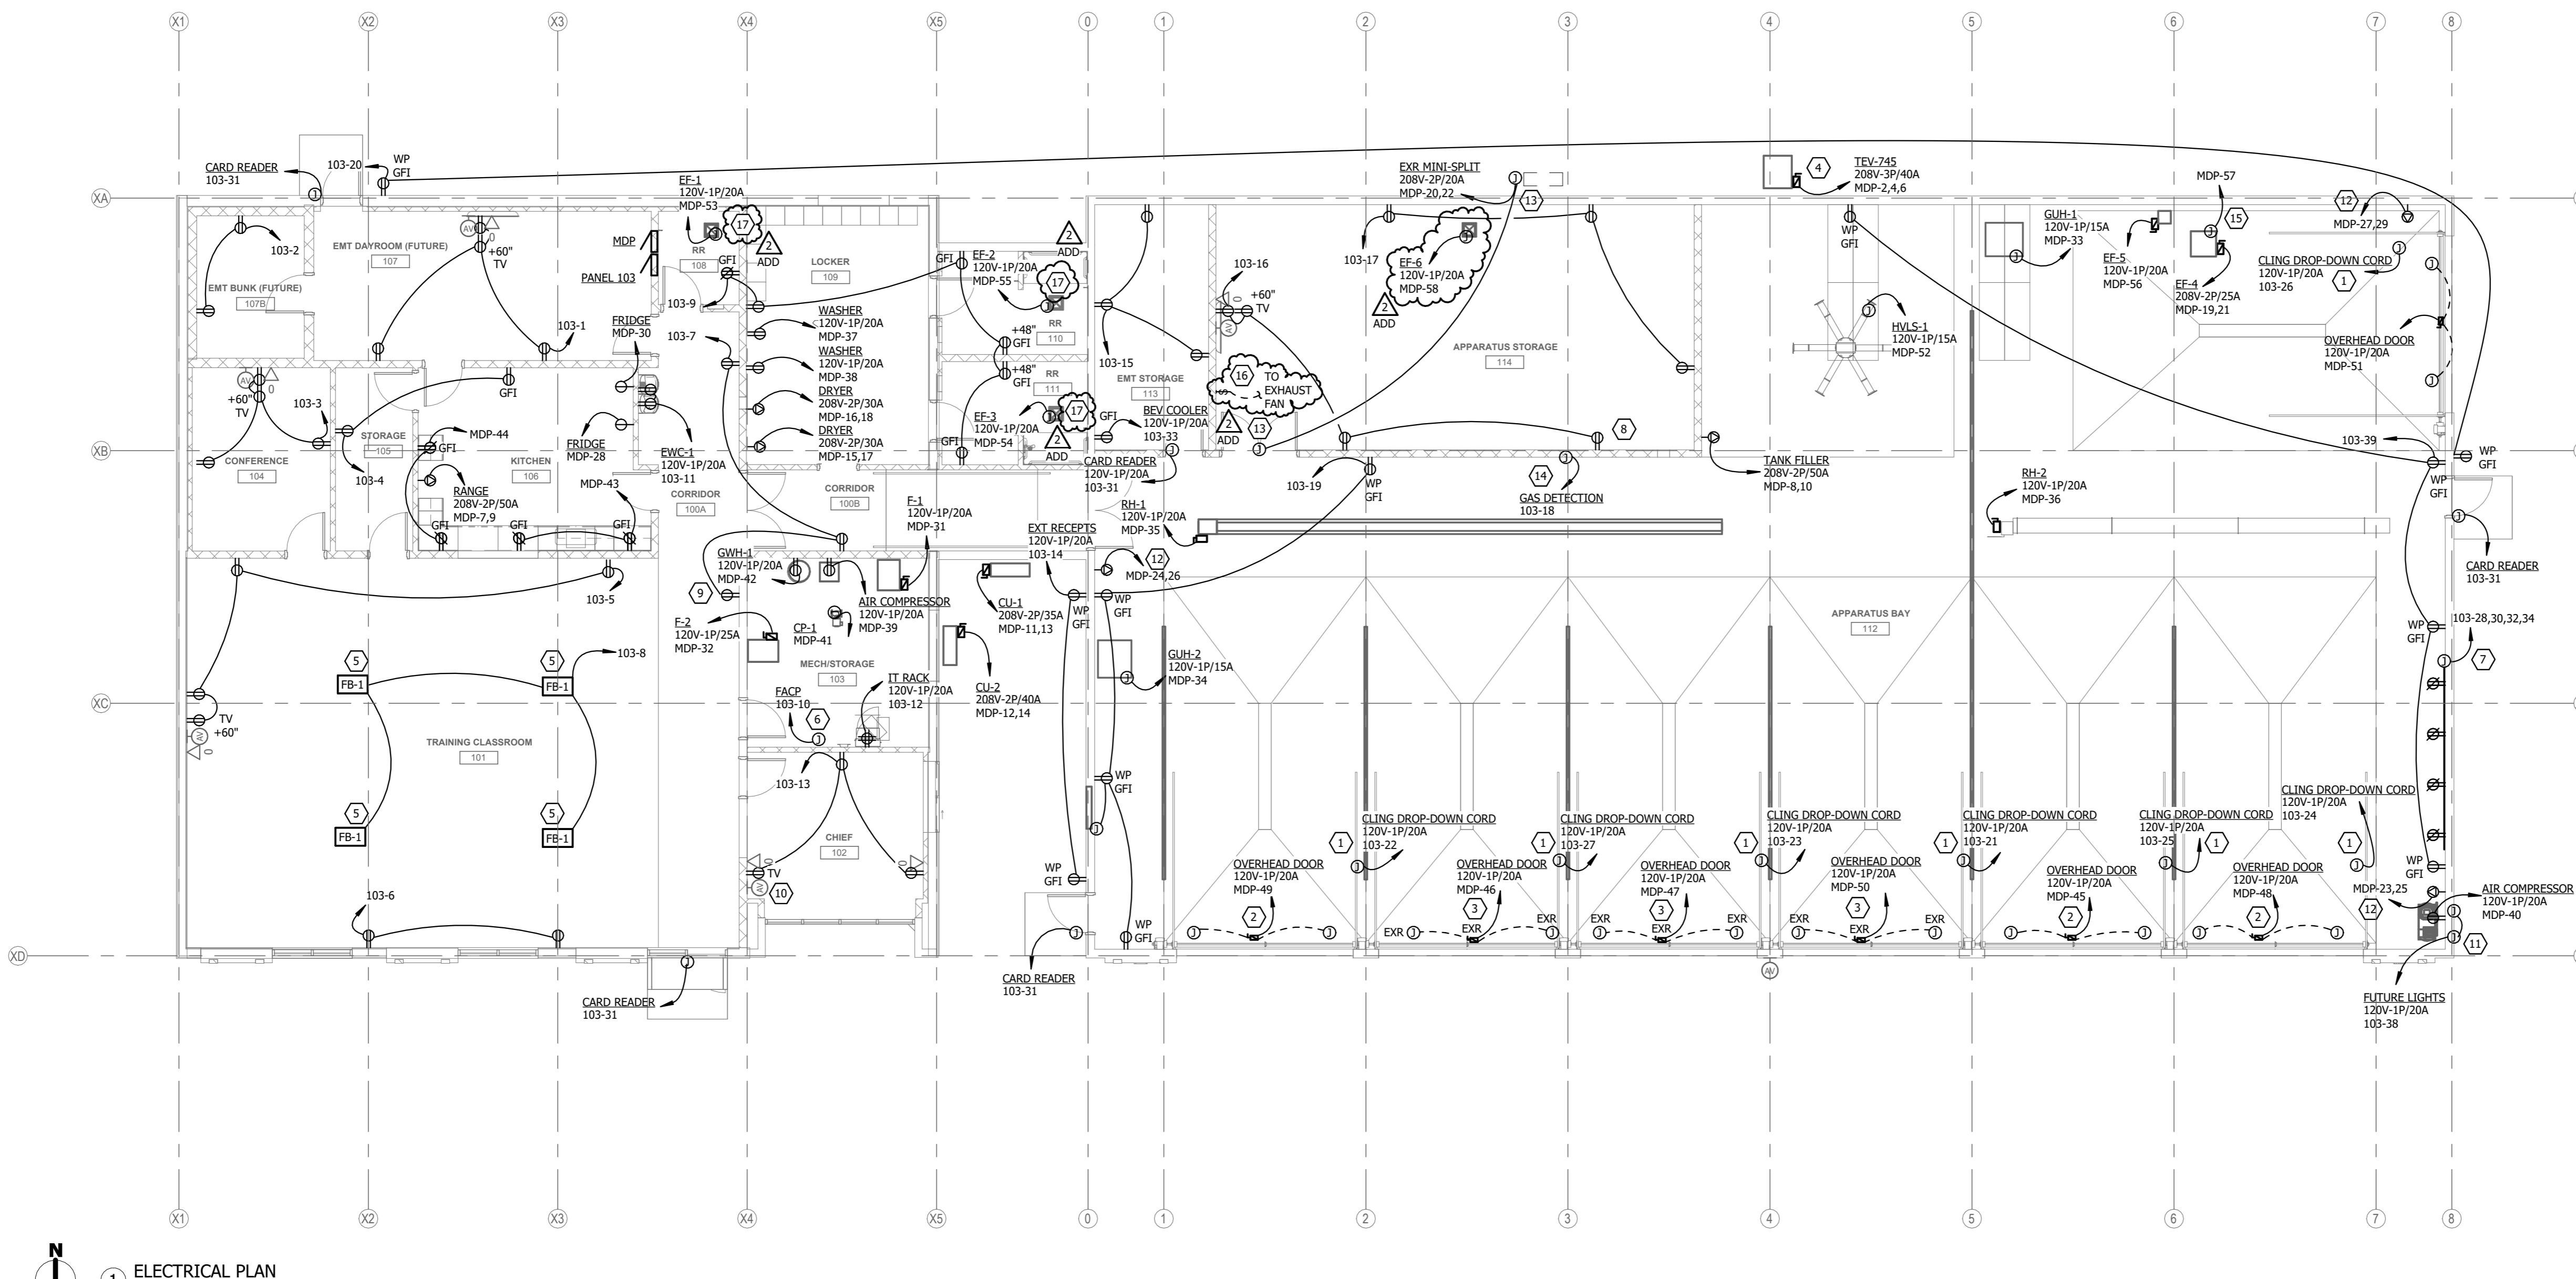

**GENERAL NOTES:**

ALL DISCONNECTS ON MECHANICAL EQUIPMENT SHALL BE MOUNTED ON STRUCTURE TO ALLOW REMOVAL OF THE EQUIPMENT FOR MAINTENANCE WITH A MINIMUM OF WIRING WORK. VERIFY NEC CLEARANCE REQUIREMENTS ARE MET PRIOR TO ROUGH-IN.

MAINTAIN SERVICE CLEARANCE AROUND ALL MECHANICAL & ELECTRICAL EQUIPMENT. DO NOT ROUTE PIPING OR CONDUIT IN CLEARANCE SPACE.

SURFACE RACEWAY AND CONDUIT SHALL NOT BE USED IN ANY FINISHED AREAS WITHOUT PRIOR APPROVAL FROM THE ENGINEER AND ARCHITECT.

ALL RECEPTACLE CIRCUITS SHALL HAVE DEDICATED NEUTRALS.

INSTALL DEVICES SUCH THAT NO TWO DEVICES ON OPPOSITE SIDES OF SAME WALL ARE WITHIN 6" OF EACH OTHER.

PROVIDE CONDUIT SLEEVES WITH INSULATED BUSHINGS SERVING ALL LOW VOLTAGE CABLING. DO NOT EXCEED 40% FILL.

PRIOR TO ROUGH-IN, COORDINATE ALL WALL DEVICES WITH FINAL CASEWORK ELEVATIONS AND OTHER TRADES. CONFLICTS SHALL BE BROUGHT IMMEDIATELY TO THE ATTENTION OF THE ENGINEER AND ARCHITECT.

ALL FLOOR BOXES SHALL HAVE THEIR EXACT ROUGH-IN LOCATION DETERMINED BY DESIGN TEAM THROUGH DIMENSIONED DRAWINGS SIGNED BY OWNER PRIOR TO ROUGH-IN. LOCATIONS SHOWN ARE FOR BIDDING PURPOSES ONLY.

PROVIDE AN ADDITIONAL 20A-1P BREAKER IN LOCAL PANEL FOR

139 4th Street  
Des Moines, Iowa 50265


THE PROJECT AND LOCATIONS  
FOR THIS PROJECT AND SHALL NOT BE  
USED ON ANY OTHER PROJECTS OR IN  
ANY OTHER LOCATIONS WITHOUT  
OBTAINING PRIOR WRITTEN CONSENT  
OF MELEF, LL, UNAUTHORIZED  
REPRODUCTION IS PROHIBITED.

ADDRESS: 109 E MAIN STREET; STATE CENTER, IA 50241  
CLIENT: STATE CENTER FIRE DEPARTMENT

L POWER F

HEET NAME: **ELECTRIC**

## 1.1

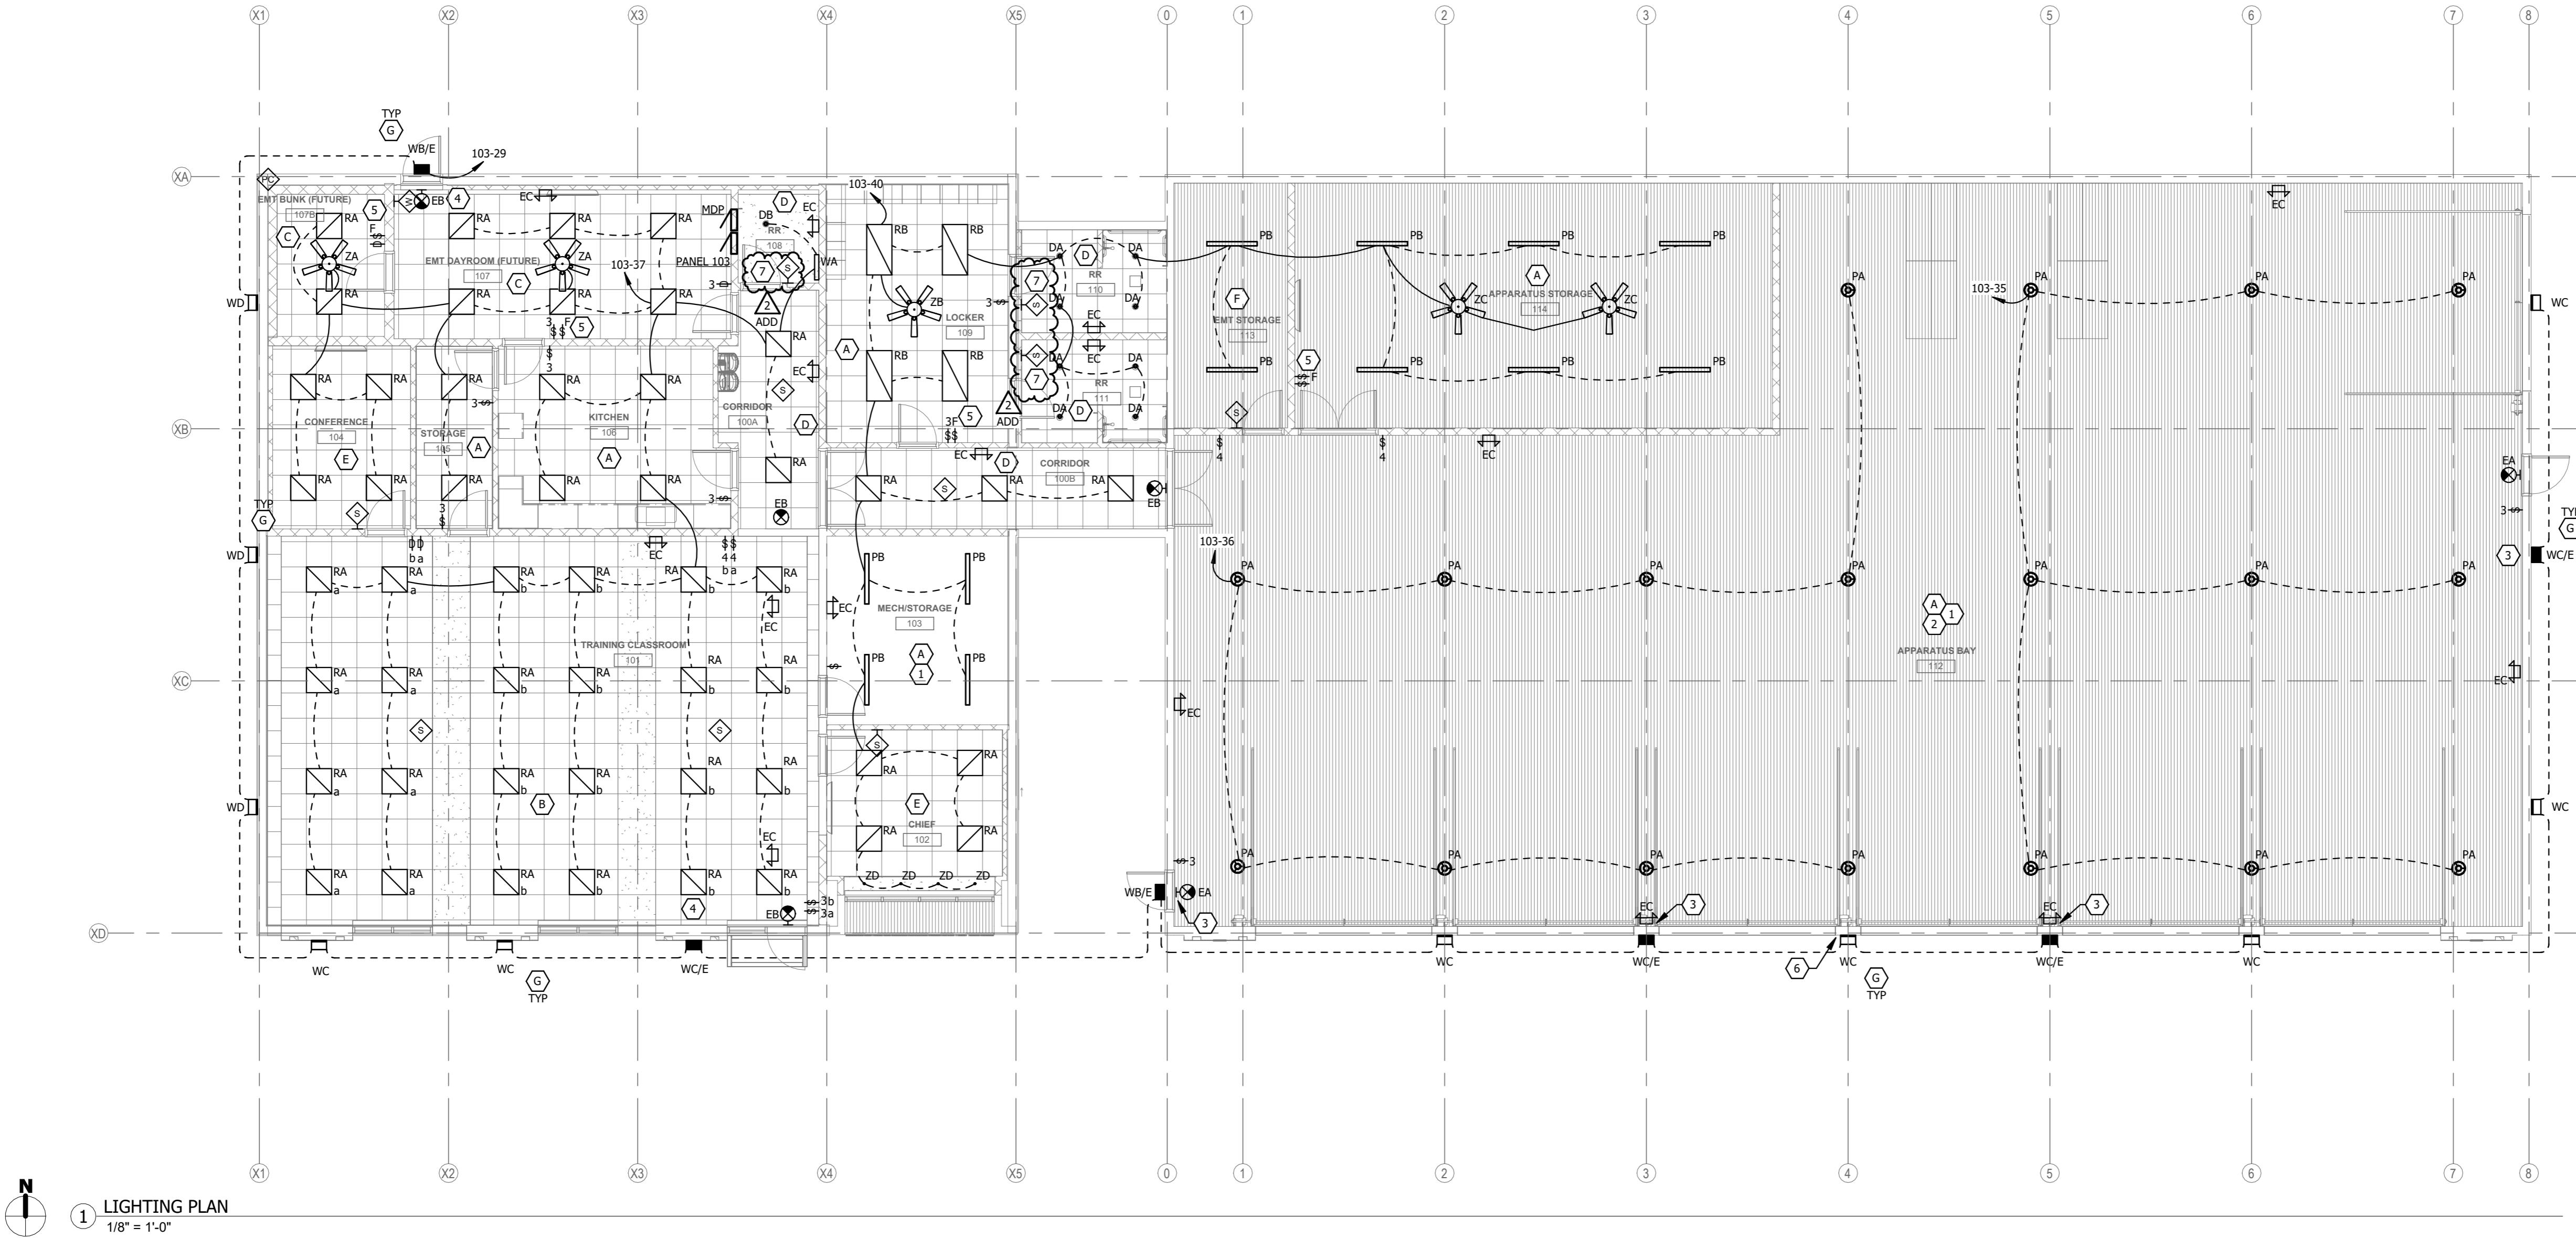

1 LIGHTING PLAN  
1/8" = 1'-0"

#### LIGHTING GENERAL NOTES:

- A. SURFACE RACEWAY SHALL NOT BE USED IN ANY FINISHED AREAS WITHOUT PRIOR APPROVAL FROM THE ENGINEER.
- B. INSTALL DEVICES SUCH THAT NO TWO DEVICES ON OPPOSITE SIDES OF SAME WALL ARE WITHIN 6" OF EACH OTHER.
- C. COORDINATE ALL DEVICES WITH ARCHITECTURAL PLANS AND CASEWORK SUBMITTALS.
- D. ALL LIGHTING FIXTURES SHALL BE INSTALLED IN SUCH WAY THAT DRIVERS ARE ACCESSIBLE WITHOUT CUTTING OF CEILING. THE ENGINEER SHALL BE NOTIFIED IMMEDIATELY OF AREAS WHERE THIS IS NOT POSSIBLE.
- E. ALL WALL-MOUNTED LIGHTING FIXTURES SHALL HAVE EXACT ROUGH-IN LOCATION DETERMINED BY DESIGN TEAM PRIOR TO ROUGH-IN.
- F. THE ELECTRICAL CONTRACTOR SHALL EXTEND AN "UNSWITCHED" HOT CONDUCTOR FROM THE NEAREST NORMAL LIGHTING CIRCUIT TO EVERY UL924 LISTED EMERGENCY LIGHT AND EXIT SIGN REQUIRED FOR EMERGENCY EGRESS OPERATION. THE "UNSWITCHED" HOT CONDUCTOR SHALL BE USED FOR SENSING PURPOSES ONLY.
- G. UNLESS NOTED OTHERWISE BY DESIGNATED "LIGHTING CONTROL ZONES", SWITCHLEG WIRING, AND LOWERCASE LETTER SWITCHLEG TAGS, SWITCHES SHOWN WILL CONTROL ALL FIXTURES IN THE ROOM SHOWN.
- H. ALL LIGHTING CONTROL SHALL OPERATE "MANUAL ON/AUTO OFF" PER CODE (ECC OR ASHRAE 90.1) UNLESS OTHERWISE NOTED IN THE SEQUENCE OF OPERATIONS OR THESE REFERENCE NOTES.
- I. REFER TO ARCHITECTURAL ELEVATIONS AND REFLECTED CEILING PLANS FOR SPECIFIC DEVICE LOCATIONS AND PLACEMENT. ANY DEVIATIONS FROM THE ARCHITECTURAL ELEVATIONS AND RCP'S SHALL BE APPROVED BY THE ARCHITECT PRIOR TO ROUGH-IN. IF A DEVICE IS REQUIRED PER SPECIFICATION, REQUIRED FOR OPERATION, OR IS DIFFERENT IN CONFIGURATION THAN SHOWN ON ELEVATIONS AND RCP'S, CLARIFICATION AND APPROVAL MUST BE GIVEN BY THE ARCHITECT BEFORE ROUGH-IN. DEVIATIONS FROM APPROVED DEVICE LOCATIONS APPROVED PRIOR TO INSTALLATION SHALL BE CORRECTED AT CONTRACTORS EXPENSE. THIS INCLUDES BUT IS NOT LIMITED TO THERMOSTATS, CONTROL SYSTEM SENSORS, ELECTRICAL DEVICES, SWITCHES, DIMMERS, TECHNOLOGY DEVICES, A/V DEVICES, SPEAKERS, FIRE ALARM DEVICES, ETC.
- J. CEILING CONTRACTOR SHALL PROVIDE AND INSTALL CEILING ACCESS PANELS FOR ACCESSIBILITY TO ELECTRICAL JUNCTION BOXES, PLUMBING VALVES, BALANCING DAMPERS, CIRCUIT SETTERS, ETC. WHERE ABSOLUTELY NECESSARY, LOCATIONS WILL NEED TO BE APPROVED AND COORDINATED WITH THE DESIGN TEAM PRIOR TO INSTALLATION.
- K. REFER TO ARCHITECTURAL EXTERIOR ELEVATIONS FOR WALLPACK LIGHTING HEIGHTS AFG.
- L. SENSORS SHALL BE INSTALLED CENTERED IN CEILING TILES WHERE APPLICABLE.
- M. EXISTING SITE LIGHTING TO BE REMOVED AS WORK BY THE CITY. ELECTRICAL CONTRACTOR SHALL COORDINATE WITH THE CITY TO AVOID INTERRUPTING THIS WORK.

#### LIGHTING REFERENCED NOTES:

(NOT ALL NOTES MAY BE APPLICABLE TO THIS SHEET)

1. COORDINATE LIGHTING MOUNTED IN THIS AREA WITH MECHANICAL EQUIPMENT. LIGHTING SHALL BE MOUNTED BELOW EQUIPMENT AT ALL TIMES. OFFSET AS REQUIRED. REFER TO ARCHITECTURAL ELEVATIONS FOR INSTALLATION HEIGHTS.
2. COORDINATE FINAL LIGHT LOCATIONS WITH DESIGN TEAM PRIOR TO FINAL INSTALLATION. OFFSET AS NEEDED FOR MECHANICAL EQUIPMENT AND PLYMVENT SYSTEM. LIGHTS SHALL BE INSTALLED WITH SURFACE BRACKET TO BOTTOM OF METAL LID, UNLESS DIRECTED OTHERWISE BY DESIGN TEAM. THERE SHALL BE A PRE-INSTALLATION MEETING FOR CEILING SYSTEMS IN THE APPARATUS BAY.
3. REMOTE BACKUP BATTERY SERVING EXTERIOR EMERGENCY LUMINAIRE SHALL BE INSTALLED ON INTERIOR WALL AT AN ACCESSIBLE LOCATION BEHIND LUMINAIRE. COORDINATE WITH OTHER EQUIPMENT OR WALL DEVICES.
4. REMOTE BACKUP BATTERY SERVING EXTERIOR EMERGENCY LUMINAIRE SHALL BE INSTALLED ABOVE CEILING AT AN ACCESSIBLE LOCATION BEHIND LUMINAIRE.
5. FAN CONTROL DEVICE. DEVICE SHALL BE GANGED WITH LIGHTING CONTROL SWITCH. SEE LIGHTING FIXTURE SCHEDULE FOR MORE INFORMATION.
6. PROVIDE ROUGH-IN FOR FURNITURE SWING LIGHT. COORDINATE LOCATION WITH DESIGN TEAM PRIOR TO ROUGH-IN FOR FINAL COORDINATION OF EMERGENCY LIGHT LOCATION.
7. CONTROL DEVICE SHALL HAVE AN ADDITIONAL AUXILIARY RELAY FOR CONTROL OF RESTROOM EXHAUST FAN. EXHAUST FAN SHALL OPERATE WITH THE LIGHTING.

LIGHTING CONTROL - SEQUENCE OF OPERATION <span style="font-size: small;">(HEXAGONAL TAGS WITH LETTERS INDICATE LIGHTING CONTROL SEQUENCES)</span>			
TAG	ACTIVATION	DESCRIPTION	SCHEDULE
A	MANUAL ON / OFF	MANUAL LINE VOLTAGE TOGGLE SWITCH(ES). PROVIDE 3- OR 4-WAY SWITCHING AS SHOWN ON PLANS. TOGGLE SWITCH GANGED WITH CEILING FAN CONTROL WHERE APPLICABLE.	N/A
B	MANUAL ON / AUTO OFF w/ DIMMING	MANUAL ON / AUTO OFF w/ DIMMING VIA LINE VOLTAGE WALL CONTROL STATION WITH 0-10V CAPABILITY, LINE VOLTAGE TOGGLE SWITCHES, AND LINE VOLTAGE CEILING SENSOR(S). SEE LOWERCASE LETTER SWITCHLEG TAGS WHERE APPLICABLE.	30 MINUTE TIMEOUT
C	MANUAL ON / OFF w/ DIMMING	MANUAL ON / MANUAL OFF w/ DIMMING VIA LINE VOLTAGE WALL CONTROL STATION WITH 0-10V CAPABILITY. WALL CONTROL STATION GANGED WITH CEILING FAN CONTROL WHERE APPLICABLE.	N/A
D	AUTO ON / AUTO OFF	AUTO ON / AUTO OFF VIA LINE VOLTAGE WALL OR CEILING MOUNTED SENSOR(S), AS APPROPRIATE.	30 MINUTE TIMEOUT
E	MANUAL ON / AUTO OFF w/ DIMMING	MANUAL ON / AUTO OFF w/ DIMMING VIA LINE VOLTAGE WALL SENSOR / SWITCH COMBINATION DEVICE WITH 0-10V DIMMING CAPABILITY.	30 MINUTE TIMEOUT
F	MANUAL ON / AUTO OFF	MANUAL ON / AUTO OFF VIA LINE VOLTAGE WALL SENSOR / SWITCH COMBINATION DEVICE.	30 MINUTE TIMEOUT
G	AUTO ON / AUTO OFF	AUTO ON / AUTO OFF VIA LINE VOLTAGE PHOTOCELL.	DUSK TO DAWN

BRANCH MDP																				
Location: EMT DAYROOM (FUTURE)...			Volts: 120/208 Wye			S.C.C.R. Rating: 22,000 AIC														
Supply From: MOUNTING: Surface ENCLOSURE: DRY Enclosure Notes: Available Isc: 19,046 A PANEL SHALL BE RATED FOR SERVICE ENTRANCE																				
Mains Type: MCB Mains Rating: 400 A MCB Rating: 400 A SPD: NONE																				