



AUTHORIZATION TO OPERATE A SEWAGE DISPOSAL SYSTEM

FOLIO NUMBER **789-9975.005** DATE OF APPLICATION (Y/M/D) **24/10/94** NAME OF OWNER **GRIFFITHS, ART & GRETA** NAME OF CONTRACTOR **M. ONSORGE CONST. LTD.**

LEGAL DESCRIPTION OF LOT
**LOT 1, PLAN KAPS1311,
SEC 18, TWP 22, RANGE 11, W6M, KOYD**

STREET ADDRESS / GENERAL LOCATION
513, C228, RRI SORRENTO B.C.


INSTALLED AS PER REGULATIONS
☒ Yes ☐ No

SIGNATURE OF OWNER / APPLICANT

[Signature]

AS BUILT DIAGRAM : to be completed by the contractor or applicant

Scale
1 Box = 5'

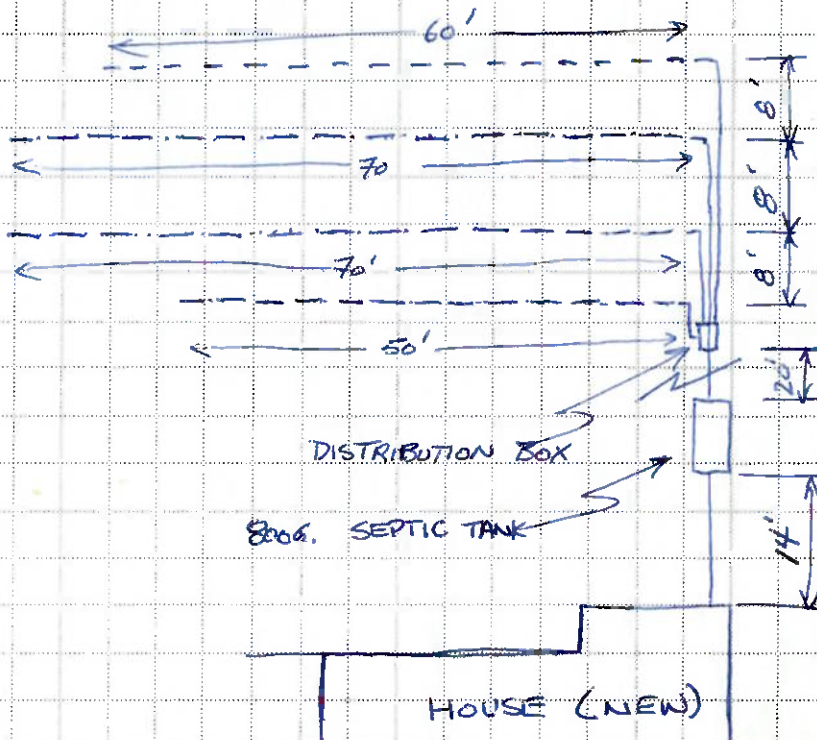

The Ministry of Health does not guarantee the useable life of the sewage disposal system. The life of the system is affected by the use and maintenance it receives. Pump out the septic tank every 2-3 years. For servicing of package treatment plants, consult your local service agent. For service guarantees, consult your local sewage disposal contractor. If the system needs repair or modification, a new permit is required.

If the system is not authorized for backfilling and if corrections are required, a re-inspection fee of \$100 must be paid for each time the Public Health Inspector checks to see that the faults have been corrected.

DATE BACKFILL / USE
AUTHORIZED

Nov. 24/94.

SUBJECT TO THE FOLLOWING CONDITIONS:

SIGNATURE PUBLIC HEALTH INSPECTOR / EHO:

Brian Gregory

FOR PUBLIC HEALTH INSPECTOR / EHO USE ONLY

APPROVED REJECTED NOT APPLICABLE

septic tank	☒	☐	☐
package treatment plant	☐	☐	☐
other (e.g. lagoon, holding tank)	☒	☐	☐
field laterals	☒	☐	☐
distribution box	☒	☐	☐
siphon	☐	☐	☐

APPROVED REJECTED NOT APPLICABLE

curtain drain	☐	☐	☐
interceptor drains	☐	☐	☐
pump	☒	☐	☐
drain rock	☒	☐	☐
set back distances	☒	☐	☐
fill	☐	☐	☐



Province of British Columbia Ministry of Health and Ministry Responsible for Seniors
PARCEL IDENTIFIER 018-569-323

APPLICATION FOR PERMIT TO CONSTRUCT
OR REPAIR A SEWAGE DISPOSAL SYSTEM

#94/317

FOLIO NUMBER 789-9975.005	DATE OF APPLICATION (D/M/Y) 24/10/94	☒ New Construction	☐ Repair	☐ Alteration
------------------------------	---	--	---------------------------------	-------------------------------------

OWNER

INFORMATION

Correspondence to be sent to
☐ owner

NAME OF OWNER
GRIFFITHS, Arthur W & Greta H.

TELEPHONE NUMBER
675-3434

MAILING ADDRESS
519, C228, RRI, SORRENTO, B.C.

Postal Code
V0E 2W0

APPLICANT

INFORMATION

Correspondence to be sent to
☒ applicant

NAME OF APPLICANT
ONSORGE CONSTRUCTION

TELEPHONE NUMBER

Number and Street
City
Postal Code

MAILING ADDRESS

LOT

INFORMATION

LEGAL DESCRIPTION OF WHERE DISPOSAL SYSTEM IS TO BE CONSTRUCTED

LOT 1, PLAN KAP51311, Sec 18, Twp 22, Range 11, W6M, KDYD

STREET ADDRESS / GENERAL LOCATION

618 ELSON ROAD, "SOUTHSHORE PLATEAU", SORRENTO W.

PREMISE

INFORMATION

SEWAGE DISPOSAL SYSTEM WILL SERVE:

☒ SINGLE FAMILY DWELLING ☐ DUPLEX

NUMBER OF BEDROOMS:

2

FINISHED BASEMENT

☐ Yes ☒ No

DO YOU INTEND TO ADD A BASEMENT SUITE OR MORE BEDROOMS IN THE FUTURE?

☒ Yes ☐ No

☐ OTHER (specify):

3 bedrm 2 300 GPD.

TOTAL LIVING AREA:

1630 s.f.

LOT SIZE:

3 acres (1.48 Ha)

ESTIMATED DAILY SEWAGE FLOW:

SYSTEM

INFORMATION

TYPE OF SEWAGE DISPOSAL SYSTEM:

☒ CONVENTIONAL

☐ ALTERNATE (E.G. ☐ PRIVY ☐ LAGOON, ☐ RAISED MOUNDS, ☐ SEEPAGE BED)

☐ DEEP TRENCH ☐ OTHER (specify):

SEPTIC TANK MANUFACTURER

Castall.

MATERIAL OF SEPTIC TANK

CONCRETE

LIQUID VOLUME OF TANK

800 gal.

TOTAL LENGTH OF DRAINAGE PIPE

250'

TYPE OF DRAINAGE PIPE:

☒ PVC ☐ OTHER (specify):

INSIDE DIAMETER OF PIPE

3"

IF PACKAGE TREATMENT PLANT IS PROPOSED GIVE:

MAKE

MODEL

TREATMENT CAPACITY

SEWAGE PUMP:

☐ YES

☐ NO

FIELD DOSE VOLUME PUMPED PER CYCLE:

ALTERNATE

INFORMATION

PRESSURE DISTRIBUTION PROPOSED

☐ YES ☐ NO

LAGOON SIZE

DEPTH OF CLAY SOIL

GARBURATOR

☐ YES ☐ NO

SITE

INFORMATION

SOIL DESCRIPTION

DEPTH OF SOIL: ☒ over 1.2 m (4 ft.) ☐ under 1.2 m (4 ft.) If under 1.2m (4 ft.), due to ☐ rock or ☐ clay at _____ ft. from surface.

DEPTH TO WATER TABLE: ☒ over 1.2 m (4 ft.) ☐ under 1.2 m (4 ft.) If under 1.2m (4 ft.) the depth is _____

PERC TESTS

SLOWEST RATE FROM test hole #1 5 min./2.5 cm (1 inch) test hole #2 8 min./2.5 cm (1 inch)

AVERAGE OF SLOWEST RATE FROM EACH TEST HOLE 6 1/2 min./2.5 cm (1 inch)

WATER INFORMATION

SOURCES OF DOMESTIC WATER: Co-op WELL.

DISTANCES OF PROPOSED DISPOSAL FIELD FROM: 1000 ft. source of domestic water _____ breakout point

own well neighbouring wells stream or lake water lines

RESTRICTIVE

COVENANTS

ARE THERE ANY RESTRICTIVE COVENANTS WHICH WILL AFFECT THE DESIGN OR LOCATION OF THE SEWAGE DISPOSAL SYSTEM? ☐ Yes ☒ No
If Yes, explain

APPLICANT

SIGNATURE

The information on this application is accurate and true to the best of my knowledge:

☒ Owner or ☒ Agent

Signature

Date

X

Oct. 24/94

OFFICE USE ONLY

PAID:

DATE:

INITIALS:

A plot plan must be submitted with this application (refer to opposite page)

PERMIT TO CONSTRUCT, INSTALL, ALTER OR REPAIR

Pursuant to this application and the Sewage Disposal Regulations, permission is hereby granted to construct, install, alter, or repair the sewage disposal system on this property. This permit may be cancelled if variations are made to these plans and specifications.


Conditions of Permit: Field system consisting of 250 feet of perforated pipe (or 4x60') with a minimum of one foot rock underlay. Keep disposal field a minimum of 100 feet from any domestic well. 800 Gal Tank.

DATE PERMIT VALID <u>Oct. 25/94</u>	SIGNATURE OF PUBLIC HEALTH INSPECTOR / EHO <u>Brian Gregory</u>
FOR PUBLIC HEALTH INSPECTOR / EHO USE ONLY SITE EVALUATION ☒ file check ☒ application complete and consistent ☒ soil requirements met ☒ setback distances	SITE INFORMATION ☒ soil type <u>sand & gravel.</u> ☒ soil depth _____ ☒ water table _____ ☒ slope _____
COMMENTS <u>a recently approved subdivision</u>	

PLOT PLAN DRAWN TO SCALE (to be completed by the Applicant/Contractor)

PLOT PLAN CHECKLIST The following items should appear on the plot plan of the proposed system. Indicate which items have been included by checking the appropriate box.

- | | | | | |
|---|--|--|--|---|
| ☒ house (or house site)
☐ other buildings
☒ septic tank
☐ pkg. treatment plant
☒ disposal field
☒ drinking water sources
☒ yours ☐ adjacent neighbours
percentage of ground slope | ☐ water lines
☐ percolation test holes (2)
☐ observation test holes (2)
☐ surface water (creeks, streams, lakes)
☐ retaining wall
☒ "North" arrow
☐ direction of and | ☒ roadways
☐ patio / deck
☐ paved areas
☐ parking areas
☒ dimensions of lot
☒ property lines
☐ swimming pool | Distance from septic tank:
☐ to house
☐ to domestic water source
☐ to domestic water pipeline
☐ to perimeter of lot | Distance from disposal field (or lagoon/mound):
☐ to house
☐ to perimeter of lot
☐ to own well
☐ to neighbouring wells
☐ to surface water (springs, streams, creeks, etc.)
☐ to interceptor drains |
|---|--|--|--|---|

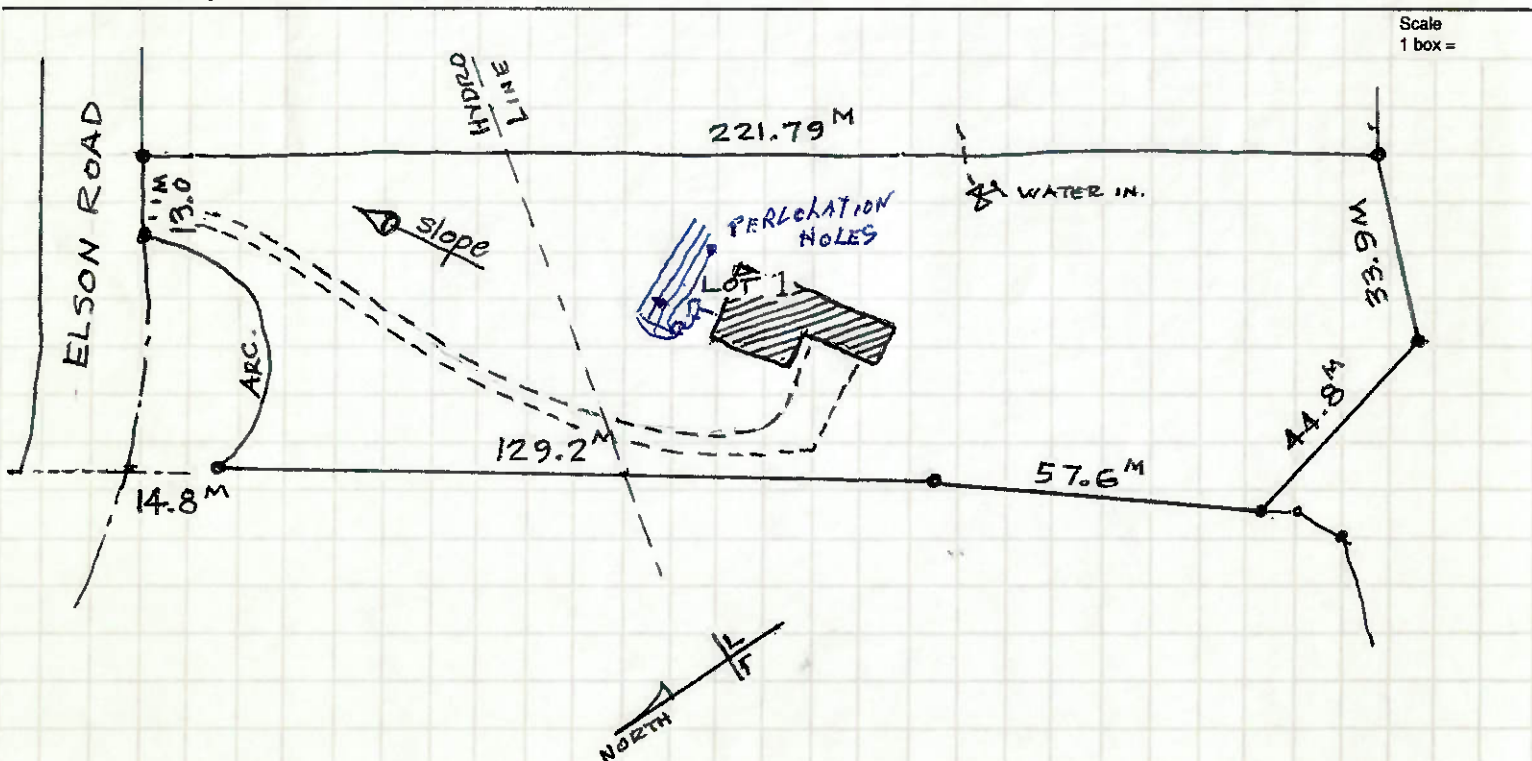

Scale
1 box =



Province of
British Columbia

Ministry of Health and
Ministry Responsible for Seniors

SEWAGE DISPOSAL SYSTEM
**SEWAGE APPLICATION
APPEAL INFORMATION**

The Environmental Appeal Board is established under section 11 of the Environment Management Act. Appeals are heard by a panel of the Board. This ensures that sewage permit application process is administered openly and fairly. It also provides the public the right to an independent appeal process.

If a person is aggrieved by the issue or the refusal of a permit for a sewage disposal system, they may appeal that ruling to the Environmental Appeal Board. On hearing an appeal, the Environmental Appeal Board may confirm, vary or rescind the ruling under appeal.

A person who is issued a permit must post a public notice, provided by the Ministry of Health, which must contain a site map, the conditions of the permit or authorization, a description of how an appeal of the decision to issue the permit or authorization is commenced, and a reference to the time period for commencing that appeal. The public notice must be posted in a conspicuous place(s) on the property not more than 3 days after the date it was issued and must remain posted for 30 days from the date it was issued.

In addition to posting a public notice if the estimated sewage flow is more than 4,546 litres (1000 I.G.) per day, a notice must be published in the newspaper in the area.

I understand that my neighbours or any other aggrieved parties have 30 days, from the date of issuance, to appeal the permit and that the permit may be overturned by the Environmental Appeal Board. I am prepared to accept full responsibility for any construction that I may do during this time should the Environmental Appeal Board uphold the appeal and revoke my permit.

and ~~for~~

I, as registered owner of the property, hereby authorize, ONSORGE CONSTRUCTION as my agent for the purpose of applying for a permit to construct and for the purpose of constructing my proposed sewage disposal system.

Legal description of property:

LOT 1 PLAN KAP51311 SECTION 18

DISTRICT Twp 22, R. 11, W6M STREET 618 ELSON ROAD
"SOUTHSHORE PLATEAU"

[Signature]
Signature of Registered Owner