


ALBERTA LAND SURVEYOR'S REAL PROPERTY REPORT

DETAILS
SCALE 1:250

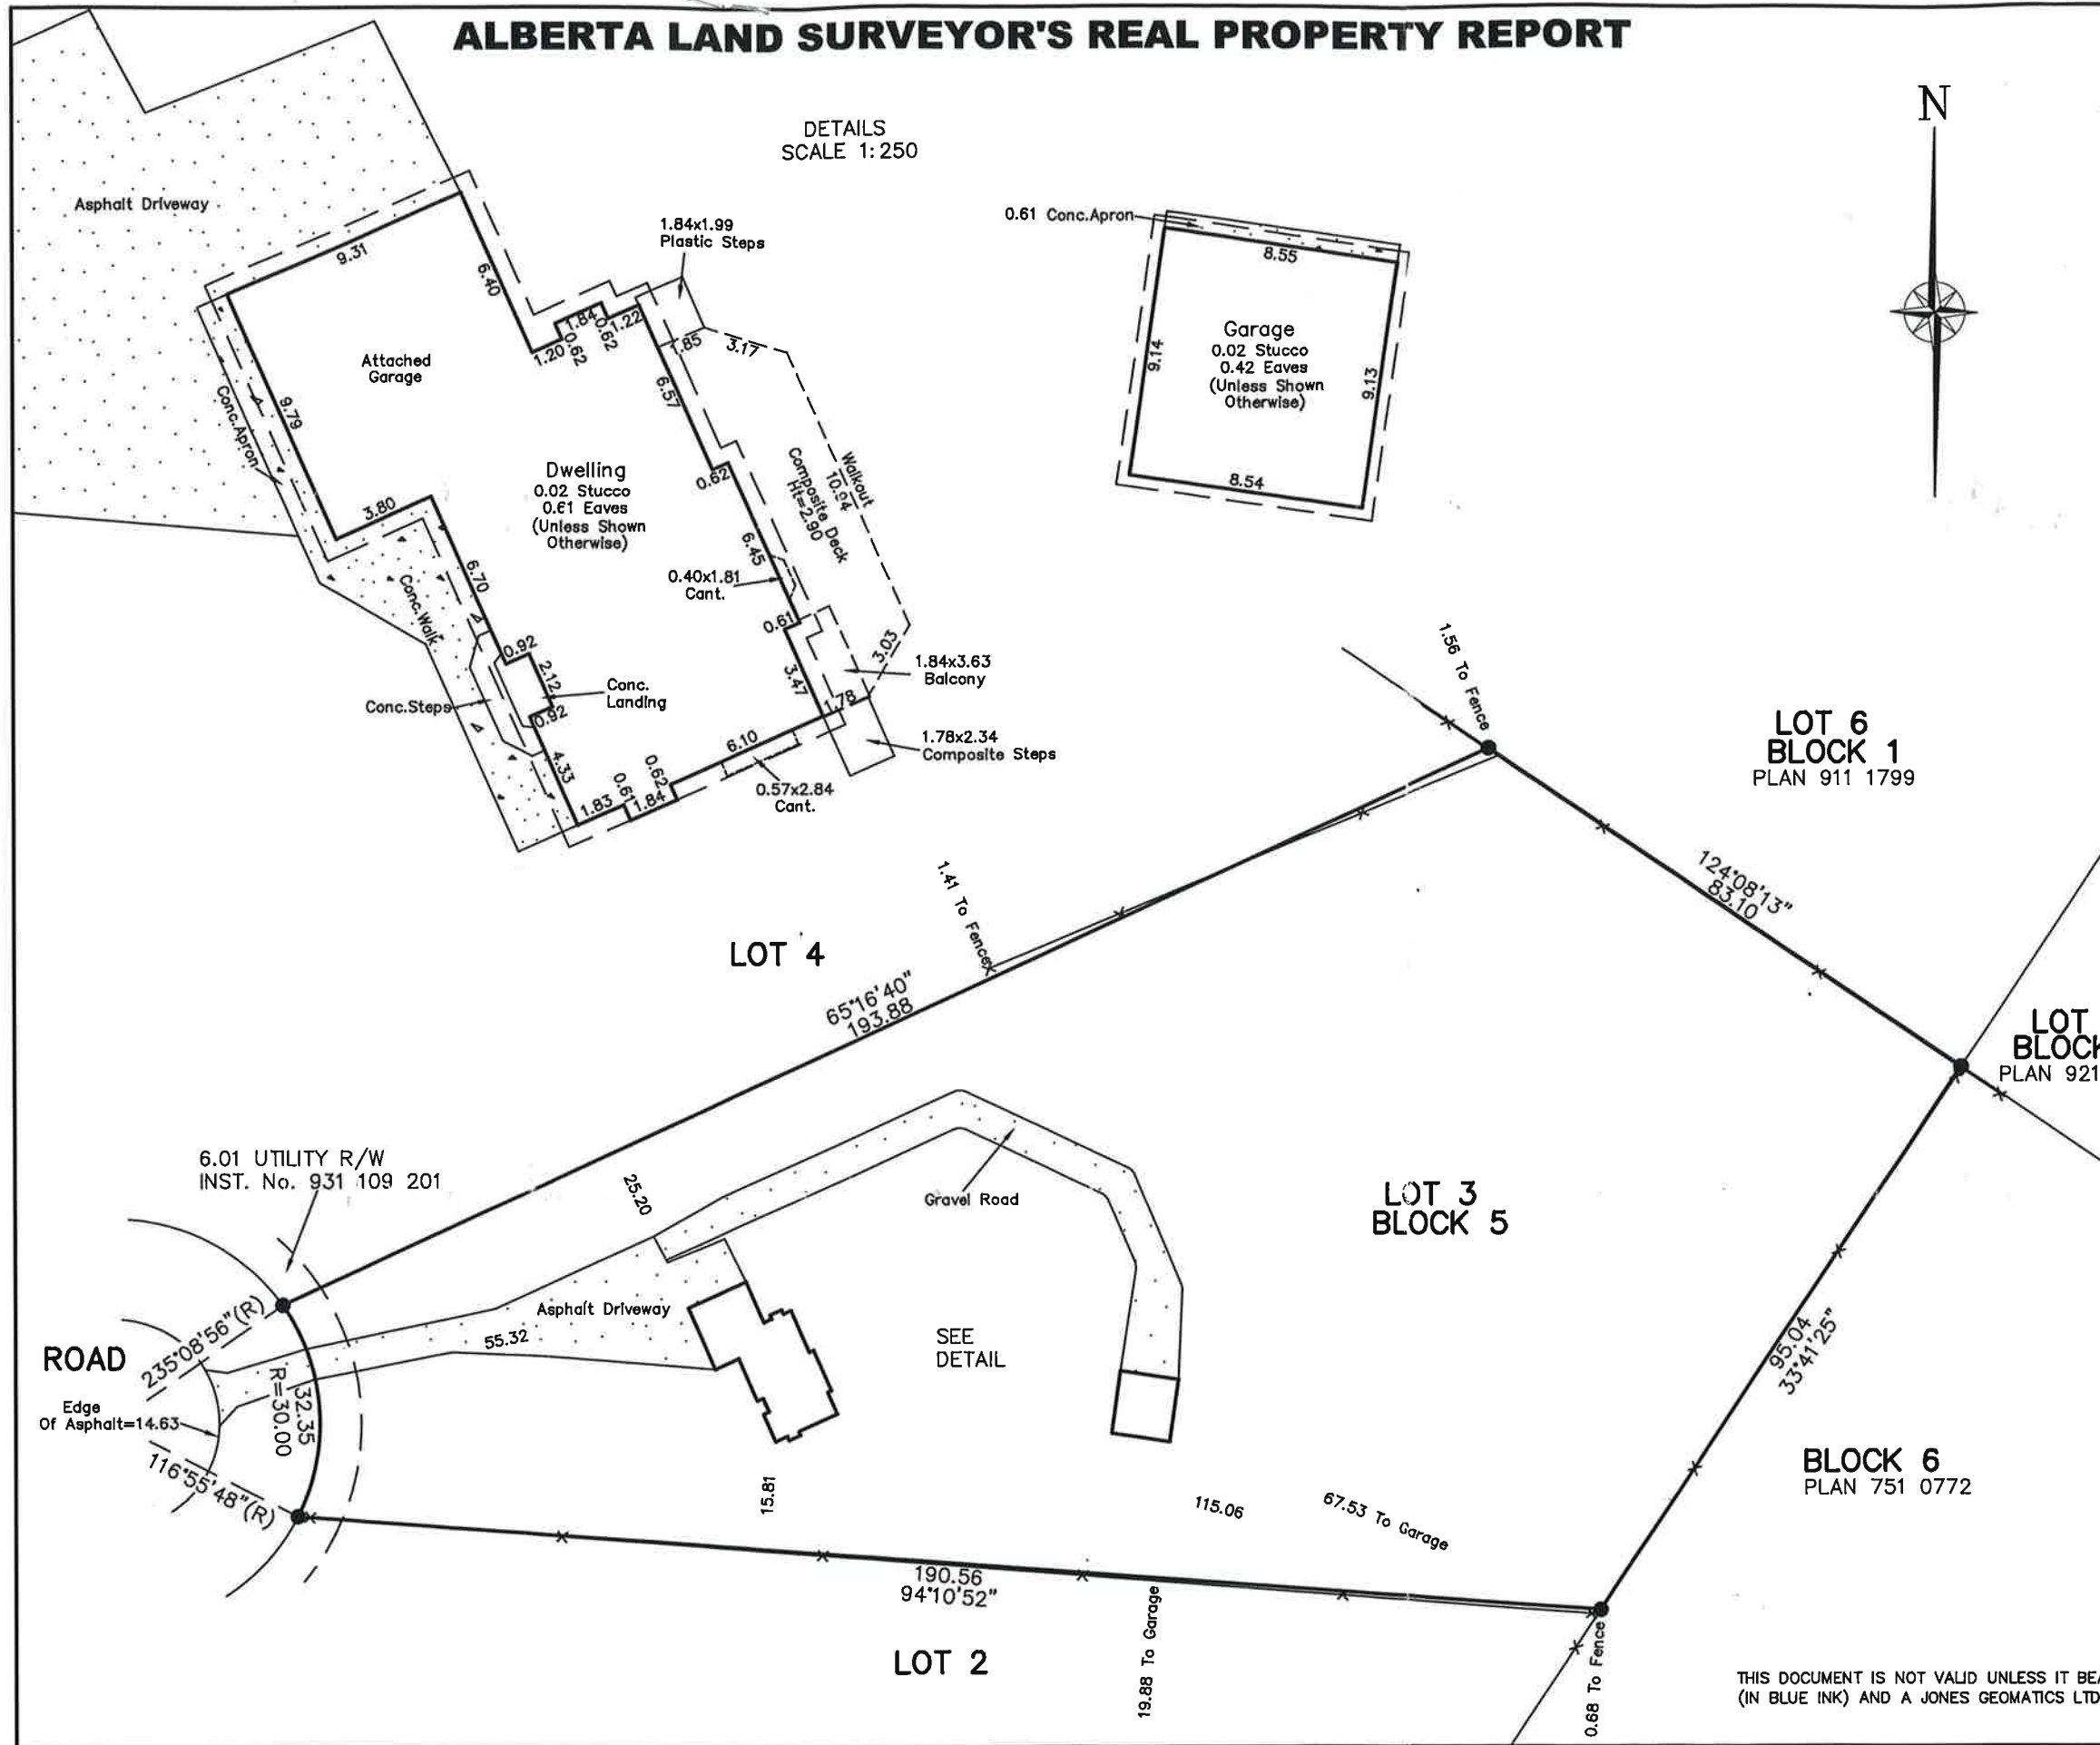

LEGAL DESCRIPTION:
LOT 3, BLOCK 5, PLAN 911 2112
MUNICIPAL ADDRESS:
M.D. OF FOOTHILLS No. 31, ALBERTA

CLIENT: **BARB DEGLOW**

SCALE = 1:1000 metric


CERTIFICATION:

I, R. KEVIN JONES, ALBERTA LAND SURVEYOR, DO HEREBY CERTIFY THAT:

1. THE SURVEY REPRESENTED BY THIS PLAN IS TRUE AND CORRECT AND WAS MADE UNDER MY PERSONAL SUPERVISION.
2. THE SURVEY WAS MADE IN ACCORDANCE WITH THE MANUAL OF STANDARD PRACTICE OF THE ALBERTA LAND SURVEYORS' ASSOCIATION. (MOVEABLE SHEDS NOT SHOWN)
3. THE SURVEY WAS COMPLETED ON THE 29TH DAY OF AUGUST, 2014
4. THE IMPROVEMENTS AS SHOWN ON THIS PLAN ARE ENTIRELY WITHIN THE BOUNDARIES OF THE SUBJECT PROPERTY.
5. NO VISIBLE ENCROACHMENTS EXIST ONTO THE SUBJECT PROPERTY FROM ANY IMPROVEMENT SITUATED ON AN ADJACENT PROPERTY.
6. NO VISIBLE ENCROACHMENTS EXIST ON REGISTERED EASEMENTS, RIGHTS-OF-WAY OR OTHER REGISTERED EASEMENTS AFFECTING THE THE EXTENT OF TITLE.

DATED THIS 5th DAY OF SEPTEMBER, 2014

R. KEVIN JONES, ALBERTA LAND SURVEYOR
© COPYRIGHT JONES GEOMATICS LTD., 2014

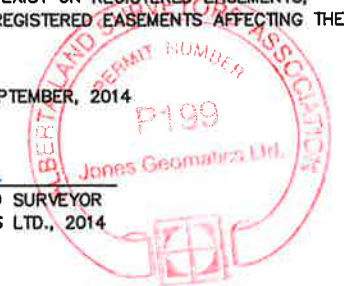

NOTES:

1. DISTANCES ARE IN METRES.
2. UNLESS OTHERWISE SPECIFIED, THE DIMENSIONS SHOWN RELATE TO PERPENDICULAR DISTANCES FROM PROPERTY BOUNDARIES TO FOUNDATION WALLS.
3. ALL EAVES SHOWN ARE DIMENSIONED FROM FOUNDATION TO FASCIA
4. ALL FENCES SHOWN ARE WITHIN 0.2 METRES OF THE PROPERTY LINES UNLESS OTHERWISE NOTED.
5. STATUTORY IRON POST FOUND THUS: ●
6. FOUND NO MARK IS SHOWN THUS: Fd. No Mk.
7. PROPERTY LINE IS SHOWN THUS: ————
8. FENCE LINE IS SHOWN THUS: —x—x—x—
9. TITLE INFORMATION IS BASED ON CERTIFICATE OF TITLE No. 071 583 996, TITLE SEARCH DATED 19/08/14
10. PROPERTY IS SUBJECT TO THE FOLLOWING INSTRUMENTS:
 -CAVEAT INST. No. 761 043 845 (DEFERRED RESERVE)
 -UTILITY R/W INST. No. 901 153 875
 -CAVEAT INST. No. 911 057 593 (R/W AGREEMENT)
 -RESTRICTIVE COVENANT INST. No. 911 247 964
 -PARTIAL DISCHARGE OF UTILITY R/W EXCEPT FOR PORTION DESCRIBED INST. No. 931 109 201

PURPOSE:
THIS REPORT AND RELATED PLAN HAVE BEEN PREPARED FOR THE BENEFIT OF THE PROPERTY OWNER, SUBSEQUENT OWNERS AND ANY OF THEIR AGENTS FOR THE PURPOSE OF (A LAND CONVEYANCE, SUPPORT OF A SUBDIVISION APPLICATION, A MORTGAGE APPLICATION, A SUBMITTAL TO THE MUNICIPALITY FOR A COMPLIANCE, CERTIFICATE, ETC.). COPYING IS PERMITTED ONLY FOR THE BENEFIT OF THESE PARTIES, AND ONLY IF THE PLAN REMAINS ATTACHED. WHERE APPLICABLE, REGISTERED EASEMENTS AND UTILITY RIGHTS OF WAY AFFECTING THE EXTENT OF THE PROPERTY HAVE BEEN SHOWN ON THE ATTACHED PLAN. UNLESS SHOWN OTHERWISE, PROPERTY CORNER MARKERS HAVE NOT BEEN PLACED DURING THE SURVEY FOR THIS REPORT. THE ATTACHED PLAN SHOULD NOT BE USED TO ESTABLISH BOUNDARIES DUE TO THE RISK OF MISINTERPRETATION OR MEASUREMENT ERROR BY THE USER. THE INFORMATION SHOWN ON THIS REAL PROPERTY REPORT REFLECTS THE STATUS OF THE PROPERTY AS OF THE DATE OF SURVEY ONLY. USERS ARE ENCOURAGED TO HAVE THE REAL PROPERTY REPORT UPDATED FOR FUTURE REQUIREMENTS.



Jones Geomatics Ltd.

Alberta Land Surveyor

20, 1323 44th Ave. N.E., Calgary, Alberta T2E 6L5

Ph. (403) 230-0778

Fax (403) 230-0714

E-mail: jonesgeo@telus.net

Job No. SI31095-14

THIS DOCUMENT IS NOT VALID UNLESS IT BEARS AN ORIGINAL SIGNATURE (IN BLUE INK) AND A JONES GEOMATICS LTD. PERMIT STAMP (IN RED INK)