



Province of British Columbia Ministry of Health and Ministry Responsible for Seniors


**AUTHORIZATION TO OPERATE A SEWAGE DISPOSAL SYSTEM**

FOLIO NUMBER: 789-07039.050 DATE OF APPLICATION (Y/M/D): AP. 10/95 NAME OF OWNER: DOUG AND GYNIS LYNN NAME OF CONTRACTOR: SANDY RIDGE CONST LTD.  
 LEGAL DESCRIPTION OF LOT: \_\_\_\_\_ STREET ADDRESS / GENERAL LOCATION: 2728 ROSDALE PLACE

LOT 10 PLAN 45826

INSTALLED AS PER REGULATIONS:  Yes  No SIGNATURE OF OWNER / APPLICANT: [Signature]

AS BUILT DIAGRAM: to be completed by the contractor or applicant

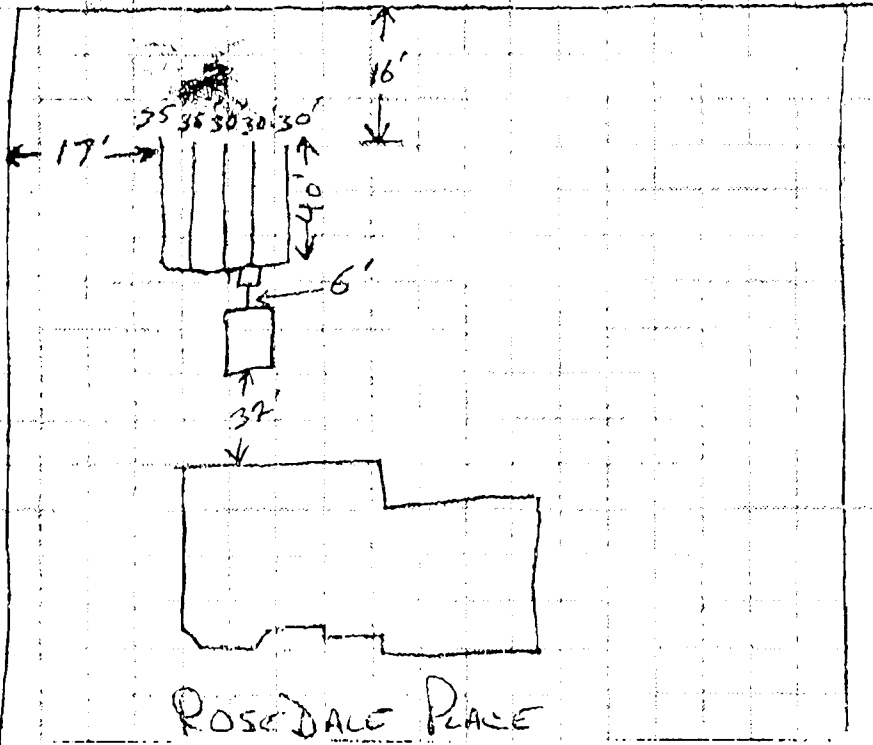

Scale 1 Box =

The Ministry of Health does not guarantee the useable life of the sewage disposal system. The life of the system is affected by the use and maintenance it receives. Pump out the septic tank every 2-3 years. For servicing of package treatment plants, consult your local service agent. For service guarantees, consult your local sewage disposal contractor. If the system needs repair or modification, a new permit is required. If the system is not authorized for backfilling and if corrections are required, a re-inspection fee of \$100 must be paid for each time the Public Health Inspector checks to see that the faults have been corrected.

DATE BACKFILL/USE AUTHORIZED: April 18/95 SUBJECT TO THE FOLLOWING CONDITIONS

SIGNATURE PUBLIC HEALTH INSPECTOR / EHO: [Signature: Brian Gregory]

FOR PUBLIC HEALTH INSPECTOR / EHO USE ONLY

	APPROVED	REJECTED	NOT APPLICABLE
septic tank	<input checked="" type="checkbox"/>	<input type="checkbox"/>	<input type="checkbox"/>
package treatment plant	<input type="checkbox"/>	<input type="checkbox"/>	<input type="checkbox"/>
other (e.g. in-pour, holding tank)	<input type="checkbox"/>	<input type="checkbox"/>	<input type="checkbox"/>
distribution box	<input checked="" type="checkbox"/>	<input type="checkbox"/>	<input type="checkbox"/>
siphon	<input type="checkbox"/>	<input type="checkbox"/>	<input type="checkbox"/>
curtain drain	<input type="checkbox"/>	<input type="checkbox"/>	<input type="checkbox"/>
interceptor drains	<input type="checkbox"/>	<input type="checkbox"/>	<input type="checkbox"/>
drain rock	<input checked="" type="checkbox"/>	<input type="checkbox"/>	<input type="checkbox"/>
set back distances	<input type="checkbox"/>	<input type="checkbox"/>	<input type="checkbox"/>



Province of British Columbia Ministry of Health and Ministry Responsible for Seniors

APPLICATION FOR PERMIT TO CONSTRUCT OR REPAIR A SEWAGE DISPOSAL SYSTEM

OWNER INFORMATION  
Correspondence to be sent to owner

FOLIO NUMBER: 2078907032050 DATE OF APPLICATION (Y/M/D): 95/04/10  
 New Construction  Repair  Alteration  
 NAME OF OWNER: Doug and Glynis Lynn City: [blank] Telephone Number: (604) 844-0926  
 Mailing Address: 1242 Chelsea Ave Port Coquitlam, B.C. V3B 7J9 Postal Code: [blank]  
 Telephone Number: [blank]

APPLICANT INFORMATION  
Correspondence to be sent to applicant

NAME OF APPLICANT: Sandy Ridge Const. Ltd. City: [blank] Postal Code: [blank]  
 Mailing Address: Box 531 Salmon Arm, B.C. V1E 4N6 Telephone Number: [blank]

LOT INFORMATION

LEGAL DESCRIPTION OF WHERE DISPOSAL SYSTEM IS TO BE CONSTRUCTED:  
 Lot 10 Plan 45826 Sec 17 Twp 22 R-10 W-6m

STREET ADDRESS / GENERAL LOCATION

2728 Rose Dale Place Blind Bay

PREMISE INFORMATION

SEWAGE DISPOSAL SYSTEM WILL SERVE:  
 SINGLE FAMILY DWELLING  DUPLEX  
 OTHER (specify): [blank]  
 ESTIMATED DAILY SEWAGE FLOW: 375  
 NUMBER OF BEDROOMS: 3 FINISHED EASEMENT:  Yes  No  
 DO YOU INTEND TO ADD A BASEMENT SUITE OR MORE BEDROOMS IN THE FUTURE?  
 Yes  No  
 TOTAL LIVING AREA: [blank] LOT SIZE: 43.985m x 44.425m

SYSTEM INFORMATION

TYPE OF SEWAGE DISPOSAL SYSTEM:  
 CONVENTIONAL  ALTERNATE (E.G.  TRENCH  LAGOON  RAISED MOUNDS  SEEPAGE BED)  
 DRAINAGE  OTHER (specify): [blank]  
 SEPTIC TANK MANUFACTURER: Costall LIQUID VOLUME OF TANK: 800  
 MATERIAL OF SEPTIC TANK: CONCRETE INSIDE DIAMETER OF PIPE: 3"  
 TOTAL LENGTH OF DRAINAGE PIPE: 160' TYPE OF DRAINAGE PIPE:  PVC  OTHER (specify): [blank]  
 IF PACKAGE TREATMENT PLANT IS PROPOSED GIVE MAKE: [blank] TREATMENT CAPACITY: [blank] SEWAGE PUMP:  YES  NO  
 MODEL: [blank] FIELD DOSE VOLUME PUMPED PER CYCLE: [blank]

ALTERNATE INFORMATION

PRELIMINARY DISTRIBUTION PROPOSED:  YES  NO  
 LAGOON SIZE: [blank] DEPTH OF CLAY SOIL: [blank] GARDURATION:  YES  NO

SITE INFORMATION

SOIL DESCRIPTION:  
 DEPTH OF SOIL:  over 1.2 m (4 ft)  under 1.2 m (4 ft) If under 1.2 m (4 ft), due to  rock or  clay at \_\_\_\_\_ ft. from surface  
 DEPTH TO WATER TABLE:  over 1.2 m (4 ft)  under 1.2 m (4 ft) If under 1.2 m (4 ft) the depth is \_\_\_\_\_  
 PERC TESTS:  
 SLOWEST RATE FROM test hole #1: 2 min / 2.5 cm (1 inch) test hole #2: 2 min / 2.5 cm (1 inch)  
 AVERAGE OF SLOWEST RATE FROM EACH TEST HOLE: 2 min / 2.5 cm (1 inch)  
 WATER INFORMATION:  
 SOURCES OF DOMESTIC WATER: COM WITC  
 DISTANCES OF PROPOSED DISPOSAL FIELD FROM: \_\_\_\_\_ source of domestic water \_\_\_\_\_ breakout point  
 \_\_\_\_\_ own well \_\_\_\_\_ neighbouring wells \_\_\_\_\_ stream or lake \_\_\_\_\_ 2-0 water lines

RESTRICTIVE COVENANTS

ARE THERE ANY RESTRICTIVE COVENANTS / EASEMENTS WHICH WILL AFFECT THE DESIGN OR LOCATION OF THE SEWAGE DISPOSAL SYSTEM?  Yes  No  
 If Yes, explain: [blank]

APPLICANT SIGNATURE

The information on this application is accurate and true to the best of my knowledge:  
 OWNER or  Agent  
 OFFICE USE ONLY  
 DATE: 09/16/02 11:28 AM

PERMIT TO CONSTRUCT, INSTALL, ALTER OR REPAIR

FOULD/LOT NUMBER 2078907039.050 / Lot 10, Plan 75826

In accordance to this application and the Sewage Disposal Regulations, permission is hereby granted to construct, install, alter, or repair the sewage disposal system on this property. This permit may be cancelled if variations are made to these plans and specifications.

Conditions of Permit:

Field systems consisting of 160 feet of perforated pipe with two foot rock underlay (8' between lines) with 18" wide trench or 1 foot rock underlay with 36" wide trenches.

DATE PERMIT VALID April 13/95

SIGNATURE OF PUBLIC HEALTH INSPECTOR / EHO Brian Gray

FOR PUBLIC HEALTH INSPECTOR / EHO USE ONLY

SITE EVALUATION

SITE INFORMATION

- file check
- application complete and consistent
- soil requirements met
- setback distances

- soil type
- soil depth
- water table
- slope

COMMENTS

Soil: clean sand and sandy loam.

PLOT PLAN DRAWN TO SCALE (to be completed by the Applicant/Contractor)

PLOT PLAN CHECKLIST The following items should appear on the plot plan of the proposed system. Indicate which items have been included by checking the appropriate box.

- |   |  |   |   |   |
|---|--|---|---|---|
| <input checked="" type="checkbox"/> house (or house site) | <input type="checkbox"/> water lines                                 | <input type="checkbox"/> roadways                     | <b>Distance from septic tank:</b>                       | <b>Distance from disposal field (or lagoon/mound)</b>                     |
| <input type="checkbox"/> other buildings                  | <input type="checkbox"/> percolation test holes (2)                  | <input checked="" type="checkbox"/> patio / deck      | <input checked="" type="checkbox"/> to house            | <input type="checkbox"/> to house   |
| <input type="checkbox"/> septic tank                      | <input type="checkbox"/> observation test holes (2)                  | <input type="checkbox"/> paved areas                  | <input type="checkbox"/> to domestic water source       | <input type="checkbox"/> to perimeter of lot                              |
| <input type="checkbox"/> pkg. treatment plant             | <input type="checkbox"/> surface water (creeks, streams, lakes)      | <input type="checkbox"/> parking areas                | <input type="checkbox"/> to domestic water pipeline     | <input type="checkbox"/> to town well                                     |
| <input type="checkbox"/> disposal field                   | <input type="checkbox"/> retaining wall                              | <input checked="" type="checkbox"/> dimensions of lot | <input checked="" type="checkbox"/> to perimeter of lot | <input type="checkbox"/> to neighbouring well                             |
| <input type="checkbox"/> drinking water sources           | <input checked="" type="checkbox"/> "North" arrow                    | <input checked="" type="checkbox"/> property lines    |   | <input type="checkbox"/> to surface water (springs, streams, creeks, etc) |
| <input type="checkbox"/> yours                            | <input type="checkbox"/> direction of and percentage of ground slope | <input type="checkbox"/> swimming pool                |   | <input type="checkbox"/> to interceptor drains                            |
| <input type="checkbox"/> adjacent neighbour               |  |   |   |   |

