



BRITISH COLUMBIA


Ministry of Health Planning

AUTHORIZATION TO OPERATE A SEWAGE DISPOSAL SYSTEM

FOLIO NUMBER 789-06335.005	DATE OF APPLICATION (Y/M/D) 04/10/28	NAME OF OWNER Anderson, Stevens Lisa	NAME OF CONTRACTOR Little Projects Ltd.
LEGAL DESCRIPTION OF LOT Lot 1 Plan KAP69632 Sec 4+5, T21, R10, W6M, KDRD		STREET ADDRESS / GENERAL LOCATION 307 Partridge Road Tappen BC	
AS BUILT DIAGRAM : to be completed by the contractor or applicant		INSTALLED AS PER REGULATIONS ☒ Yes ☐ No	SIGNATURE OF OWNER / APPLICANT

PLEASE COMPLETE
AS-BUILT & LEAVE
ON SITE FOR
FINAL APPROVAL

Scale
1 Box =

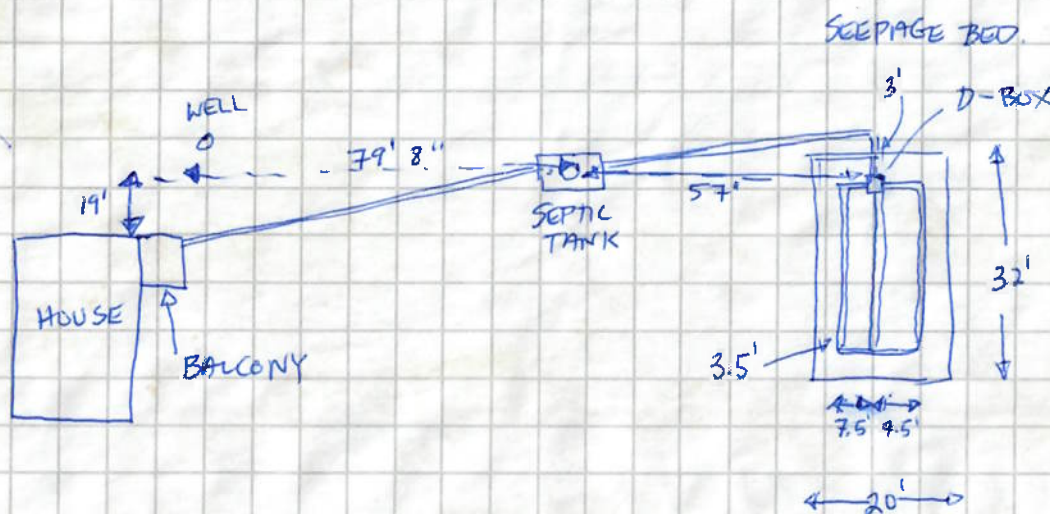

The Ministry of Health does not guarantee the useable life of the sewage disposal system. The life of the system is affected by the use and maintenance it receives. Pump out the septic tank every 2-3 years. For servicing of package treatment plants, consult your local service agent. For service guarantees, consult your local sewage disposal contractor. If the system needs repair or modification, a new permit is required.

If the system is not authorized for backfilling and if corrections are required, a re-inspection fee of \$100 must be paid for each time the Public Health Inspector checks to see that the faults have been corrected.

DATE BACKFILL / USE AUTHORIZED Nov 15/04	SUBJECT TO THE FOLLOWING CONDITIONS: The septic tank should be pumped out every 2-3 years of regular use to maintain integrity of disposal field. Use water conservatively.
--	---

SIGNATURE PUBLIC HEALTH INSPECTOR / EHO:

FOR PUBLIC HEALTH INSPECTOR / EHO USE ONLY

APPROVED REJECTED NOT APPLICABLE

septic tank	☒	☐	☐	1000 gal
package treatment plant	☐	☐	☒	
other (e.g. lagoon, holding tank)	☐	☐	☐	specify: _____
field laterals	☒	☐	☐	
distribution box	☒	☐	☐	
siphon	☐	☐	☒	

APPROVED REJECTED NOT APPLICABLE

curtain drain	☐	☐	☒
interceptor drains	☐	☐	☒
pump	☐	☐	☒
drain rock	☒	☐	☐
set back distances	☒	☐	☐
fill	☐	☐	☒

#160

**OWNER
INFORMATION**
Correspondence
to be sent to
☐ owner

FOLIO NUMBER 189-06335.005	DATE OF APPLICATION (YYYY / MM / DD) 2004 10 28th	☒ New Construction ☐ Repair ☐ Alteration
NAME OF OWNER Steven & Lisa Andersen		TELEPHONE NUMBER 250-832-2320
Mailing Address P.O. Box 482 salmon Arm		Postal Code V1E 4N6

**APPLICANT
INFORMATION**
Correspondence
to be sent to
☐ applicant

NAME OF APPLICANT Same		TELEPHONE NUMBER
Mailing Address		Postal Code

**LOT
INFORMATION**

LEGAL DESCRIPTION OF WHERE DISPOSAL SYSTEM IS TO BE CONSTRUCTED
Lot 1 plan KAP69632 S4+5, T21, R10, W6M, KDYD

STREET ADDRESS / GENERAL LOCATION
307 Partridge road VOE 2X0 Tappen B.C.
307 Partridge Rd., Tappen

**PREMISE
INFORMATION**

SEWAGE DISPOSAL SYSTEM WILL SERVE: ☒ SINGLE FAMILY DWELLING ☐ DUPLEX ☐ OTHER (specify):	NUMBER OF BEDROOMS: 2	FINISHED BASEMENT ☐ Yes ☒ No	DO YOU INTEND TO ADD A BASEMENT SUITE OR MORE BEDROOMS IN THE FUTURE? ☒ Yes ☐ No
ESTIMATED DAILY SEWAGE FLOW:	TOTAL LIVING AREA: 1466 sq ft.	LOT SIZE: 0.812 HA	

**SYSTEM
INFORMATION**

TYPE OF SEWAGE DISPOSAL SYSTEM: ☐ CONVENTIONAL ☒ ALTERNATE (E.G. ☐ PRIVY ☐ LAGOON, ☐ RAISED MOUNDS, ☒ SEEPAGE BED) ☐ DEEP TRENCH ☐ OTHER (specify):	SEPTIC TANK MANUFACTURER Leko Precast	LIQUID VOLUME OF TANK 1000 gal.
MATERIAL OF SEPTIC TANK Concrete		
TOTAL LENGTH OF DRAINAGE PIPE 105.35 ft	TYPE OF DRAINAGE PIPE: ☒ PVC ☐ OTHER (specify):	INSIDE DIAMETER OF PIPE 3-4"
IF PACKAGE TREATMENT PLANT IS PROPOSED GIVE: MAKE MODEL	TREATMENT CAPACITY	SEWAGE PUMP: ☐ YES ☒ NO
		FIELD DOSE VOLUME PUMPED PER CYCLE:

**ALTERNATE
INFORMATION**

PRESSURE DISTRIBUTION PROPOSED ☐ YES ☒ NO	LAGOON SIZE	DEPTH OF CLAY SOIL	GARBURATOR ☐ YES ☒ NO
---	-------------	--------------------	---

**SITE
INFORMATION**

SOIL DESCRIPTION
DEPTH OF SOIL: ☒ over 1.2 m (4 ft.) ☐ under 1.2 m (4 ft.) If under 1.2m (4 ft.), due to ☐ rock or ☐ clay at _____ ft. from surface.
DEPTH TO WATER TABLE: ☒ over 1.2 m (4 ft.) ☐ under 1.2 m (4 ft.) If under 1.2m (4 ft.) the depth is _____

PERC TESTS
SLOWEST RATE FROM test hole #1 **25** min./2.5 cm (1 inch) test hole #2 **25** min./ 2.5 cm (1 inch)
AVERAGE OF SLOWEST RATE FROM EACH TEST HOLE **25** min./ 2.5 cm (1inch)

WATER INFORMATION
SOURCES OF DOMESTIC WATER: **Well**
DISTANCES OF PROPOSED DISPOSAL FIELD FROM: _____ source of domestic water **N/A.** breakout point
105 ft. own well **over 200'** neighbouring wells **N/A** stream or lake **over 10'** water lines

**RESTRICTIVE
COVENANTS**

ARE THERE ANY RESTRICTIVE COVENANTS / EASEMENTS WHICH WILL AFFECT THE DESIGN OR LOCATION OF THE SEWAGE DISPOSAL SYSTEM? ☐ Yes ☒ No
If Yes, explain

**APPLICANT
SIGNATURE**

The information on this application is accurate and true to the best of my knowledge: ☒ Owner or ☐ Agent Signature [Signature] Date (yyyy/mm/dd) 2004/11/01	OFFICE USE ONLY PAID: 250.00 DATE: 2004/11/01 INITIALS: MR
--	--

Receipt #
39494

PERMIT TO CONSTRUCT, INSTALL, ALTER OR REPAIR

FOLIO / LOT NUMBER

789-06335.005 / Lot 1, Plan KAL 69632

Pursuant to this application and the Sewage Disposal Regulations, permission is hereby granted to construct, install, alter, or repair the sewage disposal system on this property. This permit may be cancelled if variations are made to these plans and specifications.

Conditions of Permit:

Construct a seepage consisting of a 20 foot by 32 foot excavation with three 25 foot perforated lines at 6 to 7 1/2 foot centres (ends looped; total perforated length = 105 feet). The entire seepage bed excavation must be over 102 feet from all domestic wells, 10 feet from buildings, 10 feet from property lines and 10 feet from water lines. The septic tank must be over 51 feet from all domestic wells. This permit is issued pursuant to the Sewage Disposal Regulation 411/85 and expires May 30, 2005. The Provincial Sewerage System Regulation 701/04 becomes effective May 31, 2005.

DATE PERMIT VALID

Nov 1, 2004

SIGNATURE OF PUBLIC HEALTH INSPECTOR / EHO

Brian Gray

FOR PUBLIC HEALTH INSPECTOR / EHO USE ONLY

SITE EVALUATION

- ☒ file check
- ☒ application complete and consistent
- ☒ soil requirements met
- ☒ setback distances

SITE INFORMATION

- ☒ soil type
- ☒ soil depth
- ☒ water table
- ☒ slope


COMMENTS

Soil: 6 foot hole. Top 1 1/2 feet is sandy loam. 1 1/2 to 4 1/2 feet is fine sandy then fine sandy loam to bottom of hole - Dry B2

PLOT PLAN DRAWN TO SCALE (to be completed by the Applicant/Contractor)

PLOT PLAN CHECKLIST The following items should appear on the plot plan of the proposed system. Indicate which items have been included by checking the appropriate box.

- | | | | | |
|---|--|--|---|--|
| ☐ house (or house site) | ☐ water lines | ☐ roadways | Distance from septic tank: | Distance from disposal field (or lagoon/mound): |
| ☐ other buildings | ☐ percolation test holes (2) | ☐ patio / deck | ☐ to house | ☐ to house |
| ☐ septic tank | ☐ observation test holes (2) | ☐ paved areas | ☐ to domestic water source | ☐ to perimeter of lot |
| ☐ pkg. treatment plant | ☐ surface water (creeks, streams, lakes) | ☐ parking areas | ☐ to domestic water pipeline | ☐ to own well |
| ☐ disposal field | ☐ retaining wall | ☐ dimensions of lot | ☐ to perimeter of lot | ☐ to neighbouring wells |
| ☐ drinking water sources | ☐ "North" arrow | ☐ property lines | | ☐ to surface water (springs, streams, creeks, etc.) |
| ☐ yours ☐ adjacent neighbours | ☐ direction of and percentage of ground slope | ☐ swimming pool | | ☐ to interceptor drains |

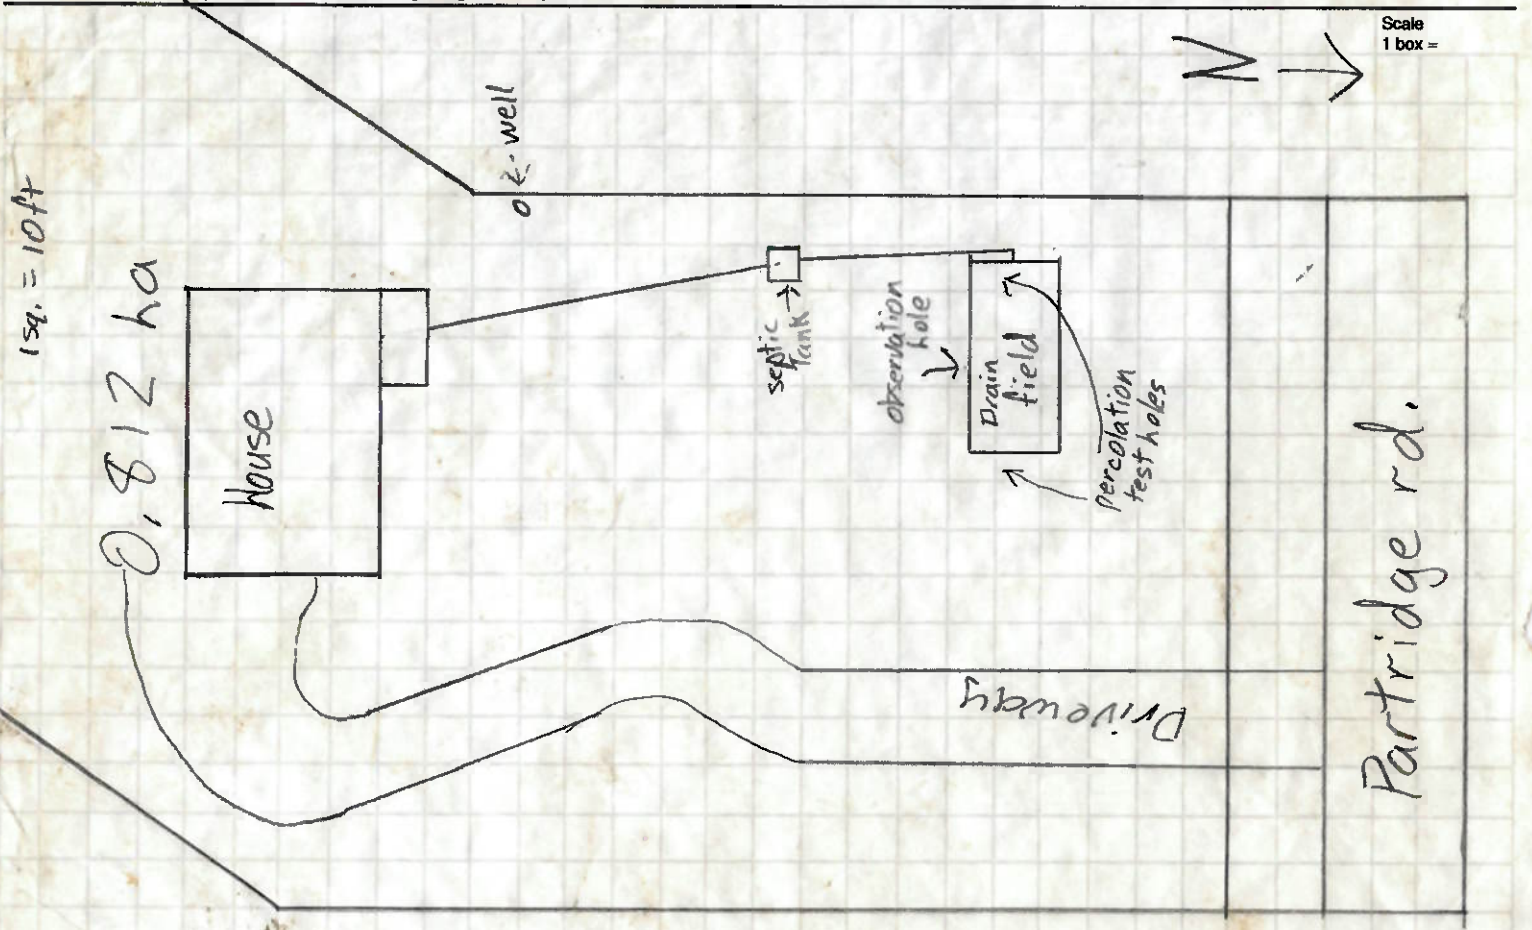



The Environmental Appeal Board is established under section 11 of the Environment Management Act. Appeals are heard by a panel of the Board. This ensures that sewage permit application process is administered openly and fairly. It also provides the public the right to an independent appeal process.

If a person is aggrieved by the issue or the refusal of a permit for a sewage disposal system, they may appeal that ruling to the Environmental Appeal Board. On hearing an appeal, the Environmental Appeal Board may confirm, vary or rescind the ruling under appeal.

A person who is issued a permit must post a public notice, provided by the Ministry of Health, which must contain a site map, the conditions of the permit or authorization, a description of how an appeal of the decision to issue the permit or authorization is commenced, and a reference to the time period for commencing that appeal. The public notice must be posted in a conspicuous place(s) on the property not more than 3 days after the date it was issued and must remain posted for 30 days from the date it was issued.

In addition to posting a public notice if the estimated sewage flow is more than 4,546 litres (1000 I.G.) per day, a notice must be published in the newspaper in the area.

I understand that my neighbours or any other aggrieved parties have 30 days, from the date of issuance, to appeal the permit and that the permit may be overturned by the Environmental Appeal Board. I am prepared to accept full responsibility for any construction that I may do during this time should the Environmental Appeal Board uphold the appeal and revoke my permit.

and

I, as registered owner of the property, hereby authorize, Steve Andersen as my agent for the purpose of applying for a permit to construct and for the purpose of constructing my proposed sewage disposal system.

Legal description of property:

LOT 1 PLAN KAP69632 SECTION 4+5, T 21, R 10

DISTRICT W6M, KRD STREET 307 Partridge rd Tappen

[Signature]
Signature of Registered Owner