



ENGINEERING A BETTER TOMORROW

ENGINEERING | SITEWORK | LAND SURVEYING | DEVELOPMENT

Servicing the Northeast

November 17, 2020

City of New Bedford
Environmental Stewardship
133 William Street – Room 304
New Bedford, MA 02740

**RE: Request for Certificate of Compliance
Map 130D Lot 474 – Farland Circle – New Bedford, MA
DEP File No.: SE49-0846
Book 13146 Page 333**

Dear, Members of the Commission:

On behalf of our client, MIH1, LLC, we respectfully request that the New Bedford Environmental Stewardship consider issuing a Certificate of Compliance for work approved under the Amended Order of Conditions issued on March 12, 2020.

On November 6, 2020, an existing conditions survey was performed by Farland Corp. to inspect the site and determine if the work completed was in substantial compliance with the approved design plan and issued Order of Conditions. Based on our Final As-Built Plan dated November 17, 2020, we have determined that the work has been completed to specifications.

Thank you in advance for your time and consideration on this matter and please do not hesitate to contact me with any further questions.

If you should have any questions, please feel free to contact me.

Very truly yours,

FARLAND CORP., INC.

Jack Tabares

Jack Tabares
Project Manager

cc. client, file



Massachusetts Department of Environmental Protection
Bureau of Resource Protection - Wetlands

WPA Form 8A – Request for Certificate of Compliance

Massachusetts Wetlands Protection Act M.G.L. c. 131, §40

DEP File Number:


SE 49-0846

Provided by DEP

A. Project Information

Important:

When filling out forms on the computer, use only the tab key to move your cursor - do not use the return key.

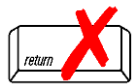

Upon completion of the work authorized in an Order of Conditions, the property owner must request a Certificate of Compliance from the issuing authority stating that the work or portion of the work has been satisfactorily completed.

1. This request is being made by:

Farland Corp

Name

21 Ventura Drive

Mailing Address

Dartmouth

City/Town

MA

State

02747

Zip Code

508-717-3479

Phone Number

2. This request is in reference to work regulated by a final Order of Conditions issued to:

MIH1, LLC

Applicant

3/12/20

Dated

SE 49-0846

DEP File Number

3. The project site is located at:

Farland Circle

Street Address

130D

Assessors Map/Plat Number

New Bedford

City/Town

474

Parcel/Lot Number

4. The final Order of Conditions was recorded at the Registry of Deeds for:

MIH1, LLC

Property Owner (if different)

Bristol

County

13146

Book

333

Page

Certificate (if registered land)

5. This request is for certification that (check one):

☒ the work regulated by the above-referenced Order of Conditions has been satisfactorily completed.

☐ the following portions of the work regulated by the above-referenced Order of Conditions have been satisfactorily completed (use additional paper if necessary).

☐ the above-referenced Order of Conditions has lapsed and is therefore no longer valid, and the work regulated by it was never started.



WPA Form 8A – Request for Certificate of Compliance

Massachusetts Wetlands Protection Act M.G.L. c. 131, §40

A. Project Information (cont.)

6. Did the Order of Conditions for this project, or the portion of the project subject to this request, contain an approval of any plans stamped by a registered professional engineer, architect, landscape architect, or land surveyor?


☒ Yes

If yes, attach a written statement by such a professional certifying substantial compliance with the plans and describing what deviation, if any, exists from the plans approved in the Order.


☐ No

B. Submittal Requirements

Requests for Certificates of Compliance should be directed to the issuing authority that issued the final Order of Conditions (OOC). If the project received an OOC from the Conservation Commission, submit this request to that Commission. If the project was issued a Superseding Order of Conditions or was the subject of an Adjudicatory Hearing Final Decision, submit this request to the appropriate DEP Regional Office (see <http://www.mass.gov/eea/agencies/massdep/about/contacts/find-the-massdep-regional-office-for-your-city-or-town.html>).

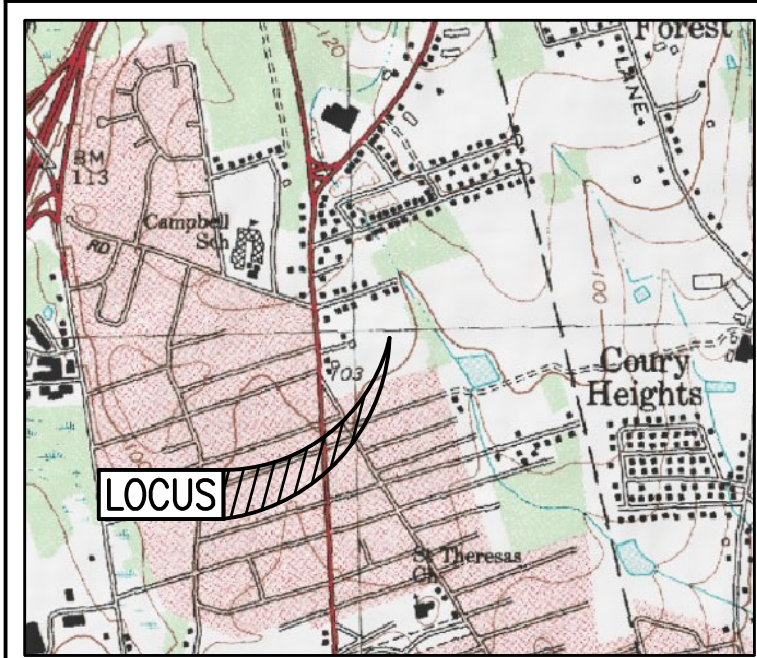

LOCUS MAP SCALE: 1"=2,000'±

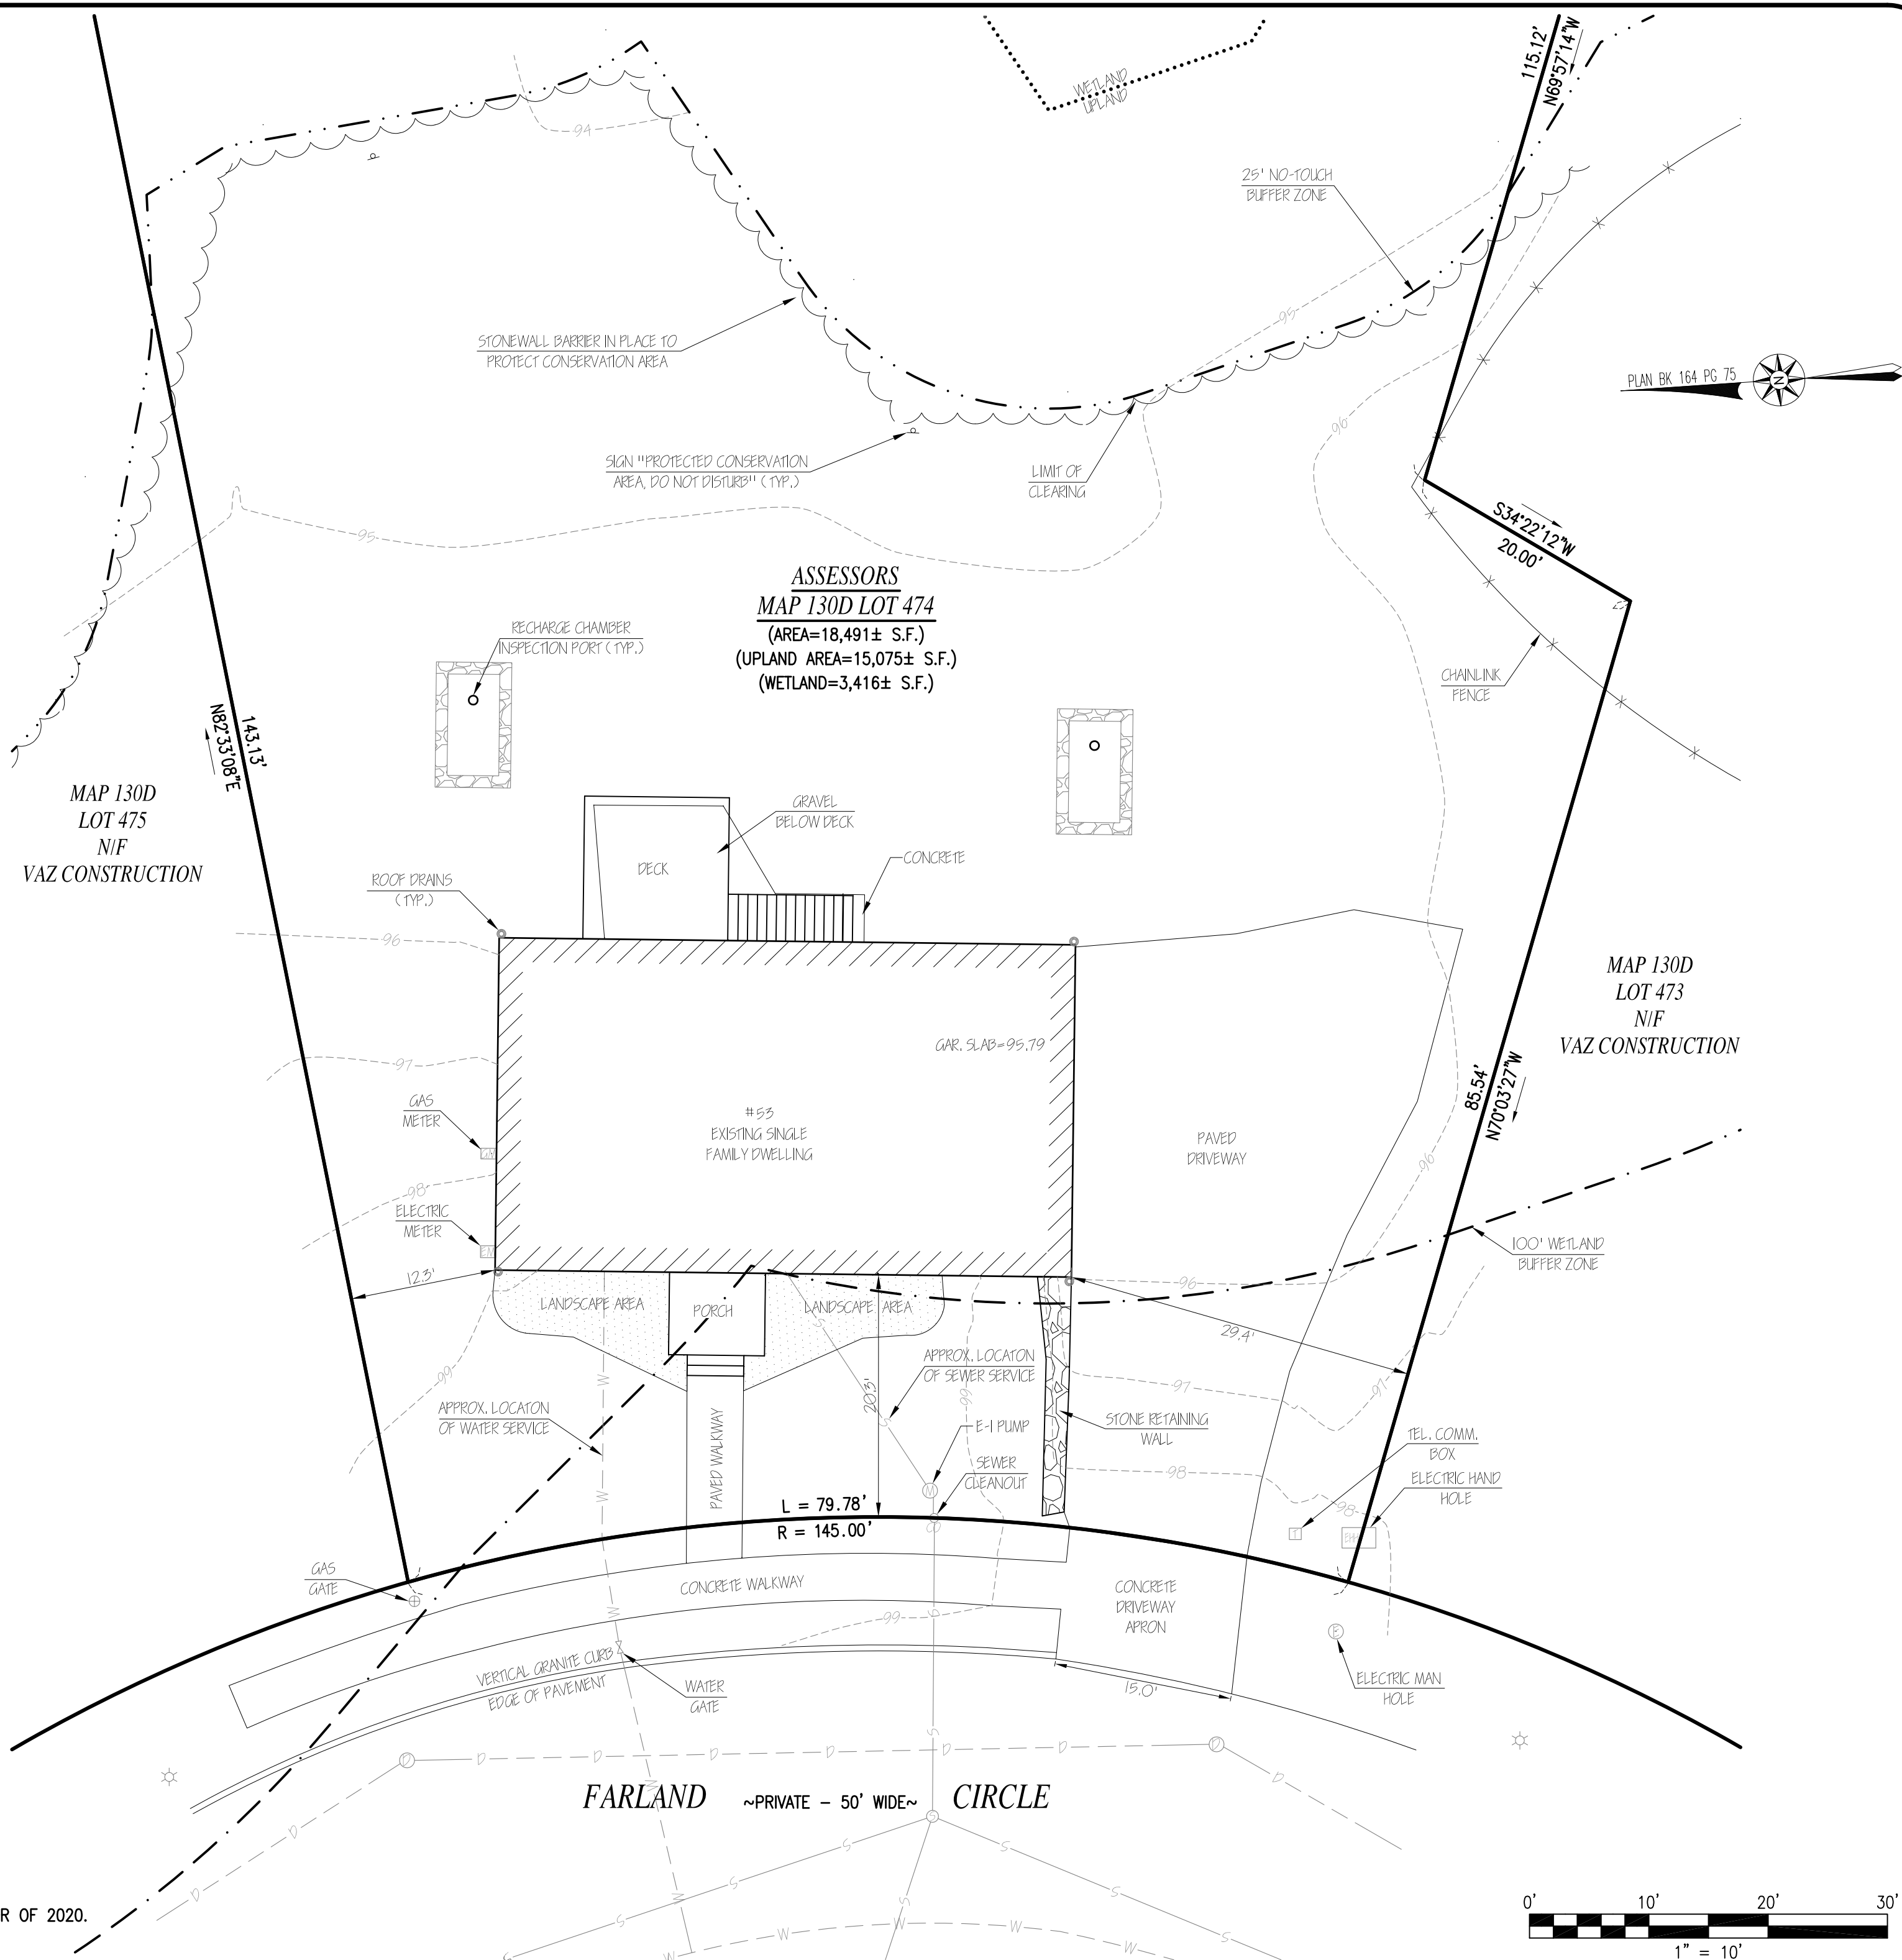

RECORD OWNER:
ASSESSORS MAP 130D LOT 474
M1H1, LLC
30 WATER STREET
NEW BEDFORD, MA 02740
DEED BOOK 12304 PAGE 200
PLAN BOOK 181 PAGE 35

NOTES:
AS-BUILT SURVEY PERFORMED BY FARLAND CORP. IN NOVEMBER OF 2020.

REVISIONS

www.FarlandCorp.com
21 VENTURA DRIVE
DARTMOUTH, MA 02747
P.508.717.3479
• ENGINEERING
• SITEWORK
• LAND SURVEYING
• DEVELOPMENT

DRAWN BY: SB
DESIGNED BY: ***
CHECKED BY: CAF

FINAL AS-BUILT PLAN
53 FARLAND CIRCLE
ASSESSORS MAP 130D LOT 474
NEW BEDFORD, MASSACHUSETTS
M1H1 LLC
30 WATER STREET
NEW BEDFORD, MA 02740
PREPARED FOR:

NOVEMBER 17, 2020
SCALE: 1"=10'
JOB NO. 18-765
LATEST REVISION:

SHEET 1 OF 1