


REVISION RECORD


[illegible][illegible][illegible]

"Final-As-Built" drawings for your records. No further approval Required.

L A N D I N G	FLOOR MARKINGS		
	F O R T	R E A R	S I D E
60			
59			
58			
2	2		
1	*1		

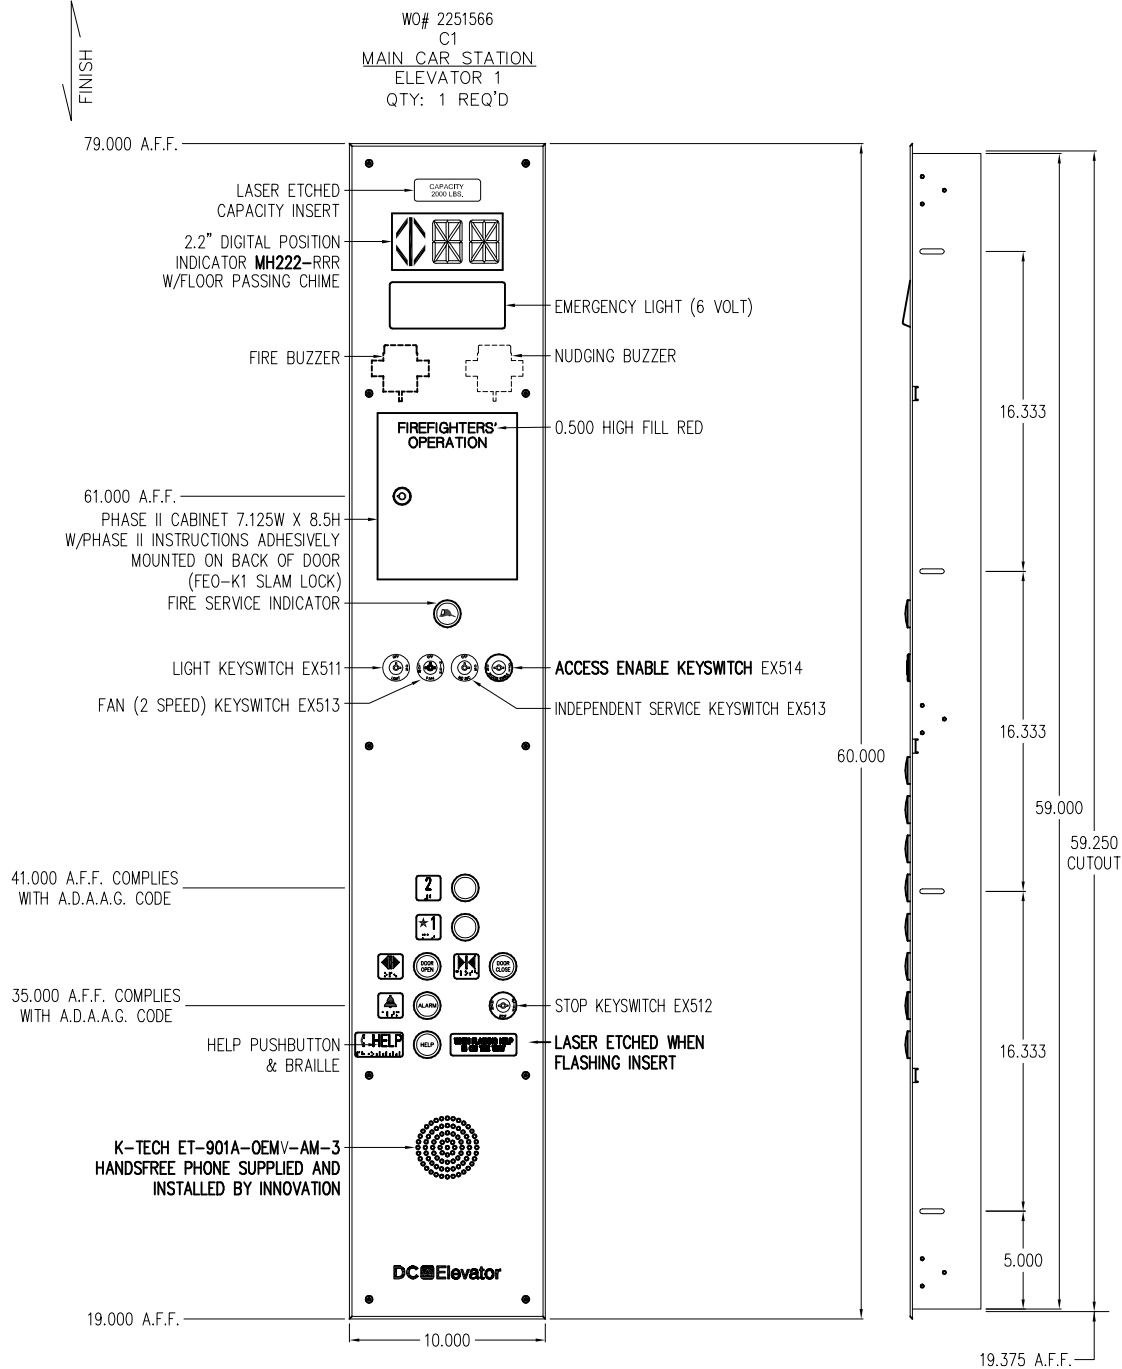

2004-2007 ASME FIRE CABINET SUBPLATE LAYOUT

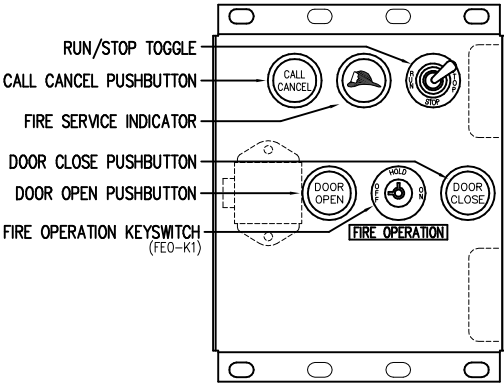

FIRE SERVICE CABINET KEYSWITCH & TOGGLE LEGEND						
SWITCH IDENTIFICATION	OPERATING POSITIONS	KEY REMOVE POSITION	MAINTAINED POSITIONS	MOMEN. POS.	MOUNT	HALO COLOR
FIRE OPERATION	OFF-HOLD-ON	OFF-HOLD	ALL		VER	RED
STOP	RUN-STOP		ALL		VER	RED

CAPACITY
2000 LBS.

DEVICE STYLE

PB-1 PUSHBUTTON WHITE LED
PB-1 INDICATOR
PB-1 KEYSWITCH
PB-1 TOGGLE



BLACK HALO



BRILLE ADA COMPLIANT:

1.250 [31.75 mm] SQ.
CUSTOM FISHTAIL BRAILLE
OVAL SURROUND 2.750 X 1.500
1.375 [34.93 mm] DIA.

STAINLESS CHARACTERS ON BLACK BACKGROUND

FASTENERS (#10-24 X 1.000) BUTTONHEAD

ELEVATOR CONTROLLER INFORMATION

MANUFACTURER: VIRGINIA CONTROL
MODEL: DISCRETE
FIXTURE VOLTAGE: 120 VAC

EXISTING RETURN DIMENSIONS

HEIGHT: _____
WIDTH: _____
JAMB DEPTH: _____

EXISTING FACEPLATE DIMENSIONS

HEIGHT: _____
WIDTH: _____
TOP AFF: _____
BOTTOM AFF: _____

CAR STATION INFORMATION

MATERIAL: 11 GA. (TYPE 304)
STAINLESS STEEL
FINISH: NO. 4 BRUSHED

ENGRAVING FONT: HELVETICA LIGHT

BEVEL 15°: YES

PREWIRE: YES

HINGING: RIGHT

HINGE TYPE (QTY): SNAP (3 REQ'D)

CAPACITY: 2000 LBS.

ASME / STATE / FIRE CODE

FIRE YEAR CODE: 2007
FIRE KEYCODE: FE0-K1

DIGITAL PI INFORMATION

DISPLAY COLOR: RED

LENS COLOR: RED

SIGNAL VOLTAGE: _____

SIGNAL FORMAT: _____

NO. OF INPUTS: _____

SCROLLING: (IH320 ONLY)

PREWIRING REQ'D

- INNOVATION TO PREWIRE TO TERMINAL STRIPS PER WD-VOID WIRING DIAGRAMS.
- PUSHBUTTONS AND INDICATORS TO USE TERMINAL BLOCK CONFIGURATION.

INNOVATION INDUSTRIES INC

3500 E. MAIN ST.,
RUSSELLVILLE, AR 72802
(479) 968-2232
FAX (479) 968-7986

DRAWN FOR CANTON ELEVATOR INCORPORATED

JOB NAME
DC ELEVATOR / E-STUDIO SUITES

LOCATION:
PLAINFIELD, IN

PURCHASE ORDER NO.
30859-03

JOB NO.
642773

WORK ORDER NO.
SEE DWG

QUOTE NO.
112123JG6

SALES REP:
JG

FILE NAME
642773B

SHEET NO.
2 OF 4

REV B-REVISED FINAL

DRAWN BY:
DDW

DO NOT SCALE

SIZE
B

PANEL KEYSWITCH AND TOGGLE LEGEND						
SWITCH IDENTIFICATION	OPERATING POSITIONS	KEY REMOVE POSITION	MAINTAINED POSITIONS	MOMEN. POS.	MOUNT	HALO COLOR
LIGHT	OFF-ON	ALL	ALL		SWV	BLACK
FAN (2 SPEED)	LOW-OFF-HIGH	ALL	ALL		VER	BLACK
IND SVC	OFF-ON	ALL	ALL		SWV	BLACK
ACCESS ENABLE	ON-OFF	ALL	ALL		VER	BLACK
STOP	RUN-STOP	ALL	ALL		HOR	RED

"DC" POLANE 8890
PRODUCTION BLACK

POLANE B TO MATCH PANTONE RED 186C

DC Elevator


0.688

"ELEVATOR" POLANE 8890 TO MATCH
PANTONE COOL GRAY 8C

APPROVED AS DRAWN:	APPROVED BY: _____
APPROVED AS NOTED:	DATE: _____
REVISE AND RESUBMIT:	

"Final-As-Built" drawings for your records. No further approval Required.

L A N D I N G	ELEVATOR 1		
	FLOOR MARKINGS		
	F R O N T	R E A R	S I D E
60			
59			
58			
2	2		
1	*1		

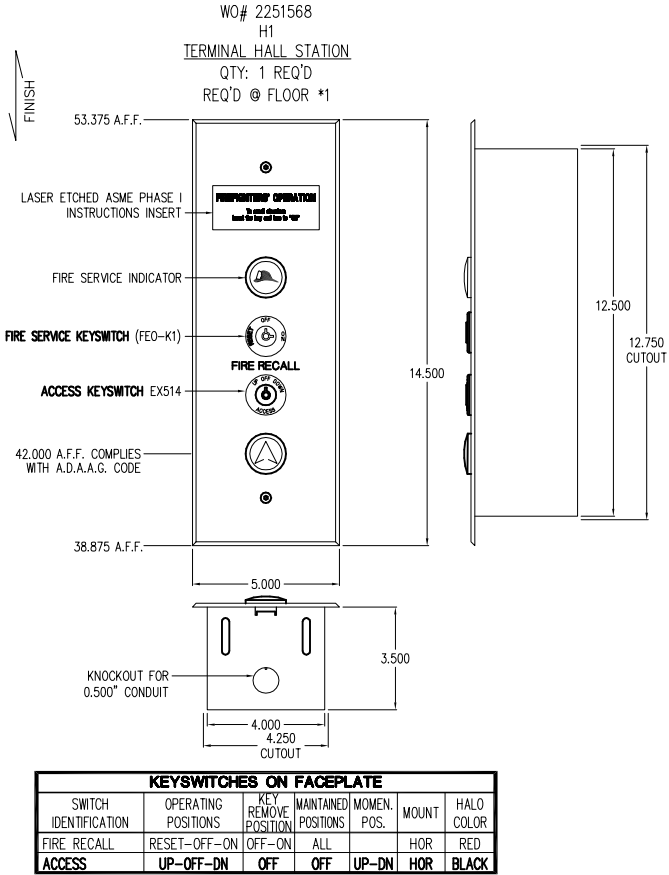

DEVICE STYLE
PB-1 PUSHBUTTON WHITE LED
PB-1 INDICATOR
PB-1 KEYSWITCH
TOGGLE

BRILLE ADA COMPLIANT:
1.250 [31.75 mm] SQ.
CUSTOM FISHTAIL BRILLE
OVAL SURROUND 2.750 X 1.500
1.375 [34.93 mm] DIA.
CHARACTERS ON _____ BACKGROUND

FASTENERS (#10-24 X 2.000) BUTTONHEAD

ELEVATOR CONTROLLER INFORMATION
MANUFACTURER: VIRGINIA CONTROL
MODEL: DISCRETE
FIXTURE VOLTAGE: 120 VAC

EXISTING FACEPLATE DIMENSIONS
HEIGHT: _____
WIDTH: _____
TOP AFF: _____
BOTTOM AFF: _____
BOX DEPTH: _____

LANTERN INFORMATION
UP: _____
DOWN: _____
HALL CHIME: _____
CAR CHIME: _____

HALL EQUIPMENT INFORMATION
MATERIAL: 11 GA. (TYPE 304)
STAINLESS STEEL
FINISH: NO. 4 BRUSHED

ENGRAVING FONT: HELvetica LIGHT
BEVEL 15': YES
PREWIRE: NO

ASME / STATE / FIRE CODE
FIRE YEAR CODE: 2007
FIRE KEYCODE: FEQ-K1

DIGITAL PI INFORMATION
DISPLAY COLOR: _____
LENS COLOR: _____
SIGNAL VOLTAGE: _____
SIGNAL FORMAT: _____
NO. OF INPUTS: _____
SCROLLING: _____
(IH320 ONLY)



3500 E. MAIN ST.,
RUSSELLVILLE, AR 72802
(479) 968-2232
FAX (479) 968-7986

DRAWN FOR



JOB NAME
DC ELEVATOR / E-STUDIO SUITES

LOCATION:
PLAINFIELD, IN



PURCHASE ORDER NO.
30859-03

JOB NO. 642773	WORK ORDER NO. SEE DWG	QUOTE NO. 112123JG6
SALES REP: JG	FILE NAME 642773C	SHEET NO. 3 OF 4
REV B-REVISED FINAL		DRAWN BY: DDW
DO NOT SCALE		SIZE B

	APPROVED AS DRAWN:	APPROVED BY: _____ DATE: _____
	APPROVED AS NOTED:	
	REVISE AND RESUBMIT:	

"Final-As-Built" drawings for your records. No further approval Required.

L A N D I N G	ELEVATOR 1		
	FLOOR MARKINGS		
	FRONT	REAR	SIDE
60			
59			
58			
2	2		
1	*1		

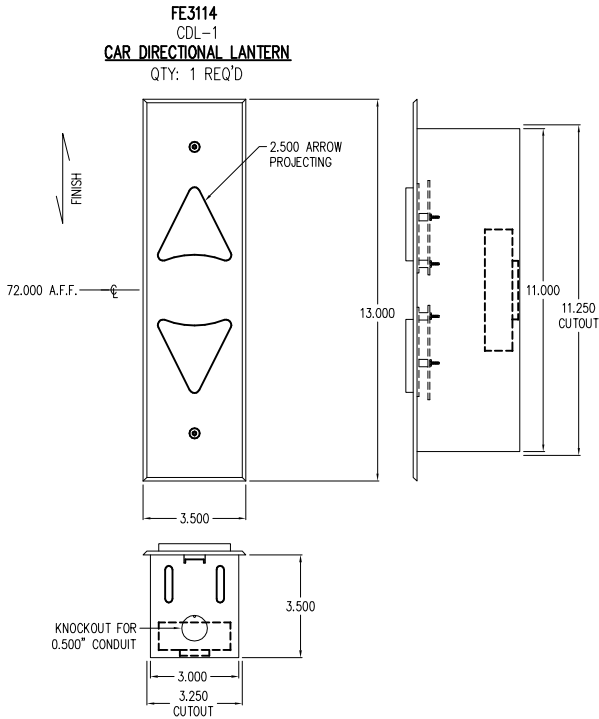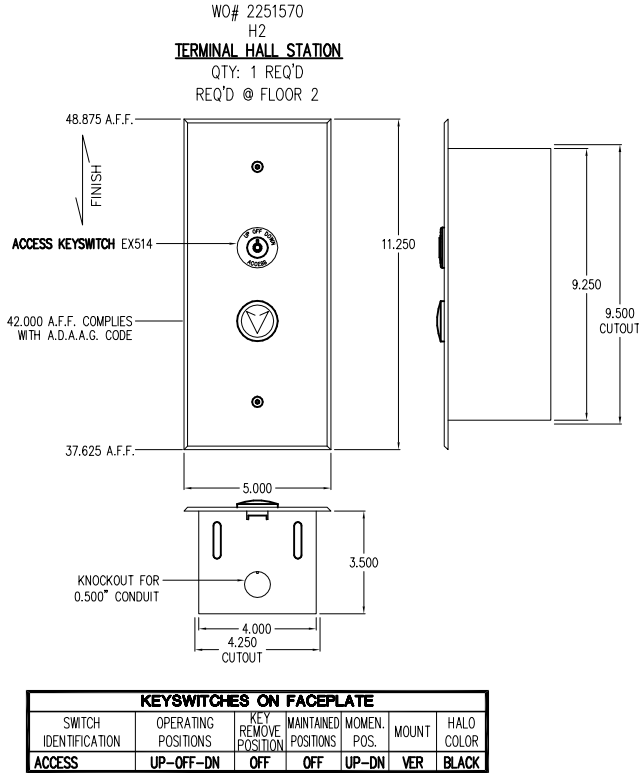

DEVICE STYLE
PB-1 PUSHBUTTON WHITE LED
INDICATOR
PB-1 KEYSWITCH
TOGGLE

BRILLE ADA COMPLIANT:
1.250 [31.75 mm] SQ.
CUSTOM FISHTAIL BRAILLE
OVAL SURROUND 2.750 X 1.500
1.375 [34.93 mm] DIA.
CHARACTERS ON BACKGROUND

FASTENERS (#10-24 X 2.000) BUTTONHEAD

ELEVATOR CONTROLLER INFORMATION
MANUFACTURER: VIRGINIA CONTROL
MODEL: DISCRETE
FIXTURE VOLTAGE: 120 VAC

EXISTING FACEPLATE DIMENSIONS
HEIGHT: _____
WIDTH: _____
TOP AFF: _____
BOTTOM AFF: _____
BOX DEPTH: _____

LANTERN INFORMATION
UP: WHITE (LED)
DOWN: RED (LED)
HALL CHIME: _____
CAR CHIME: DISCRETE

HALL EQUIPMENT INFORMATION
MATERIAL: 11 GA. (TYPE 304)
STAINLESS STEEL
FINISH: NO. 4 BRUSHED

ENGRAVING FONT: _____
BEVEL 15': YES
PREWIRE: NO

ASME / STATE / FIRE CODE
FIRE YEAR CODE: 2007
FIRE KEYCODE: _____

DIGITAL PI INFORMATION
DISPLAY COLOR: _____
LENS COLOR: _____
SIGNAL VOLTAGE: _____
SIGNAL FORMAT: _____
NO. OF INPUTS: _____
SCROLLING: (IH320 ONLY)

INNOVATION INDUSTRIES INC
3500 E. MAIN ST.,
RUSSELLVILLE, AR 72802
(479) 968-2232
FAX (479) 968-7986

DRAWN FOR **CANTON ELEVATOR INCORPORATED**

JOB NAME
DC ELEVATOR / E-STUDIO SUITES

LOCATION:
PLAINFIELD, IN

PURCHASE ORDER NO.
30859-03

JOB NO. 642773	WORK ORDER NO. SEE DWG	QUOTE NO. 112123JG6
SALES REP: JG	FILE NAME 642773D	SHEET NO. 4 OF 4

REV B-REVISED FINAL

DO NOT SCALE

DRAWN BY:
DDW

SIZE **B**

	APPROVED AS DRAWN:	APPROVED BY: _____ DATE: _____
	APPROVED AS NOTED:	
	REVISE AND RESUBMIT:	

"Final-As-Built" drawings for your records. No further approval Required.