




A TOWER 1
Scale: 1/4" = 1'-0"

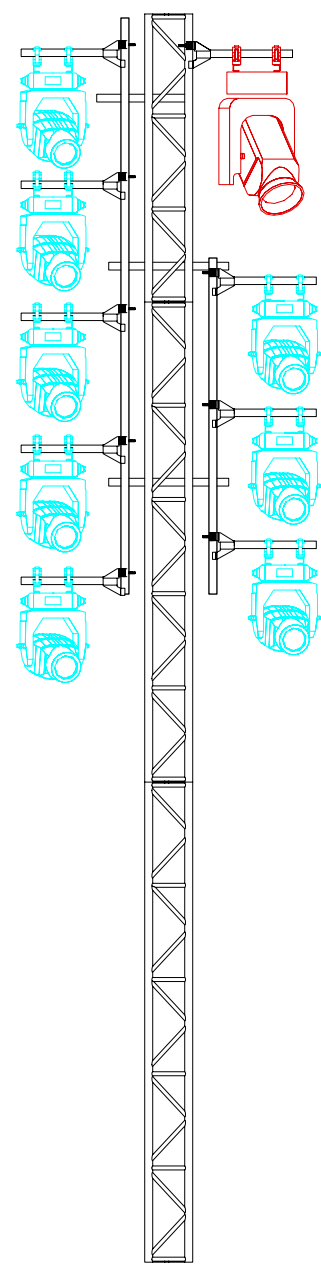


B TOWER 2
Scale: 1/4" = 1'-0"

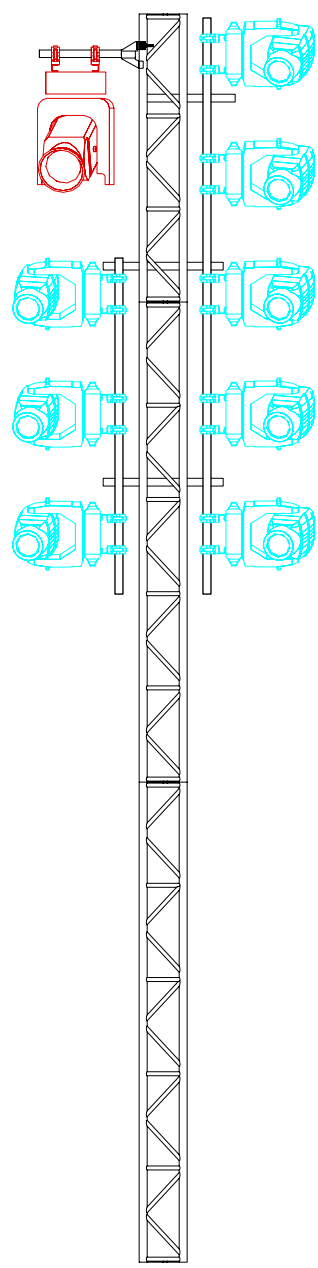


C TOWER 3
Scale: 1/4" = 1'-0"

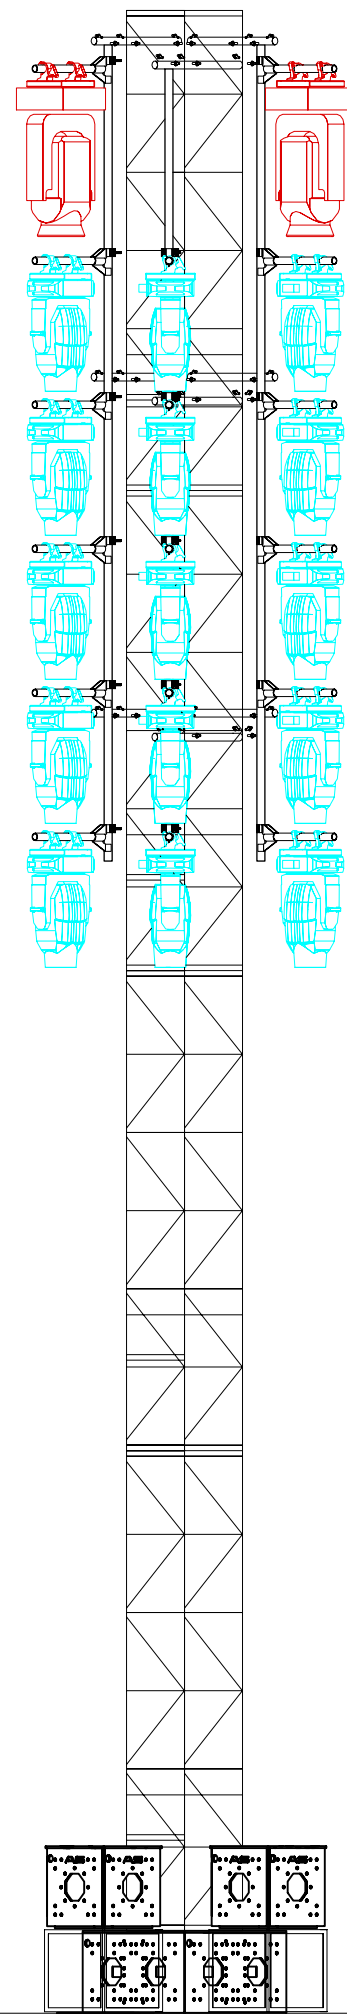


D TOWER 4
Scale: 1/4" = 1'-0"

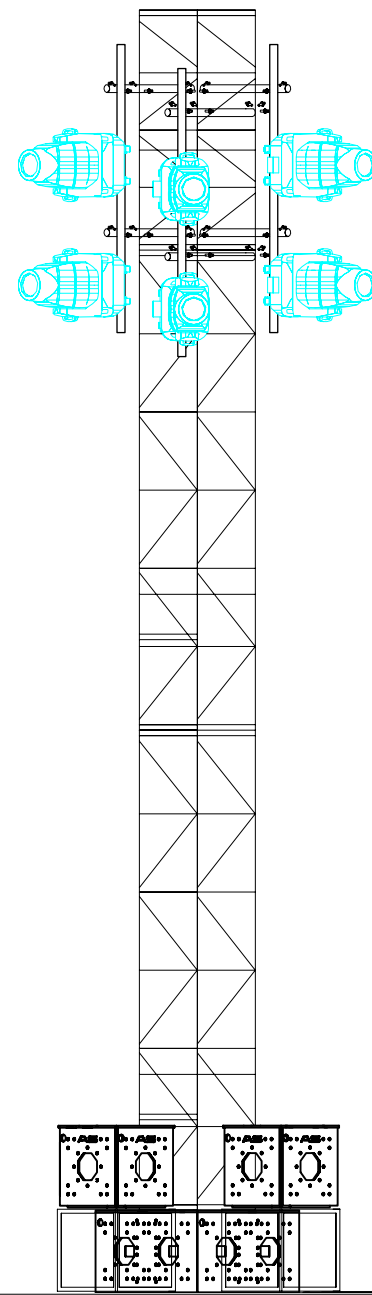


E TOWER 9
Scale: 1/4" = 1'-0"

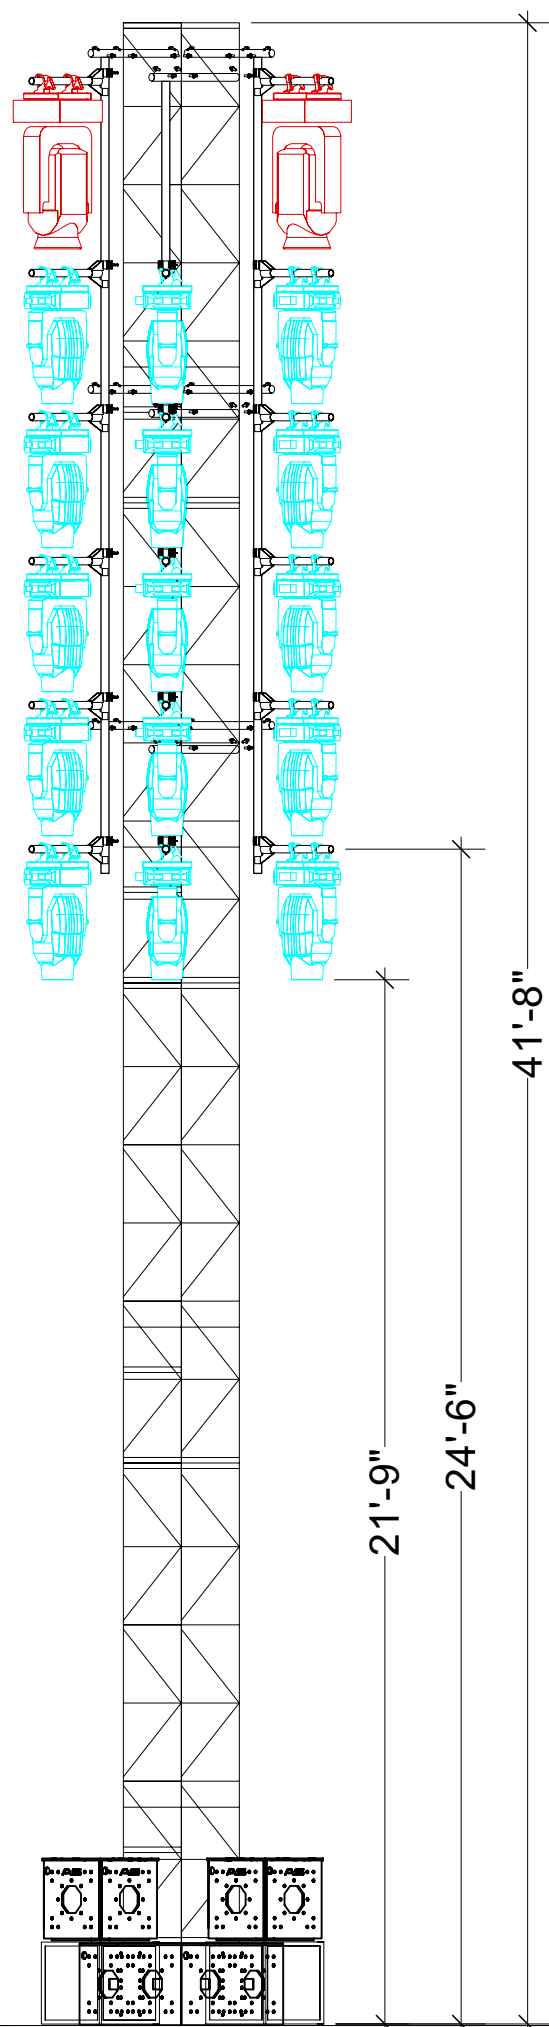


F TOWER 5
Scale: 1/4" = 1'-0"

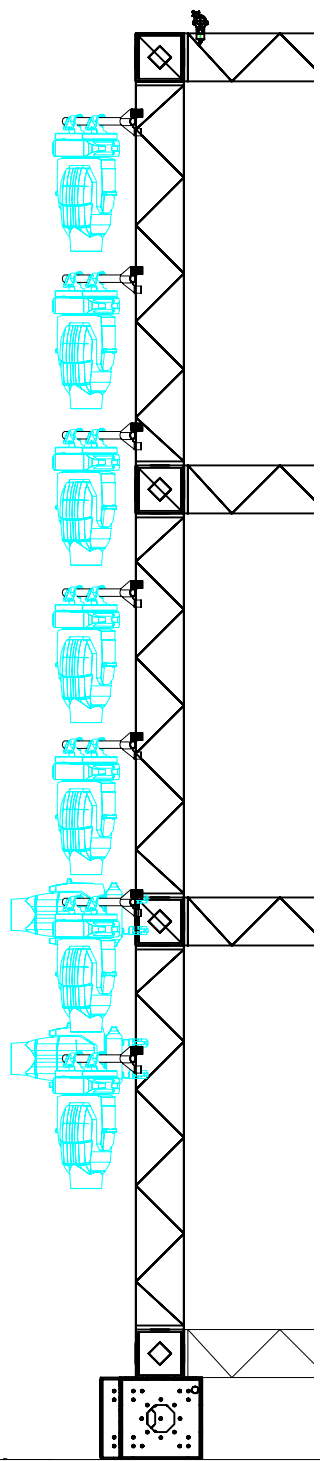


G TOWER 6
Scale: 1/4" = 1'-0"

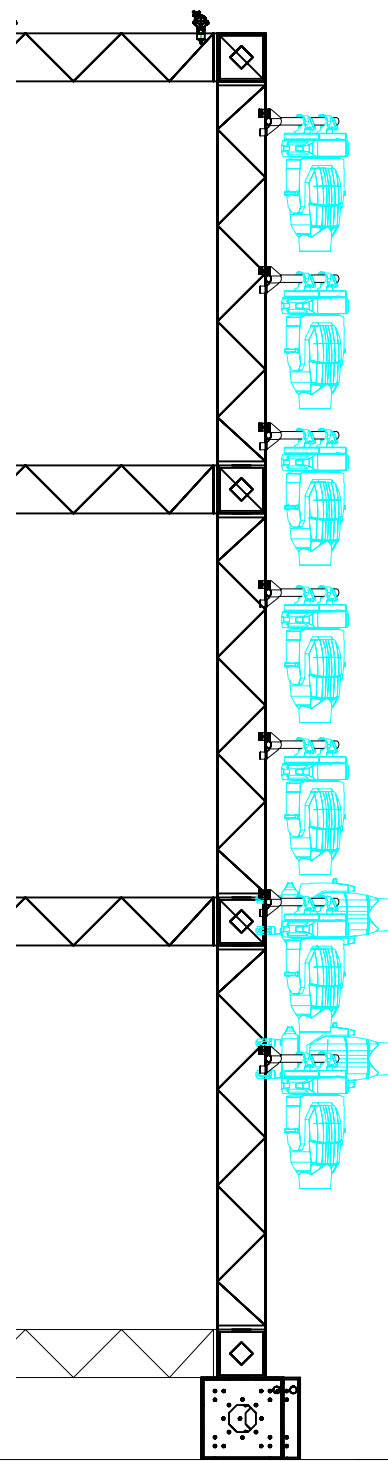

H TOWER 7
Scale: 1/4" = 1'-0"

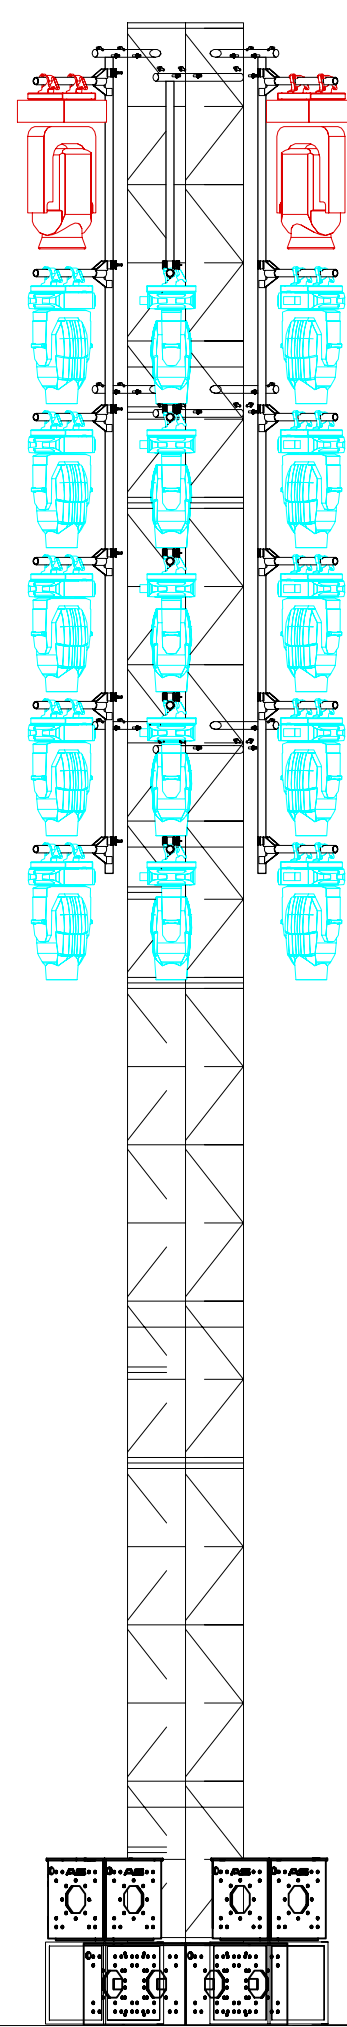

I TOWER 8
Scale: 1/4" = 1'-0"

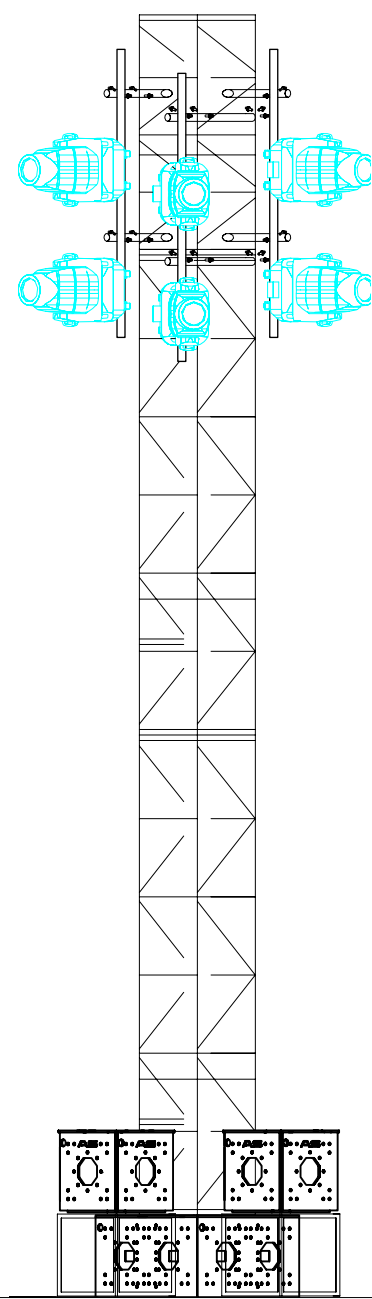

J TOWER 10
Scale: 1/4" = 1'-0"

INSTRUMENT KEY

- ETC Source 4 19 deg Lustr
- ETC Source 4 26 deg LED HD
- ETC Source 4 36 deg LED HD
- PRG Best Boy HP Ground Control
- PRG Best Boy HP
- VL3500 WASH
- VL2600 PROFILE
- PROTEUS HYBRID
- GLP Impression X4
- SMG P-1
- SGM P10
- SKYPANEL S60-C
- ETC Source 4 PAR WFL
- WW CW TABLE LAMP
- COLOR FORCE II 12
- COLOR FORCE II 48
- COLOR FORCE II 72

VENUE

UNION STATION
LOS ANGELES, CA

SHOW

93RD OSCARS

LOAD IN	SHOWDAY	SHOW #
2017-07-31	01/01/01	#2109

DESIGNER	DICKINSON/MITZ
LEAD L.D.	BERGER/GREEN
GAFFER	SISUL
PROG. 1:	O'REILLY
PROG. 2:	BOOZER
LEAD TECH	BEAGHAN

AS BUILT

0" 1" 2"

PRINT ARCH D SHEET

DRAWN BY: BERGER SCALE:

- 1 - OVERVIEW
- 2 - 3D ISO
- 3 - TOWER DETAILS
- 4 - FLOOR

SHEET

3

PUBLISH DATE: 04/25/2021

TOWER DETAILS