

SOURCE FOUR 10° @ 750w

SOURCE FOUR 14° @ 750w

SOURCE FOUR 19° @ 750w

SOURCE FOUR 26° @ 750w


SOURCE FOUR 36° @ 750w



CHROMA-Q COLORFORCE II 72" STRIPLIGHT


PLACE UNDER 4 ELECTRIC.
UNITS FOCUS UPSTAGE TO BOUNCE.

Genomic map of the 1401-1461 region on chromosome 1. The map shows a series of genes: CYCLOW, COLORFORCE H72, and CYCLOW. The genes are arranged in a linear fashion, with CYCLOW genes flanking the COLORFORCE H72 genes. The map includes a scale bar at the top and a legend at the bottom.

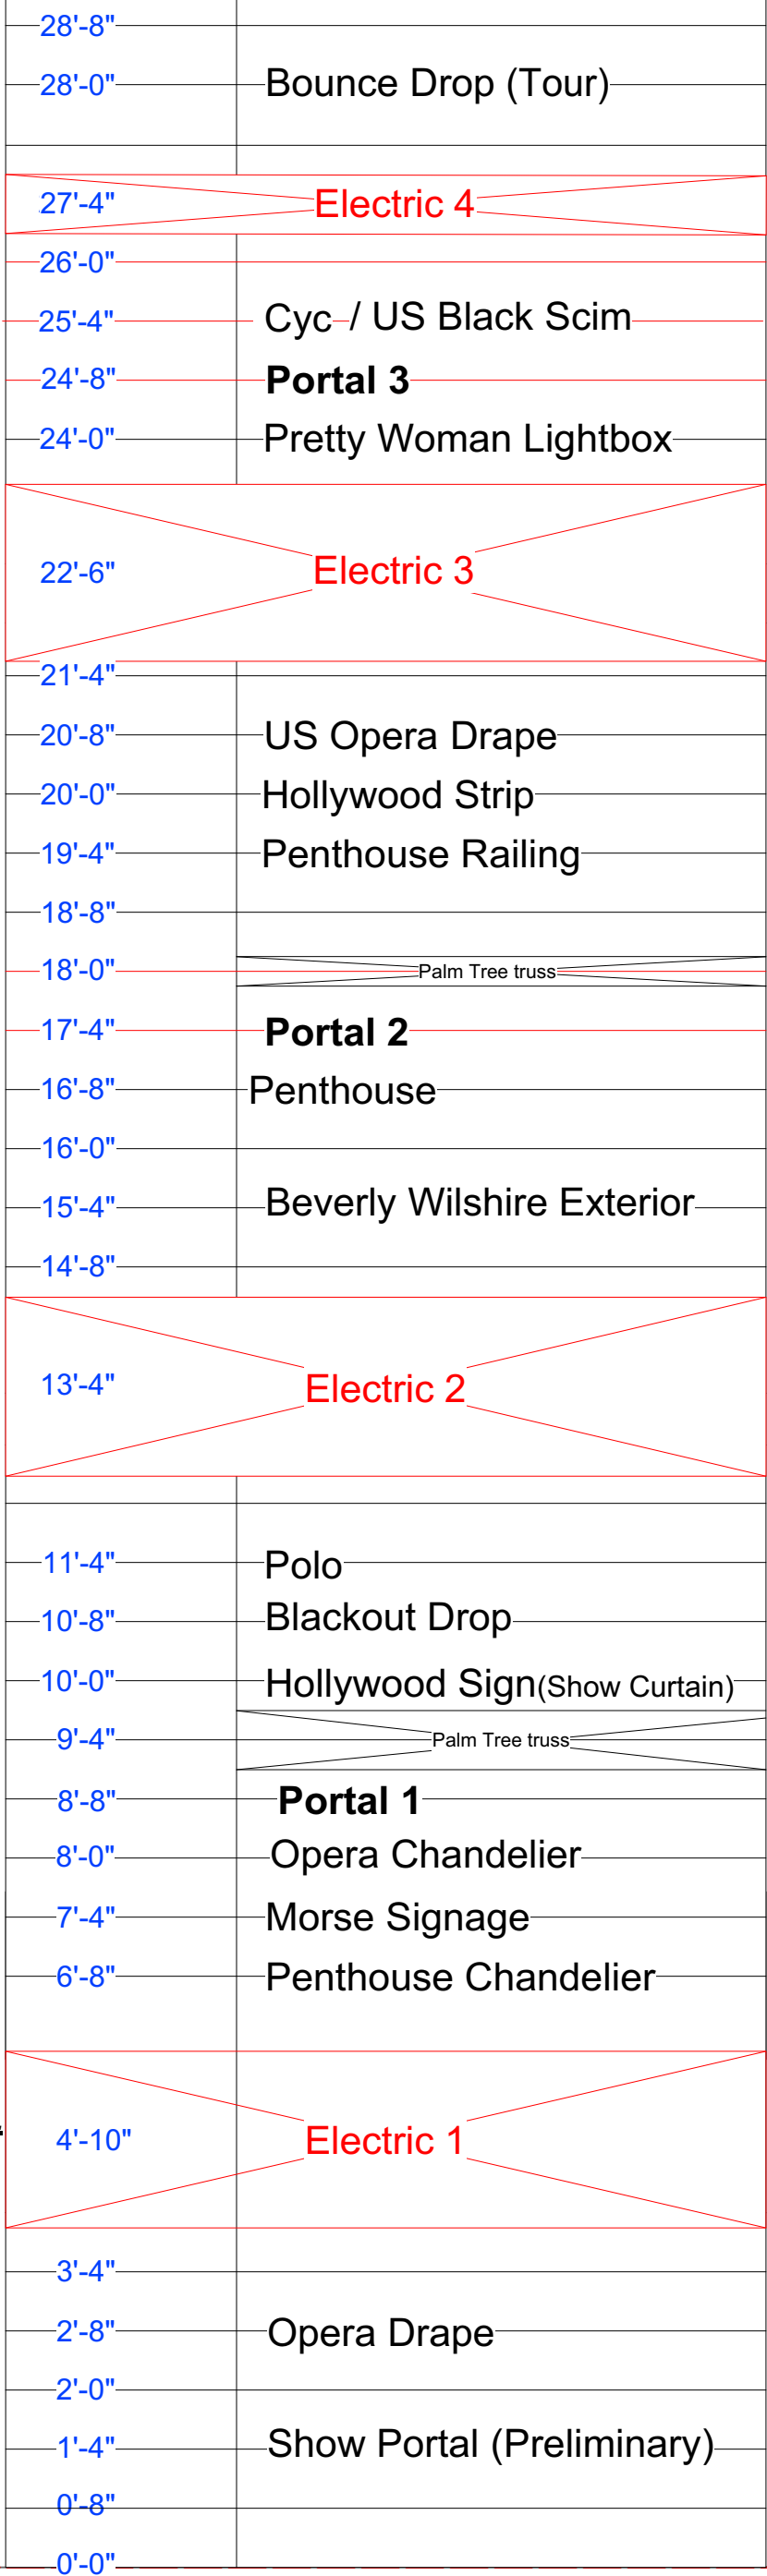

THIS DRAWING REPRESENTS A LIGHTING DESIGN THAT IS OWNED BY KENNETH POSNER & PHILIP ROSENBERG. NO REUSE OR DISTRIBUTION OF THIS DRAWING OTHER THAN AS AUTHORIZED FOR PRODUCING THE UNITED STATES TOUR OF "THE WOMAN OF THE MUSICAL" IS EXPLICITLY PROHIBITED AND VIOLATION OF COPYRIGHT LAWS IN THE US AND INTERNATIONALLY. ANY UNAUTHORIZED DISTRIBUTION OR USE OF THIS DRAWING IN ANY MANNER OR ACTION ON BEHALF OF THE DESIGNER, KENNETH POSNER & PHILIP ROSENBERG, WITHOUT THE WRITTEN DRAWING, AND THE LIGHTING DESIGN ITSELF, IS #02020 / KENNETH POSNER & PHILIP ROSENBERG. ALL RIGHTS RESERVED.

THIS DRAWING REPRESENTS VISUAL CONCEPTS AND CONSTRUCTION SUGGESTIONS ONLY. IT DOES NOT REPLACE THE KNOWLEDGE AND ADVICE OF A LICENSED STRUCTURAL ENGINEER. THE DESIGNER IS UNQUALIFIED TO DETERMINE THE STRUCTURAL APPROPRIATENESS OF THIS DESIGN AND WILL NOT ASSUME RESPONSIBILITY FOR IMPROPER ENGINEERING OR USE.

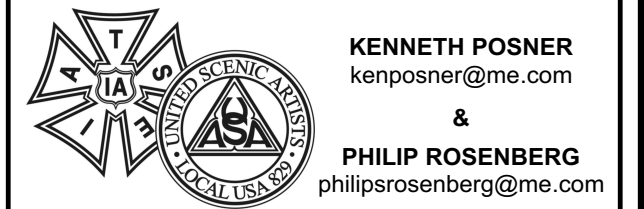

<u>G</u>	REVISION	XX/XX/XX
<u>F</u>	REVISION	XX/XX/XX
<u>E</u>	AS BUILT	13 OCT 21
<u>D</u>	REVISED GROUNDPLAN	02 AUG 21
<u>C</u>	FOR BID ONLY	13 AUG 20
<u>B</u>	FOR ELECTRICIAN	11 AUG 20
<u>A</u>	PRELIMINARY	22 JULY 20
REV	REVISION	DATE

PRETTY WOMAN
THE MUSICAL
MUSIC & LYRICS BY
BRYAN ADAMS & JIM VALLANCE
BOOK BY
GARRY MARSHALL & J.F. LAWTON
DIRECTED & CHOROGRAPHED BY
JERRY MITCHELL

SCENERY BY..... DAVID ROCKWELL
COSTUMES BY..... GREGG BARNES
SOUND BY..... JOHN SHIVERS
LIGHTING BY..... KENNETH POSNER &
 PHILIP ROSENBERG






SCALE: 1/2" = 1'-0"
EXCEPT WHERE NOTED
DATE: OCTOBER 13, 2021

RAWING

1

F 4

LIGHT PLOT

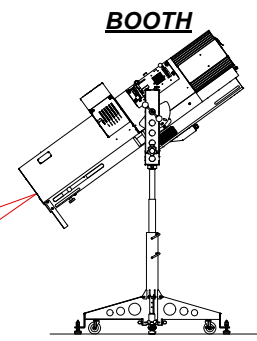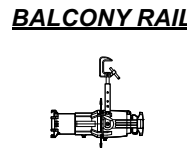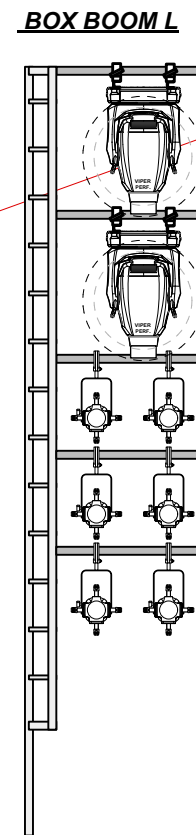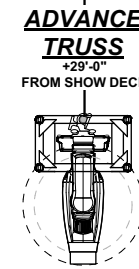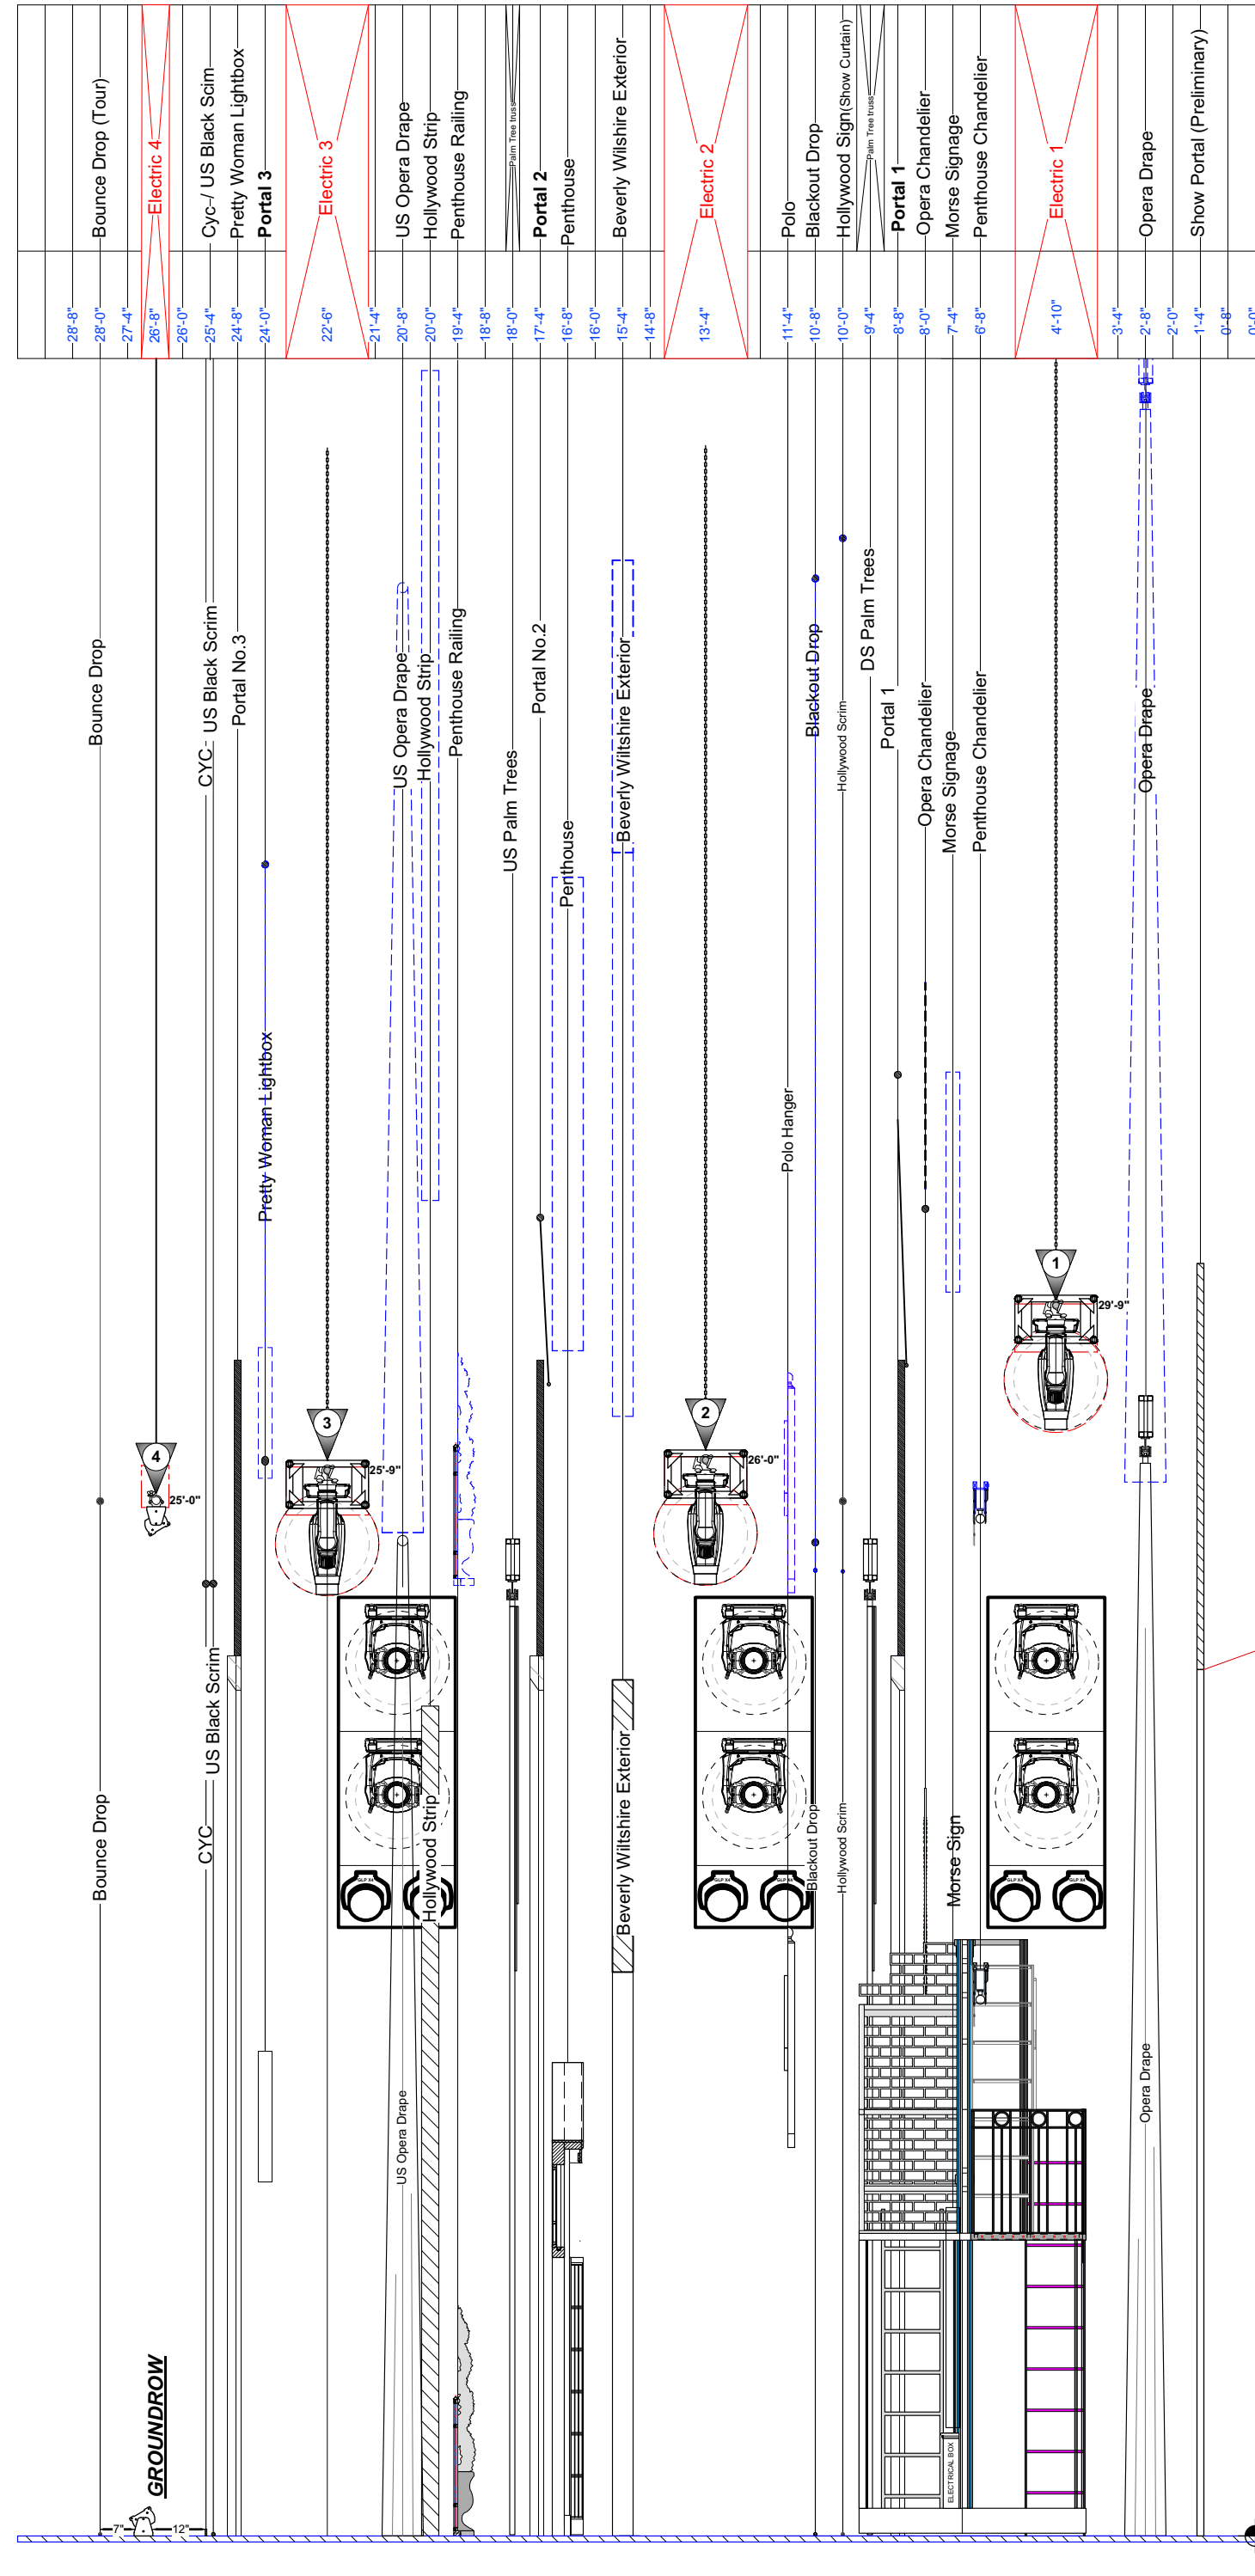

KEY TO SYMBOLS:

SOURCE FOUR 10° @ 750w

SOURCE FOUR 14° @ 750w

SOURCE FOUR 19° @ 750w

SOURCE FOUR 26° @ 750w

SOURCE FOUR 36° @ 750w

GANTOM ONE WW

MARTIN MAC VIPER PERFORMANCE @ 1kw

GLP IMPRESSION X4 w/ CONCENTRIC RINGS

COLORFORCE II 72

CHROMA-Q COLORFORCE II 72° STRIPLIGHT

TEMPLATE

UNIT #

LUSTR SERIES 2

CHANNEL #

THIS DRAWING REPRESENTS A LIGHTING DESIGN THAT IS WHOLLY OWNED BY KENNETH POSNER & PHILIP ROSENBERG. ANY USE OR DISTRIBUTION OF THIS DRAWING OTHER THAN AS REQUIRED FOR PRODUCING THE UNITED STATES TOUR OF "PRETTY WOMAN THE MUSICAL" IS EXPLICITLY PROHIBITED AND IS A VIOLATION OF COPYRIGHT LAWS IN THE US AND INTERNATIONALLY. ANY UNAUTHORIZED DISTRIBUTION OR USE WILL RESULT IN LEGAL ACTION ON BEHALF OF THE DESIGNER. THIS DRAWING AND THE LIGHTING DESIGN ITSELF IS ©2020 / 2021 KENNETH POSNER & PHILIP ROSENBERG. ALL RIGHTS RESERVED.

THIS DRAWING REPRESENTS VISUAL CONCEPTS AND CONSTRUCTION SUGGESTIONS ONLY. IT DOES NOT REPLACE THE KNOWLEDGE AND ADVICE OF A LICENSED STRUCTURAL ENGINEER. THE DESIGNER IS UNQUALIFIED TO DETERMINE THE STRUCTURAL APPROPRIATENESS OF THIS DESIGN AND WILL NOT ASSUME RESPONSIBILITY FOR IMPROPER ENGINEERING OR USE.

KENNETH POSNER
kenposner@me.com

PHILIP ROSENBERG
philiprosenberg@me.com

G	REVISION	XX/XX/XX
F	REVISION	XX/XX/XX
E	AS BUILT	13 OCT 21
D	REVISED GROUNDPLAN	02 AUG 21
C	FOR BID ONLY	13 AUG 20
B	FOR ELECTRICIAN	11 AUG 20
A	PRELIMINARY	22 JULY 20
REV	REVISION	DATE

PRETTY WOMAN

MUSIC & LYRICS BY
BRYAN ADAMS & JIM VALLANCE

BOOK BY
GARRY MARSHALL & J.F. LAWTON

DIRECTED & CHOREOGRAPHED BY
JERRY MITCHELL

SCENERY BY DAVID ROCKWELL

COSTUMES BY GREGG BARNES

SOUND BY JOHN SHIVERS

LIGHTING BY KENNETH POSNER & PHILIP ROSENBERG

US TOUR



SCALE: 1/2" = 1'-0"
EXCEPT WHERE NOTED
DATE: OCTOBER 13, 2021

DRAWING
2
OF 4

DRAWN BY: KF



SECTION

SCALE 1/4" = 1'-0"

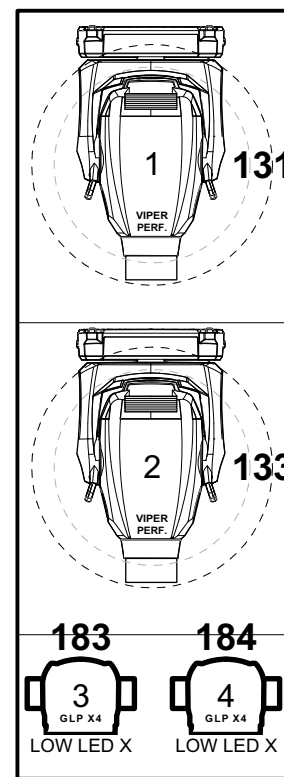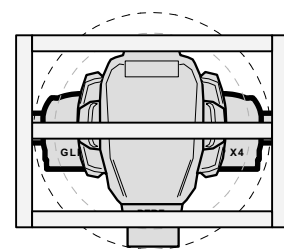



1 LADDER R

TRIM TO CLEAR +14'-9" FROM SHOW DECK.

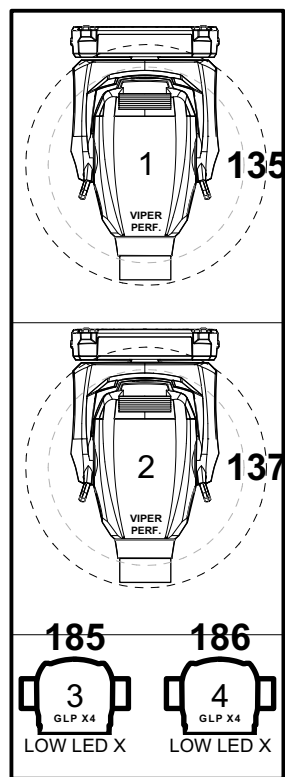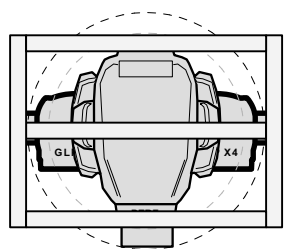



2 LADDER R

TRIM TO CLEAR +14'-9" FROM SHOW DECK.

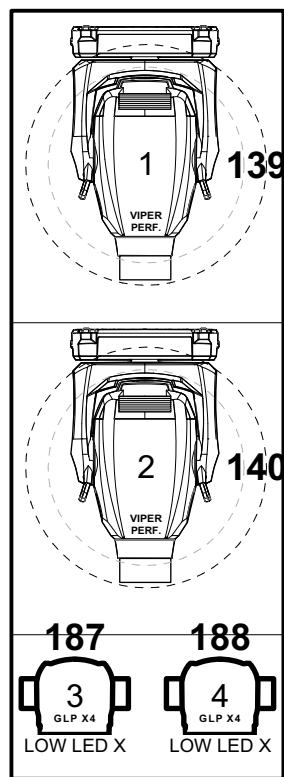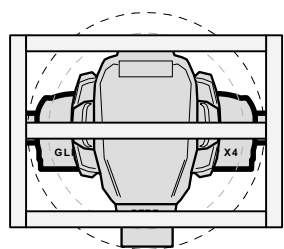



3 LADDER R

TRIM TO CLEAR +14'-9" FROM SHOW DECK.

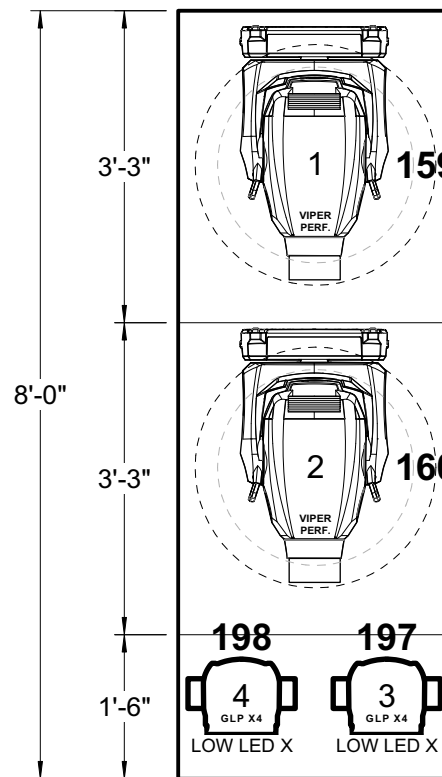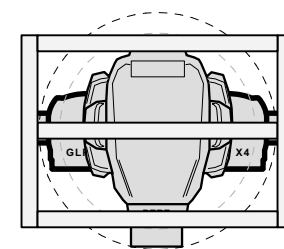



3 LADDER L

TRIM TO CLEAR +14'-9" FROM SHOW DECK.

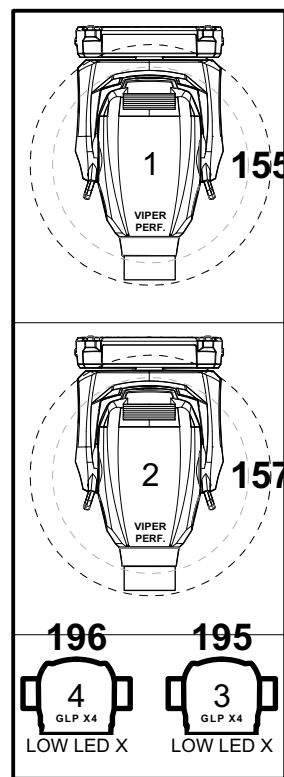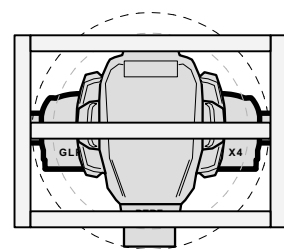

2 LADDER L




TRIM TO CLEAR +14'-9" FROM SHOW DECK.

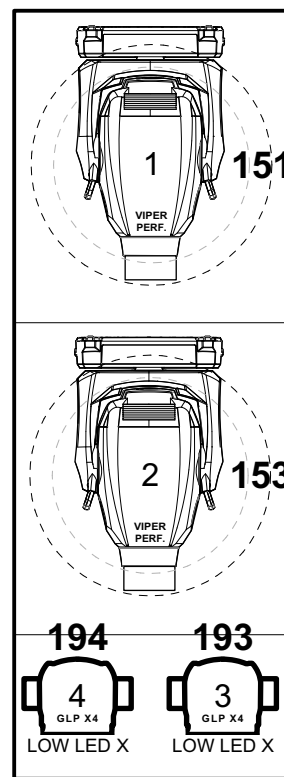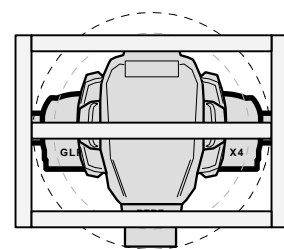

1 LADDER L


TRIM TO CLEAR +14'-9" FROM SHOW DECK.

KEY TO SYMBOLS:

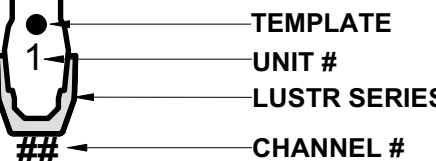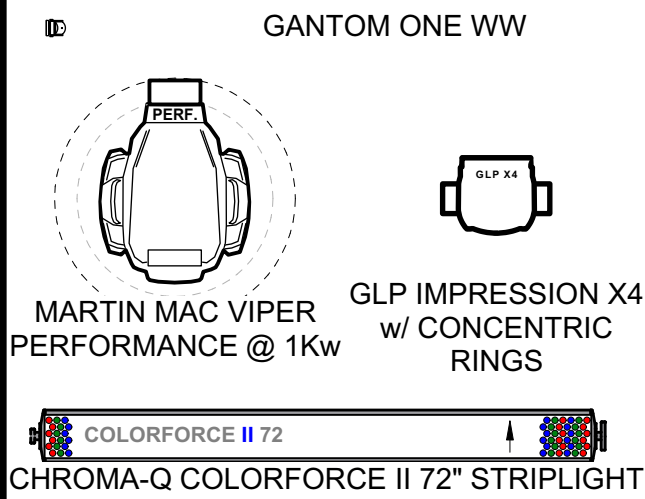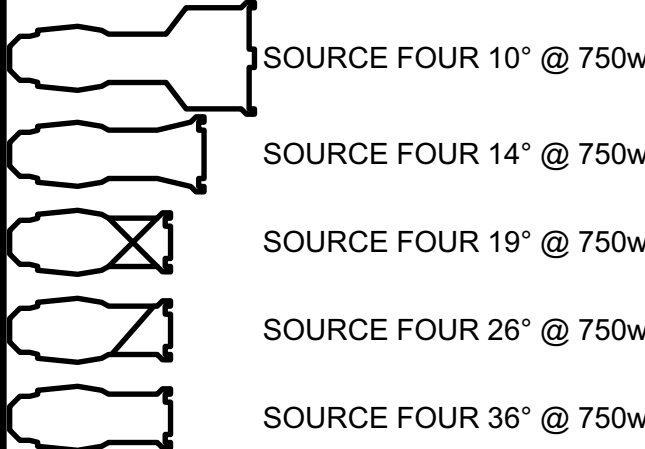


THIS DRAWING REPRESENTS A LIGHTING DESIGN THAT IS WHOLLY OWNED BY KENNETH POSNER & PHILIP ROSENBERG. ANY USE OR DISTRIBUTION OF THIS DRAWING OTHER THAN AS REQUIRED FOR PRODUCTION OF THE UNITED STATES TOUR OF "PRETTY WOMAN: THE MUSICAL" IS EXPLICITLY PROHIBITED AND IS A VIOLATION OF COPYRIGHT LAWS IN THE US AND INTERNATIONALLY. ANY UNAUTHORIZED DISTRIBUTION OR USE WILL RESULT IN LEGAL ACTION ON BEHALF OF THE DESIGNER. THIS DRAWING AND THE LIGHTING DESIGN ITSELF IS ©2020 / 2021 KENNETH POSNER & PHILIP ROSENBERG. ALL RIGHTS RESERVED.

THIS DRAWING REPRESENTS VISUAL CONCEPTS AND CONSTRUCTION SUGGESTIONS ONLY. IT DOES NOT REPLACE THE KNOWLEDGE AND ADVICE OF A LICENSED STRUCTURAL ENGINEER. THE DESIGNER IS UNQUALIFIED TO DETERMINE THE STRUCTURAL APPROPRIATENESS OF THIS DESIGN AND WILL NOT ASSUME RESPONSIBILITY FOR IMPROPER ENGINEERING OR USE.

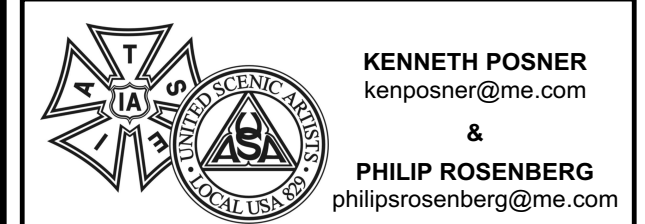

G	REVISION	XX/XX/XX
F	REVISION	XX/XX/XX
E	AS BUILT	13 OCT 21
D	REVISED GROUNDPLAN	02 AUG 21
C	FOR BID ONLY	13 AUG 20
B	FOR ELECTRICIAN	11 AUG 20
A	PRELIMINARY	22 JULY 20
REV	REVISION	DATE

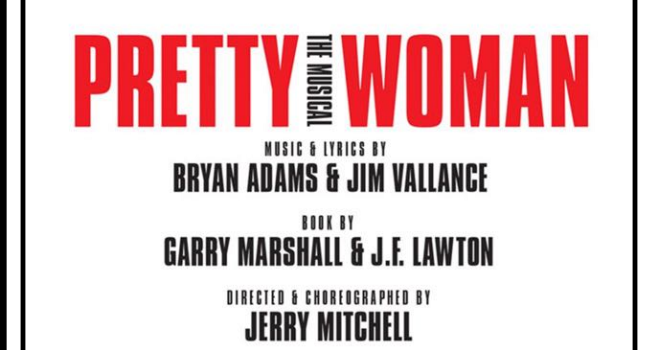


SCENERY BY DAVID ROCKWELL
COSTUMES BY GREGG BARNES
SOUND BY JOHN SHIVERS
LIGHTING BY KENNETH POSNER & PHILIP ROSENBERG

US TOUR

SCALE: 1/2" = 1'-0" EXCEPT WHERE NOTED DATE: OCTOBER 13, 2021	DRAWING 3 OF 4
---	-----------------------------

LADDERS & BOOMS

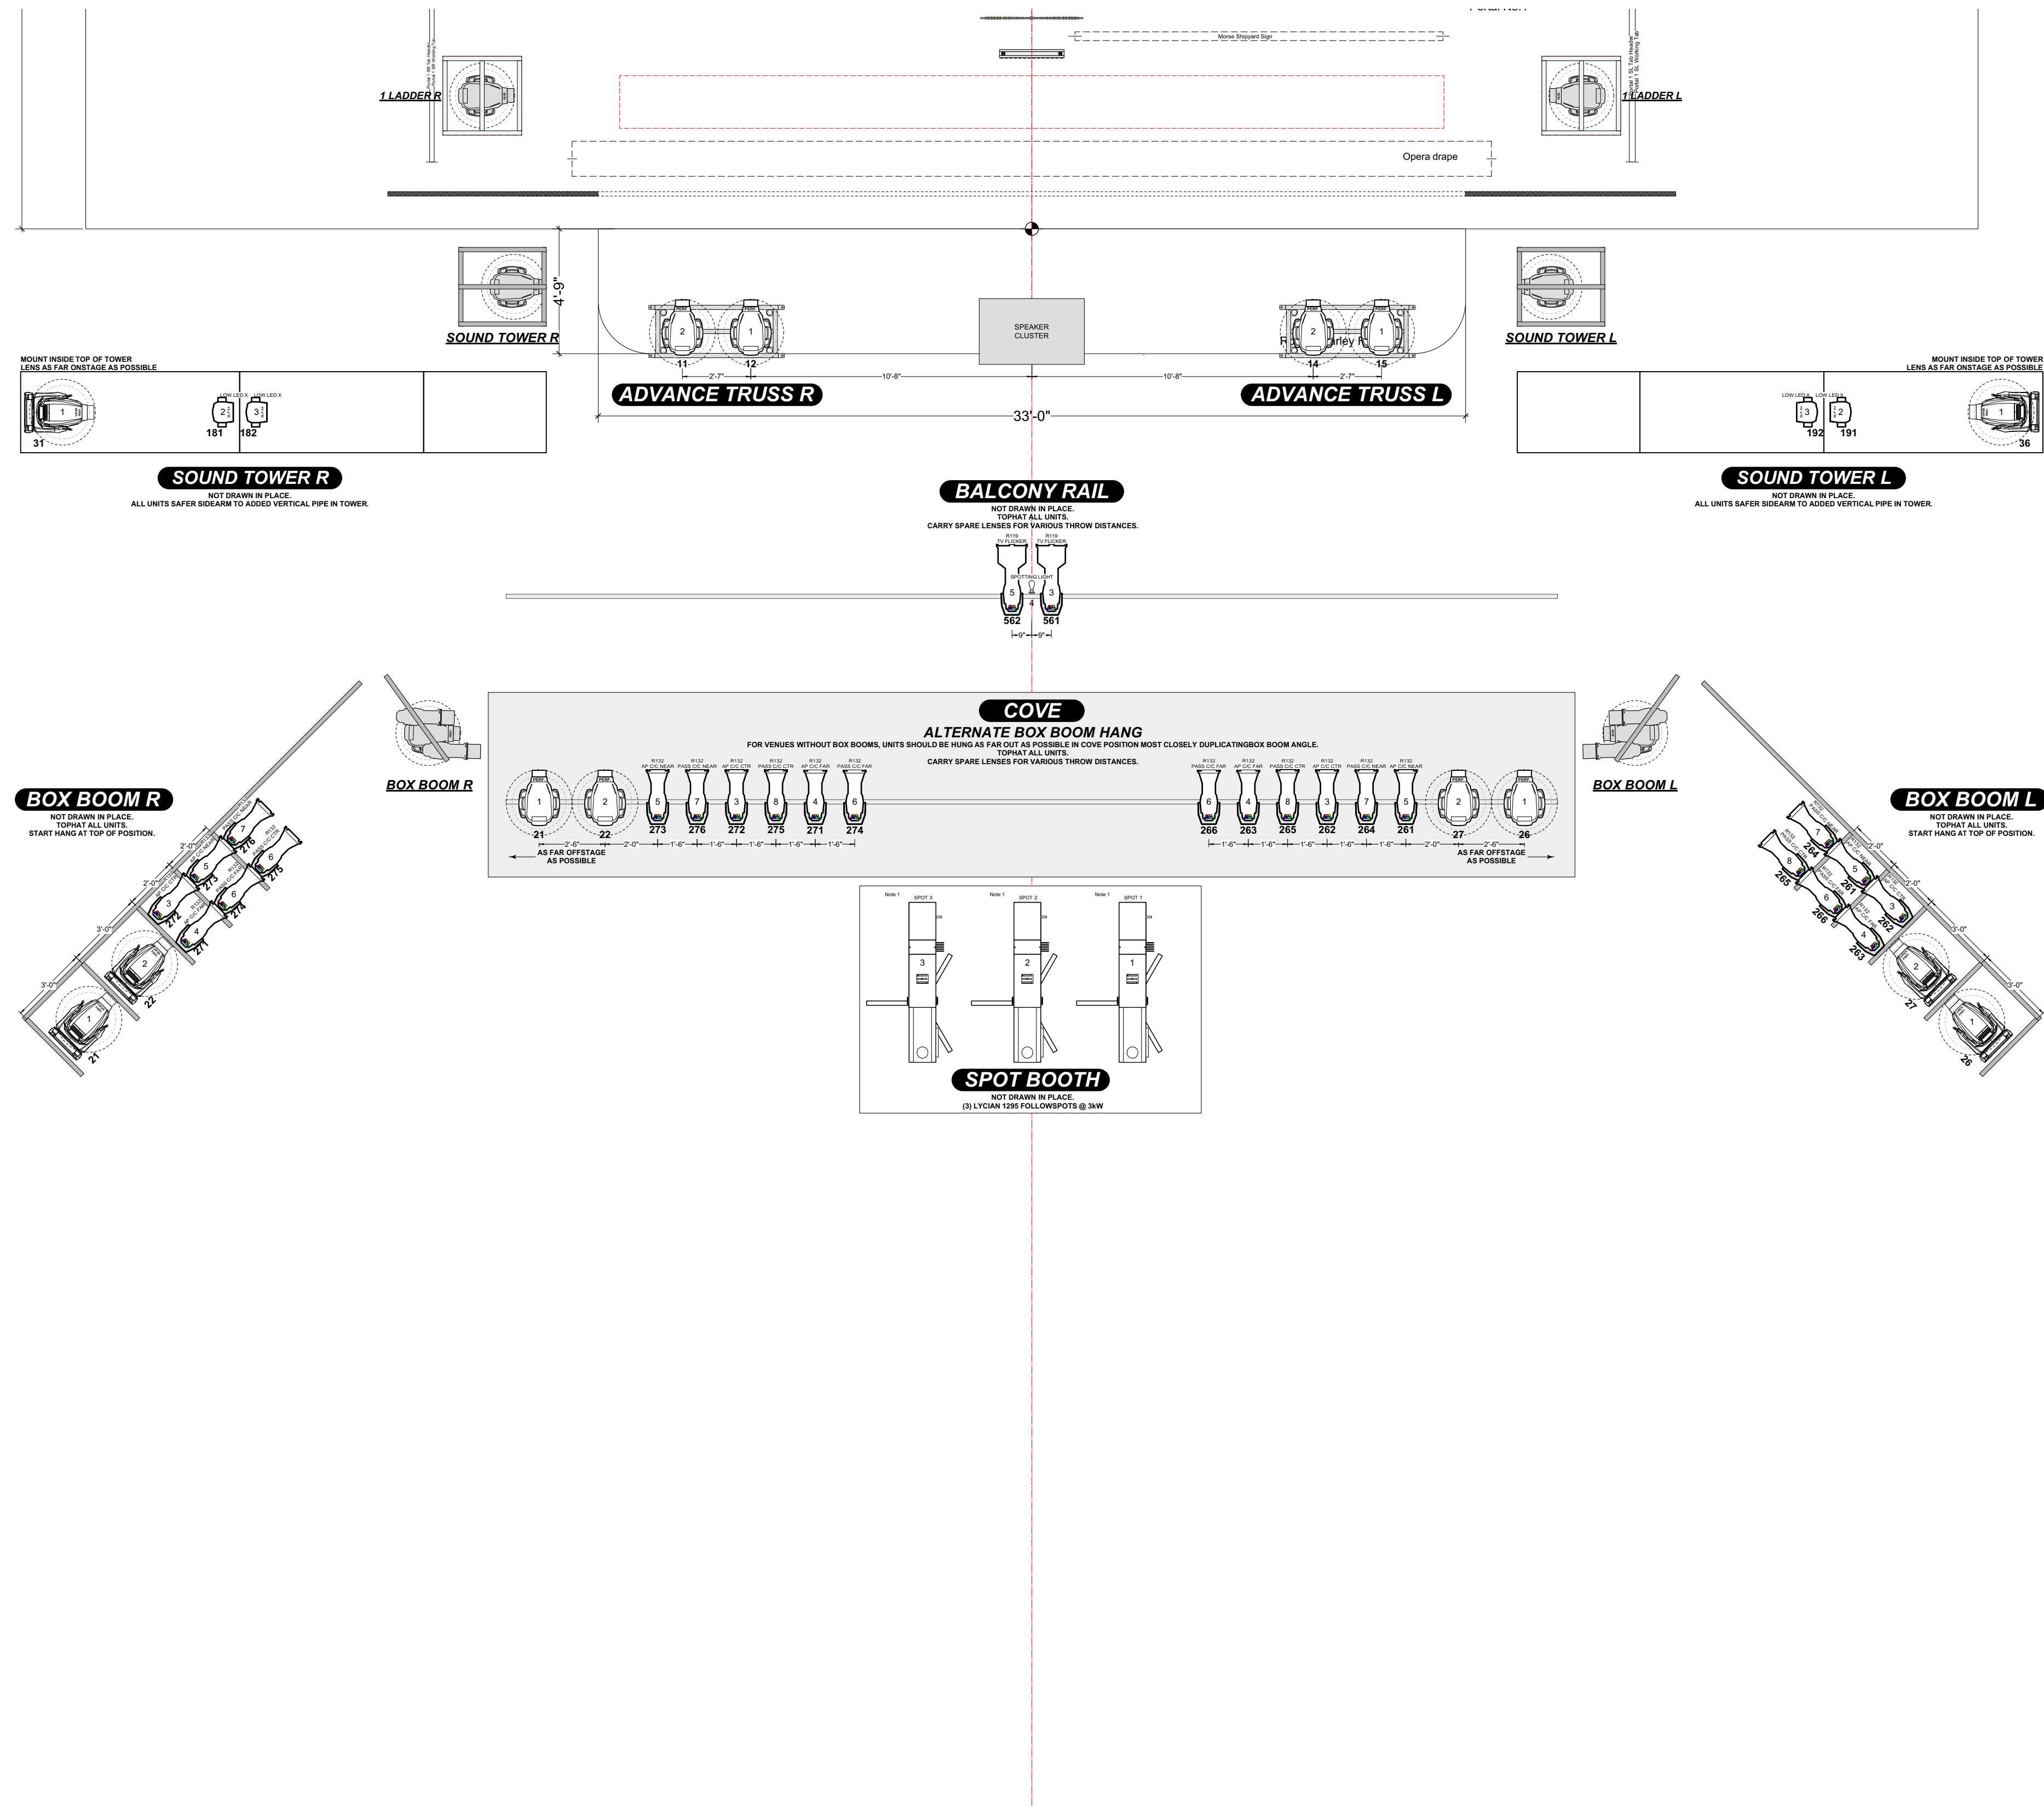

KEY TO SYMBOLS:

- SOURCE FOUR 10" @ 750w
- SOURCE FOUR 14" @ 750w
- SOURCE FOUR 19" @ 750w
- SOURCE FOUR 26" @ 750w
- SOURCE FOUR 36" @ 750w

- GANTOM ONE WW
- MARTIN MAC VIPER PERFORMANCE @ 1kw
- GLP IMPRESSION X4 w/ CONCENTRIC RINGS
- COLORFORCE II 72
- CHROMA-Q COLORFORCE II 72" STRIPLIGHT

- TEMPLATE
- UNIT #
- LUSTR SERIES 2
- CHANNEL #

THIS DRAWING REPRESENTS A LIGHTING DESIGN THAT IS WHOLLY OWNED BY KENNETH POSNER & PHILIP ROSENBERG. ANY USE OR DISTRIBUTION OF THIS DRAWING OTHER THAN AS REQUIRED FOR PRODUCING THE UNITED STATES TOUR OF "PRETTY WOMAN: THE MUSICAL" IS EXPLICITLY PROHIBITED AND IS A VIOLATION OF COPYRIGHT LAWS IN THE US AND INTERNATIONALLY. ANY UNAUTHORIZED DISTRIBUTION OR USE WILL RESULT IN LEGAL ACTION ON BEHALF OF THE DESIGNER. THIS DRAWING AND THE LIGHTING DESIGN ITSELF IS ©2020 / 2021 KENNETH POSNER & PHILIP ROSENBERG. ALL RIGHTS RESERVED.

THIS DRAWING REPRESENTS VISUAL CONCEPTS AND CONSTRUCTION SUGGESTIONS ONLY. IT DOES NOT REPLACE THE KNOWLEDGE AND ADVICE OF A LICENSED STRUCTURAL ENGINEER. THE DESIGNER IS UNQUALIFIED TO DETERMINE THE STRUCTURAL APPROPRIATENESS OF THIS DESIGN AND WILL NOT ASSUME RESPONSIBILITY FOR IMPROPER ENGINEERING OR USE.

KENNETH POSNER
kenposner@me.com
&
PHILIP ROSENBERG
philiprosenberg@me.com

REV	REVISION	DATE
G	REVISION	XX/XX/XX
F	REVISION	XX/XX/XX
E	AS BUILT	13 OCT 21
D	REVISED GROUNDPLAN	02 AUG 21
C	FOR BID ONLY	13 AUG 20
B	FOR ELECTRICIAN	11 AUG 20
A	PRELIMINARY	22 JULY 20

PRETTY WOMAN
MUSIC & LYRICS BY
BRYAN ADAMS & JIM VALLANCE
BOOK BY
GARRY MARSHALL & J.F. LAWTON
DIRECTED & CHOREOGRAPHED BY
JERRY MITCHELL

SCENERY BY DAVID ROCKWELL
COSTUMES BY GREGG BARNES
SOUND BY JOHN SHIVERS
LIGHTING BY KENNETH POSNER & PHILIP ROSENBERG

US TOUR

SCALE: 1/2" = 1'-0" EXCEPT WHERE NOTED DATE: OCTOBER 13, 2021	DRAWING 4 OF 4
---	-----------------------------

FOH PLOT

SCALE 1/4" = 1'-0"