


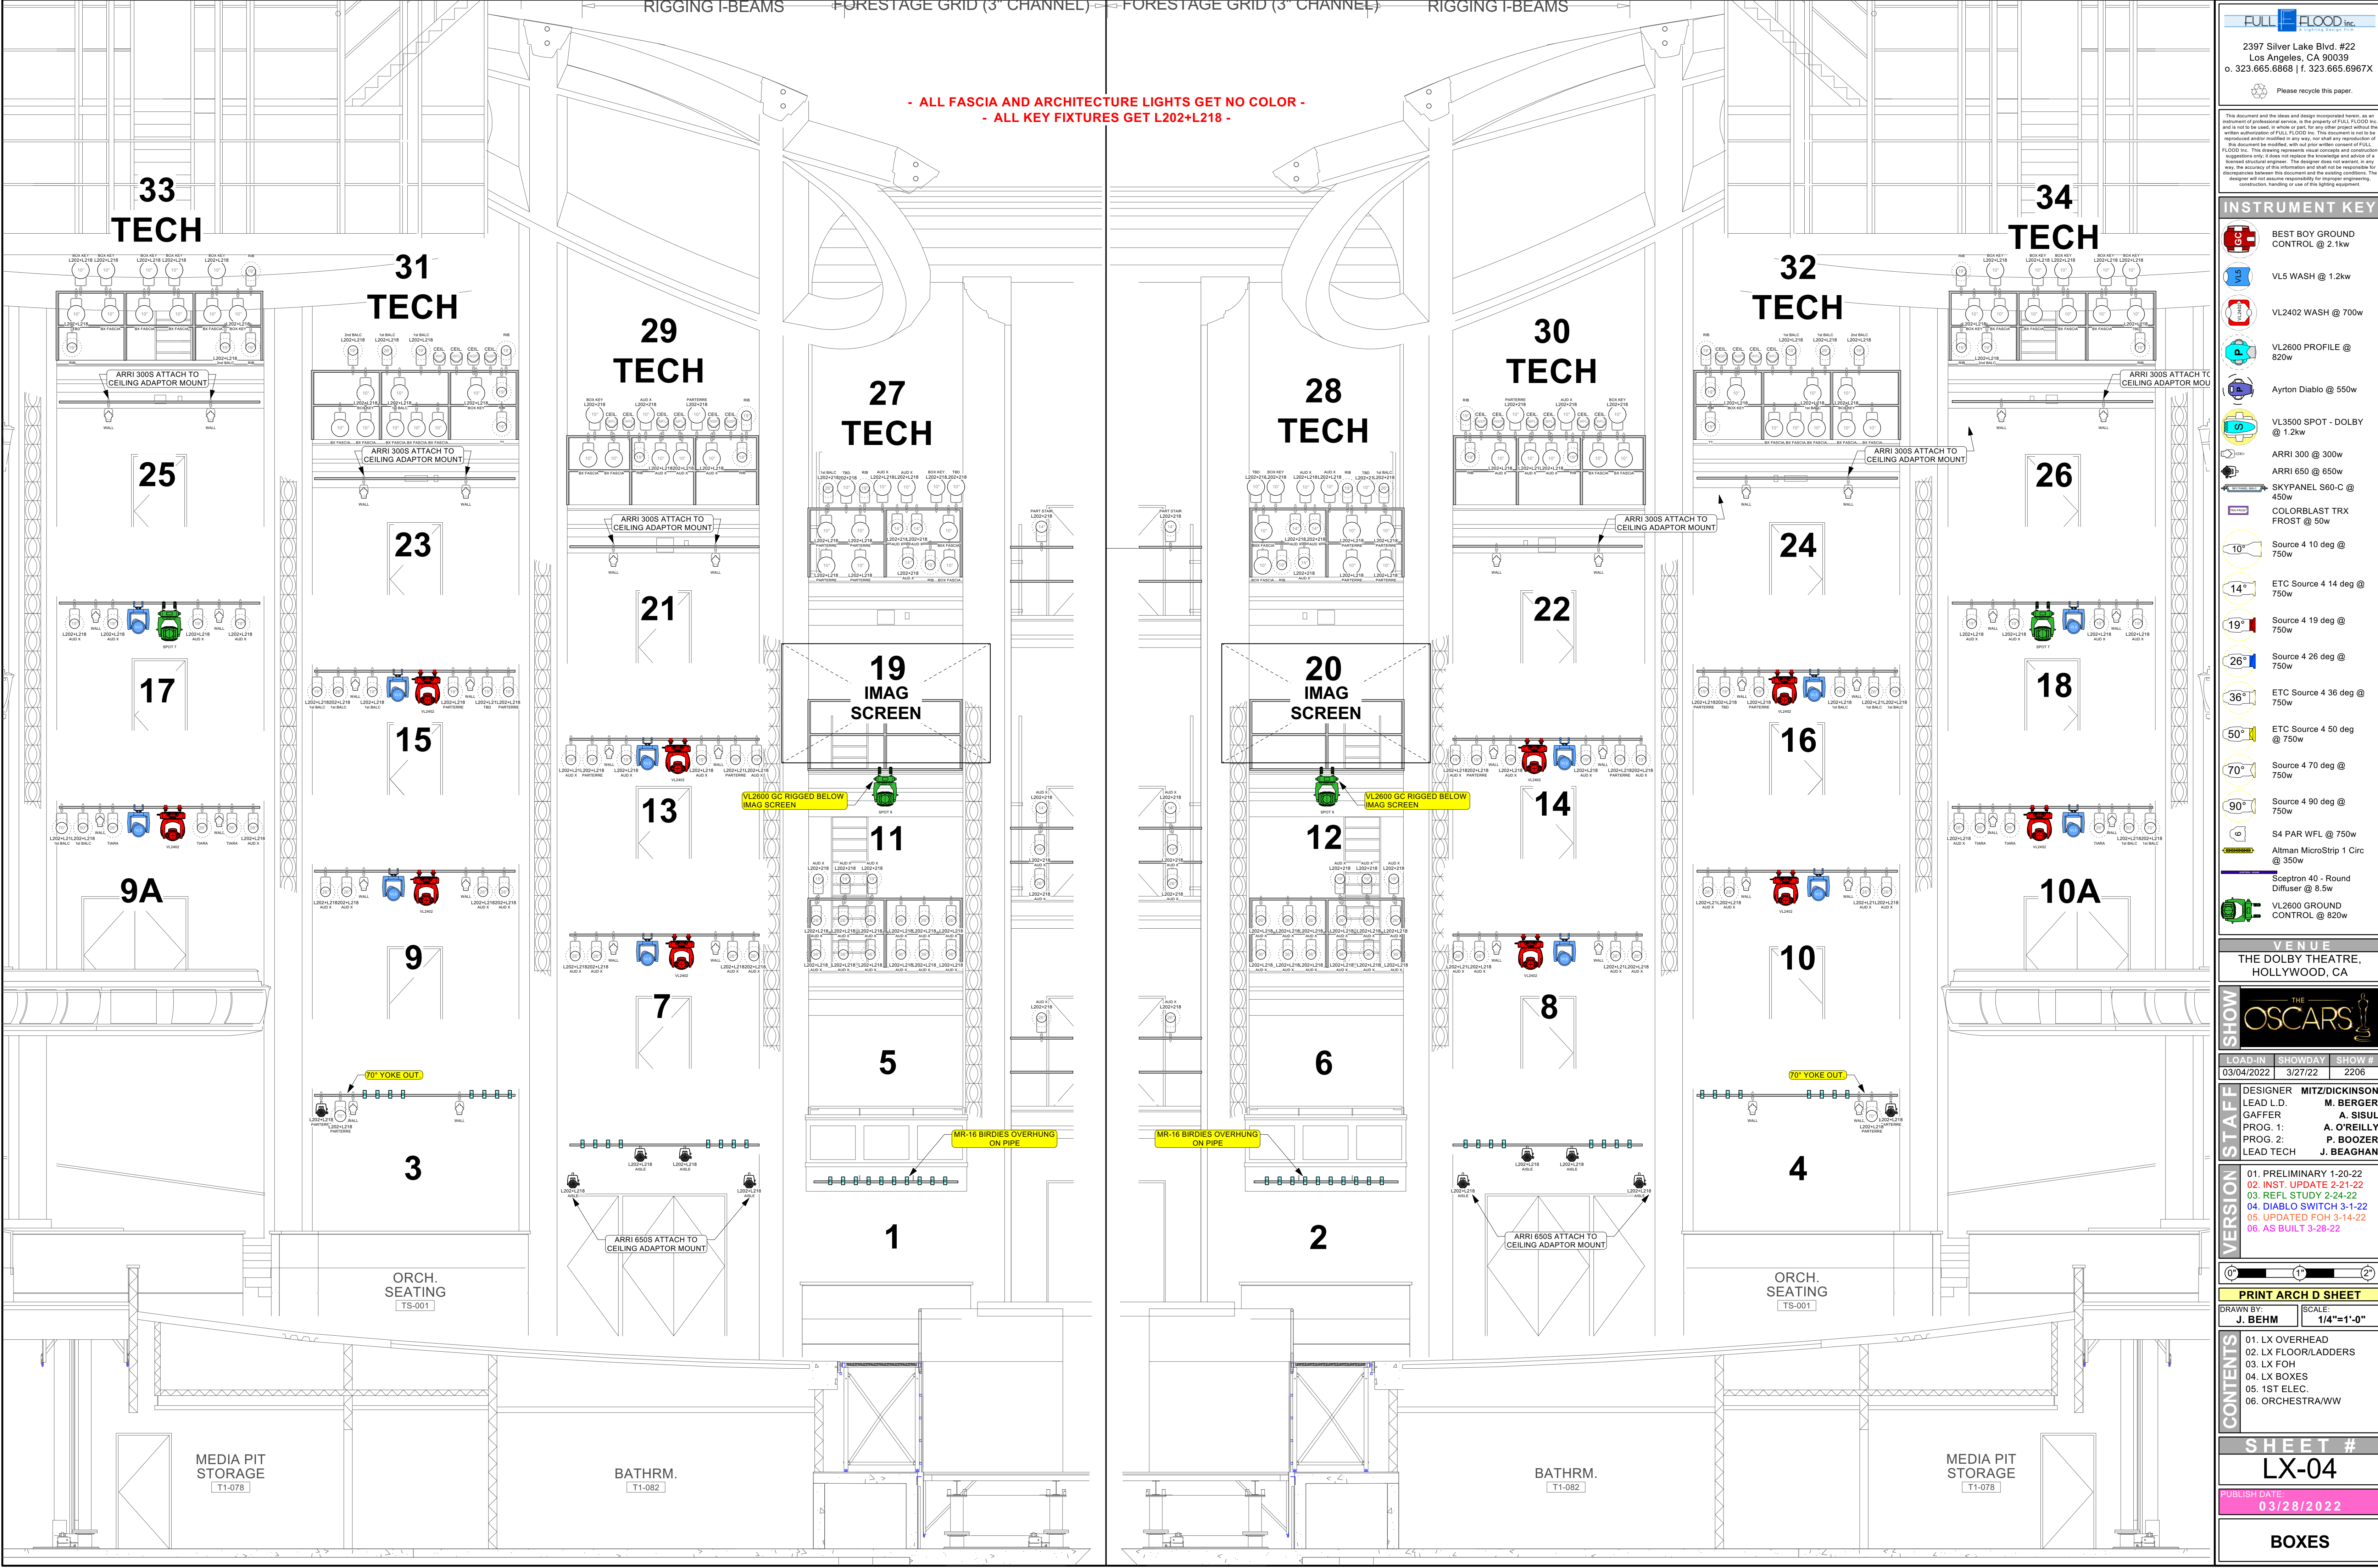

2397 Silver Lake Blvd. #22
Los Angeles, CA 90039
o. 323.665.6868 | f. 323.665.6967X

Please recycle this paper.

This document and the ideas and design incorporated herein, as an instrument of professional service, is the property of FULL FLOOD Inc. and is not to be used, in whole or in part, for any other project without the written authorization of FULL FLOOD Inc. This document is not to be reproduced and/or modified in any way. Your use of any reproduction of this document is limited to the specific project and location for which it was prepared. This drawing represents visual concepts and considerations. It is not a contract. It is not a guarantee of performance. It is not a substitute for the services of a licensed structural engineer. The designer does not warrant, in any way, the accuracy of any information and shall not be responsible for discrepancies between this document and the existing conditions. The designer will not assume responsibility for improper engineering, construction, handling or use of this lighting equipment.

	BEST BOY GROUND CONTROL @ 2.1kw
	VL5 WASH @ 1.2kw
	VL2402 WASH @ 700w
	VL2600 PROFILE @ 820w
	Ayrton Diablo @ 550w
	VL3500 SPOT - DOLBY @ 1.2kw
	ARRI 300 @ 300w
	ARRI 650 @ 650w
	SKYPANEL S60-C @ 450w
	COLORBLAST TRX FROST @ 50w
	Source 4 10 deg @ 750w
	ETC Source 4 14 deg @ 750w
	Source 4 19 deg @ 750w
	ETC Source 4 26 deg @ 750w
	ETC Source 4 36 deg @ 750w
	ETC Source 4 50 deg @ 750w
	Source 4 70 deg @ 750w
	Source 4 90 deg @ 750w
	S4 PAR WFL @ 750w
	Altman MicroStrip 1 Circ @ 350w
	Scepter 40 - Round Diffuser @ 8.5w
	VL2600 GROUND CONTROL @ 820w

VENUE

THE DOLBY THEATRE, HOLLYWOOD, CA

SHOW

THE OSCARS

LOAD-IN	SHOWDAY	SHOW #
03/04/2022	3/27/22	2206

DESIGNER MITZ/DICKINSON

LEAD L.D. M. BERGER

GAFFER A. SISUL

PROG. 1: A. O'REILLY

PROG. 2: P. BOOZER

LEAD TECH J. BEAGHAN

VERSION

01. PRELIMINARY 1-20-22

02. INST. UPDATE 2-21-22

03. REFL STUDY 2-24-22

04. DIABLO SWITCH 3-1-22

05. UPDATED FOH 3-14-22

06. AS BUILT 3-28-22

0' 1' 2'

PRINT ARCH D SHEET

DRAWN BY: J. BEHM

SCALE: 1/4"=1'-0"

CONTENTS

01. LX OVERHEAD

02. LX FLOOR/LADDERS

03. LX FOH

04. LX BOXES

05. 1ST ELEC.

06. ORCHESTRA/WW

SHEET #

LX-04

PUBLISH DATE: 03/28/2022

BOXES