


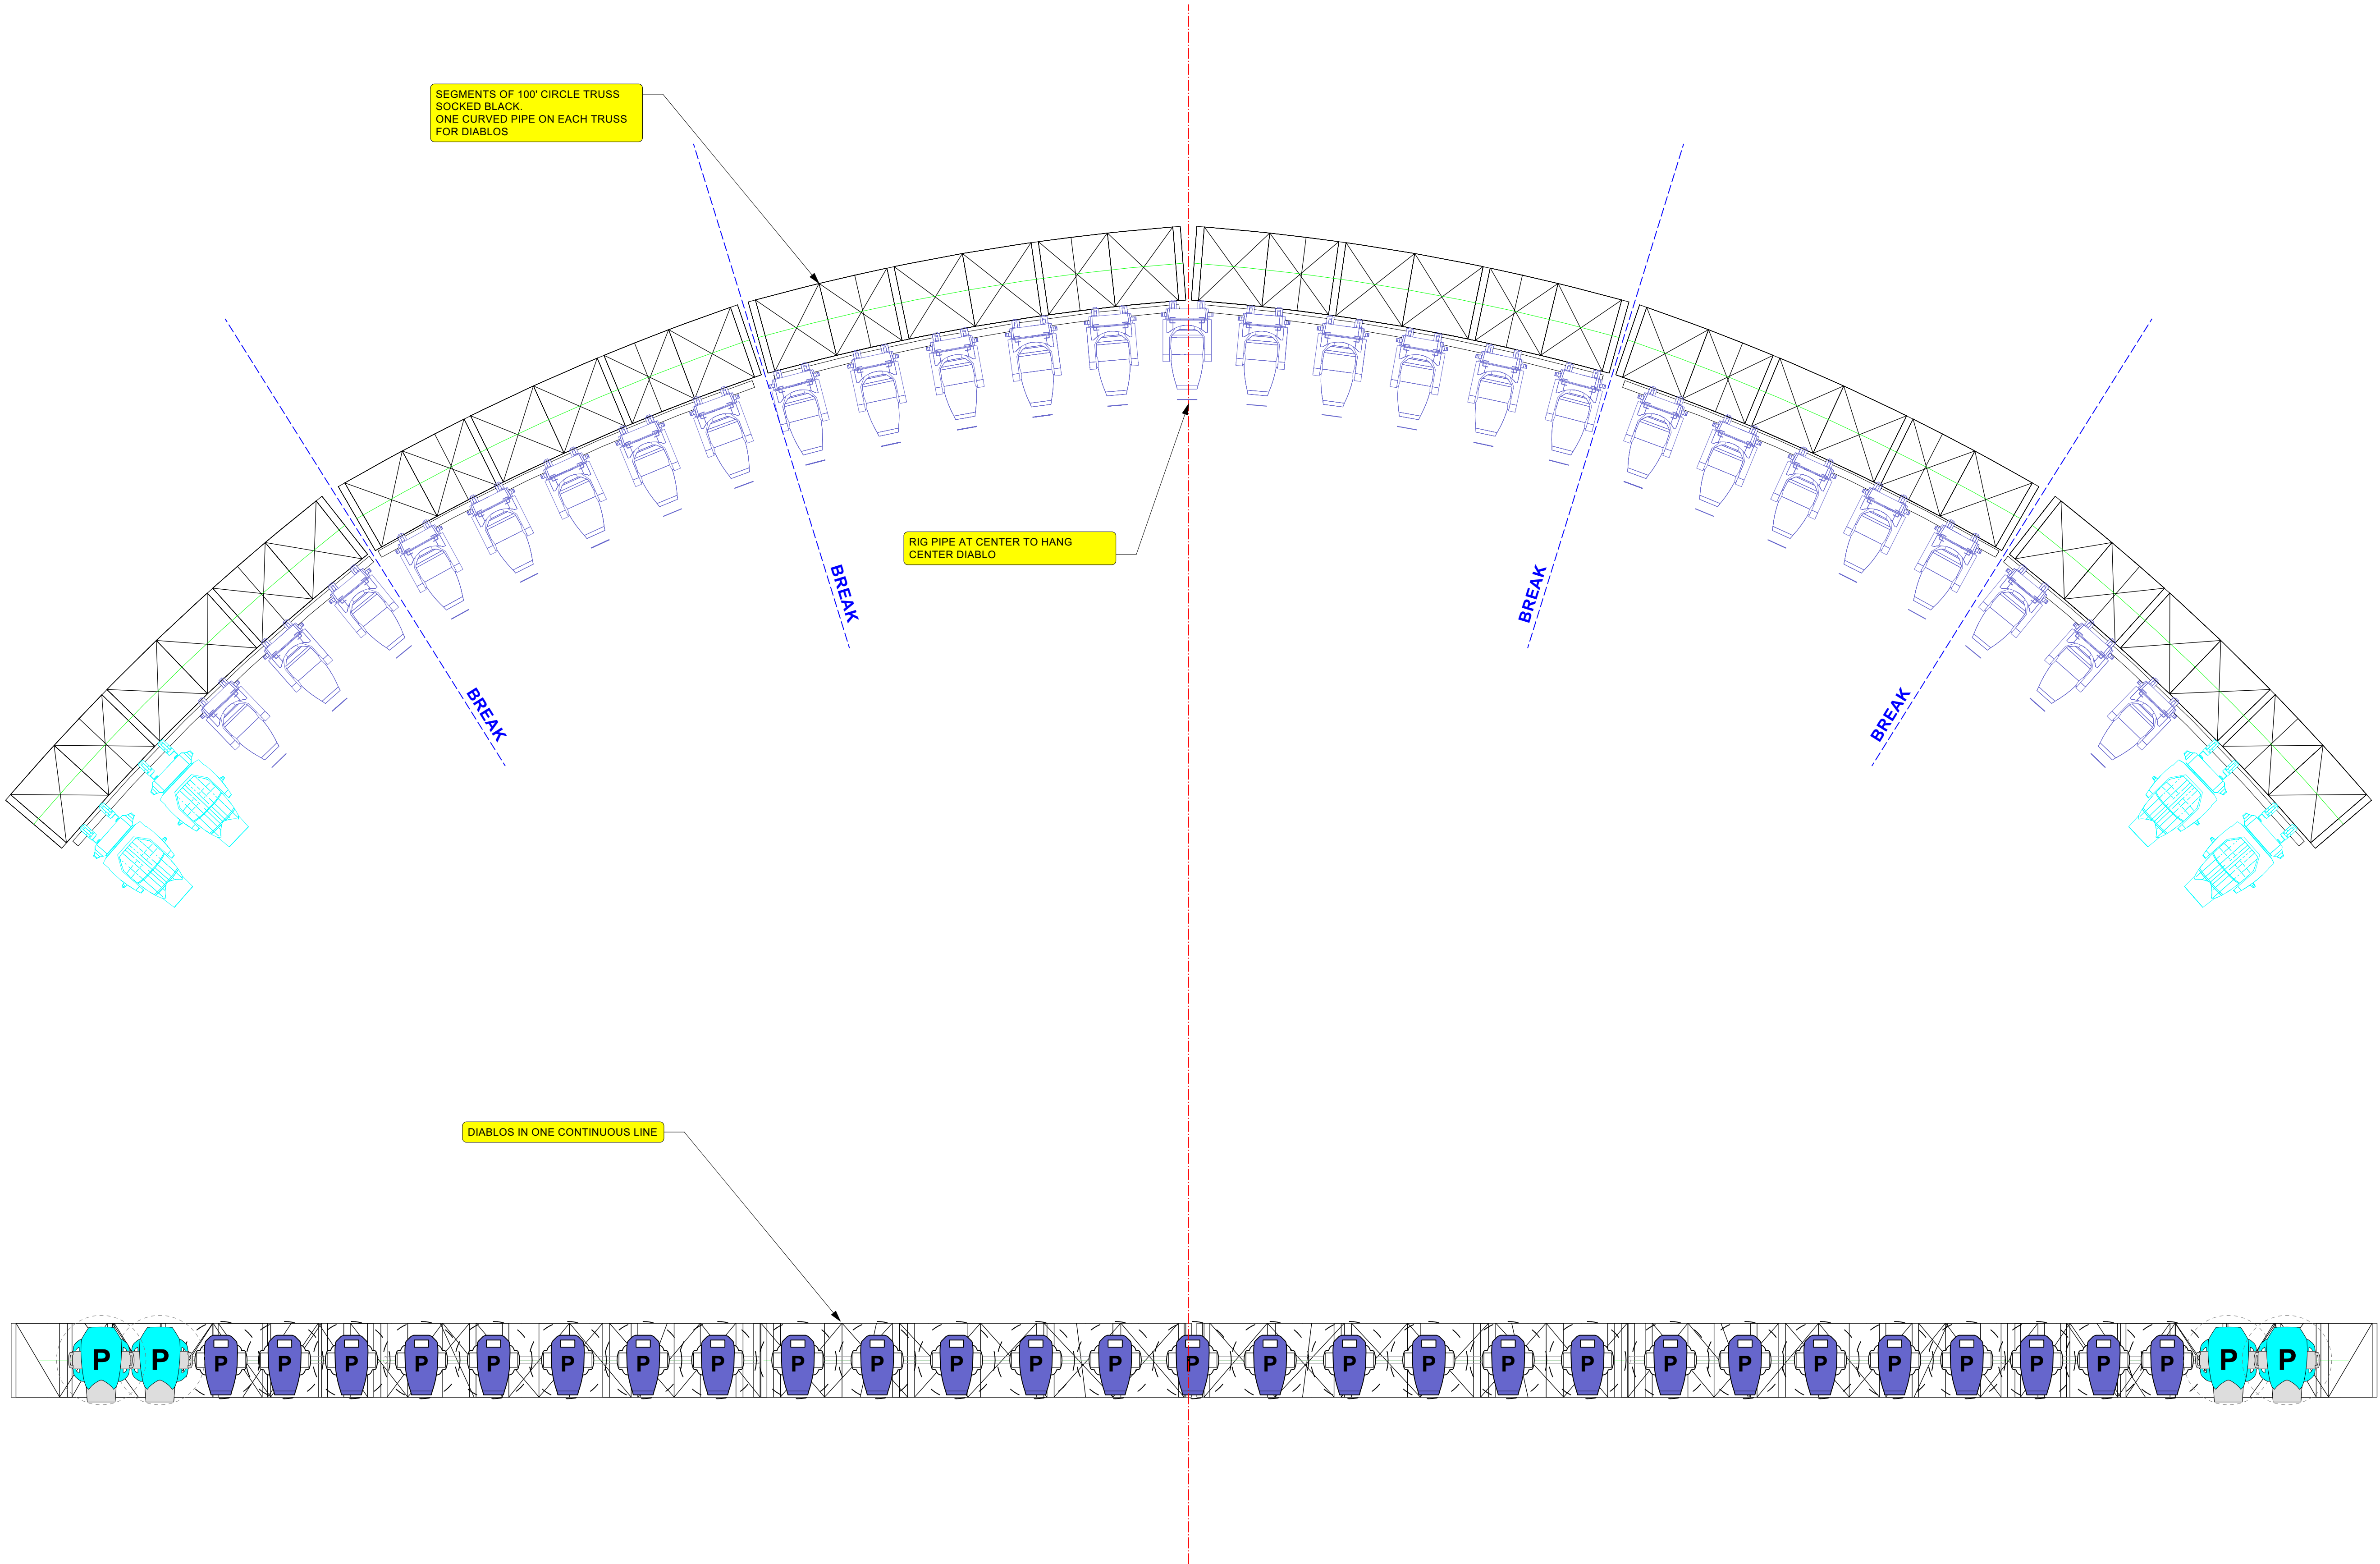

1 1ST ELECTRIC DETAIL
Scale: 1/2" = 1'-0"

INSTRUMENT KEY

- BEST BOY GROUND CONTROL @ 2.1kw
- VL5 WASH @ 1.2kw
- VL2402 WASH @ 700w
- VL2600 PROFILE @ 820w
- Ayrton Diablo @ 550w
- VL3500 SPOT - DOLBY @ 1.2kw
- ARRI 300 @ 300w
- ARRI 650 @ 650w
- SKYPANEL S60-C @ 450w
- COLORBLAST TRX FROST @ 50w
- Source 4 10 deg @ 750w
- ETC Source 4 14 deg @ 750w
- Source 4 19 deg @ 750w
- Source 4 26 deg @ 750w
- ETC Source 4 36 deg @ 750w
- ETC Source 4 50 deg @ 750w
- Source 4 70 deg @ 750w
- Source 4 90 deg @ 750w
- S4 PAR WFL @ 750w
- Altman MicroStrip 1 Circ @ 350w
- Sceptron 40 - Round Diffuser @ 8.5w
- VL2600 GROUND CONTROL @ 820w

VENUE

THE DOLBY THEATRE,
HOLLYWOOD, CA

SHOW

THE OSCARS

LOAD-IN	SHOWDAY	SHOW #
03/04/2022	3/27/22	2206

DESIGNER	MITZ/DICKINSON
LEAD L.D.	M. BERGER
GAFFER	A. SISUL
PROG. 1:	A. O'REILLY
PROG. 2:	P. BOOZER
LEAD TECH	J. BEAGHAN

VERSION	01. PRELIMINARY 1-20-22
02.	INST. UPDATE 2-21-22
03.	REFL STUDY 2-24-22
04.	DIABLO SWITCH 3-1-22
05.	UPDATED FOH 3-14-22
06.	AS BUILT 3-28-22

0'	1'	2'
----	----	----

PRINT ARCH D SHEET

DRAWN BY:	J. BEHM	SCALE:	1/4"=1'-0"
-----------	---------	--------	------------

CONTENTS	01. LX OVERHEAD 02. LX FLOOR/LADDERS 03. LX FOH 04. LX BOXES 05. 1ST ELEC. 06. ORCHESTRA/WW
----------	--

SHEET

LX-05

PUBLISH DATE:
03/28/2022

1ST ELEC.