
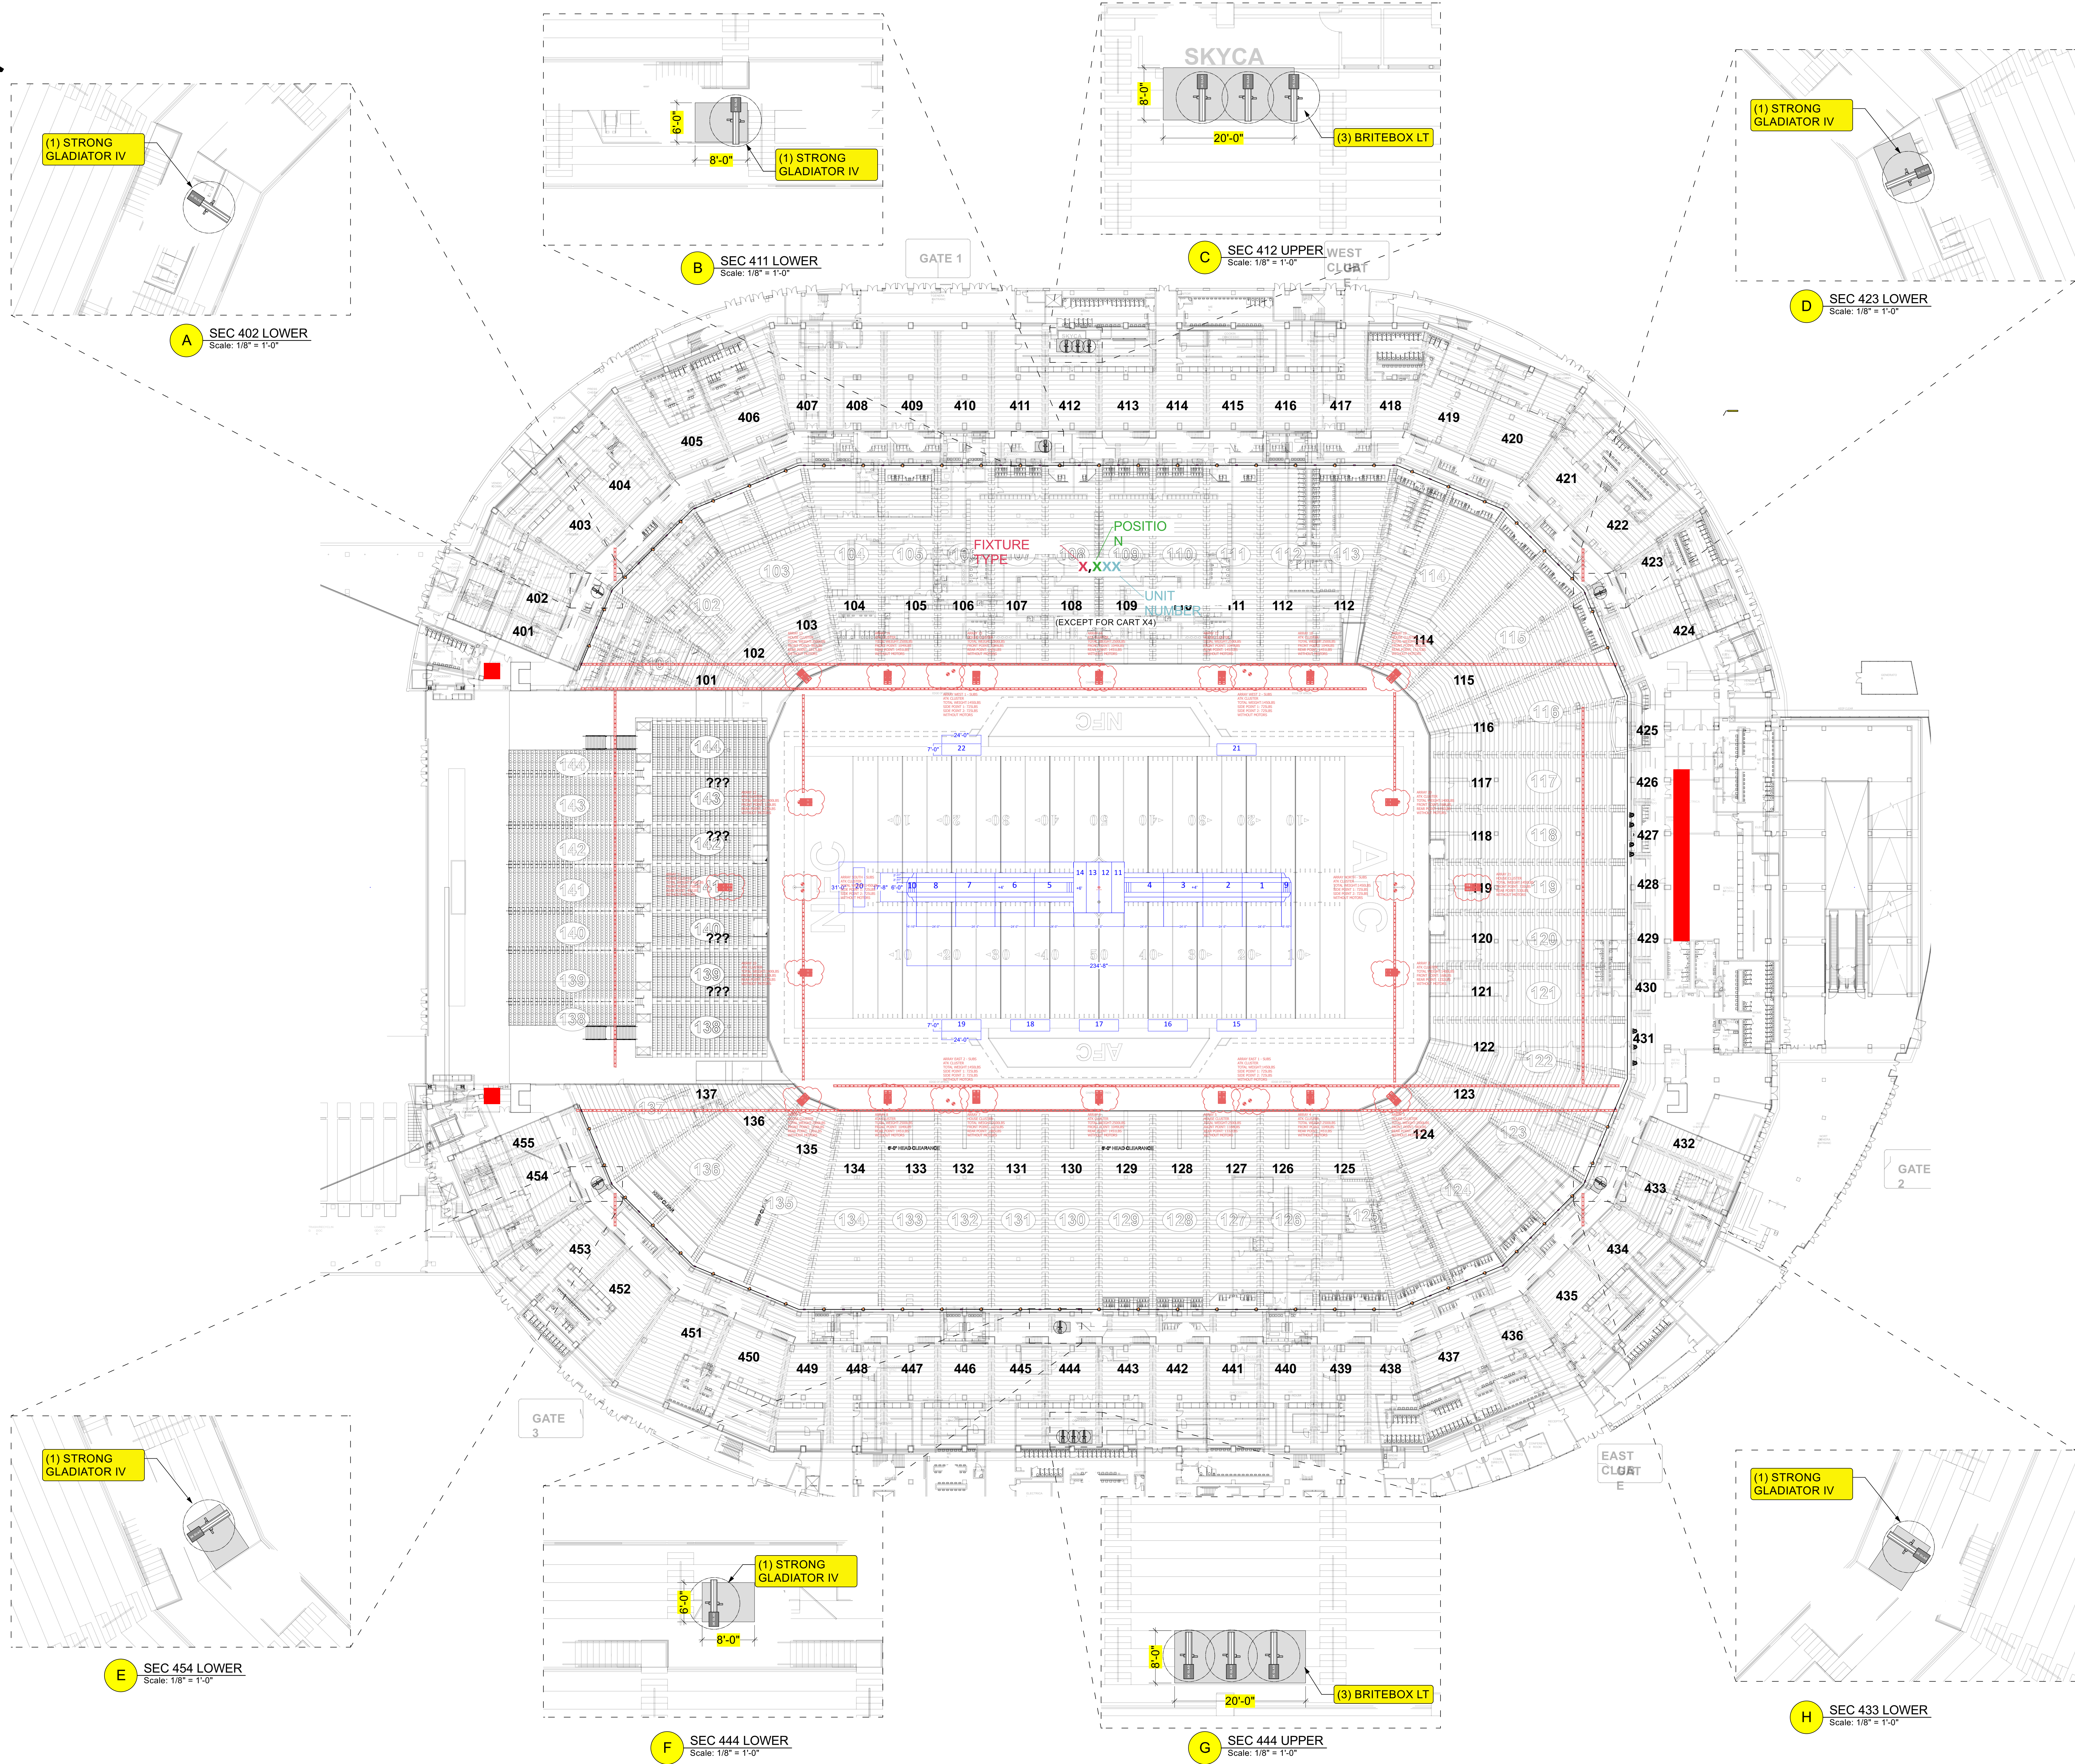


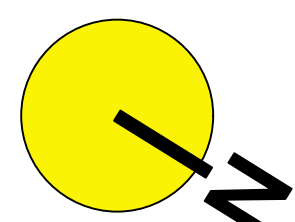

ENTERTAINMENT DESIGN GROUP
Please recycle this paper.

INSTRUMENT KEY

- OLP Impression X4 @ 350w
- Robe Robin 1200 LED Wash @ 880w
- Philips Vari-Lite VL2600 Profile @ 820w
- Varilite VL3600 @ 1.505kw
- PRG GC Longthrow @ 1.5kw
- TMB Solars Flare @ 1kw
- SK GLAD
- Strong Gladiator III @ 3kw

VENUE
STATE FARM STADIUM
GLENDALE, AZ

SHOW
SB 57 HALFTIME SHOW

LOAD-IN 01/23/23 **SHOWDAY** 02/12/23 **SHOW #** #2305

DESIGNER GURDON
LEAD I.D. GREEN / FORSTNER
GAFFER SISKUL
PROG. 1: MARCHWINSKI
PROG. 2: HUMPHREY
LEAD TECH MINNOTTE

VERSION
01 PRELIMINARY
02 2023 CUTS 010823
03 AS BUILT 020823

PRINT ARCH E SHEET
DRAWN BY: BEG
SCALE: 1/2" = 1'-0"

CONTENTS
LX-01: ROOF OVERVIEW
LX-02: BOWL OVERVIEW
LX-03: ESCAPE TRUSS
LX-04: ENDZONE TRUSS
LX-05: CORNER TRUSS
LX-06: RING OF HONOR SW
LX-07: RING OF HONOR NE
LX-08: FIELD LAYOUT
LX-09: SECTIONS

SHEET #
LX-02

PUBLISH DATE
02/09/2023

BOWL OVERVIEW