
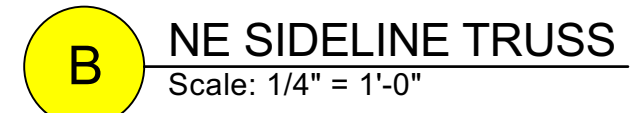


TOTAL FIXTURE WEIGHT:
3300lbs

TRUSS:
330' LINEAR 16" BOX TRUSS BLACK

CABLE CARRY:
150' LINEAR 16" BOX TRUSS BLACK

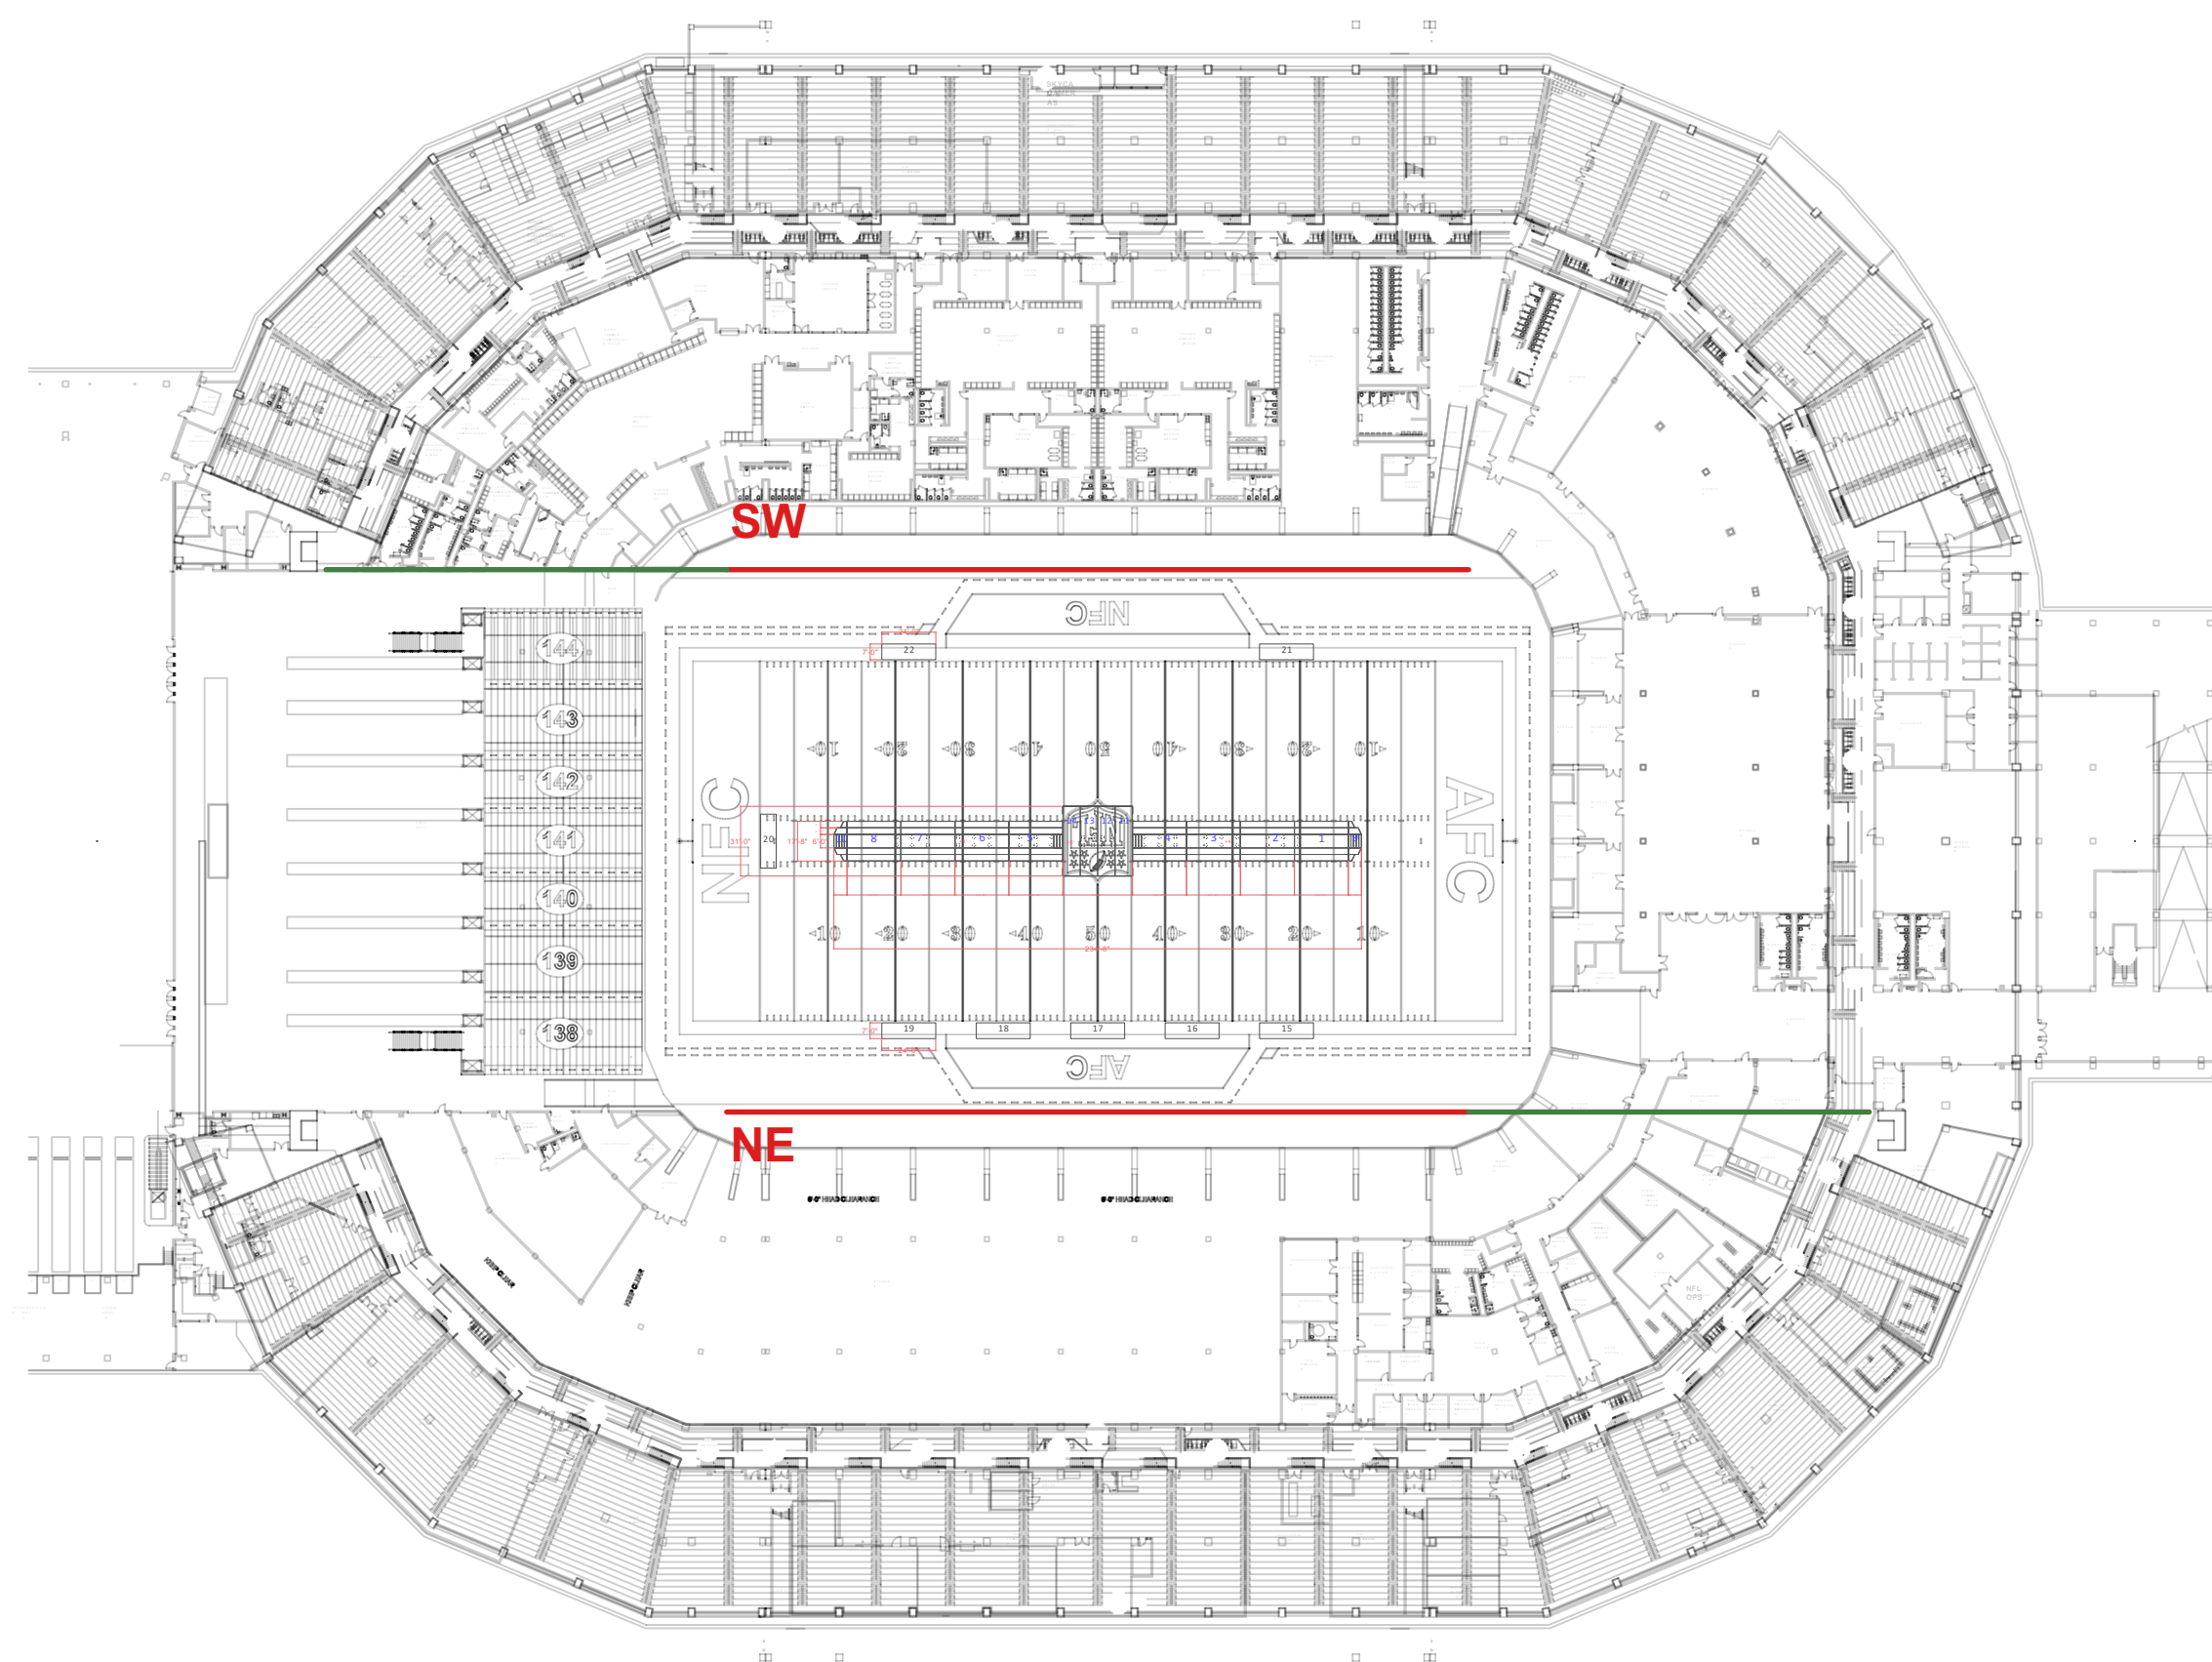

TOTAL FIXTURE WEIGHT:
3300lbs

TRUSS:
330' LINEAR 16" BOX TRUSS BLACK

CABLE CARRY:
150' LINEAR 16" BOX TRUSS BLACK



AD-IN	SHOWDAY	SHOW #
23/23	02/12/23	#2305

DESIGNER	GURDON
LEAD L.D.	GREEN / FORSTER
GAFFER	SISUL
PROG. 1:	MARCHWINSKI
PROG. 2:	HUMPHREY
LEAD TECH	MINNOTTE

01. PRELIMINARY
02. 2023 CUTS 01/08/23
03. AS BUILT 02/09/23

1" 2"

PRINT ARCH E SHEET

N BY: BEG	SCALE: 1/4" = 1'-0"
LX-01: ROOF OVERVIEW LX-02: BOWL OVERVIEW LX-03: SIDELINE TRUSS LX-04: ENDZONE TRUSS LX-05: CORNER TRUSS LX-06: RING OF HONOR SW LX-07: RING OF HONOR NE LX-08: FIELD LAYOUT LX-09: SECTIONS	

SHEET #
LX-03

ISSUE DATE:
02/09/2023

SIDELINE TRUSS