

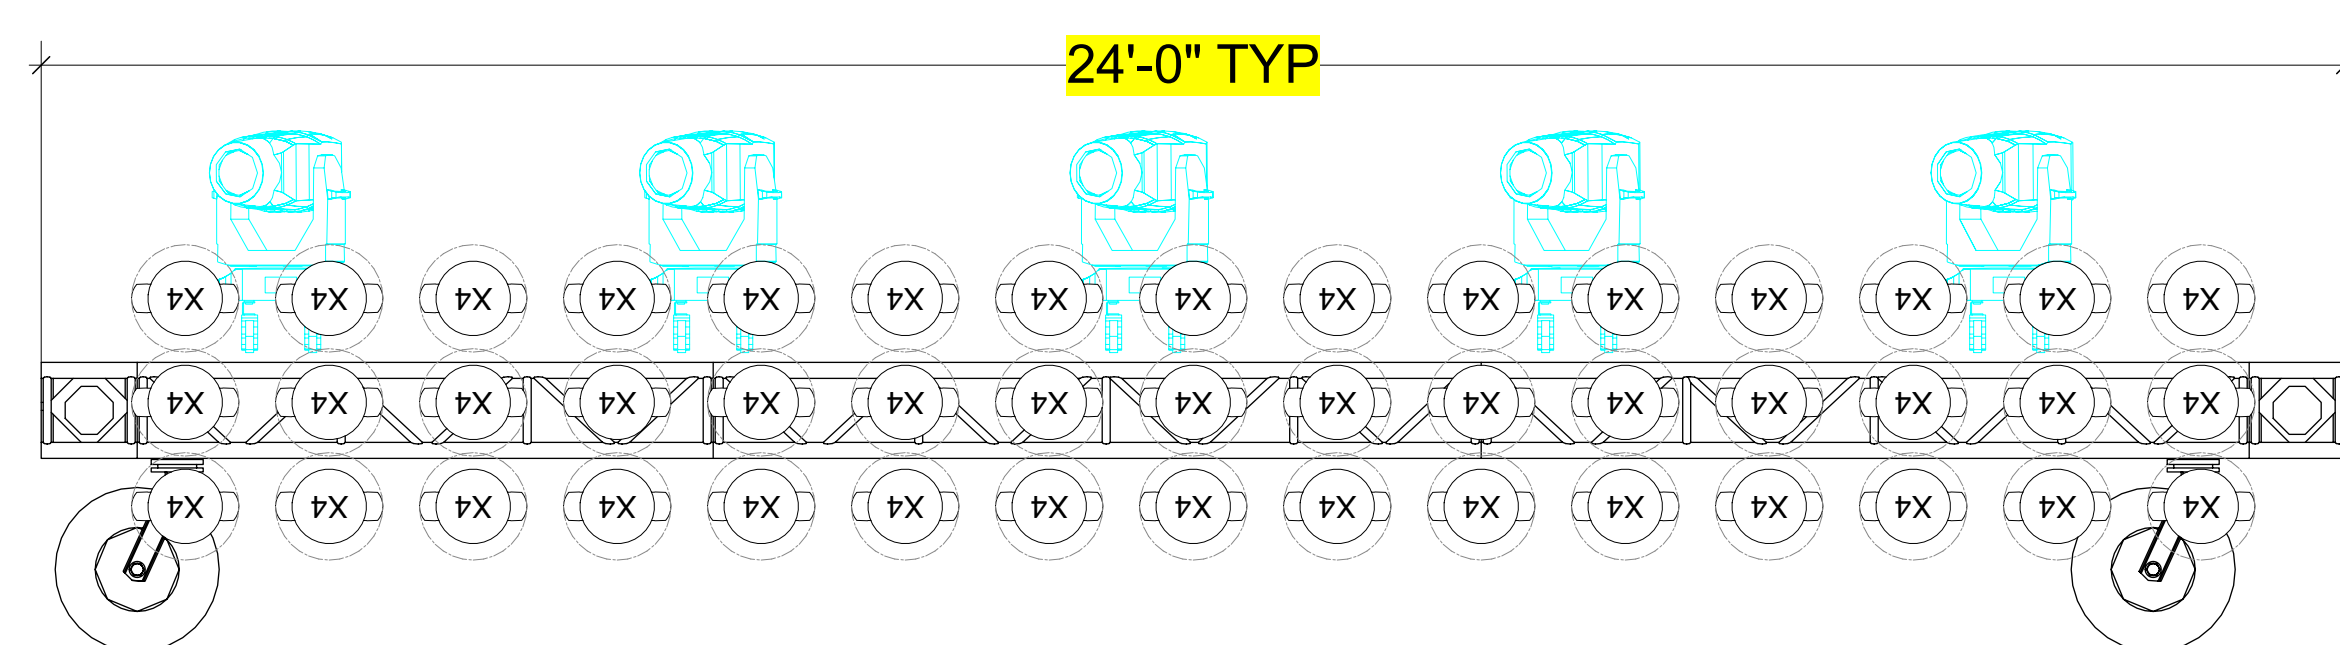
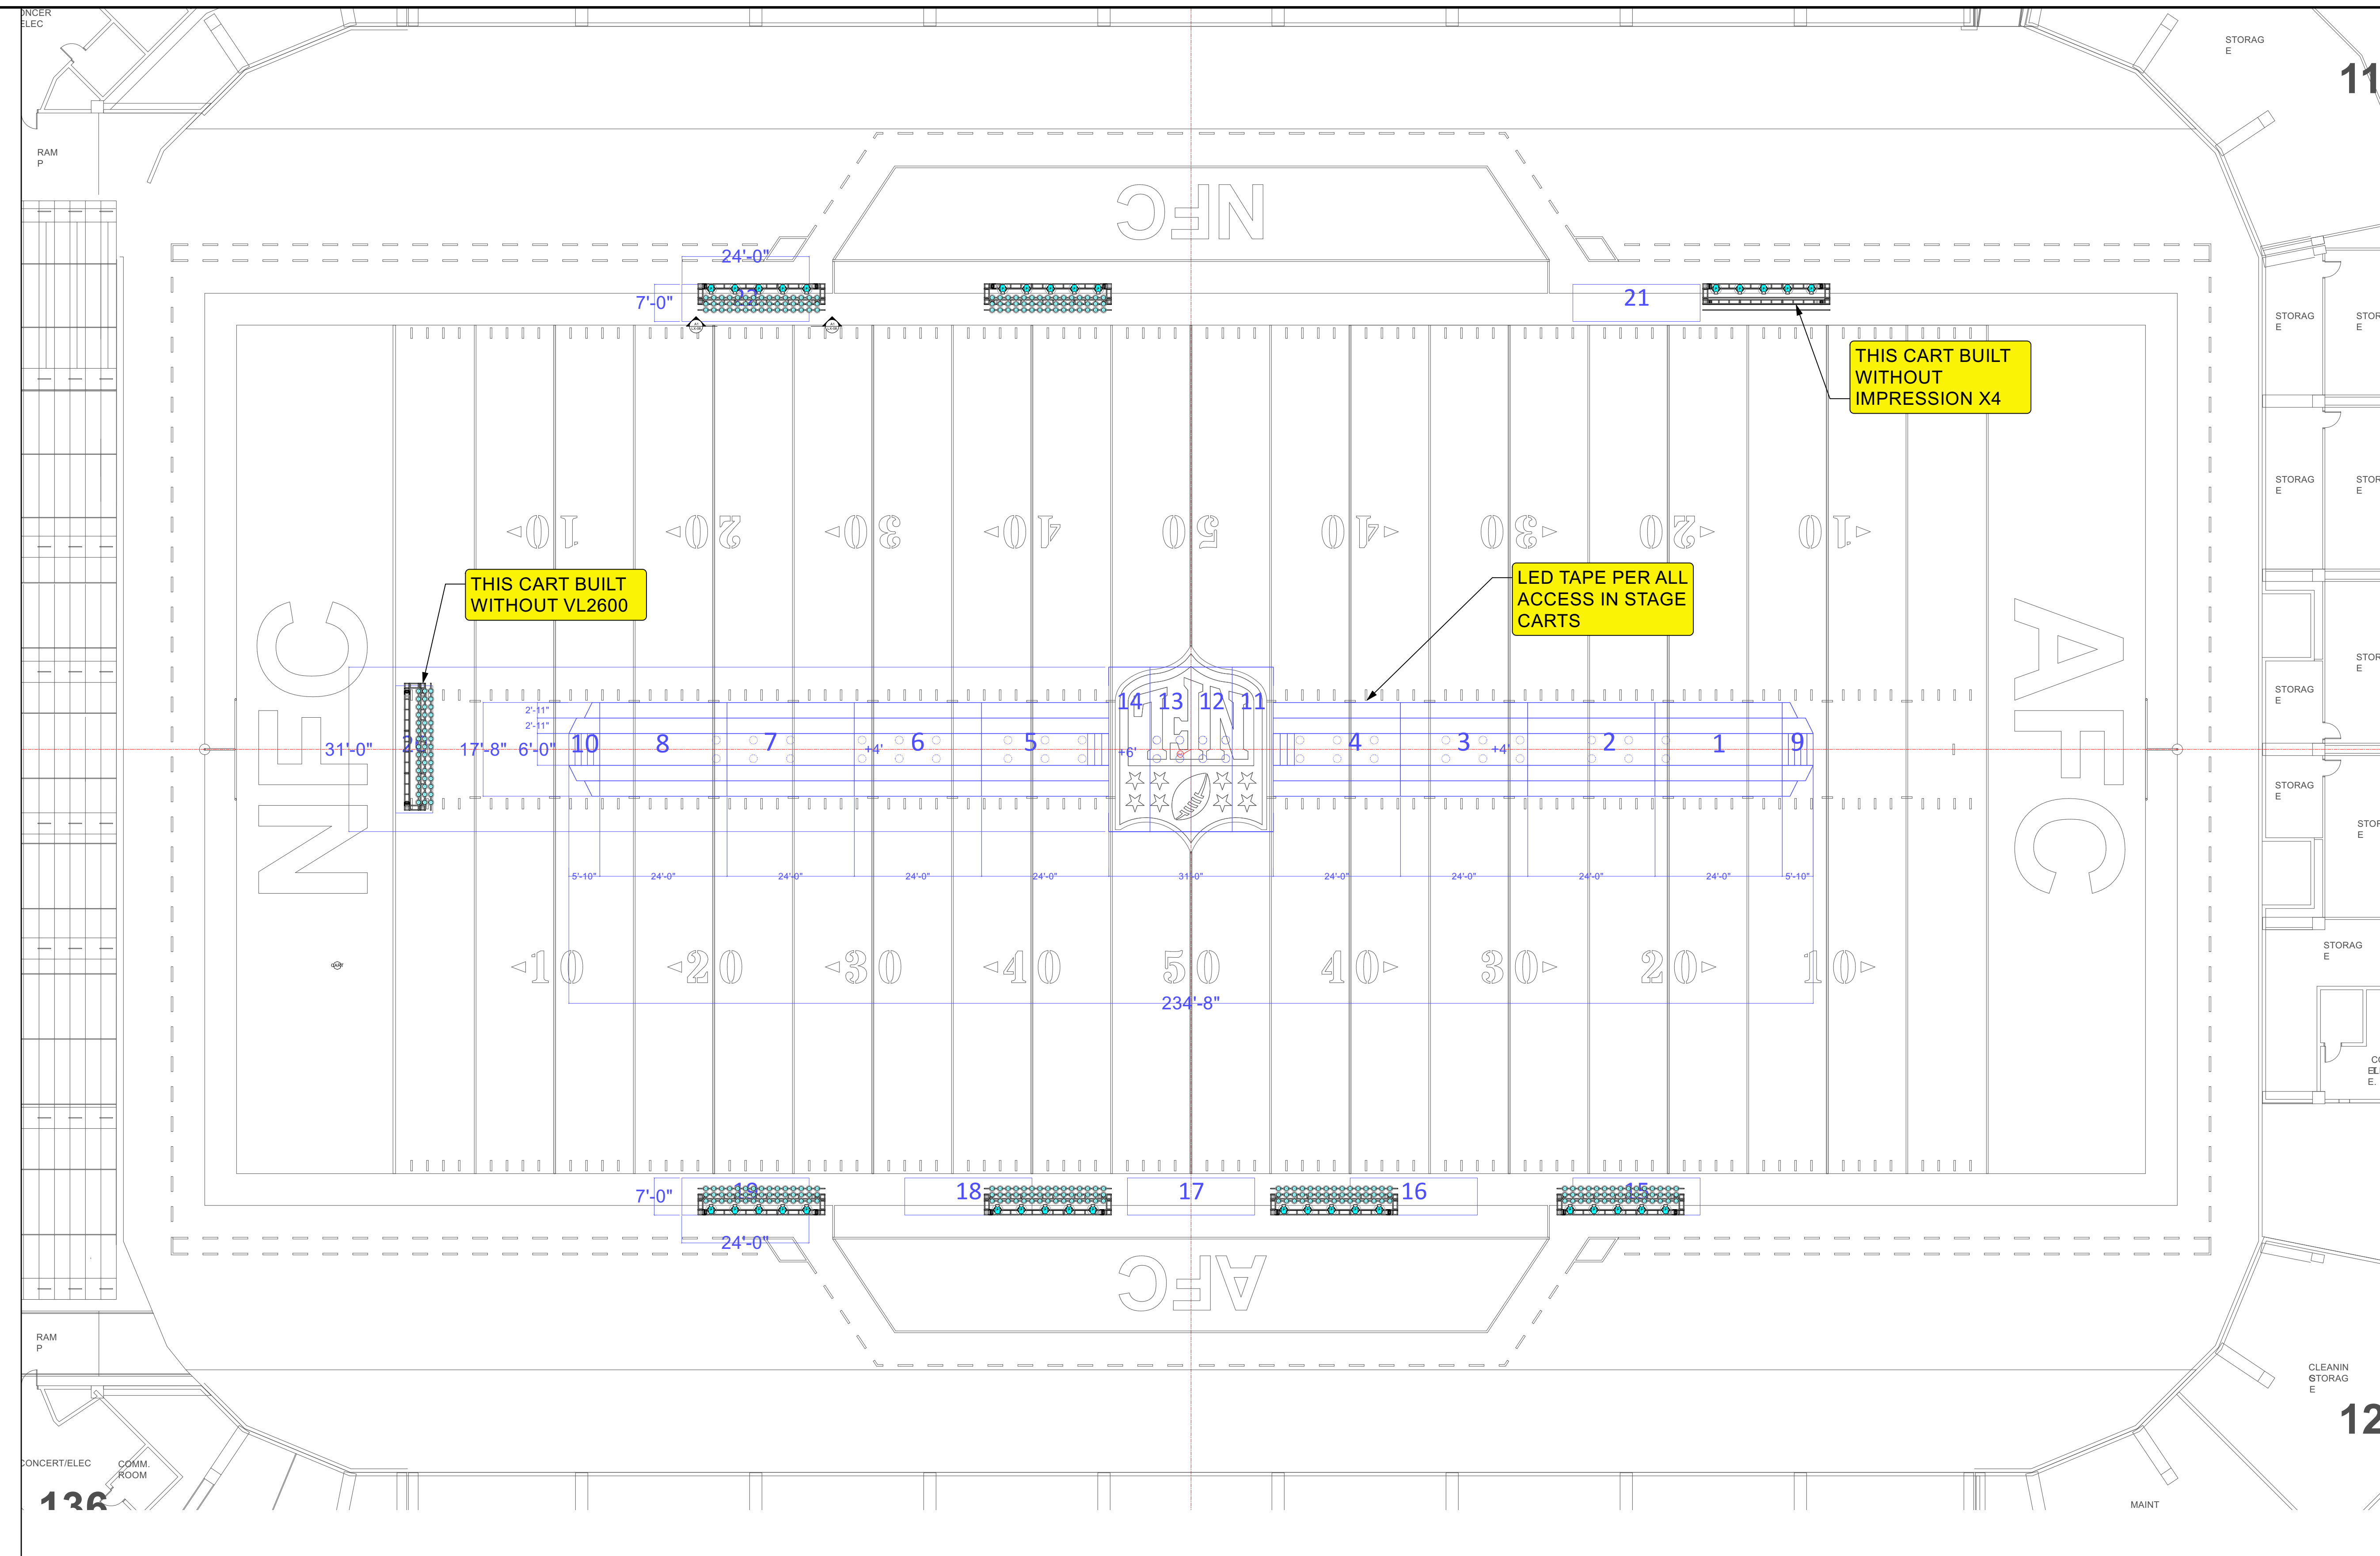


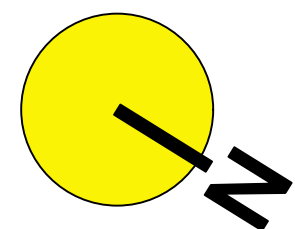


A1 SIDELINE CART ELEVATION
Scale: 1/2" = 1'-0"

FIXTURE COUNT:
(45) IMPRESSION X4 @ 17 LBS
(5) VARILITE VL2600 PROFILE @ 71 LBS
(1) REEL EFX DF-50 @ 35 LBS
(1) REEL EFX FAN @ 49 LBS

CART TOTAL FIXTURE WEIGHT:
1204 lbs

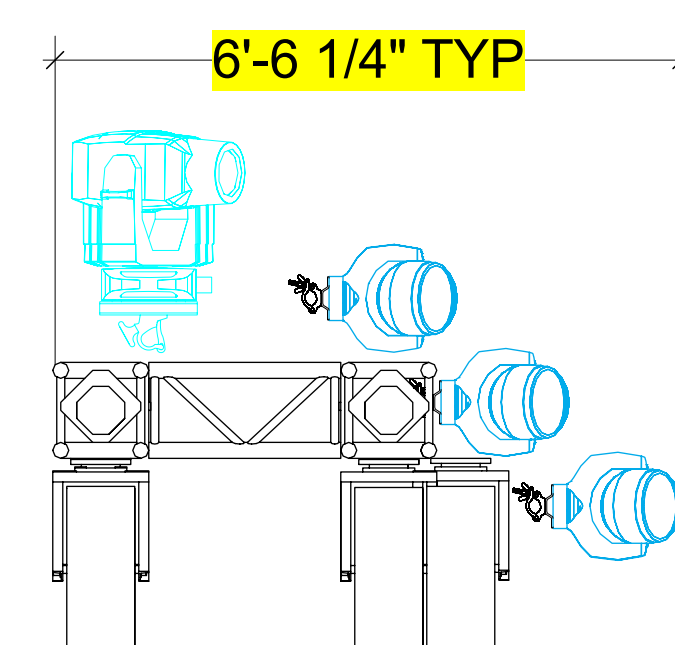

A3 SIDELINE CART SECTION
Scale: 1/2" = 1'-0"

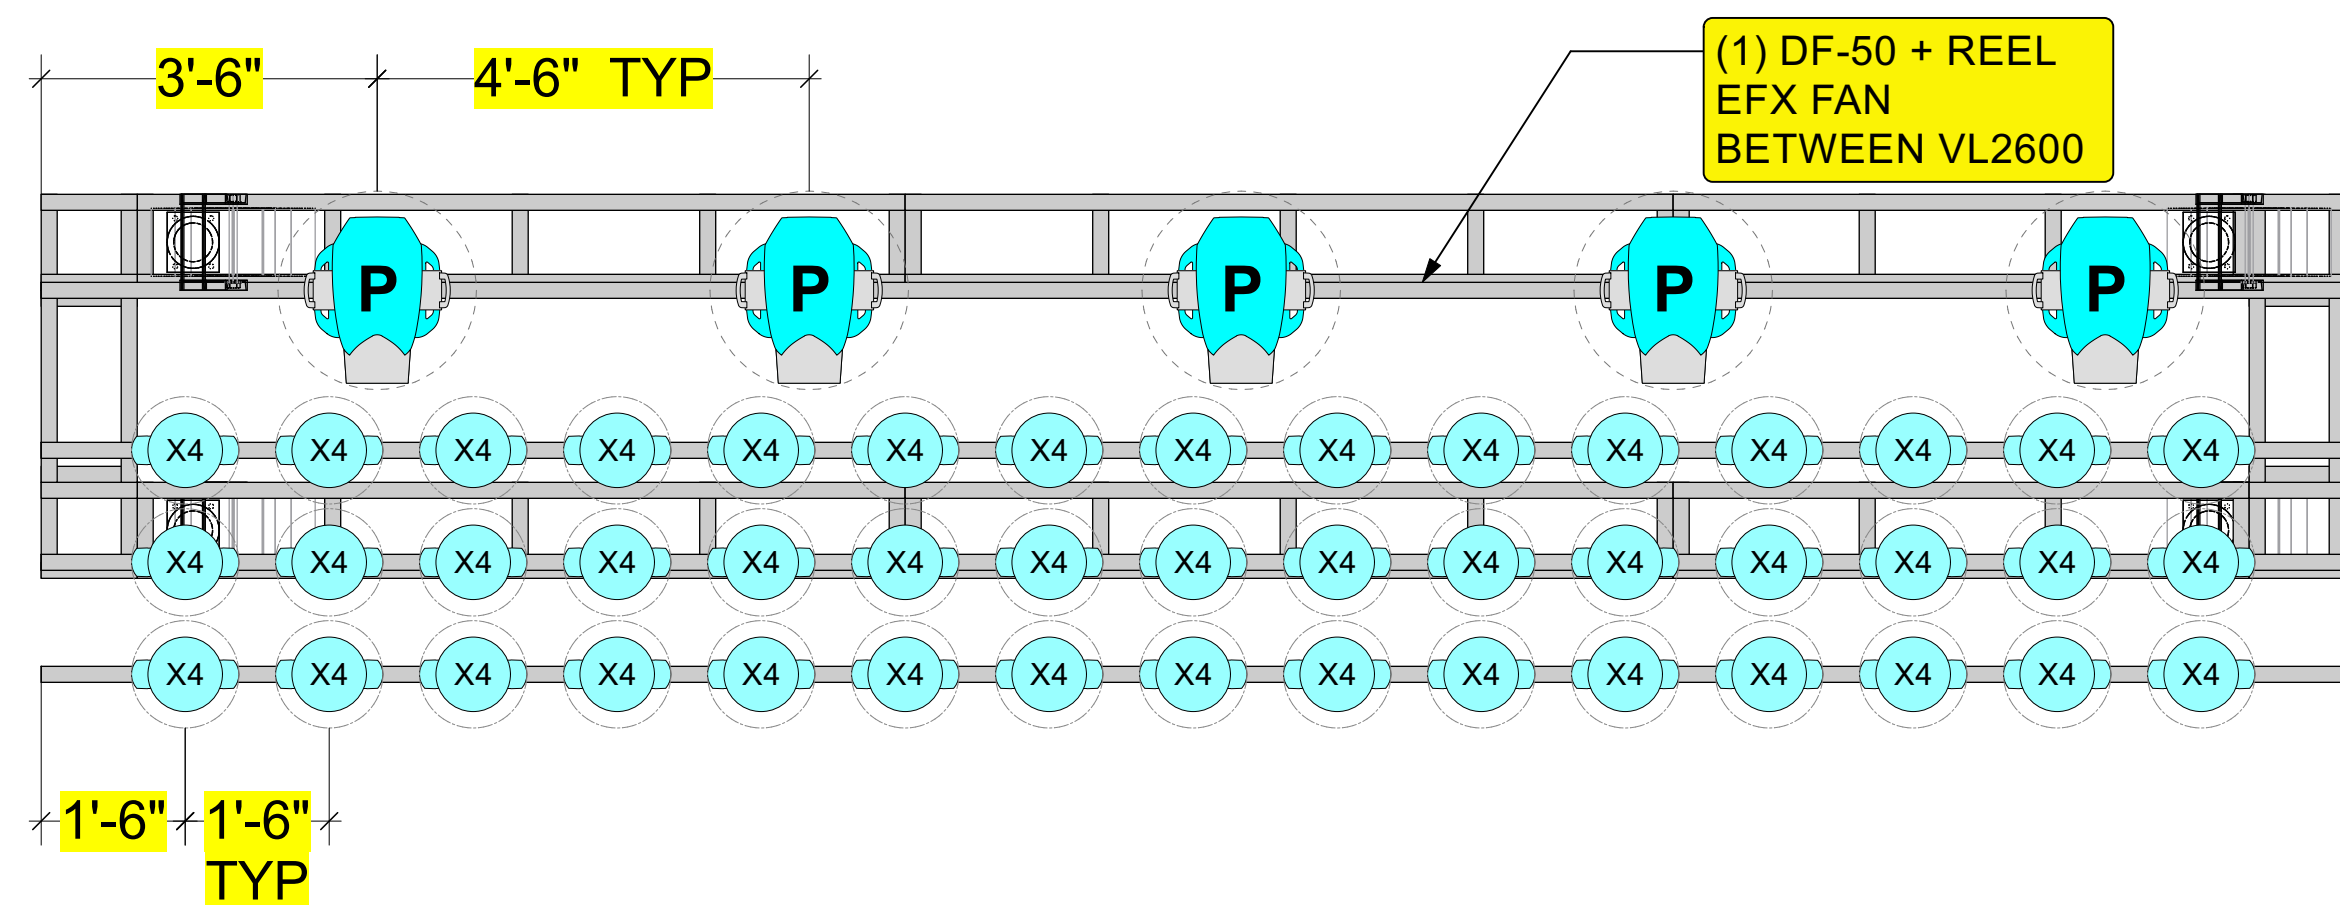

A2 SIDELINE CART PLAN VIEW
Scale: 1/2" = 1'-0"

ENTERTAINMENT DESIGN GROUP
Please recycle this paper.

This document and the sheet and design information herein are an integral part of the contract. No part of this document shall be reproduced or transmitted in any form or by any means, electronic or mechanical, including photocopying, recording, or by any information storage and retrieval system, without the prior written consent of the Designer. The Designer warrants that the information herein is true and correct as of the date of the design. The Designer shall not be responsible for any errors or omissions in this document or for any consequences arising therefrom. The Designer shall not be responsible for any damages, including consequential damages, arising out of or from the use of this document.

INSTRUMENT KEY		
	Impression X4 @ 350w	
	Robe Robin 1200 LED Wash @ 880w	
	Philips Vari-Lite VL2600 Profile @ 820w	
	Varilite VL3600 @ 1.505kw	
	PRG GC Longthrow @ 1.5kw	
	TMB Solaris Flare @ 1kw	
	Strong Gladiator III @ 3kw	

VENUE	
STATE FARM STADIUM GLENDALE, AZ	

SHOW	
SB 57 HALFTIME SHOW	
LOAD-IN	SHOWDAY
01/23/23	02/12/23
#2305	

DESIGNER	
GURDON	
LEAD I.D.	GREEN / FORSTER
GAFFER	SISUL
PROG. 1:	MARCHWINSKI
PROG. 2:	HUMPHREY
LEAD TECH	MINNOTTE

VERSION	
01 PRELIMINARY	
02 2023 CUTS	01/08/23
03 AS BUILT	02/08/23

PRINT ARCH E SHEET

DRAWN BY: BEG

SCALE: 1/4" = 1'-0"

CONTENTS

LX-01: ROOF OVERVIEW
LX-02: BOWL OVERVIEW
LX-03: ENDZONE TRUSS
LX-04: CORNER TRUSS
LX-05: RING OF HONOR SW
LX-06: RING OF HONOR NE
LX-07: FIELD LAYOUT
LX-08: SECTIONS

SHEET #

LX-08

PUBLISH DATE:

02/09/2023

FIELD LAYOUT