

COMPREHENSIVE PERMIT APPLICATION REVISED DRAWING LIST A000.Br3 COVER SHEET

299 BROADWAY

P&Z #22-092

COMPREHENSIVE PERMIT APPLICATION BUILDING B - REVISION 3

APRIL 16, 2025

DRAFT

A000.B2r3	DESIGN NARRATIVE		
A000.B3r2	DIMENSIONAL TABLE		
A000.B3r3	DIMENSIONAL TABLE		
A000.B4r2	GROSS FLOOR AREA PLANS		
A000.B4r3	GROSS FLOOR AREA PLANS		
A000.B5r2	FACADE ANALYSIS		
A000.B5r3	FACADE ANALYSIS		
A001.B1r2	BUILDING B - LEVEL 1		
A001.B1r3	BUILDING B - LEVEL 1		
A003.B1r2	BUILDING B - ELEVATIONS		
A003.B1r3	BUILDING B - ELEVATIONS		
A003.B2r2	BUILDING B - ELEVATIONS	A004.B1	SIGNAGE PLANS
A003.B2r3	BUILDING B - ELEVATIONS	A004.B1r1	SIGNAGE PLANS
A003.B3r2	BUILDING B - ELEVATIONS	A004.B2	SIGNAGE PLANS
A003.B3r3	BUILDING B - ELEVATIONS	A004.B2r1	SIGNAGE PLANS
A003.B5r2	BUILDING B - ELEVATIONS	A004.B3	SIGNAGE PLANS
A003.B5r3	BUILDING B - ELEVATIONS	A004.B3r1	SIGNAGE PLANS
A003.B6r2	BUILDING B - ELEVATIONS	A004.B4	SIGNAGE PLANS
A003.B6r3	BUILDING B - ELEVATIONS	A004.B4r1	SIGNAGE PLANS
A003.B7r2	BUILDING B - ELEVATIONS	A004.B5	SIGNAGE PLANS
A003.B7r3	BUILDING B - ELEVATIONS		

SHEET**	COMMENT
A000.B3r3	Highlighted figures show revised fenestration of proposed elevations.
A000.B4r3	Clouded areas indicate changes in floorplan. Highlighted figures show revised calculations for proposed fenestration.
A000.B5r3	Clouded areas indicate changes to fenestartion dimensions and locations. Highlighted figures show revised calculations for proposed fenestration.
A001.B1r3	Clouded areas indicate changes to the floorplan.
A003.B1r3	Clouded areas indicate change in fenestration dimensions, alignment, and added vents.
A003.B2r3	Clouded areas indicate change in fenestration dimensions, alignment, and added vents.
A003.B3r3	Clouded areas indicate change in fenestration dimensions, alignment, and added vents.
A003.B4	NOT USED.
A003.B5r3	Clouded areas indicate added door and vents.
A003.B6r3	Clouded areas indicate change in fenestration dimensions, alignment, and added vents.
A003.B7r3	Clouded areas indicate change in fenestration dimensions, alignment, and added vents.
A004.B1r1	Revised signage locations due to elevation changes.
A004.B2r1	Revised signage locations due to elevation changes.
A004.B3r1	Revised signage locations due to elevation changes.
A004.B4r1	Revised signage locations due to elevation changes.
A004.B5	New sheet showing address signage at secondary entrance.
L.001.B2	Clouded areas indicate updates to Site Plan & Landscape
L.001.B4	Added proposed streetscape elements to the set, including street trees, planting areas, Bluebikes station, and bike racks Revised planter layout, planting design and paving layout at the new fitness room entry along the Mews, including removal of café seating near fitness room; removed one bench to accommodate a plaza tree (see plaza notes). Updated courtyard design, including layout, furniture and planting to accommodate current elevations and building entries; reduced tree count in accordance with green score to improve visibility and light. Green Score: limited paving to central Mews pathway; updated planting categories based on the 100% CD planting plan and revised courtyard design

^{*} Note that minor changes may have been made to overall fenestration size or location but have not been clouded because the original design intent is still being met. Additionally, unit mix has been reconfigured to better stack demising walls. These changes have been made to improve overall structural efficiency.

^{**} Note that sheets that are not listed or included in this set have not been modified from previously approved comprehensive permit packages.

LOT 2 ZONING AND DEVELOPMENT SUMMARY

ZONING DISTRICT

MR4/MR6

TRANSIT AREA PEDESTRIAN STREET PRINCIPAL BUILDING TYPE YES - INSIDE HALF MILE WALKSHED

YES - BROADWAY GENERAL BUILDING

LOT AREA (SQFT)

WHOLE LOT MR4 MR6 44,795 58,554 13,759

GROSS FLOOR AREA (SQFT) RETAIL/COMMERCIAL RESIDENTIAL MECHANICAL

153,240 6.641 6,641 0 160,810 40,418 120,392 26,348 26,207 141

NOTE:

844 SQFT (5% OF SITE WIDE COMMERCIAL AREA) RESERVED FOR ARTS & CREATIVE ENTERPRISE IS PROVIDED IN LOT 1. PLEASE SEE A000.A3 AND A001.A1 FOR MORE INFORMATION.

PARKING

	BIKES				
	SHOR ⁻	T TERM		LONG TERM	
	REQUIRED	AS OF	RIGHT	REQUIRED	AS OF RIGHT
HOUSEHOLD LIVING	0.1/DU			1.0/DU	
	20 <mark>.4</mark>			20 <mark>4.0</mark>	
COMMERCIAL/RETAIL	1/2,500 SF			1/10,000 SF	
	1.34			0.33	
FOOD & BEVERAGE	1/1,000 SF			1/5,000 SF	
	5.1			1.0	
ARTS & CREATIVE	1/10,00 SF			1/3,000 SF	
	0			0	
COMMUNITY CENTER	1/10,00 SF			4/10,000 SF	
	0			0	
TOTAL REQUIRED	27			205	
TOTAL PROPOSED	27	YE	S	205	YES
	LONG TERM SPO	T - CATE	GORIES)	
	TOTAL ALLO	WED	TOT	AL PROPOSED	AS OF RIGHT
2FT X 6FT (MAX)	132			132	YES
3FT X 8FT (MIN)	21			21	YES
RACKS (2 BIKES) (MAX)	26 RACKS (52	BIKES)	26 RA	CKS (52 BIKES)	YES

NOTES

- 1. PLEASE REFER TO ATTACHED REQUESTED WAIVERS MASTER LIST
- 2. LOT 2/BUILDING-B SPANS BETWEEN THE MR4 AND MR6 DISTRICTS OF THE CITY OF SOMERVILLE OFFICIAL ZONING MAP AND CITY OF SOMERVILLE 2019 ZONING ORDINANCE AND 2021 AMENDMENTS. NOT ALL REGULATED STANDARDS OF THE SZO DIMENSIONAL TABLES OCCUR IN EACH ZONE IN WHICH THE PROJECT OCCURS. N/A DENOTES THAT THE PARTICULAR STANDARD DOES NOT OCCUR IN THAT PARTICULAR ZONE.
- 3. DURING UDC DESIGN REVIEW IT WAS REQUESTED THAT THE DESIGN TEAM RELOCATE SOME OF THE REQUIRED STEPBACKS ALONG BROADWAY UP TO THE 6TH FLOOR FROM THE 5TH FLOOR. PLEASE REFER TO PLANS AND ELEVATIONS FOR SPECIFIC LOCATIONS. PLEASE REFER TO ATTACHED REQUESTED WAIVERS MASTER LIST FOR ASSOCAITED WAIVER.
- 4. THE BROADAY FACADE AND CIVIC PLAZA FACE OF LOT 2/BUILDING B FACE THE SAME FRONT LOT LINE ALONG BROADWAY. IF COUNTED TOGETHER THE FACADE BUILD OUT FOR THIS LOT LINE IS GREATER THAN 80%. PLEASE NOTE THAT THE STEPBACK AT THE CIVIC PLAZA FACADE IS GREATER THAN 15FT AND IS LISTED ON THE ATTACHED REQUESTED WAIVERS MASTER LIST.
 5. REQUIRED OUTDOOR AMENITY SPACE FOR THE ENTIRE LOT IS PROVIDED BY THE BUILDING COURTYARD WHICH OCCURS SOLELY WITHIN THE MR6 DISTRICT.
- - 5A. LOT2/BUILDING B CONTAINS 173 DWELLING UNITS. OUTDOOR AMENITY SPACE IS MEASURED AT 24 SQUARE FEET PER A DWELLING UNIT.
 - 5B. 173 DWELLING UNITS X 24 SQFT/DU = 4,152 SQFT MINIMUM
 - 5C. ACTUAL OUTDOOR AMENITY SPACE PROVIDED = 5,580 SQFT.
 - 5,580 SQFT > 4,152 SQFT.

	ALLOWED MD4	DDODOGED MD/	AS OF DICUT	ALLOWED MR6	DDODOSED MD6	AS OF BIOLIT
	ALLOWED MR4	PROPOSED MR4	AS OF RIGHT	ALLOWED WK6	PROPOSED MR6	AS OF RIGHT
LOT DIMENSIONS & DEVELOPMENT						
LOT WIDTH (MIN)						
BROADWAY	30FT	N/A ²	N/A ²	30FT	261FT	YES
GRANT	30FT	N/A ²	N/A ²	30FT	18FT 7 INCHES	NO ¹
LOT COVERAGE (MAX)	90%	48%	YES	62%	71%	YES
GREEN SCORE						
MIN/IDEAL	.25/.30	.351	YES	.20/.25	.351	YES
OPEN SPACE (MIN)	15%	52%	YES	15%	38%	YES
,						
BUILDING SETBACKS						
PRIMARY FRONT SETBACK (MIN/MAX)						
PRIMARY FRONT (BROADWAY)	2FT 15FT	N/A ²	N/A ²	2FT 15FT	2FT 3FT 8 IN	YES
PRIMARY FRONT (GRANT)	2FT 15FT	N/A ²	N/A ²	2FT 15FT	99 FT 5 1/2 INCHES	NO ¹
SECONDARY FRONT SETBACK (MIN/MAX)	2FT 15FT	21FT 10 INCHES ¹	NO ¹	2FT 15FT	N/A ²	N/A ²
	2 13 13	ZIFT TO INCHES	NO ¹	2 10 10	IN/A ²	IN/A ²
SIDE SETBACK (MIN)	OFT.	AAET CINIOUEO	VEO	OFT.	4057	VEO
ABUTTING ANY NON-NR/LHD	0FT	14FT 6INCHES	YES	0FT	10FT	YES
1ST-3RD STORY ABUTTING NR/LHD	10FT	10FT	YES	10FT	10FT	YES
4TH-6TH STORY ABUTTING NR/LHD	30FT	10FT	NO	30FT	30FT	YES
REAR SETBACK (MIN)						
ABUTTING ANY NON-NR/LHD	10FT	N/A ²	N/A ²	10FT	N/A ²	N/A ²
1ST-3RD STORY ABUTTING NR/LHD	20FT	20FT 6 INCHES	YES	20FT	N/A ²	N/A ²
4TH-6TH STORY ABUTTING NR/LHD	30FT	30FT	YES	30FT	N/A ²	N/A ²
MAIN MA 001110						
MAIN MASSING					1	
BUILDING WIDTH (MAX)						
BROADWAY FACADE	200FT	N/A ²	N/A ²	200FT	177 FT 5 INCHES	YES
CIVIC PLAZA FACADE	200FT	N/A ²	N/A ²	200FT	66 FT 0 INCHES	YES
GRANT FACADE	200FT	N/A ²	N/A ²	200FT	20 FT 0 INCHES	YES
FACADE BUILD OUT (MIN)						
PRIMARY FRONT (BROADWAY +	80%	N/A ²	N/A ²	80%	93%4	YES ⁴
CIVIC PLAZA)4						
PRIMARY FRONT (GRANT)	80%	N/A ²	N/A ²	80%	100%	YES
SECONDARY FRONT	65%	27% ¹	NO ¹	65%	N/A ²	N/A ²
OLOONDAKT TROIT	00 /0	21 /0	110	0370	IN//A	IN//A
FLOOR PLATE (MAX)	15,000 SQFT	6,845 SQFT	YES	30,000 SQFT	27,368 SQFT	YES
FLOOR FLATE (IVIAA)	13,000 SQF1	0,040 SQF1	IEO	30,000 SQF1	21,300 SQF1	IES
ODOLIND OTODY LIEIGUT (MINI)	AAFT	40 FT 0 INOUE0	VEO	4057	42ET O INOLIEO	NO1
GROUND STORY HEIGHT (MIN)	14FT	16 FT 9 INCHES	YES	18FT	13FT 0 INCHES	NO ¹
UPPER STORY HEIGHT (MIN)	10FT	10 FT 8 INCHES	YES	10FT	10FT 8 INCHES	YES
NUMBER OF STORIES (MIN/MAX)	3 4	6	YES	3 6	6	YES
STEP BACK, 5TH-6TH STORY (MIN)	N/A ²	8 FT 0 INCHES	NO	10FT	81,3	NO ¹
BUILDING HEIGHT, FEET (MAX)	52FT	60 FT 8 INCHES	NO	80FT	67FT 9 INCHES	YES
ROOF TYPE	FLAT	FLAT	YES	FLAT	FLAT	YES
FACADE COMPOSITION						
GROUND STORY FENESTRATION						
PRIMARY FACADE (BROADWAY)	70%	N/A ²	N/A ²	70%	51%	YES
PRIMARY FACADE (PLAZA)	70%	N/A ²	N/A ²	70%	35%	NO
PRIMARY FACADE (GRANT)	70%	N/A ²	N/A ²	70%	48%	NO
SECONDARY FACADE (MIN/MAX)	15% 70%	32.9	YES	15% 70%	N/A ²	N/A ²
UPPER STORY FENESTRATION	15% 70%	24%	YES	15% 70%	27%	YES
	20FT	Z4 /0	YES	20FT	Z1 /0	YES
BLANK WALL (MAX)	ZUFI		159	ZUFI		150
USE & OCCUPANCY						
GROUND STORY ENTRY SPACING (MAX)	30FT	SEE ELEVATIONS ¹	SEE ELEVATIONS ¹	30FT	SEE ELEVATIONS ¹	SEE EI EVATION
COMMERCIAL SPACE DEPTH (MIN)	30FT	N/A ²	YES	30FT	30FT 2 INCHES	YES
DENOITY EACTOR (AMI)	055 05000 5: :::	055 05000 5: 11/5	\/E0	055 05000 5: 1:::	055 05000 5: 11:5	\/=0
DENSITY FACTOR (MIN)	SEE GROSS PLANS	SEE GROSS PLANS	YES	SEE GROSS PLANS	SEE GROSS PLANS	YES
OUTDOOR AMENITY SPACE (MIN)	1/DU	N/A ^{2,5}	YES ^{2,5}	1/DU	5,580 SQFT ⁵	YES

A000.B3r2 **DIMENSIONAL TABLES** **PREVIOUS**

DISCLAIMER: These plans are conceptual only. They have not been

subject to a comprehensive code and regulatory review, nor have they been tested against any as-built surveys. Discoveries in such an analysis may result in fundamental changes to the original concept. This scheme assumes zoning relief will be required. As with all

zoning relief, the architect cannot guarantee zoning relief will be

LOT 2 ZONING AND DEVELOPMENT SUMMARY

ZONING DISTRICT

MR4/MR6 TRANSIT AREA

PEDESTRIAN STREET PRINCIPAL BUILDING TYPE YES - INSIDE HALF MILE WALKSHED

YES - BROADWAY GENERAL BUILDING

LOT AREA (SQFT)

WHOLE LOT 58,554 13,759 GROSS FLOOR AREA (SQFT) 193,799 40,559 RETAIL/COMMERCIAL 6,641 0 RESIDENTIAL 160,810 40,418 MECHANICAL 24,414 141

NOTE:

844 SQFT (5% OF SITE WIDE COMMERCIAL AREA) RESERVED FOR ARTS & CREATIVE ENTERPRISE IS PROVIDED IN LOT 1. PLEASE SEE A000.A3

MR6

44,795

153,240

120,392

24,414

6,641

AND A001.A1 FOR MORE INFORMATION.

PARKING

	BIKES					
	SHORT	T TERM		LONG TERM		
	REQUIRED	AS OF	RIGHT	REQUIRED	AS OF RIGHT	
HOUSEHOLD LIVING	0.1/DU			1.0/DU		
	20.4			204.0		
COMMERCIAL/RETAIL	1/2,500 SF			1/10,000 SF		
	1.34			0.33		
FOOD & BEVERAGE	1/1,000 SF			1/5,000 SF		
	5.1			1.0		
ARTS & CREATIVE	1/10,00 SF			1/3,000 SF		
	0			0		
COMMUNITY CENTER	1/10,00 SF			4/10,000 SF		
	0			0		
TOTAL REQUIRED	27			205		
TOTAL PROPOSED	27	YE	S	205	YES	
	LONG TERM SPO	OT - CATE	GORIES			
	TOTAL ALLO	WED	TOT	AL PROPOSED	AS OF RIGHT	
2FT X 6FT (MAX)	132			132	YES	
3FT X 8FT (MIN)	21			21	YES	
RACKS (2 BIKES) (MAX)	26 RACKS (52	BIKES)	26 RA	RACKS (52 BIKES) YES		

NOTES

1. PLEASE REFER TO ATTACHED REQUESTED WAIVERS MASTER LIST

2. LOT 2/BUILDING-B SPANS BETWEEN THE MR4 AND MR6 DISTRICTS OF THE CITY OF SOMERVILLE OFFICIAL ZONING MAP AND CITY OF SOMERVILLE 2019 ZONING ORDINANCE AND 2021 AMENDMENTS. NOT ALL REGULATED STANDARDS OF THE SZO DIMENSIONAL TABLES OCCUR IN EACH ZONE IN WHICH THE PROJECT OCCURS. N/A DENOTES THAT THE PARTICULAR STANDARD DOES NOT OCCUR IN THAT PARTICULAR ZONE.

3. DURING UDC DESIGN REVIEW IT WAS REQUESTED THAT THE DESIGN TEAM RELOCATE SOME OF THE REQUIRED STEPBACKS ALONG BROADWAY UP TO THE 6TH FLOOR FROM THE 5TH FLOOR. PLEASE REFER TO PLANS AND ELEVATIONS FOR SPECIFIC LOCATIONS. PLEASE REFER TO ATTACHED REQUESTED WAIVERS MASTER LIST FOR ASSOCAITED WAIVER

4. THE BROADAY FACADE AND CIVIC PLAZA FACE OF LOT 2/BUILDING B FACE THE SAME FRONT LOT LINE ALONG BROADWAY. IF COUNTED TOGETHER THE FACADE BUILD OUT FOR THIS LOT LINE IS GREATER THAN 80%. PLEASE NOTE THAT THE STEPBACK AT THE CIVIC PLAZA FACADE IS GREATER THAN 15FT AND IS LISTED ON THE ATTACHED REQUESTED WAIVERS MASTER LIST.

5. REQUIRED OUTDOOR AMENITY SPACE FOR THE ENTIRE LOT IS PROVIDED BY THE BUILDING COURTYARD WHICH OCCURS SOLELY WITHIN THE MR6 DISTRICT.

5A. LOT2/BUILDING B CONTAINS 173 DWELLING UNITS. OUTDOOR AMENITY SPACE IS MEASURED AT 24 SQUARE FEET PER A DWELLING UNIT.

5B. 173 DWELLING UNITS X 24 SQFT/DU = 4,152 SQFT MINIMUM

5C. ACTUAL OUTDOOR AMENITY SPACE PROVIDED = 5,580 SQFT.

5,580 SQFT > 4,152 SQFT.

	ALLOWED MR4	PROPOSED MR4	AS OF RIGHT	ALLOWED MR6	PROPOSED MR6	AS OF RIGHT
LOT DIMENSIONS & DEVELOPMENT						
LOT WIDTH (MIN)						
BROADWAY	30FT	N/A ²	N/A ²	30FT	261FT	YES
GRANT	30FT	N/A ²	N/A ²	30FT	18FT 7 INCHES	NO ¹
LOT COVERAGE (MAX)	90%	48%	YES	62%	71%	YES
GREEN SCORE	0070	1070	120	0270	1170	120
MIN/IDEAL	.25/.30	.351	YES	.20/.25	.351	YES
OPEN SPACE (MIN)	15%	52%	YES	15%	38%	YES
or Err or rioz (mirr)	1070	02 70	120	1070	0070	120
BUILDING SETBACKS						
PRIMARY FRONT SETBACK (MIN/MAX)						
PRIMARY FRONT (BROADWAY)	2FT 15FT	N/A ²	N/A ²	2FT 15FT	2FT 3FT 8 IN	YES
PRIMARY FRONT (GRANT)	2FT 15FT	N/A ²	N/A ²	2FT 15FT	99 FT 5 1/2 INCHES	NO ¹
SECONDARY FRONT SETBACK (MIN/MAX)	2FT 15FT	21FT 10 INCHES ¹	NO ¹	2FT 15FT	N/A ²	N/A ²
SIDE SETBACK (MIN)	211 1011	ZII I IO INOTILO	IVO	21 1 101 1	11//1	19/73
ABUTTING ANY NON-NR/LHD	0FT	14FT 6INCHES	YES	0FT	10FT	YES
1ST-3RD STORY ABUTTING NR/LHD		14F1 6INCHES	YES	10FT	10FT	YES
4TH-6TH STORY ABUTTING NR/LHD	30FT	10F1 10FT	NO NO	30FT	30FT	YES
REAR SETBACK (MIN)	JUFI	IUFI	NU	JUT I	JUF I	159
	4000	N/A ²	N1/A2	1057	N1/A2	N1/A2
ABUTTING ANY NON-NR/LHD	10FT	·	N/A ²	10FT	N/A ²	N/A ²
1ST-3RD STORY ABUTTING NR/LHD		20FT 6 INCHES	YES	20FT	N/A ²	N/A ²
4TH-6TH STORY ABUTTING NR/LHD	30FT	30FT	YES	30FT	N/A ²	N/A ²
MAIN MASSING						
BUILDING WIDTH (MAX)						
BROADWAY FACADE	200FT	N/A ²	N/A ²	200FT	177 FT 5 INCHES	YES
CIVIC PLAZA FACADE	200FT	N/A ²	N/A ²	200FT	66 FT 0 INCHES	YES
GRANT FACADE	200FT	N/A ²	N/A ²	200FT	20 FT 0 INCHES	YES
FACADE BUILD OUT (MIN)	2001 1	14/71	14/7 (2001 1	ZOTT O IIVOTILO	120
PRIMARY FRONT (BROADWAY +	80%	N/A ²	N/A ²	80%	93%4	YES ⁴
CIVIC PLAZA)4	0070	IN/A	IN//A	00 70	90 /0	ILO
PRIMARY FRONT (GRANT)	80%	N/A ²	N/A ²	80%	100%	YES
SECONDARY FRONT	65%	27% ¹	NO ¹	65%	N/A ²	N/A ²
SECUNDARY FROM	00%	21%	NO.	00%	IN/A ²	IN/A ²
FLOOR PLATE (MAX)	45 000 COFT	C DAE COET	VEC	20 000 COFT	07 200 COFT	VEC
FLOOR PLATE (MAX)	15,000 SQFT	6,845 SQFT	YES	30,000 SQFT	27,368 SQFT	YES
ODOLIND OTODY LIFLOUT (MINI)	4457	40 FT 0 INOLIFO	V/F0	4057	42FT 0 INIQUE0	NO1
GROUND STORY HEIGHT (MIN)	14FT	16 FT 9 INCHES	YES	18FT	13FT 0 INCHES	NO ¹
UPPER STORY HEIGHT (MIN)	10FT	10 FT 8 INCHES	YES	10FT	10FT 8 INCHES	YES
NUMBER OF STORIES (MIN/MAX)	3 4	6	YES	3 6	6	YES
OTED DAOI/ ETH OTE OTO STATE		0.55.0000000000000000000000000000000000		10==	04.0	1161
STEP BACK, 5TH-6TH STORY (MIN)	N/A ²	8 FT 0 INCHES	NO	10FT	81,3	NO ¹
BUILDING HEIGHT, FEET (MAX)	52FT	60 FT 8 INCHES	NO	80FT	67FT 9 INCHES	YES
ROOF TYPE	FLAT	FLAT	YES	FLAT	FLAT	YES
FACADE COMPOSITION						
FACADE COMPOSITION		1	Т	1		
GROUND STORY FENESTRATION	700/	N1/10	N 1/20		F.(0)	
PRIMARY FACADE (BROADWAY)	70%	N/A ²	N/A ²	70%	51%	YES
PRIMARY FACADE (PLAZA)	70%	N/A ²	N/A ²	70%	33%	NO
PRIMARY FACADE (GRANT)	70%	N/A ²	N/A ²	70%	48%	NO
SECONDARY FACADE (MIN/MAX)	15% 70%	32.9	YES	15% 70%	N/A ²	N/A ²
UPPER STORY FENESTRATION	15% 50%	24%	YES	15% 50%	27%	YES
BLANK WALL (MAX)	20FT		YES	20FT		YES
HOT A COURTNOY		•		•	·	
USE & OCCUPANCY						
GROUND STORY ENTRY SPACING (MAX)	30FT		SEE ELEVATIONS ¹	30FT		SEE ELEVATIO
COMMERCIAL SPACE DEPTH (MIN)	30FT	N/A ²	YES	30FT	30FT 2 INCHES	YES
DENSITY FACTOR (MIN)	SEE GROSS PLANS	SEE GROSS PLANS	YES	SEE GROSS PLANS	S SEE GROSS PLANS	YES
· · ·						
OUTDOOR AMENITY SPACE (MIN)	1/DU	N/A ^{2,5}	YES ^{2,5}	1/DU	5,580 SQFT ⁵	YES

299 BROADWAY - BUILDING B SOMERVILLE, MA, 02145

MARK DEVELOPMENT AND SAMUEL'S & **ASSOCIATES**


A000.B2r3 **DIMENSIONAL TABLES**

DISCLAIMER: These plans are conceptual only. They have not been they been tested against any as-built surveys. Discoveries in such an analysis may result in fundamental changes to the original concept. This scheme assumes zoning relief will be required. As with all

subject to a comprehensive code and regulatory review, nor have


zoning relief, the architect cannot guarantee zoning relief will be

PROPOSED

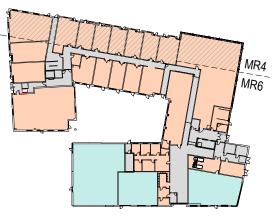


LEVEL 01	MR4	MR6
COMMERCIAL AREA	0 SQF	6641 SQF
RESIDENTIAL AREA	6835 SQF	14154 SQF
MECHANICAL AREA	141 SQF	5125 SQF
PARKING AREA	0 SQF	0 SQF
TOTAL AREA PER ZONE	6976 SQF	26470 SQF
TOTAL AREA COMBINED	3289	6 SQF


LEVEL 1 1" = 100'-0"

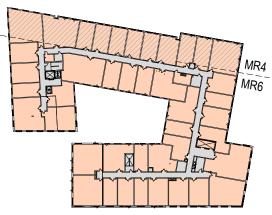

EVEL 03	MR4	MR6
COMMERCIAL AREA	0 SQF	0 SQF
RESIDENTIAL AREA	7302 SQF	23102 SQF
MECHANICAL AREA	0 SQF	4171 SQF
PARKING AREA	0 SQF	0 SQF
TOTAL AREA PER ZONE	7302 SQF	27273 SQF
TOTAL AREA COMBINED	3457	5 SQF

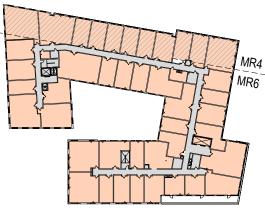

LEVEL 05	MR4	MR6
COMMERCIAL AREA	0 SQF	0 SQF
RESIDENTIAL AREA	7302 SQF	22359 SQF
MECHANICAL AREA	0 SQF	4203 SQF
PARKING AREA	0 SQF	0 SQF
TOTAL AREA PER ZONE	7302 SQF	26562 SQF
TOTAL AREA COMBINED	3386	4 SQF

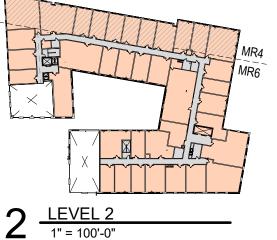

LEVEL 02	MR4	MR6
COMMERCIAL AREA	0 SQF	0 SQF
RESIDENTIAL AREA	7302 SQF	19529 SQF
MECHANICAL AREA	0 SQF	4016 SQF
PARKING AREA	0 SQF	0 SQF
TOTAL AREA PER ZONE	7302 SQF	23545 SQF
TOTAL AREA COMBINED	308	347 SQF


區

LEVEL 04	MR4	MR6
COMMERCIAL AREA	0 SQF	0 SQF
RESIDENTIAL AREA	7302 SQF	23102 SQF
MECHANICAL AREA	0 SQF	4171 SQF
PARKING AREA	0 SQF	0 SQF
TOTAL AREA PER ZONE	7302 SQF	27273 SQF
TOTAL AREA COMBINED	345	575 SQF

NOTES:

- 1. BUILDING A IS LOCATED IN BOTH THE MR4 AND MR6 ZONING DISTRICTS.
- 2. LOT AREA 58,5545 SQFT
- 3. TOTAL GROSS AREA ALL FLOORS = 193,799 SQFT
 - 3A. TOTAL GROSS AREA ALL FLOORS IN MR4 = 40,559 SQFT
 - 3B. TOTAL GROSS AREA ALL FLOORS IN MR6 = 153,240 SQFT
- 4. DENSITY FACTOR:
 - 4A. IN MR4 FOR LOTS OVER 5,500 SQFT THE DENSITY FACTOR IS **1,125**.
 - 40,559 (SQFT IN MR4) / 1,125 = **36 PERMITTED UNITS**
 - 4B. IN MR6 FOR LOTS OVER 6,500 SQFT THE DENSITY FACTOR IS 850.
 - 153,240 (SQFT IN MR6) / 850 = **180 PERMITTED UNITS**
 - 4C. ACTUAL UNITS PROVIDED = 204

204 UNITS < 216 UNITS (36 MR4 UNITS + 180 MR6 UNITS)

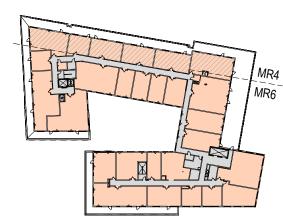

LEVEL 06	MR4	MR6
COMMERCIAL AREA	0 SQF	0 SQF
RESIDENTIAL AREA	4357 SQF	18146 SQF
MECHANICAL AREA	0 SQF	4213 SQF
PARKING AREA	0 SQF	0 SQF
TOTAL AREA PER ZONE	4357 SQF	22359 SQF
TOTAL AREA COMBINED	267	734 SQF

BUILDING B SUMMARY	MR4	MR6		
COMMERCIAL AREA	0 SQF	6641 SQF		
RESIDENTIAL AREA	40418 SQF	120392 SQF		
MECHANICAL AREA	141 SQF	24414 SQF		
PARKING AREA	0 SQF	0 SQF		
TOTAL AREA PER ZONE	40559 SQF	153240 SQF		
TOTAL AREA COMBINED	1937	193783 SQF		

			COMMERCIAL AREAS MR4
			RESIDENTIAL AREAS MR6
MR4	MR6	////	
0 SQF	6641 SQF		RESIDENTIAL AREAS MR4
40418 SQF	120392 SQF		
141 SQF	24414 SQF		MECHANICAL AREAS MR6
0 SQF	0 SQF	////	
40559 SQF	153240 SQF		MECHANICAL AREAS MR4
1937	83 SUE	l	


KEY

A000.B4r2 GROSS FLOOR AREA


PLANS

DISCLAIMER: These plans are conceptual only. They have not been subject to a comprehensive code and regulatory review, nor have they been tested against any as-built surveys. Discoveries in such an analysis may result in fundamental changes to the original concept. This scheme assumes zoning relief will be required. As with all zoning relief, the architect cannot guarantee zoning relief will be achieved.

COMMERCIAL AREAS MR6

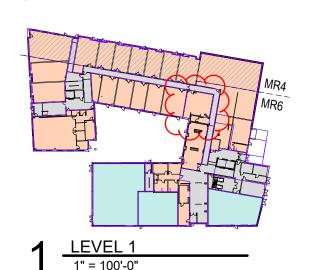

LEVEL 1 COMMERCIAL 6641 SF MECHANICAL 2420 SF RESIDENTIAL 15521 SF RESIDENTIAL MR4 7203 SF 33588 SF

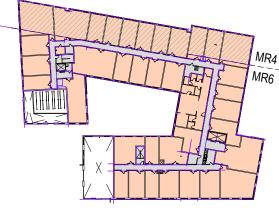

MECHANICAL	1166 SF	
RESIDENTIAL	25945 SF	
RESIDENTIAL MR4	7403 SF	
	34514 SF	

LEVEL 5 MECHANICAL

LEVEL 6 MECHANICAL

RESIDENTIAL

RESIDENTIAL MR4

RESIDENTIAL

RESIDENTIAL MR4

1147 SF

25253 SF

7403 SF

33803 SF

964 SF

21239 SF

4479 SF 26681 SF


LEVEL 4




- 1. BUILDING A IS LOCATED IN BOTH THE MR4 AND MR6 ZONING DISTRICTS.
- 2. LOT AREA 58,5545 SQFT
- 3. TOTAL GROSS AREA ALL FLOORS = 193,799 SQFT
 - 3A. TOTAL GROSS AREA ALL FLOORS IN MR4 = 40,559 SQFT
- 3B. TOTAL GROSS AREA ALL FLOORS IN MR6 = 153,240 SQFT
- 4. DENSITY FACTOR:
 - 4A. IN MR4 FOR LOTS OVER 5,500 SQFT THE DENSITY FACTOR IS 1,125.
 - 40,559 (SQFT IN MR4) / 1,125 = **36 PERMITTED UNITS**
 - 4B. IN MR6 FOR LOTS OVER 6,500 SQFT THE DENSITY FACTOR IS 850.
 - 153,240 (SQFT IN MR6) / 850 = **180 PERMITTED UNITS**
 - 4C. ACTUAL UNITS PROVIDED = 204

204 UNITS < 216 UNITS (36 MR4 UNITS + 180 MR6 UNITS)

KEY

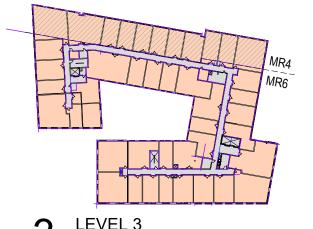


LEVEL 2	
MECHANICAL	1 <mark>085 SF</mark>
RESIDENTIAL	13517 SF
RESIDENTIAL MR4	7403 SF
	22005 SF

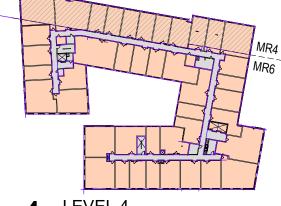

1	LEVE	L 4		·	
4	1" = 10	00'-0"			



		_
6	LEVEL 6	
O	1" = 100'-0"	_

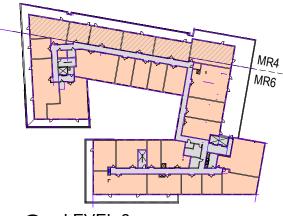


BUILDING B SUMMARY	MR4	MR6
COMMERCIAL AREA	0 SQF	6641 SQF
RESIDENTIAL AREA	41,294SQF	127,420SQF
MECHANICAL AREA	0 SQF	7,948 SQF
PARKING AREA	0 SQF	0 SQF
TOTAL AREA PER ZONE	41,294SQF	142,009SQF
TOTAL AREA COMBINED	183,30	3 SQF


				COMMERCIAL AREAS MR4
ING B SUMMARY	MR4	MR6		RESIDENTIAL AREAS MR6
ERCIAL AREA	0 SQF	6641 SQF		
ENTIAL AREA	41,294SQF	127,420SQF		RESIDENTIAL AREAS MR4
ANICAL AREA	0 SQF	7,948 SQF	(///)	
NG AREA	0 SQF	0 SQF		MECHANICAL AREAS MR6
AREA PER ZONE	41,294SQF	142,009SQF		
AREA COMBINED	183,303	SQF		MECHANICAL AREAS MR4
		-	E///,	

LEVEL 3	
MECHANICAL	1166 SF
RESIDENTIAL	25945 SF
RESIDENTIAL MR4	7403 SF
	34514 SF


299 BROADWAY - BUILDING B SOMERVILLE, MA, 02145

COMMERCIAL AREAS MR6

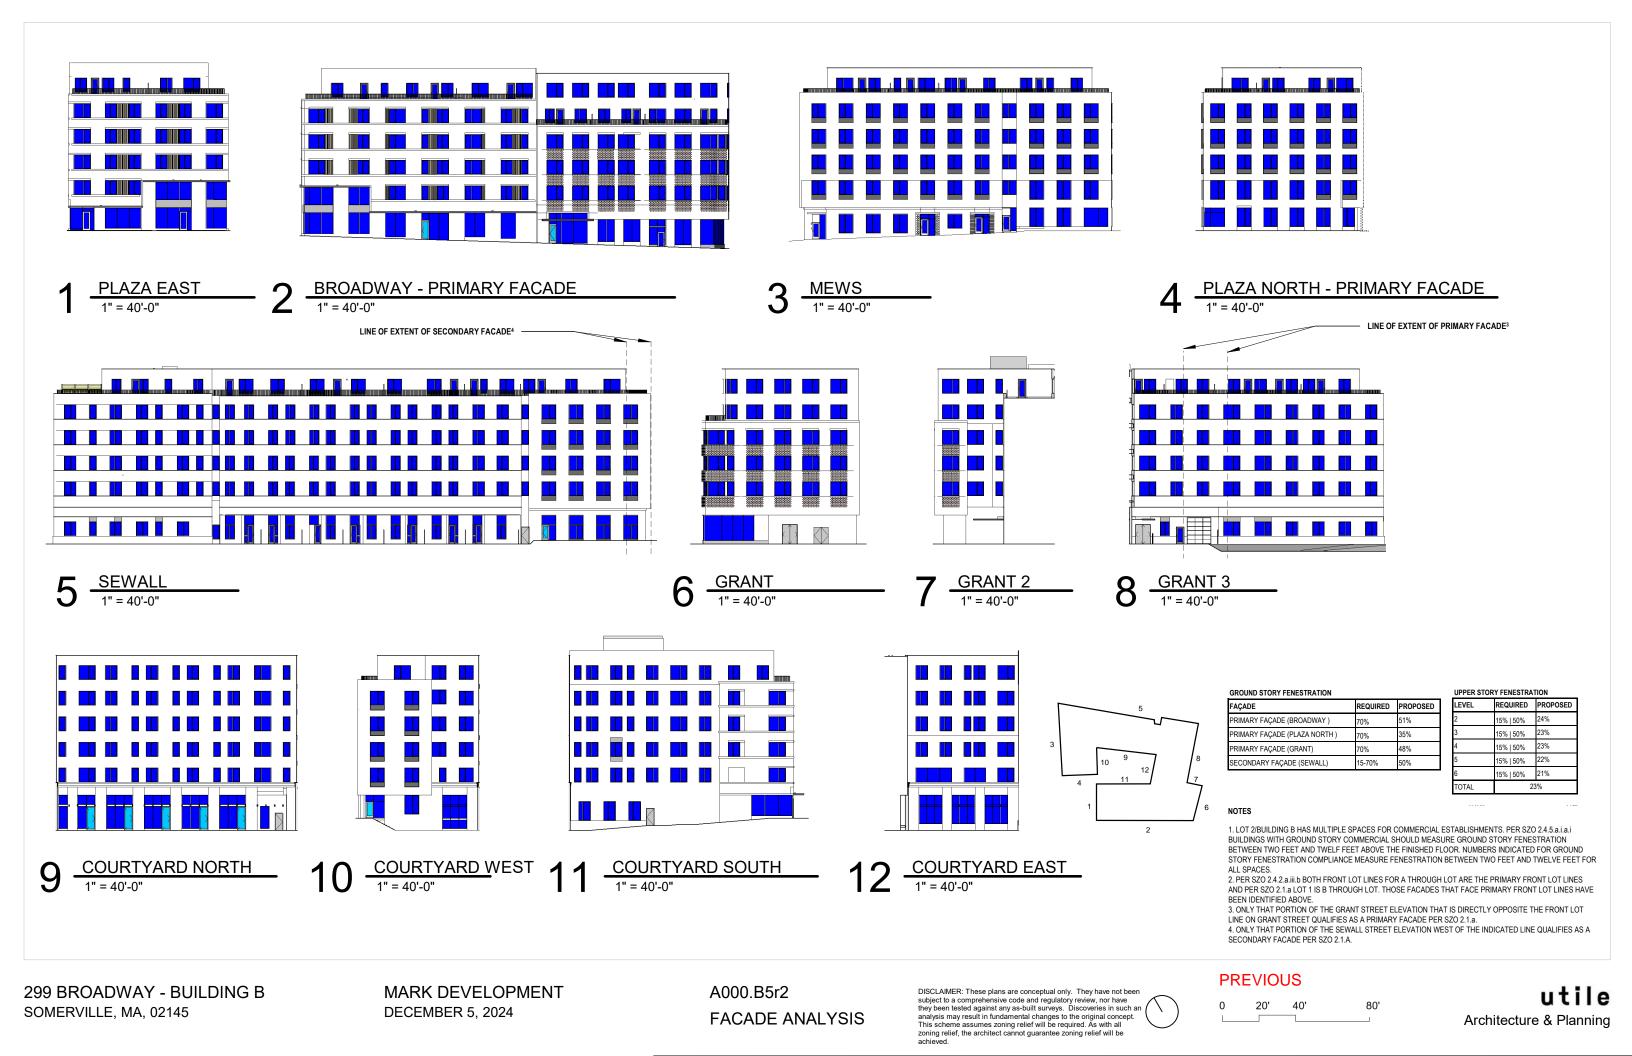

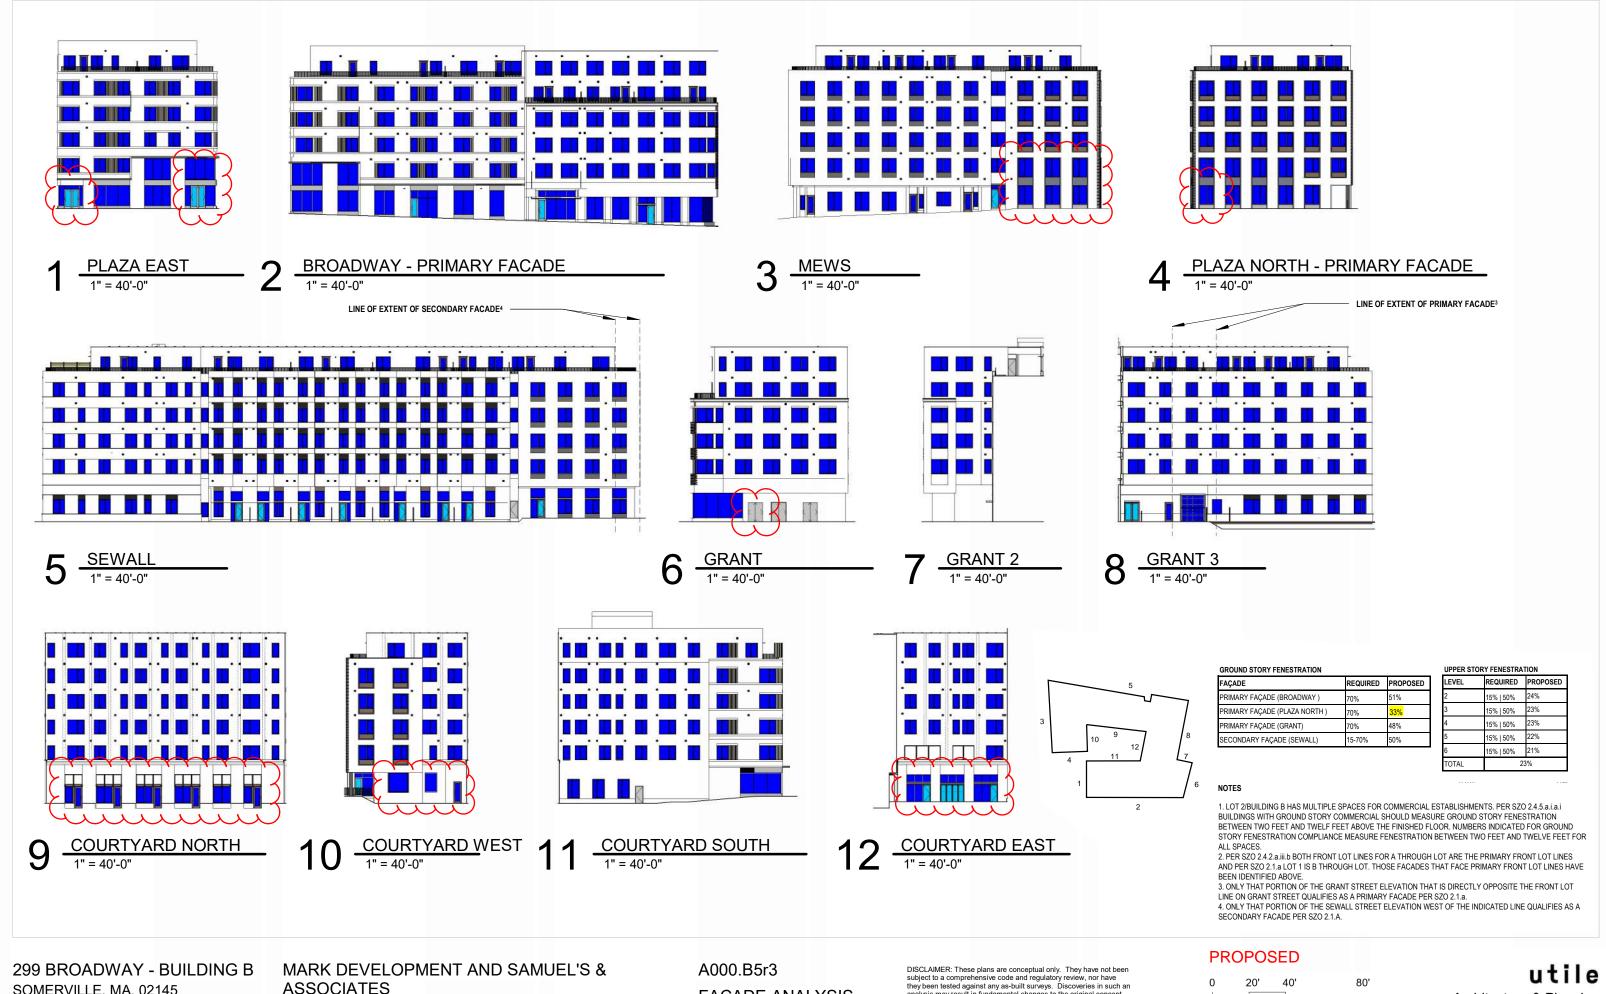

4/16/25

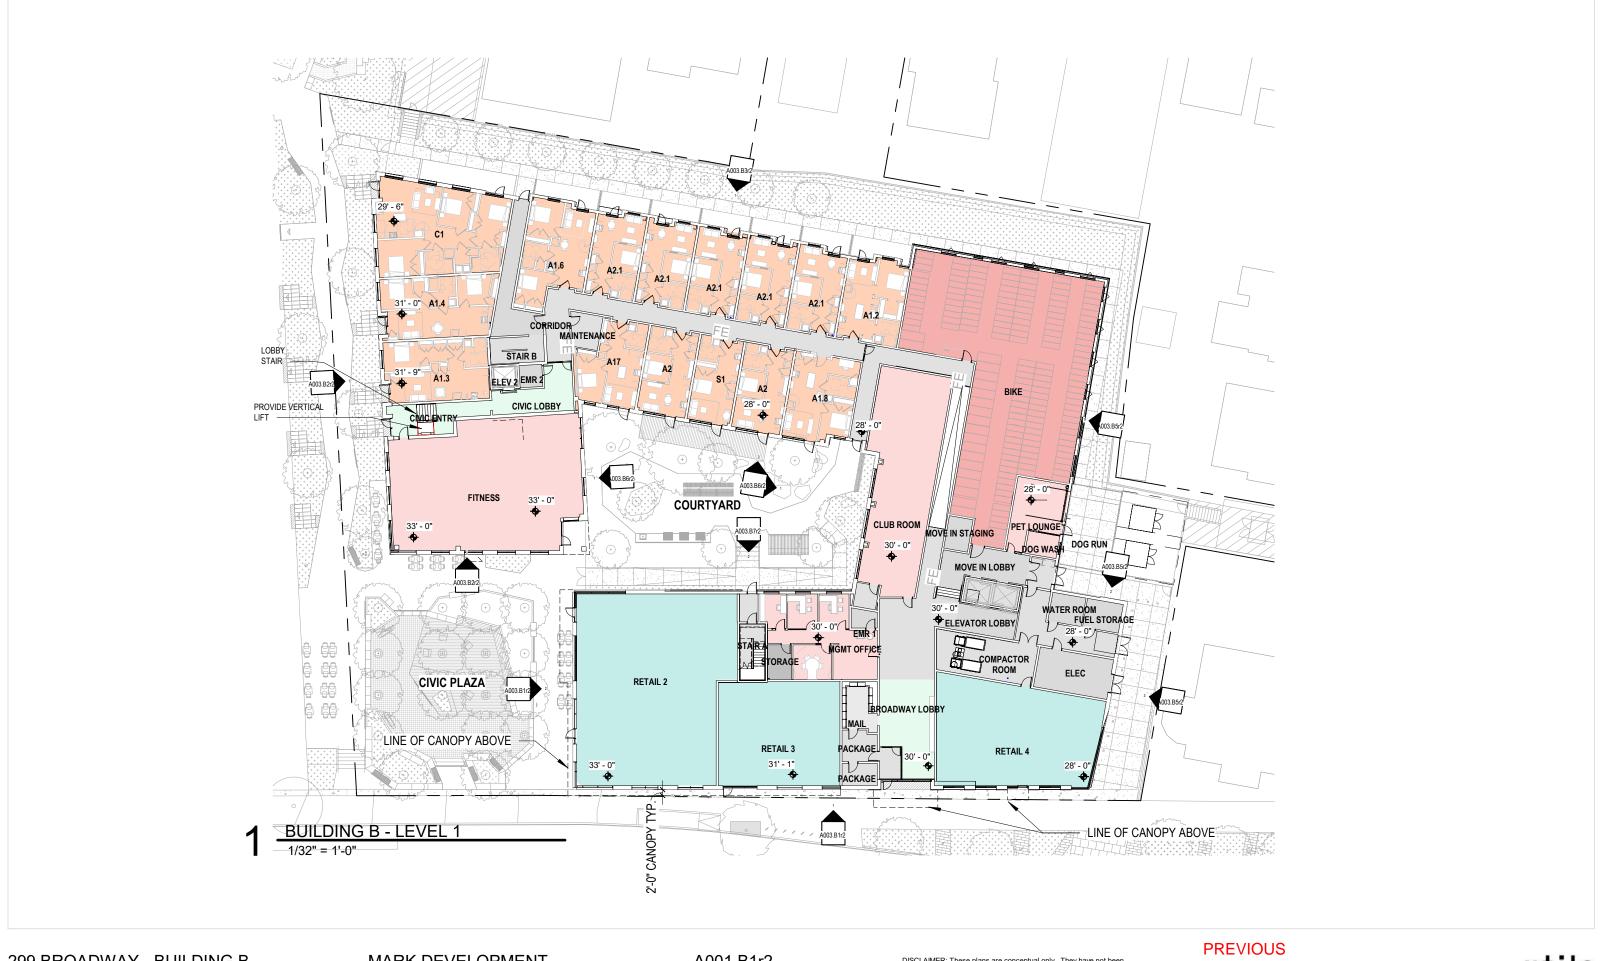

299 BROADWAY - BUILDING B SOMERVILLE, MA, 02145

MARK DEVELOPMENT DECEMBER 5, 2024 A001.B1r2
BUILDING B - LEVEL 1
PLAN

DISCLAIMER: These plans are conceptual only. They have not been subject to a comprehensive code and regulatory review, nor have they been tested against any as-built surveys. Discoveries in such an analysis may result in fundamental changes to the original concept. This scheme assumes zoning relief will be required. As with all zoning relief, the architect cannot guarantee zoning relief will be achieved.

0' 16' 32' 64'



299 BROADWAY - BUILDING B SOMERVILLE, MA, 02145

MARK DEVELOPMENT AND SAMUEL'S & ASSOCIATES

4/16/25

A001.B1r3
BUILDING B - LEVEL 1
PLAN

DISCLAIMER: These plans are conceptual only. They have not been subject to a comprehensive code and regulatory review, nor have they been tested against any as-built surveys. Discoveries in such an analysis may result in fundamental changes to the original concept. This scheme assumes zoning relief will be required. As with all zoning relief, the architect cannot guarantee zoning relief will be achieved.

0' 16' 32' 64'



SOMERVILLE, MA, 02145

DECEMBER 5, 2024

BUILDING B -ELEVATIONS

analysis may result in fundamental changes to the original concept. This scheme assumes zoning relief will be required. As with all zoning relief, the architect cannot guarantee zoning relief will be



4/16/25



NORTHWEST ELEVATION @ MEWS
3/64" = 1'-0"

2 SOUTHWEST ELEVATION @ PLAZA 3/64" = 1'-0"

ELEVATION KEY NOTES (A) 4" REVEAL CEMENT CLAPBOARD SIDING: COLOR A (A) BRICK A: RUNNING BOND ③ PRECAST; COLOR A PAINTED HOLLOW METAL DOOR; CUSTOM COLOR E 6" REVEAL CEMENT CLAPBOARD SIDING: COLOR A PRECAST; COLOR B (A) BRICK A: DECORATIVE BOND TILT-TURN STYLE, TRIPLE-GLAZED HIGH PERFORMANCE 4" REVEAL CEMENT CLAPBOARD SIDING: COLOR B UPVC WINDOWS, TYPICAL; SEE WINDOW SCHEDULE FOR PRECAST WATERTABLE; COLOR B (B) BRICK B: RUNNING BOND SIZING, OPERATION, AND ADDITIONAL REQUIREMENTS 4" REVEAL CEMENT CLAPBOARD SIDING: COLOR C PRECAST WINDOW BOX; COLOR C BRICK B: DECORATIVE BOND **6" THERMALLY BROKEN ALUMINUM STOREFRONT** 2 4" REVEAL CEMENT CLAPBOARD SIDING: COLOR D SYSTEM; SEE ENLARGED ELEVATIONS FOR SIZING, ® BRICK C: RUNNING BOND OPENING OPERATION, AND ADDITIONAL REQUIREMENTS 6" REVEAL CEMENT CLAPBOARD SIDING: COLOR D © BRICK C: DECORATIVE BOND **E** FC BOARD & BATTEN SIDING: COLOR E (A) FACTORY FINISH METAL ROOF EDGE, COLOR TBD ® BRICK SOLDIER COURSE BAND FACTORY FINISHED ALUMINUM WINDOW TRIM, TYPICAL ② 4" REVEAL CEMENT CLAPBOARD SIDING: COLOR F GALV POWDER COATED METAL SOLAR SHADE **©** FC PANEL: COLOR G **PROJECTION** GALV POWDER COATED METEAL PICKET BALCONY (H) FC PANEL: COLOR H RAIL

299 BROADWAY - BUILDING B SOMERVILLE, MA, 02145

MARK DEVELOPMENT DECEMBER 5, 2024 A003.B2r2
BUILDING B ELEVATIONS

DISCLAIMER: These plans are conceptual only. They have not been subject to a comprehensive code and regulatory review, nor have they been tested against any as-built surveys. Discoveries in such an analysis may result in fundamental changes to the original concept. This scheme assumes zoning relief will be required. As with all zoning relief, the architect cannot quarantee zoning relief will be

PREVIOUS

' 8' 16' 32'



ELEVATION KEY NOTES

(1A) BRICK A: RUNNING BOND

(1A.2) BRICK A: DECORATIVE BOND

(1B) BRICK B: RUNNING BOND

(1B.2) BRICK B: DECORATIVE BOND

(1C) BRICK C: RUNNING BOND

(1C.2) BRICK C: DECORATIVE BOND

(1D) BRICK SOLDIER COURSE BAND

4/16/25

- 2A) 4" REVEAL CEMENT CLAPBOARD SIDING: COLOR A
- (2A.2) 6" REVEAL CEMENT CLAPBOARD SIDING: COLOR A
- (2B) 4" REVEAL CEMENT CLAPBOARD SIDING: COLOR B
- (2C) 4" REVEAL CEMENT CLAPBOARD SIDING: COLOR C
- 2D 4" REVEAL CEMENT CLAPBOARD SIDING: COLOR D
- (2D.2) 6" REVEAL CEMENT CLAPBOARD SIDING: COLOR D
- (2E) FC BOARD & BATTEN SIDING: COLOR E
- (2F) 4" REVEAL CEMENT CLAPBOARD SIDING: COLOR F
- 2G) FC PANEL: COLOR G
- (2H) FC PANEL: COLOR H

- (3A) PRECAST; COLOR A
- (3B) PRECAST; COLOR B
- (3B.2) PRECAST WATERTABLE; COLOR B
- (3C) PRECAST WINDOW BOX; COLOR C
- (7) PAINTED HOLLOW METAL DOOR; CUSTOM COLOR E
 - TILT-TURN STYLE, TRIPLE-GLAZED HIGH PERFORMANCE UPVC WINDOWS, TYPICAL; SEE WINDOW SCHEDULE FOR SIZING, OPERATION, AND ADDITIONAL REQUIREMENTS
- 6" THERMALLY BROKEN ALUMINUM STOREFRONT SYSTEM; SEE ENLARGED ELEVATIONS FOR SIZING, OPENING OPERATION, AND ADDITIONAL REQUIREMENTS
- (6A) FACTORY FINISH METAL ROOF EDGE, COLOR TBD
- (6B) FACTORY FINISHED ALUMINUM WINDOW TRIM, TYPICAL
- 6C GALV POWDER COATED METAL SOLAR SHADE PROJECTION
- (6D) GALV POWDER COATED METEAL PICKET BALCONY RAIL

299 BROADWAY - BUILDING B SOMERVILLE, MA, 02145



299 BROADWAY - BUILDING B SOMERVILLE, MA, 02145

MARK DEVELOPMENT DECEMBER 5, 2024 A003.B3r2
BUILDING B ELEVATIONS

DISCLAIMER: These plans are conceptual only. They have not been subject to a comprehensive code and regulatory review, nor have they been tested against any as-built surveys. Discoveries in such an analysis may result in fundamental changes to the original concept. This scheme assumes zoning relief will be required. As with all zoning relief, the architect cannot guarantee zoning relief will be



)' 8' 16' 32' L utile
Architecture & Planning

 \triangleright




SOMERVILLE, MA, 02145

ASSOCIATES

4/16/25

BUILDING B-ELEVATIONS they been tested against any as-built surveys. Discoveries in such an analysis may result in fundamental changes to the original concept. This scheme assumes zoning relief will be required. As with all zoning relief, the architect cannot guarantee zoning relief will be

16' 8'

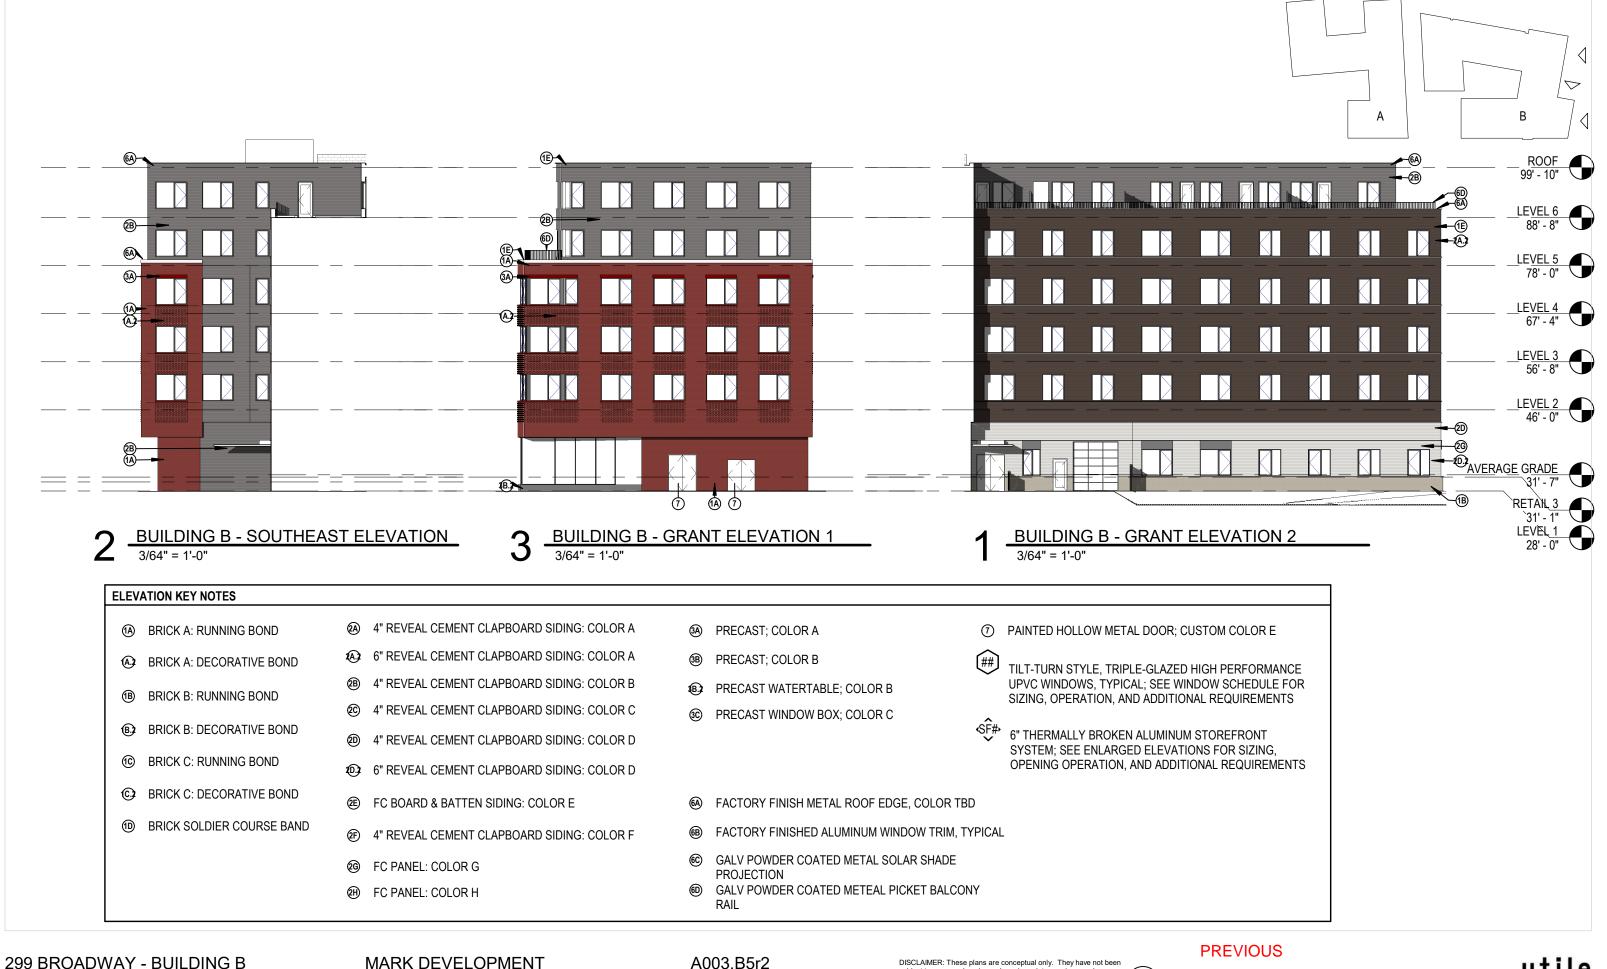


299 BROADWAY - BUILDING B SOMERVILLE, MA, 02145

MARK DEVELOPMENT DECEMBER 5, 2024


BUILDING B -ELEVATIONS DISCLAIMER: These plans are conceptual only. They have not been subject to a comprehensive code and regulatory review, nor have they been tested against any as-built surveys. Discoveries in such an analysis may result in fundamental changes to the original concept. This scheme assumes zoning relief will be required. As with all zoning relief, the architect cannot guarantee zoning relief will be

8' 16' 32'

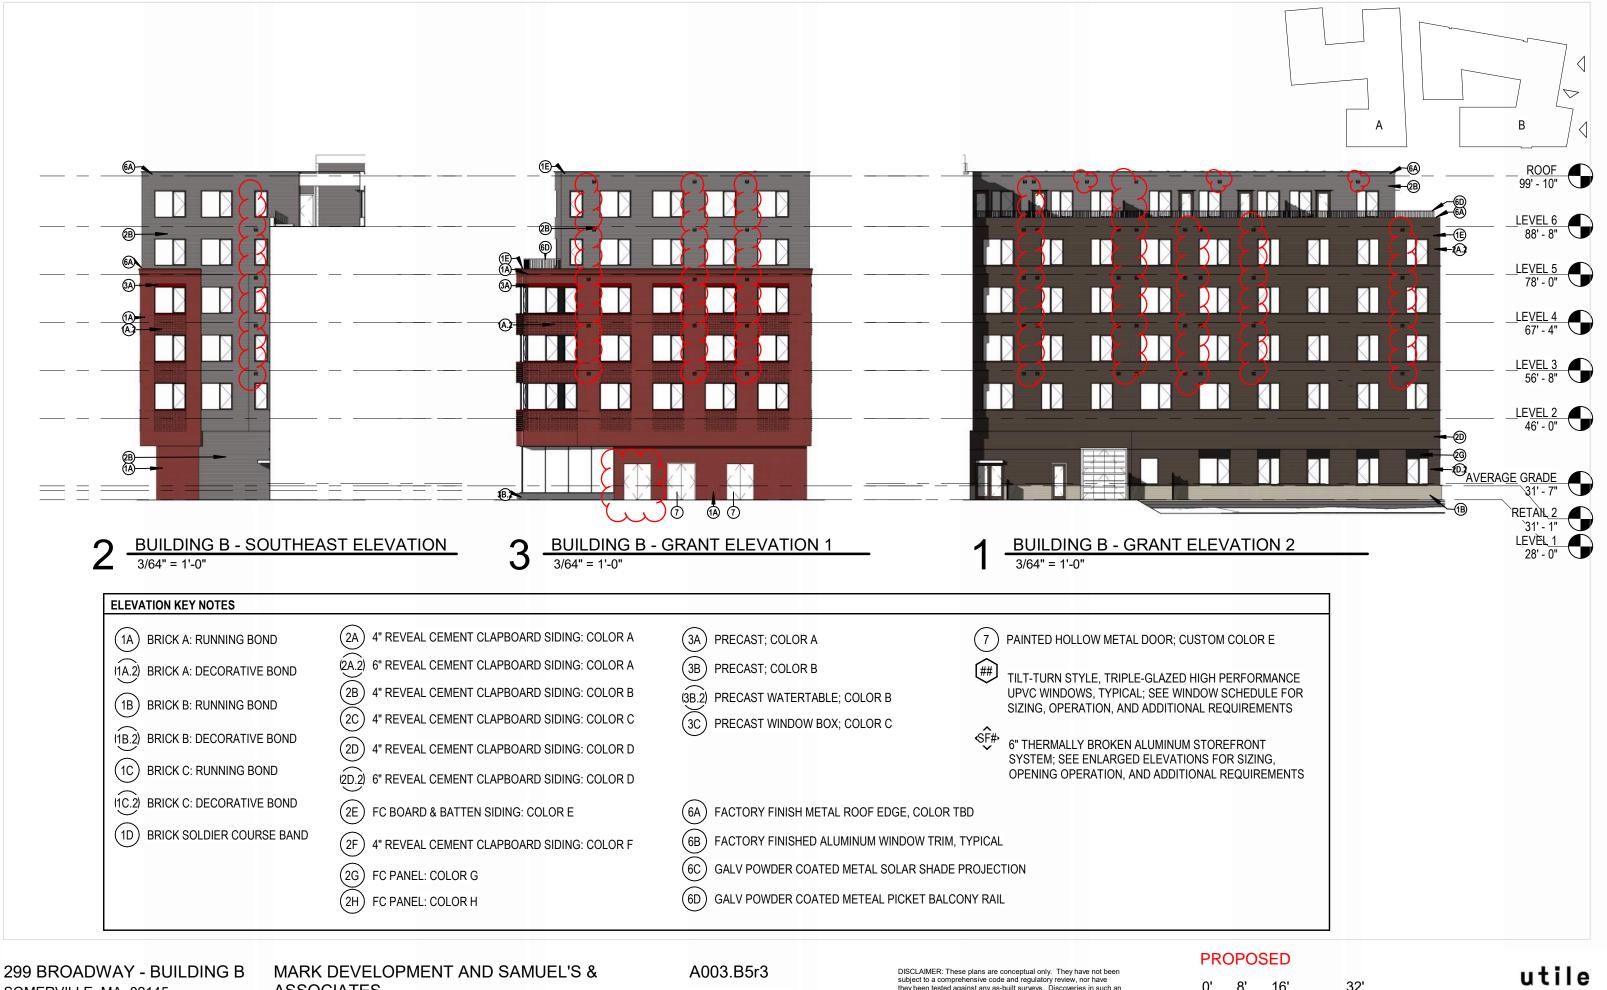

SOMERVILLE, MA, 02145

4/16/25

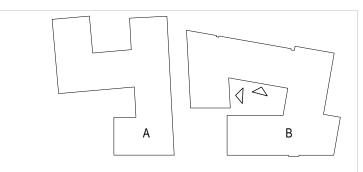

ROOF 99' - 10"

LEVEL 6 88' - 8"

LEVEL 5 78' - 0"

LEVEL 4 67' - 4"

LEVEL 3 56' - 8"

LEVEL 2 46' - 0"



BUILDING B - COURTARD NORTH ELEVATION

RETAIL 3 31' - 1" LEVEL 1 28' - 0"

AVERAGE GRADE

ELEVATION KEY NOTES

- (A) BRICK A: RUNNING BOND
- (A) BRICK A: DECORATIVE BOND
- (B) BRICK B: RUNNING BOND
- ® BRICK B: DECORATIVE BOND
- ® BRICK C: RUNNING BOND
- © BRICK C: DECORATIVE BOND
- ® BRICK SOLDIER COURSE BAND

- (A) 4" REVEAL CEMENT CLAPBOARD SIDING: COLOR A
- 6" REVEAL CEMENT CLAPBOARD SIDING: COLOR A
- 4" REVEAL CEMENT CLAPBOARD SIDING: COLOR B
- 4" REVEAL CEMENT CLAPBOARD SIDING: COLOR C
- 2 4" REVEAL CEMENT CLAPBOARD SIDING: COLOR D
- 6" REVEAL CEMENT CLAPBOARD SIDING: COLOR D
- **E** FC BOARD & BATTEN SIDING: COLOR E
- ② 4" REVEAL CEMENT CLAPBOARD SIDING: COLOR F
- **©** FC PANEL: COLOR G

BUILDING B - COURTYARD WEST ELEVATION

(H) FC PANEL: COLOR H

- ③ PRECAST; COLOR A
- PRECAST; COLOR B
- PRECAST WATERTABLE; COLOR B
- © PRECAST WINDOW BOX; COLOR C


- 7 PAINTED HOLLOW METAL DOOR; CUSTOM COLOR E
- TILT-TURN STYLE, TRIPLE-GLAZED HIGH PERFORMANCE UPVC WINDOWS, TYPICAL; SEE WINDOW SCHEDULE FOR SIZING, OPERATION, AND ADDITIONAL REQUIREMENTS
- **6" THERMALLY BROKEN ALUMINUM STOREFRONT** SYSTEM; SEE ENLARGED ELEVATIONS FOR SIZING, OPENING OPERATION, AND ADDITIONAL REQUIREMENTS
- FACTORY FINISHED ALUMINUM WINDOW TRIM, TYPICAL
- GALV POWDER COATED METAL SOLAR SHADE **PROJECTION**
- RAIL


(A) FACTORY FINISH METAL ROOF EDGE, COLOR TBD

GALV POWDER COATED METEAL PICKET BALCONY

PREVIOUS

32' 8'

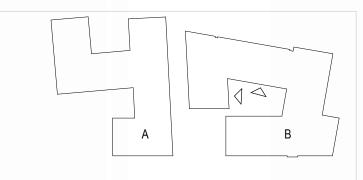

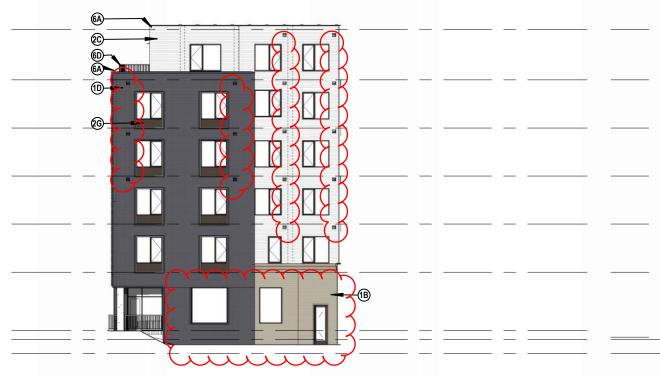

-ROOF 99' - 10" LEVEL 6 88' - 8" LEVEL 5 78' - 0" LEVEL 4 67' - 4" LEVEL 3 56' - 8" LEVEL 2 46' - 0" AVERAGE GRADE **\31' - 7"** RETAIL 2 31' - 1" BUILDING B - COURTARD NORTH ELEVATION 3/64" = 1'-0" LEVEL 1 28' - 0"

ELEVATION KEY NOTES

- (1A) BRICK A: RUNNING BOND
- (1A.2) BRICK A: DECORATIVE BOND
- (1B) BRICK B: RUNNING BOND
- (1B.2) BRICK B: DECORATIVE BOND
- (1C) BRICK C: RUNNING BOND

SOMERVILLE, MA, 02145

- (1C.2) BRICK C: DECORATIVE BOND
- (1D) BRICK SOLDIER COURSE BAND

- 4" REVEAL CEMENT CLAPBOARD SIDING: COLOR A
- (2A.2) 6" REVEAL CEMENT CLAPBOARD SIDING: COLOR A
- (2B) 4" REVEAL CEMENT CLAPBOARD SIDING: COLOR B
- (2C) 4" REVEAL CEMENT CLAPBOARD SIDING: COLOR C
- 2D 4" REVEAL CEMENT CLAPBOARD SIDING: COLOR D
- (2D.2) 6" REVEAL CEMENT CLAPBOARD SIDING: COLOR D
- (2E) FC BOARD & BATTEN SIDING: COLOR E
- 2F) 4" REVEAL CEMENT CLAPBOARD SIDING: COLOR F
- (2G) FC PANEL: COLOR G

BUILDING B - COURTYARD WEST ELEVATION

(2H) FC PANEL: COLOR H

- (3A) PRECAST; COLOR A
- (3B) PRECAST; COLOR B
- (3B.2) PRECAST WATERTABLE; COLOR B
- PRECAST WINDOW BOX; COLOR C

- PAINTED HOLLOW METAL DOOR; CUSTOM COLOR E
- TILT-TURN STYLE, TRIPLE-GLAZED HIGH PERFORMANCE UPVC WINDOWS, TYPICAL; SEE WINDOW SCHEDULE FOR SIZING, OPERATION, AND ADDITIONAL REQUIREMENTS
- 6" THERMALLY BROKEN ALUMINUM STOREFRONT SYSTEM; SEE ENLARGED ELEVATIONS FOR SIZING, OPENING OPERATION, AND ADDITIONAL REQUIREMENTS
- (6A) FACTORY FINISH METAL ROOF EDGE, COLOR TBD
- (6B) FACTORY FINISHED ALUMINUM WINDOW TRIM, TYPICAL
- (6C) GALV POWDER COATED METAL SOLAR SHADE PROJECTION
- GALV POWDER COATED METEAL PICKET BALCONY RAIL

MARK DEVELOPMENT AND SAMUEL'S & 299 BROADWAY - BUILDING B **ASSOCIATES**

4/16/25


A003.B6r3 **BUILDING B-ELEVATIONS**

DISCLAIMER: These plans are conceptual only. They have not been subject to a comprehensive code and regulatory review, nor have they been tested against any as-built surveys. Discoveries in such an analysis may result in fundamental changes to the original concept. This scheme assumes zoning relief will be required. As with all zoning relief, the architect cannot guarantee zoning relief will be

PROPOSED

32' 8' 16'



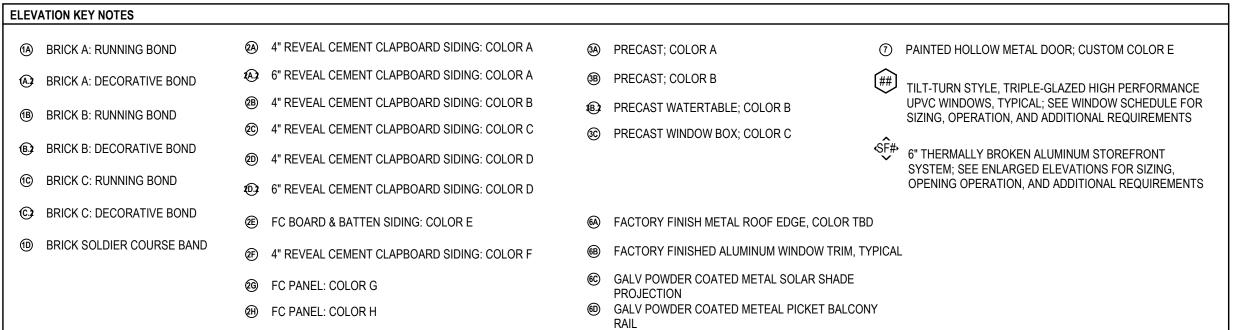



- 11B.2) BRICK B: DECORATIVE BOND
- 1C BRICK C: RUNNING BOND
- (1C.2) BRICK C: DECORATIVE BOND
- (1D) BRICK SOLDIER COURSE BAND

4/16/25

- (2D) 4" REVEAL CEMENT CLAPBOARD SIDING: COLOR D
- (2D.2) 6" REVEAL CEMENT CLAPBOARD SIDING: COLOR D
- (2E) FC BOARD & BATTEN SIDING: COLOR E
- (2F) 4" REVEAL CEMENT CLAPBOARD SIDING: COLOR F
- 2G FC PANEL: COLOR G
- (2H) FC PANEL: COLOR H

- 6" THERMALLY BROKEN ALUMINUM STOREFRONT SYSTEM; SEE ENLARGED ELEVATIONS FOR SIZING, OPENING OPERATION, AND ADDITIONAL REQUIREMENTS
- (6A) FACTORY FINISH METAL ROOF EDGE, COLOR TBD
- (6B) FACTORY FINISHED ALUMINUM WINDOW TRIM, TYPICAL
- 6C GALV POWDER COATED METAL SOLAR SHADE PROJECTION
- (6D) GALV POWDER COATED METEAL PICKET BALCONY RAIL

299 BROADWAY - BUILDING B SOMERVILLE, MA, 02145

MARK DEVELOPMENT AND SAMUEL'S & ASSOCIATES

A003.B7r3
BUILDING B ELEVATIONS

DISCLAIMER: These plans are conceptual only. They have not been subject to a comprehensive code and regulatory review, nor have they been tested against any as-built surveys. Discoveries in such an analysis may result in fundamental changes to the original concept. This scheme assumes zoning relief will be required. As with all zoning relief, the architect cannot guarantee zoning relief will be

PROPOSED

0' 8' 16' 32'



299 BROADWAY - COMPREHENSIVE PERMIT APPLICATION

Owner: Mark Development & Beacon Communities A004.B1


Architect: Utile P&Z 22-092 November 8, 2022

299 Broadway Somerville, MA, 02145 Landscape Architect: Future Green Civil Engineer: Bohler Traffic Engineer: VHB

SIGNAGE PLANS





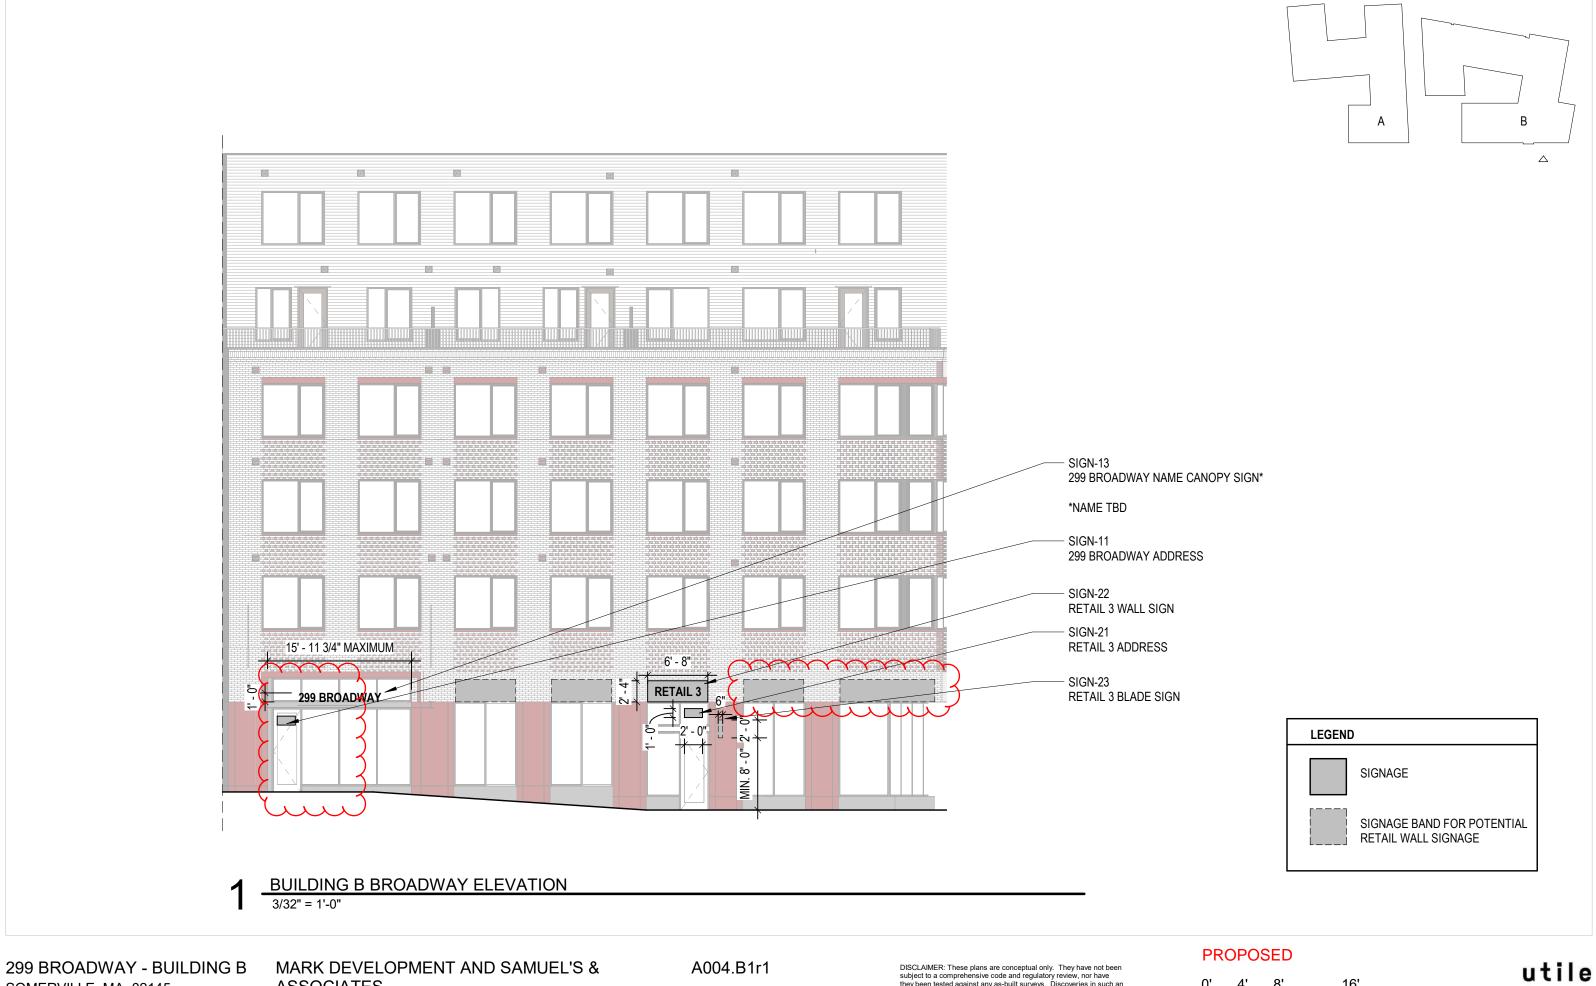


SOMERVILLE, MA, 02145

ASSOCIATES

BUILDING B - SIGNAGE

PLANS

DISCLAIMER: These plans are conceptual only. They have not been subject to a comprehensive code and regulatory review, nor have they been tested against any as-built surveys. Discoveries in such an analysis may result in fundamental changes to the original concept. This scheme assumes zoning relief will be required. As with all zoning relief, the architect cannot guarantee zoning relief will be achieved.

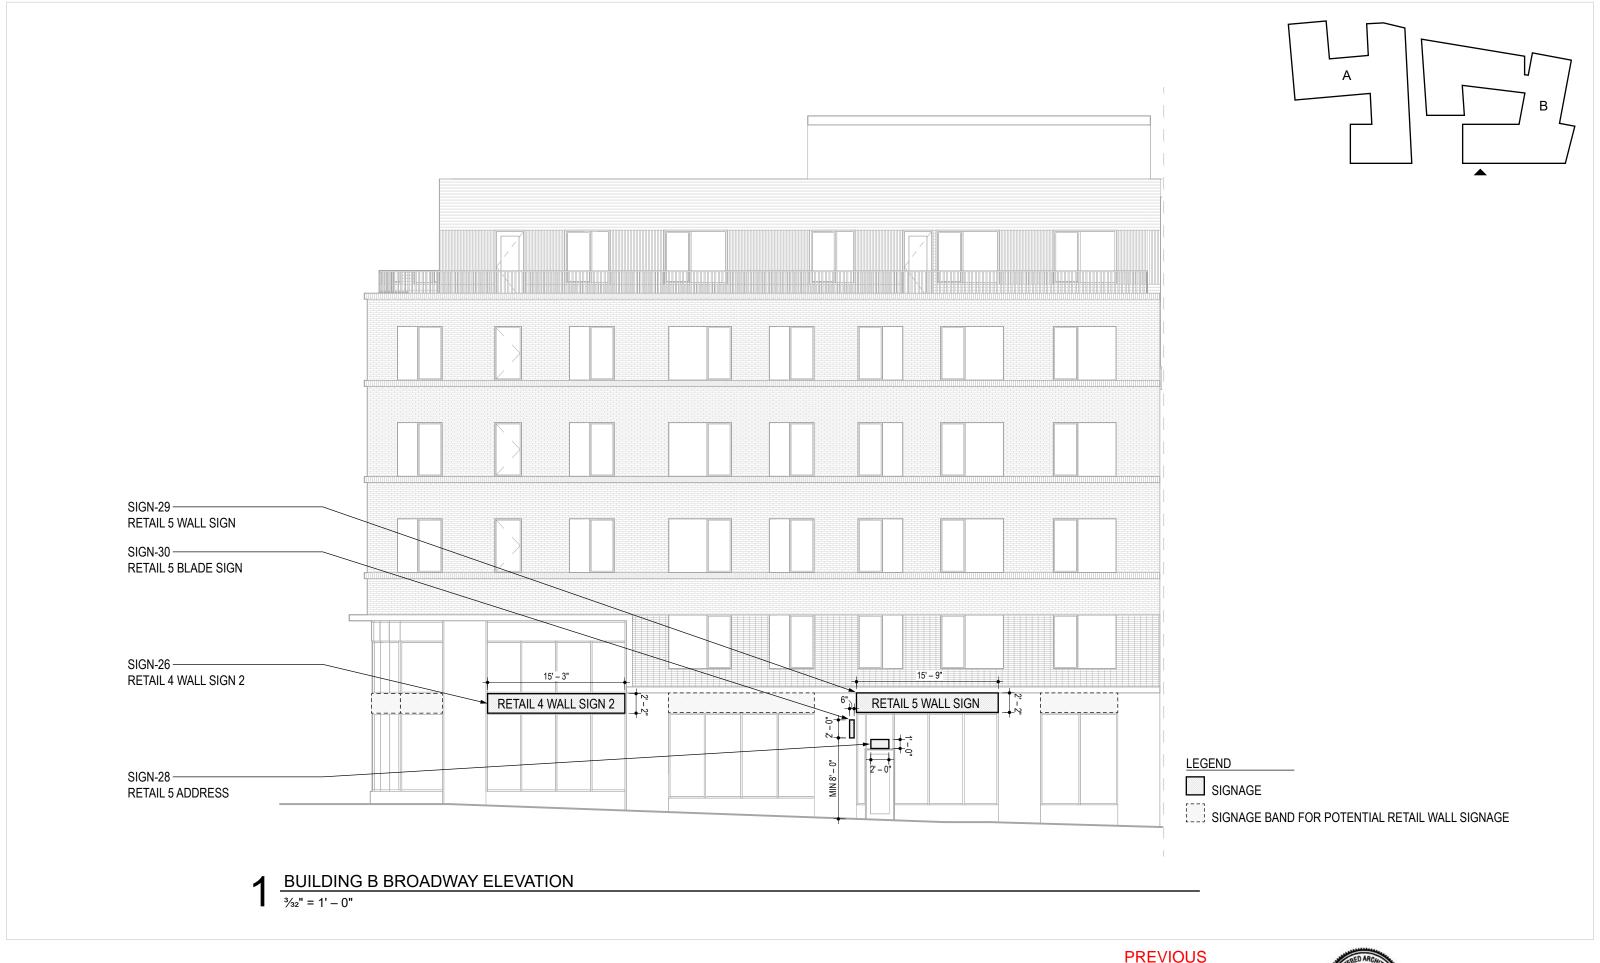


299 BROADWAY - COMPREHENSIVE PERMIT APPLICATION

Owner: Mark Development & Beacon Communities A004.B2

Architect: Utile


Landscape Architect: Future Green Civil Engineer: Bohler Traffic Engineer: VHB

SIGNAGE PLANS

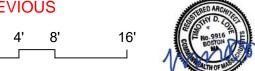



Somerville, MA, 02145

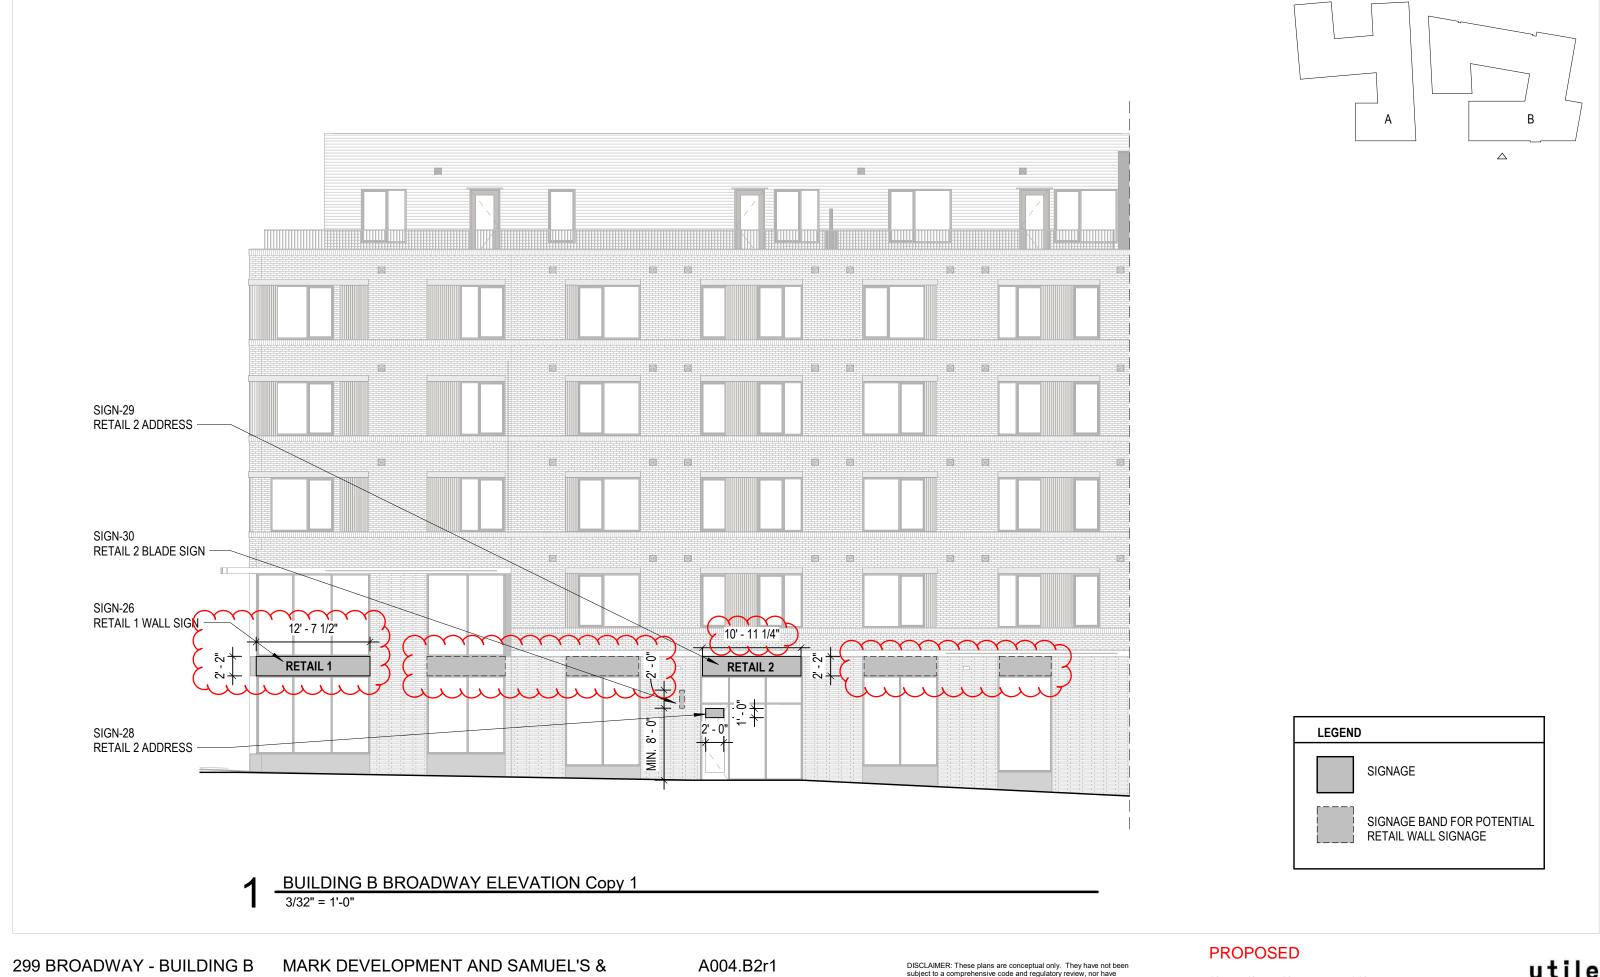


SOMERVILLE, MA, 02145


ASSOCIATES

BUILDING B - SIGNAGE

PLANS

DISCLAIMER: These plans are conceptual only. They have not been subject to a comprehensive code and regulatory review, nor have they been tested against any as-built surveys. Discoveries in such an analysis may result in fundamental changes to the original concept. This scheme assumes zoning relief will be required. As with all zoning relief, the architect cannot guarantee zoning relief will be achieved.

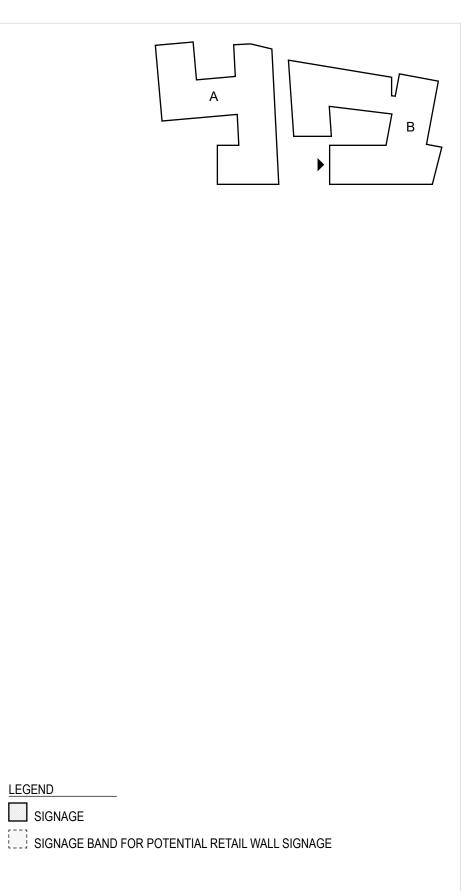

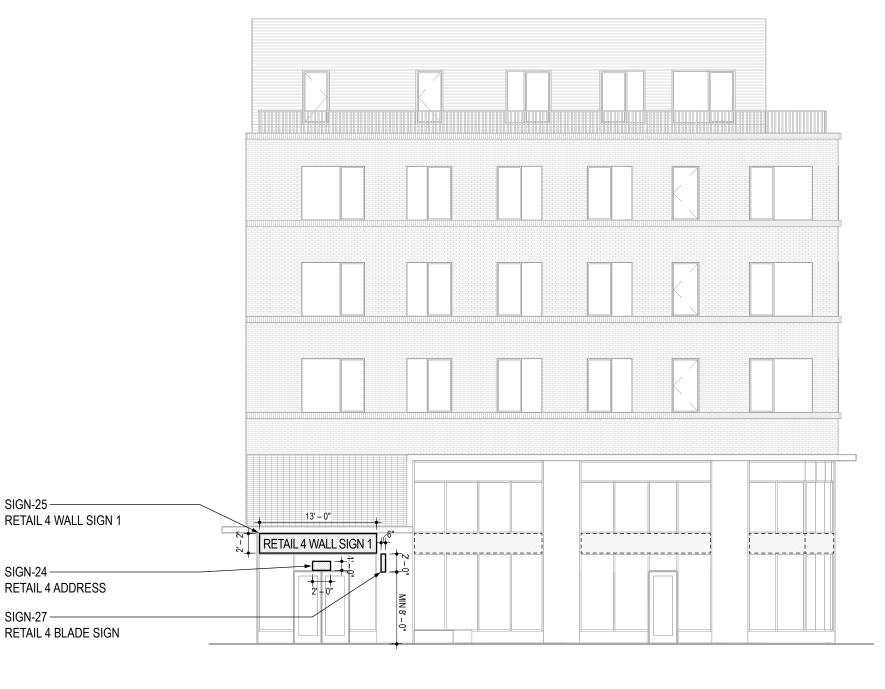

SIGNAGE

LEGEND


PLAZA EAST ELEVATION

³/₃₂" = 1' – 0"

PREVIOUS





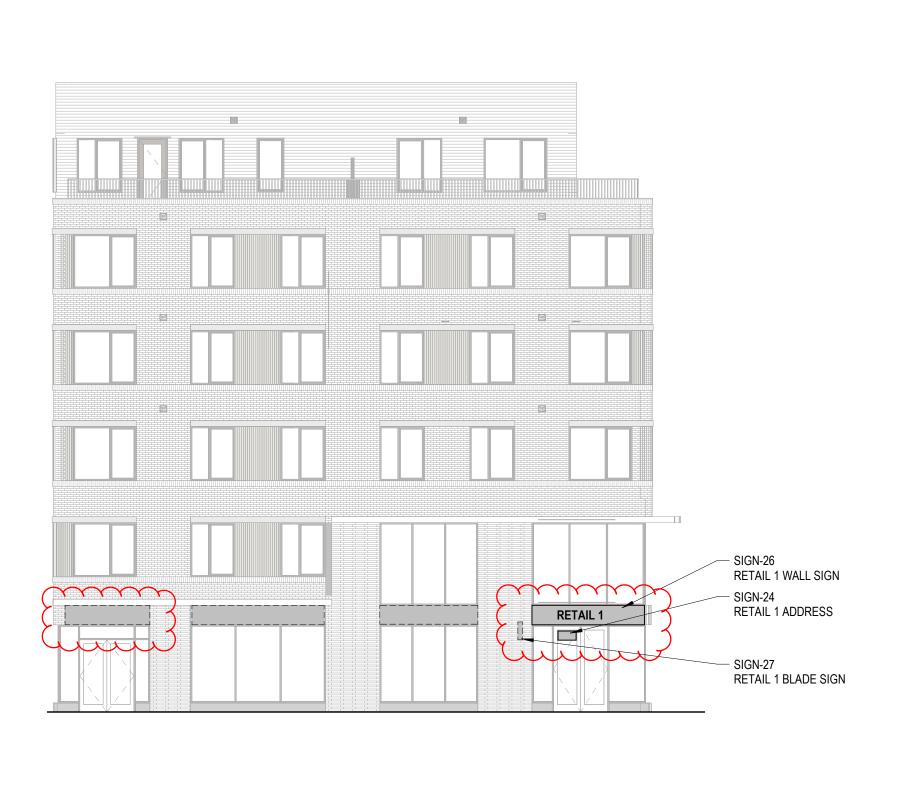


LEGEND SIGNAGE SIGNAGE BAND FOR POTENTIAL RETAIL WALL SIGNAGE

PLAZA EAST ELEVATION
3/32" = 1'-0"

4/16/25

299 BROADWAY - BUILDING B SOMERVILLE, MA, 02145

PLANS

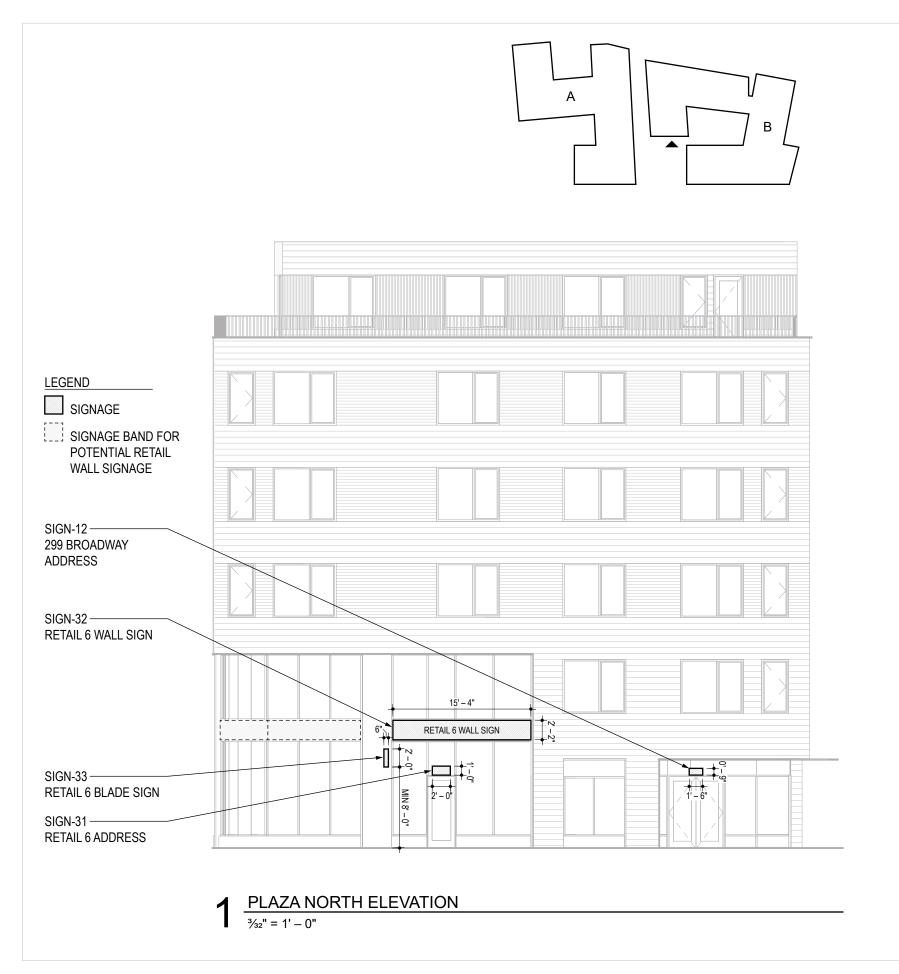

Sign ID	Sign Description		Sign Type	Dimensions (max)
Sign-11	Address sign at 299 Broadway primary residential entrance	Dimensional letters on glass w vinyl backer	Address Sign	2' - 0" × 1' - 0"
Sign-12	Address sign at 299 Broadway secondary residential entrance	Vinyl letters on glass, 2nd surface mounted	Window Sign	1' - 6" × 0' - 9"
Sign-13	299 Broadway name sign	Dimensional letters mounted to top of canopy	Canopy Sign	17' – 8" × 1' – 0"
Sign-21	Address sign at Retail 3 Entrance	Dimensional letters on glass w vinyl backer	Address Sign	2' - 0" × 1' - 0"
Sign-22	Retail 3 name wall sign	Dimensional, pin mounted letters on metal signage band	Wall Sign	6' - 9" × 2' - 9"
Sign-23	Retail 3 name blade sign	Blade sign mounted to brick	Blade sign	3'-0" × 2'-0" × 0'-6"
Sign-24	Address sign at Retail 4 Entrance	Dimensional letters on glass w vinyl backer	Address Sign	2' - 0" × 1' - 0"
Sign-25	Retail 4 name wall sign (1 of 2)	Dimensional, pin mounted letters on metal signage band	Wall Sign	14' – 4" × 2' – 2"
Sign-26	Retail 4 name wall sign (2 of 2)	Dimensional, pin mounted letters on metal signage band	Wall Sign	15' - 3" × 2' - 2"
Sign-27	Retail 4 name blade sign	Blade sign mounted to metal	Blade sign	3'-0" × 2'-0" × 0'-6"
Sign-28	Address sign at Retail 5 Entrance	Dimensional letters on glass w vinyl backer	Address Sign	2' - 0" × 1' - 0"
Sign-29	Retail 5 name wall sign	Dimensional, pin mounted letters on metal signage band	Wall Sign	15' – 9" × 2' – 2"
Sign-30	Retail 5 name blade sign	Blade sign mounted to metal	Blade sign	3'-0" × 2'-0" × 0'-6"
Sign-31	Address sign at Retail 6 Entrance	Dimensional letters on glass w vinyl backer	Address Sign	2' - 0" × 1' - 0"
Sign-32	Retail 6 name wall sign	Dimensional, pin mounted letters on metal signage band	Wall Sign	15' – 4" × 2' – 2"
Sign-33	Retail 6 name blade sign	Blade sign mounted to metal	Blade sign	3' - 0" × 2' - 0" × 0' - 6"

2 BUILDING B SIGNAGE PLAN SCHEDULE


PREVIOUS


0' 4' 8' 10





Somerville, MA, 02145

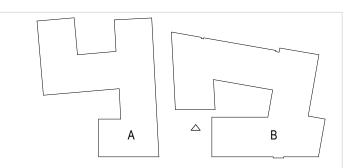

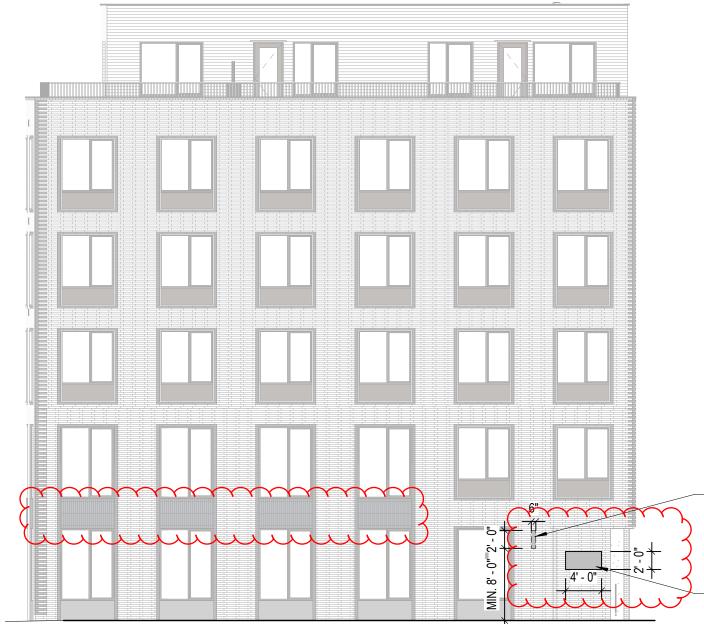

Sign ID	Sign Description		Sign Type	Dimensions (max)
Sign-01	Address sign at 15 Temple St; primary residential entrance	Dimensional letters on glass w vinyl backer	Address Sign	2' - 0" × 1' - 0" × 0' - 1"
Sign-02	Address sign at 15 Temple St, secondary residential entrance	Vinyl letters on glass, 2nd surface mounted	Address Sign	2' - 0" × 1' - 0"
Sign-03	15 Temple name sign	Dimensional letters mounted to top of canopy	Canopy Sign	9' - 0" × 1' - 0" × 0' - 6"
Sign-04	Address sign at A.C.E. entrance	Vinyl letters on glass, 2nd surface mounted	Address Sign	2' - 0" × 1' - 0"
Sign-05	Address sign at Winter Hill Community Space	Dimensional letters on glass w vinyl backer	Address Sign	2' - 0" × 1' - 0" × 0' - 1"
Sign-06	Winter Hill Community Space name wall sign 1	Dimensional, pin mounted letters on metal signage band	Wall Sign	29' - 0" × 3' - 6" × 0' - 6
Sign-07	Winter Hill Community Space name wall sign 2	Dimensional, pin mounted letters on metal signage band	Wall Sign	9' - 4" × 3' - 6" × 0' - 6"
Sign-08	Winter Hill Community Space name window sign	Vinyl letters on glass, 2nd surface mounted	Window Sign	4' - 7" × 2' - 0"
Sign-09	Address sign at Retail 2 Entrance	Dimensional letters on glass w vinyl backer	Address Sign	2' - 0" × 1' - 0" × 0' - 1"
Sign-10	Retail 2 name window sign	Vinyl letters on glass, 2nd surface mounted	Window Sign	8' - 0" × 3' - 0"
Sign-11	Retail 2 name blade sign	Blade sign mounted underneath canopy	Blade Sign	3' - 0" × 2' - 0" × 0' - 6"
Sign-12	Address sign at Retail 1 Entrance	Dimensional letters on glass w vinyl backer	Address Sign	2'-0" × 1'-0" × 0'-1"
Sign-13	Retail 1 name window sign	Vinyl letters on glass, 2nd surface mounted	Window Sign	8' - 0" × 3' - 0"
Sign-14	Retail 1 name blade sign	Blade sign mounted underneath canopy	Blade-Sign	3'-0"×2'-0"×0'-6"
Sign-34	Broadway Fitness Entry Wall Signage	Dimensional, pin mounted letters on wall	Wall Sign	4' - 0" × 2' - 0" × 0' - 2"
Sign-35	299 Broadway Blade Sign	Blade sign mounted underneath canopy	Blade Sign	3'-0" × 2'-0" × 0'-6"

BUILDING A SIGNAGE PLAN SCHEDULE

SIGN-35 299 BROADWAY BLADE SIGN

SIGN-34 299 BROADWAY FITNESS ENTRY WALL SIGN **LEGEND** SIGNAGE SIGNAGE BAND FOR POTENTIAL RETAIL WALL SIGNAGE

PLAZA NORTH ELEVATION
3/32" = 1'-0"

4/16/25

PROPOSED



299 BROADWAY - BUILDING B SOMERVILLE, MA, 02145

MARK DEVELOPMENT AND SAMUEL'S & **ASSOCIATES** 4/16/25

A004.B5 **BUILDING B - SIGNAGE**

PLANS

DISCLAIMER: These plans are conceptual only. They have not been subject to a comprehensive code and regulatory review, nor have they been tested against any as-built surveys. Discoveries in such an analysis may result in fundamental changes to the original concept. This scheme assumes zoning relief will be required. As with all zoning relief, the architect cannot guarantee zoning relief will be achieved.



299 BROADWAY - COMPREHENSIVE PERMIT APPLICATION


P&Z 22-092 November 8, 2022 299 Broadway Somerville, MA, 02145 Owner: Mark Development & Beacon Communities Architect: Utile Landscape Architect: Future Green Civil Engineer: Bohler Traffic Engineer: VHB

L.001.B2 LANDSCAPE PLAN

NOT FOR CONSTRUCTION





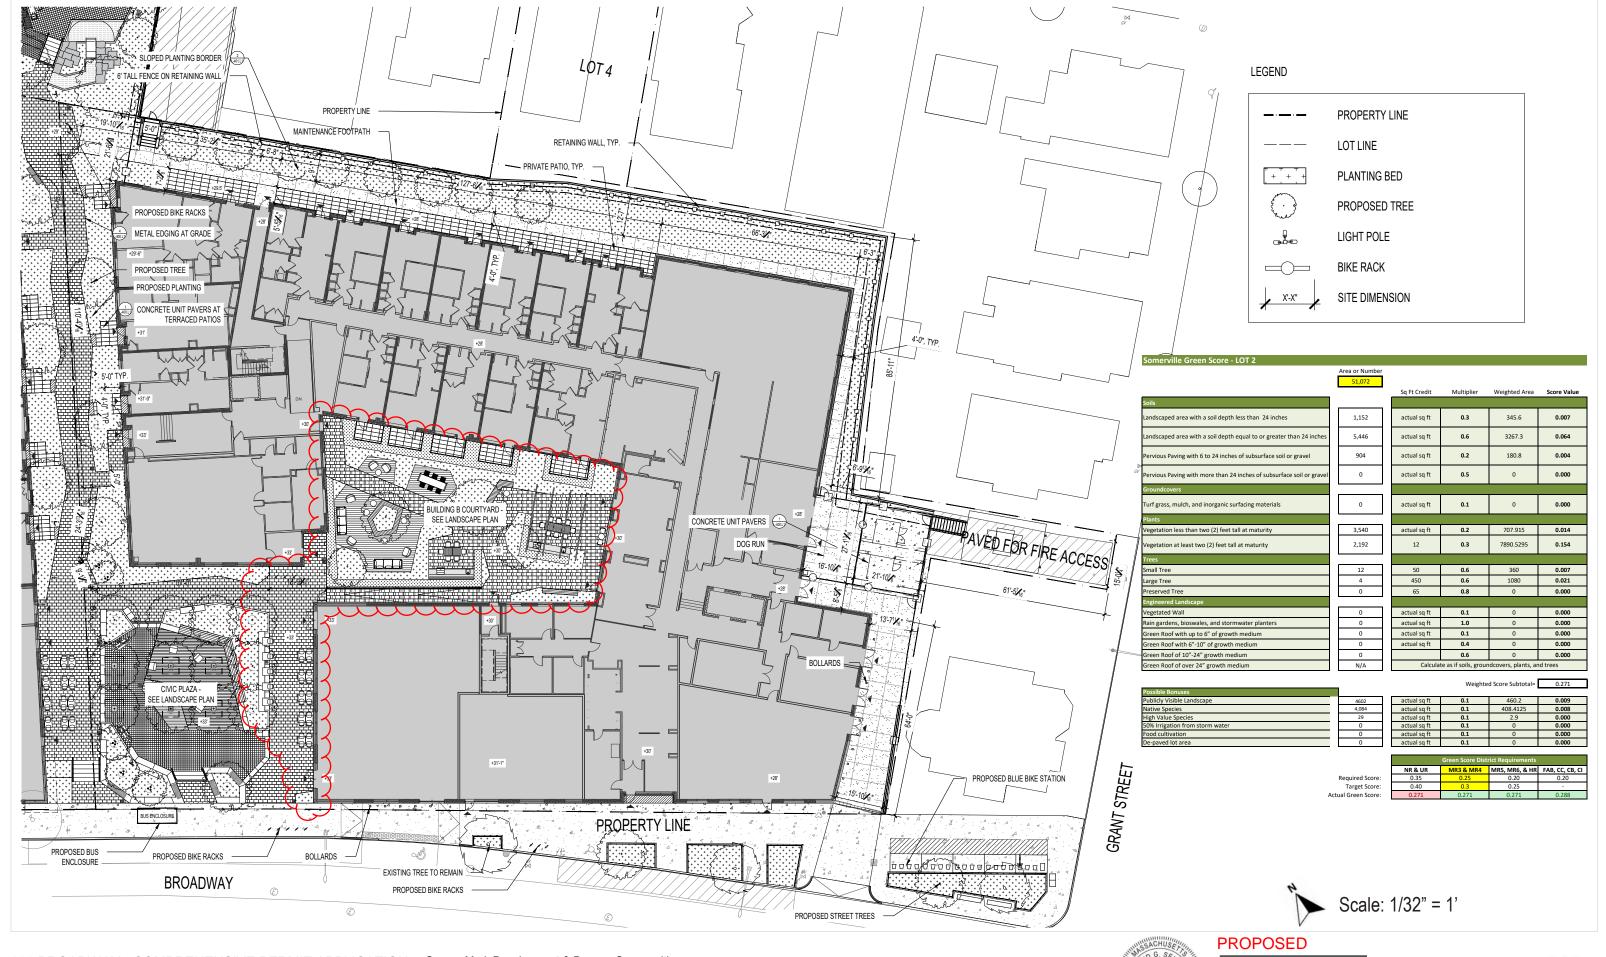

299 BROADWAY - COMPREHENSIVE PERMIT APPLICATION

P&Z 22-092 April 15, 2025 299 Broadway Somerville, MA, 02145 Owner: Mark Development & Beacon Communities
Architect: Utile
Landscape Architect: Future Green
Civil Engineer: Bohler
Traffic Engineer: VHB

L.001.B2 SITE PLAN

NOT FOR CONSTRUCTION







LOT LINE + + + PLANTING BED PROPOSED TREE

FURNITURE SCHEDULE

SYMB	ITEM	QTY
0	LOUNGE CHAIR	12
0	CAFE TABLE	4
\circ	GAS FIREPIT	1
	ADIRONDACK CHAIR	6


PAVING SCHEDULE


	TYPE	QTY
	BUFFER PLANTING	2088 SQ FT
A. 18 (18)	DECOMPOSED GRANITE PAVING	1966 SQ FT
	TIMBER DECKING	630 SQ FT

Scale: 1/16" = 1'





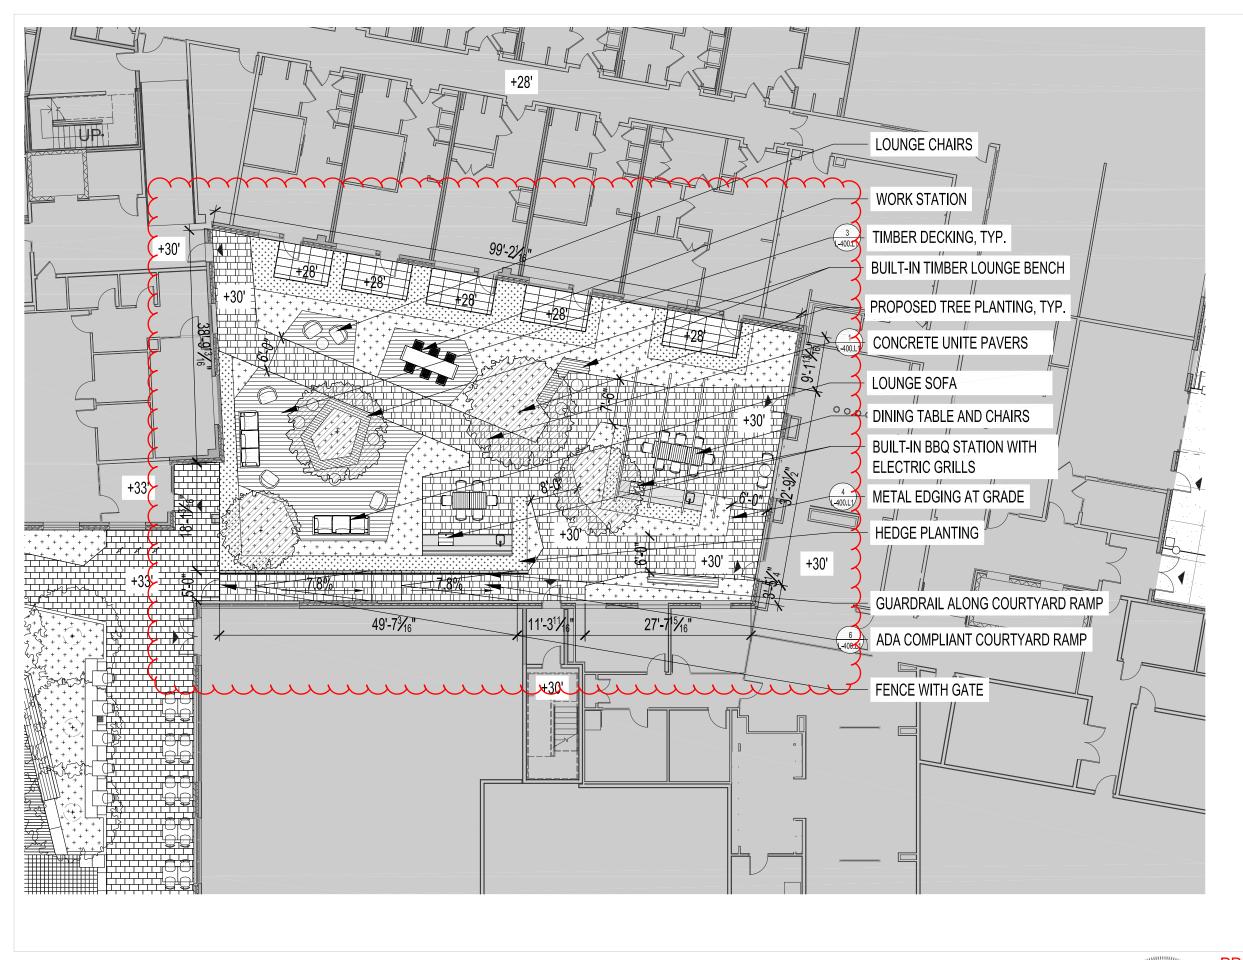

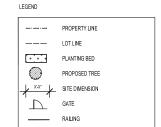

FURNITURE SCHEDULE

SYMB	ITEM	QTY
	LOUNGE SOFA	2
	BUILT-IN TIMBER LOUNGE BENCH	3
0	DINING CHAIR	16
	DINING TABLE	2
0	LOUNGE CHAIR	5
0	LOW TABLE	8
	BBQ STATION WITH ELECTRIC GRILL	2
	WORK STATION	1

PAVING SCHEDULE

TYPE	QTY
COURTYARD PLANTING	1146 SQ FT
HEDGE PLANTING	627 SQ FT
CONCRETE UNIT PAVERS	1954 SQ FT
TIMBER DECKING	716 SQ FT

1

Scale: 1/16" = 1'





