



- REVISED PLANS SCOPE
1. ADD 5TH GARAGE BAY DOOR FACING RIGHT SIDE.
 2. ADD PASSAGE DOOR FACING RIGHT SIDE.

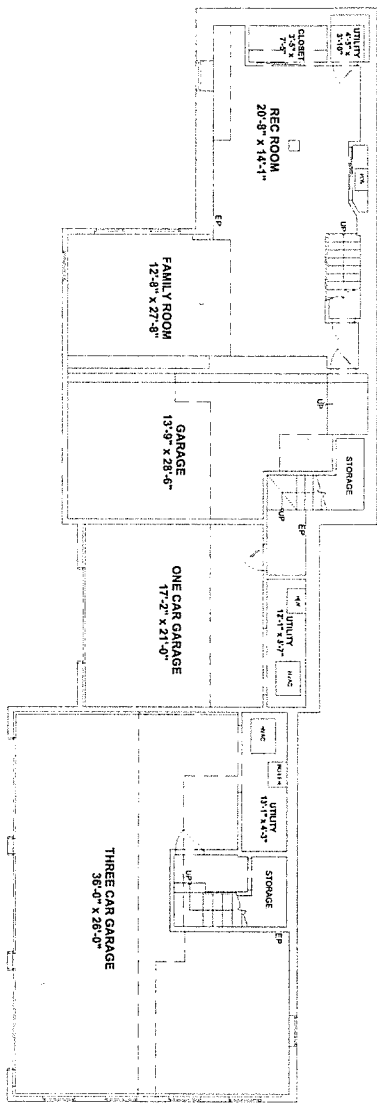

LOWER LEVEL PLAN - AS PERMITTED
Ceiling Height = 7'-7"

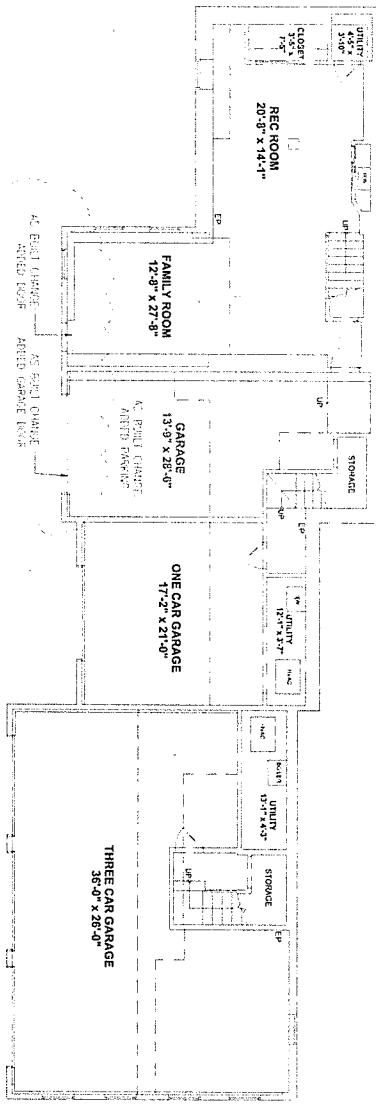

LOWER LEVEL PLAN - REVISED PLAN
Ceiling Height = 7'-7"

PROJECT:
New Dwelling Units
56 Franklin St
Somerville, MA 02143

GOD ARCHITECTS
200 WASHINGTON ST
SOMERVILLE, MA 02143
TEL: 617-424-1244
WWW.GODARCHITECTS.COM

Project Team

AS-BUILTS
ISSUED
FOR CHANGES
TO PERMIT
PLANS


Date Revisions

Date	Revisions


Drawing Title:
BASEMENT
PLANS

Scale: 1/4" = 1'-0"
Job No.: A131.00
Date: 29 APRIL 2025
Drawing No.: **A1.0**

REVISED PLANS SCOPE
 1. EXTEND PORCH ROOF OVER ENTRY PORCH

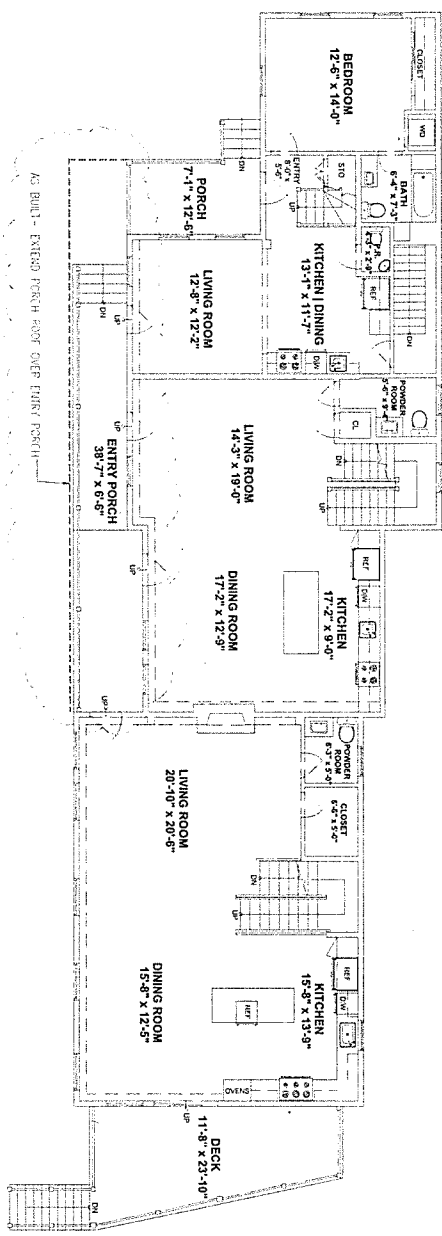

FIRST FLOOR - REVISED PLAN
 Ceiling Height = 8'-5"

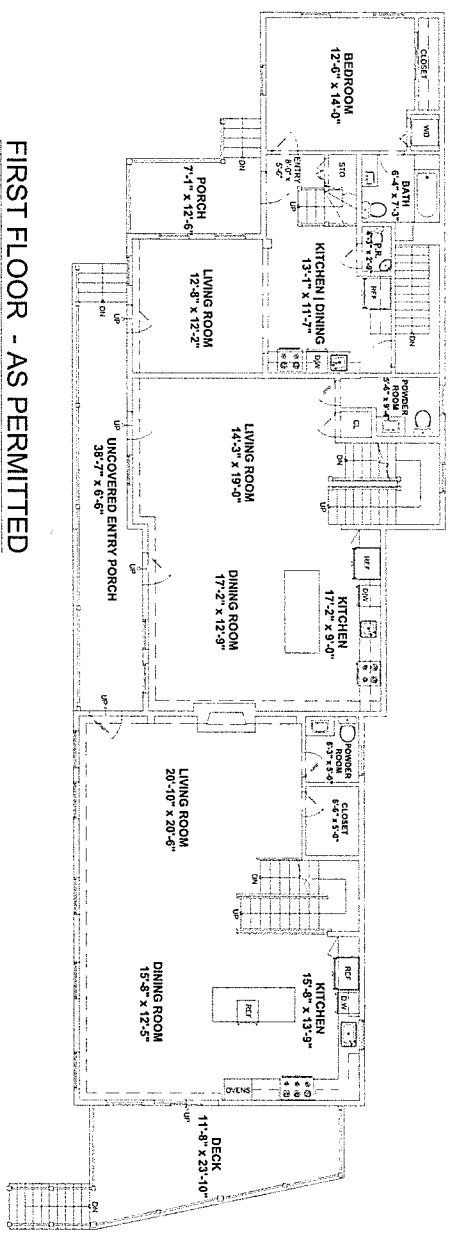

FIRST FLOOR - AS PERMITTED
 Ceiling Height = 8'-5"

PROJECT:
 New Dwelling Units
 56 Franklin St
 Somerville, MA 02143

GOD ARCHITECTS
 100118
 Cambridge, MA 02142
 god@godarchitects.com
 www.godarchitects.com

Project Team:


AS-BUILTS
 ISSUED
 FOR CHANGES
 TO PERMIT
 PLANS

Date:	Revisions:


Drawing Title
**FIRST FLOOR
 PLANS**

Scale: 1" = 1'-0"
 Job No.: A13100
 Date: 29 APRIL 2025
 Drawing No.: **A1.1**

REVISED PLANS SCOPE
 1. EXTEND PORCH ROOF OVER ENTRY PORCH

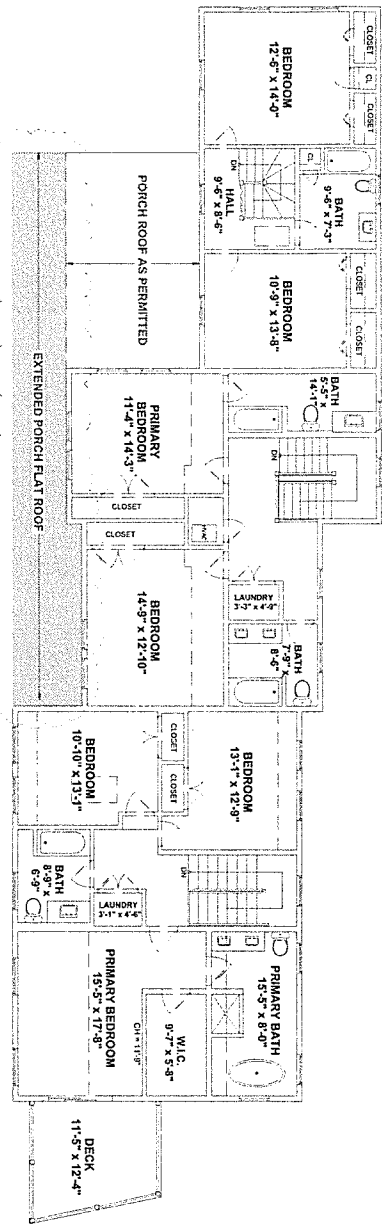

SECOND FLOOR - REVISED PLAN
 Ceiling Height = 7'-2"

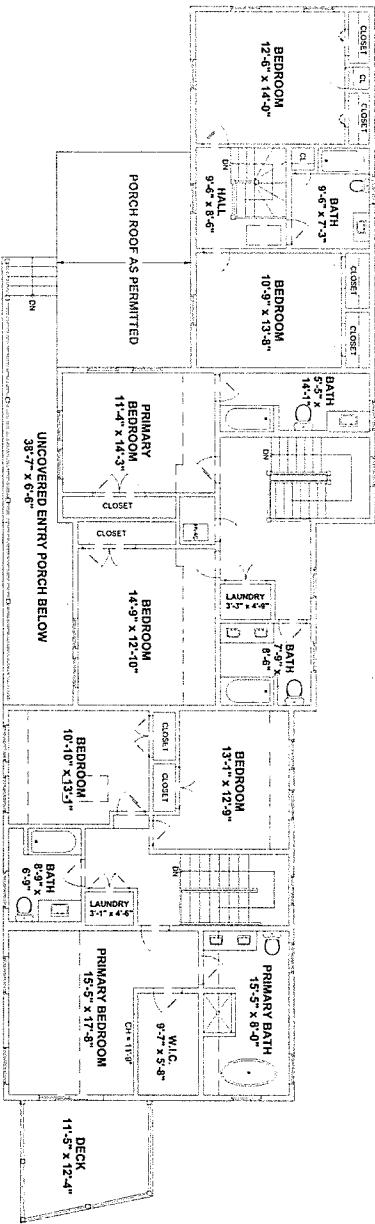

SECOND FLOOR - AS PERMITTED
 Ceiling Height = 7'-2"

PROJECT:
 New Dwelling Units
 56 Franklin St
 Somerville, MA 02143

GCD ARCHITECTS
 100 STATE ST
 10TH FLOOR
 BOSTON, MA 02109
 617.552.3333
 www.gcdarchitects.com

Project Team:

AS-BUILTS
 ISSUED
 FOR CHANGES
 TO PERMIT
 PLANS


Date: _____
 Revisions:

Date	Revisions


Drawing Title
 SECOND
 FLOOR PLANS

Scale: 1/8" = 1'-0"
 Job No.: A134.00
 Date: 29 APRIL 2025
 Drawing No.: A1.2

- REVISED PLANS SCOPE
1. ADD 5TH GARAGE BAY DOOR FACING RIGHT SIDE.
 2. ADD PASSAGE DOOR FACING RIGHT SIDE.
 3. EXTEND FRONT FACING FARMERS PORCH ROOF OVER UNCOVERED RIGHT SIDE PORCH ENTRY

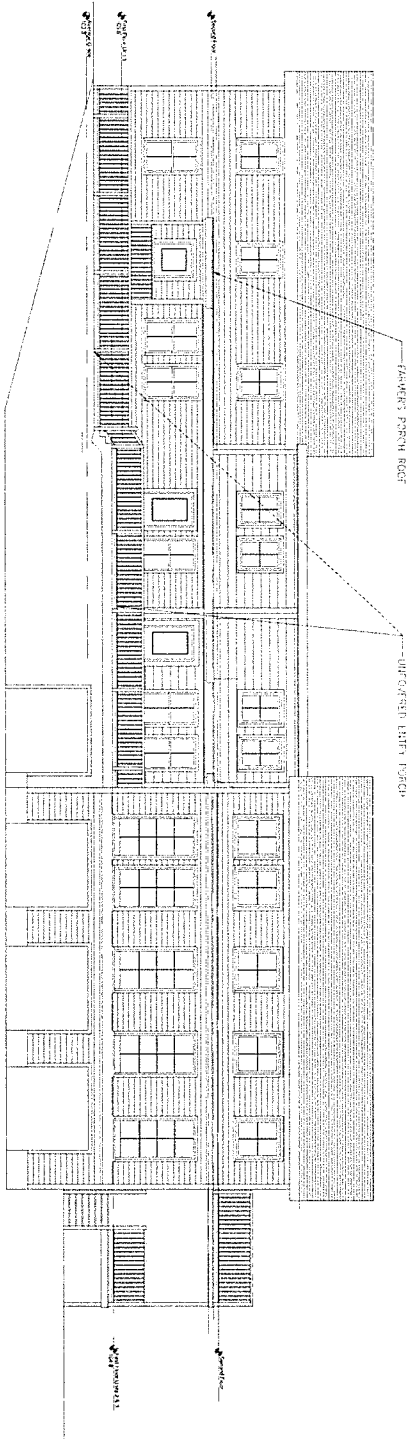

RIGHT SIDE ELEVATION - AS PERMITTED

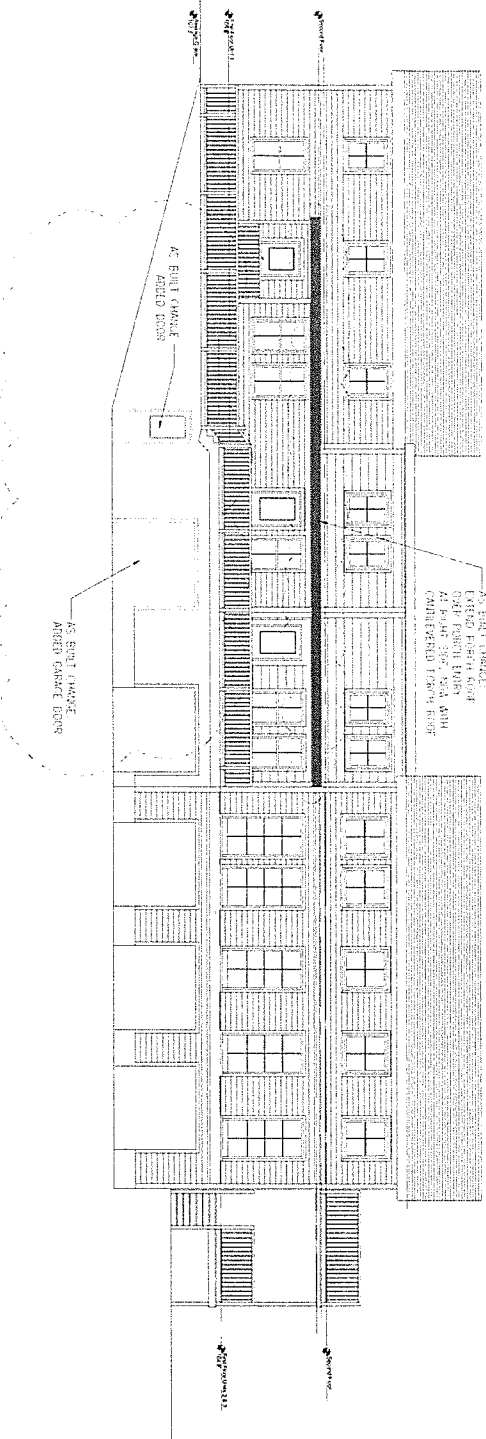

RIGHT SIDE ELEVATION - AS BUILT

PROJECT:
 New Dwelling Units
 56 Franklin St
 Somerville, MA 02143

GOD ARCHITECTS
 100 STATE STREET
 CAMBRIDGE, MA 02142
 617.452.1000
 www.godarchitects.com

Project Team

AS-BUILTS
 ISSUED
 FOR CHANGES
 TO PERMIT
 PLANS

Date: _____
 Revisions:

Drawing Title:
 RIGHT SIDE
 EXTERIOR
 ELEVATION

Scale: 1/4" = 1'-0"
 Job No: A134.00
 Date: 29 APRIL 2025
 Drawing No.: **A2.2**