
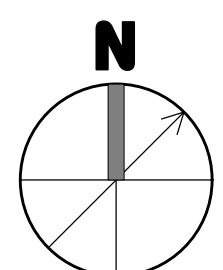


# Site Plot

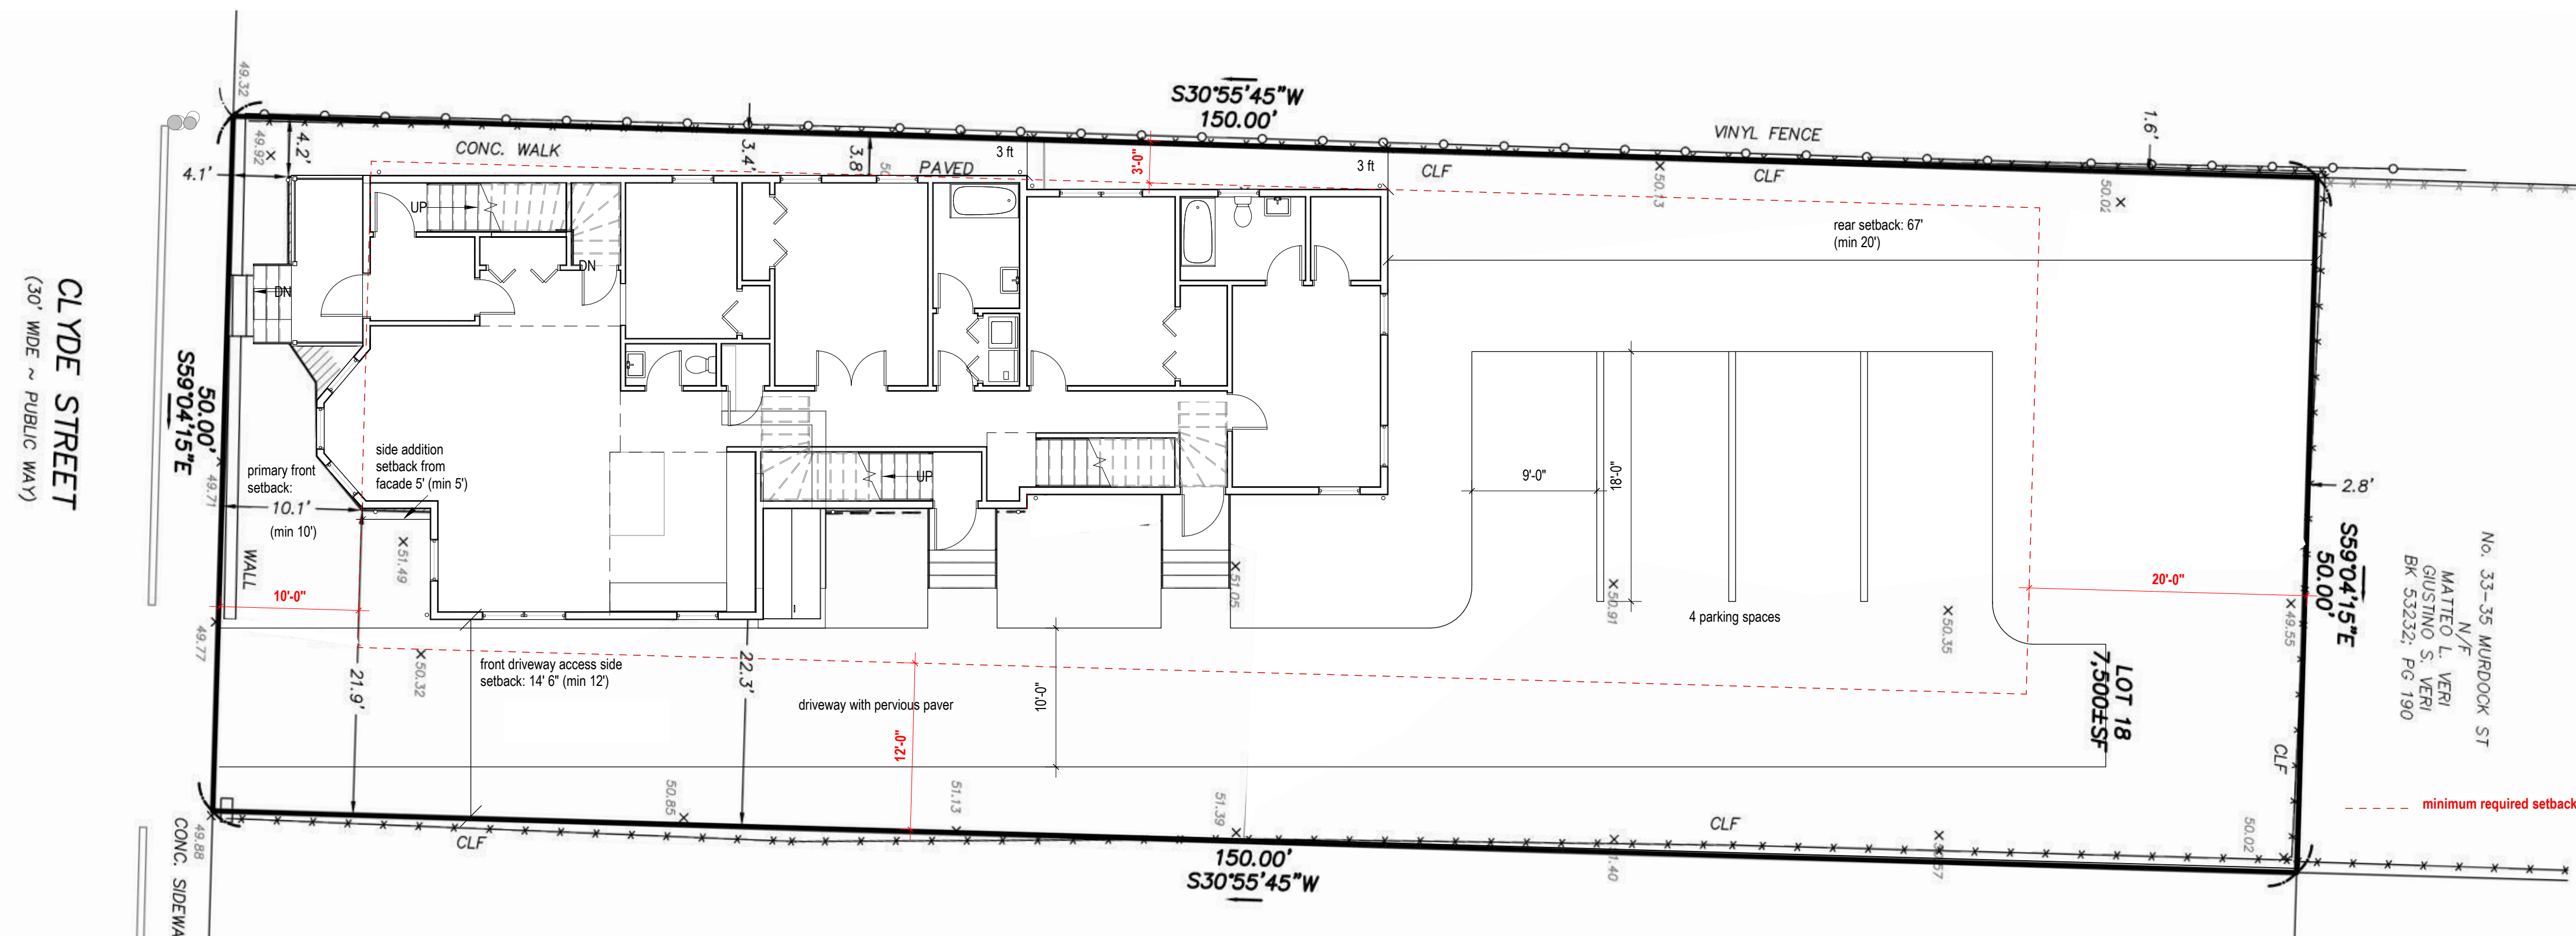

## For Permit

**WARNING:**  
Joe The Architect, Inc., all drawings and written material herein constitute the original and unpublished work of the architect, and the same may not be duplicated, used, or disclosed without the written consent of the architect. Contractors to use Architectural Drawings for set out. Contractors to check and verify all Dimensions on Site prior to Construction/Fabrication. Figure Dimensions take precedence over Scaled Dimensions. All inquiries should be immediately referred to the Architect. The project manager shall be notified in writing of any discrepancies prior to proceeding with the work. The scale of drawings may change when copied or faxed. All work to comply with I.B.C. Regulations and relevant American Standards.  
© 2019- all rights reserved

consultant / contractor information:

stamp:



revision	revision description	date

project title:  
CLYDE STREET RESIDENCE

26 Clyde Street  
Somerville, MA 02145


client information:  
Brian O. Lavelle

**J t A**  
JOE THE ARCHITECT

343 Medford Street, Suite 4C Somerville, MA 02145  
t: +1(617) 764-3593 e: askjoe@joethearchitect.com  
www.joethearchitect.com

drawing title  
**SITE CONTEXT**


project number <b>324</b>	drawing scale <b>1/8" = 1'-0"</b>	approver <b>Approver</b>
drawing number <b>A001</b>		revision

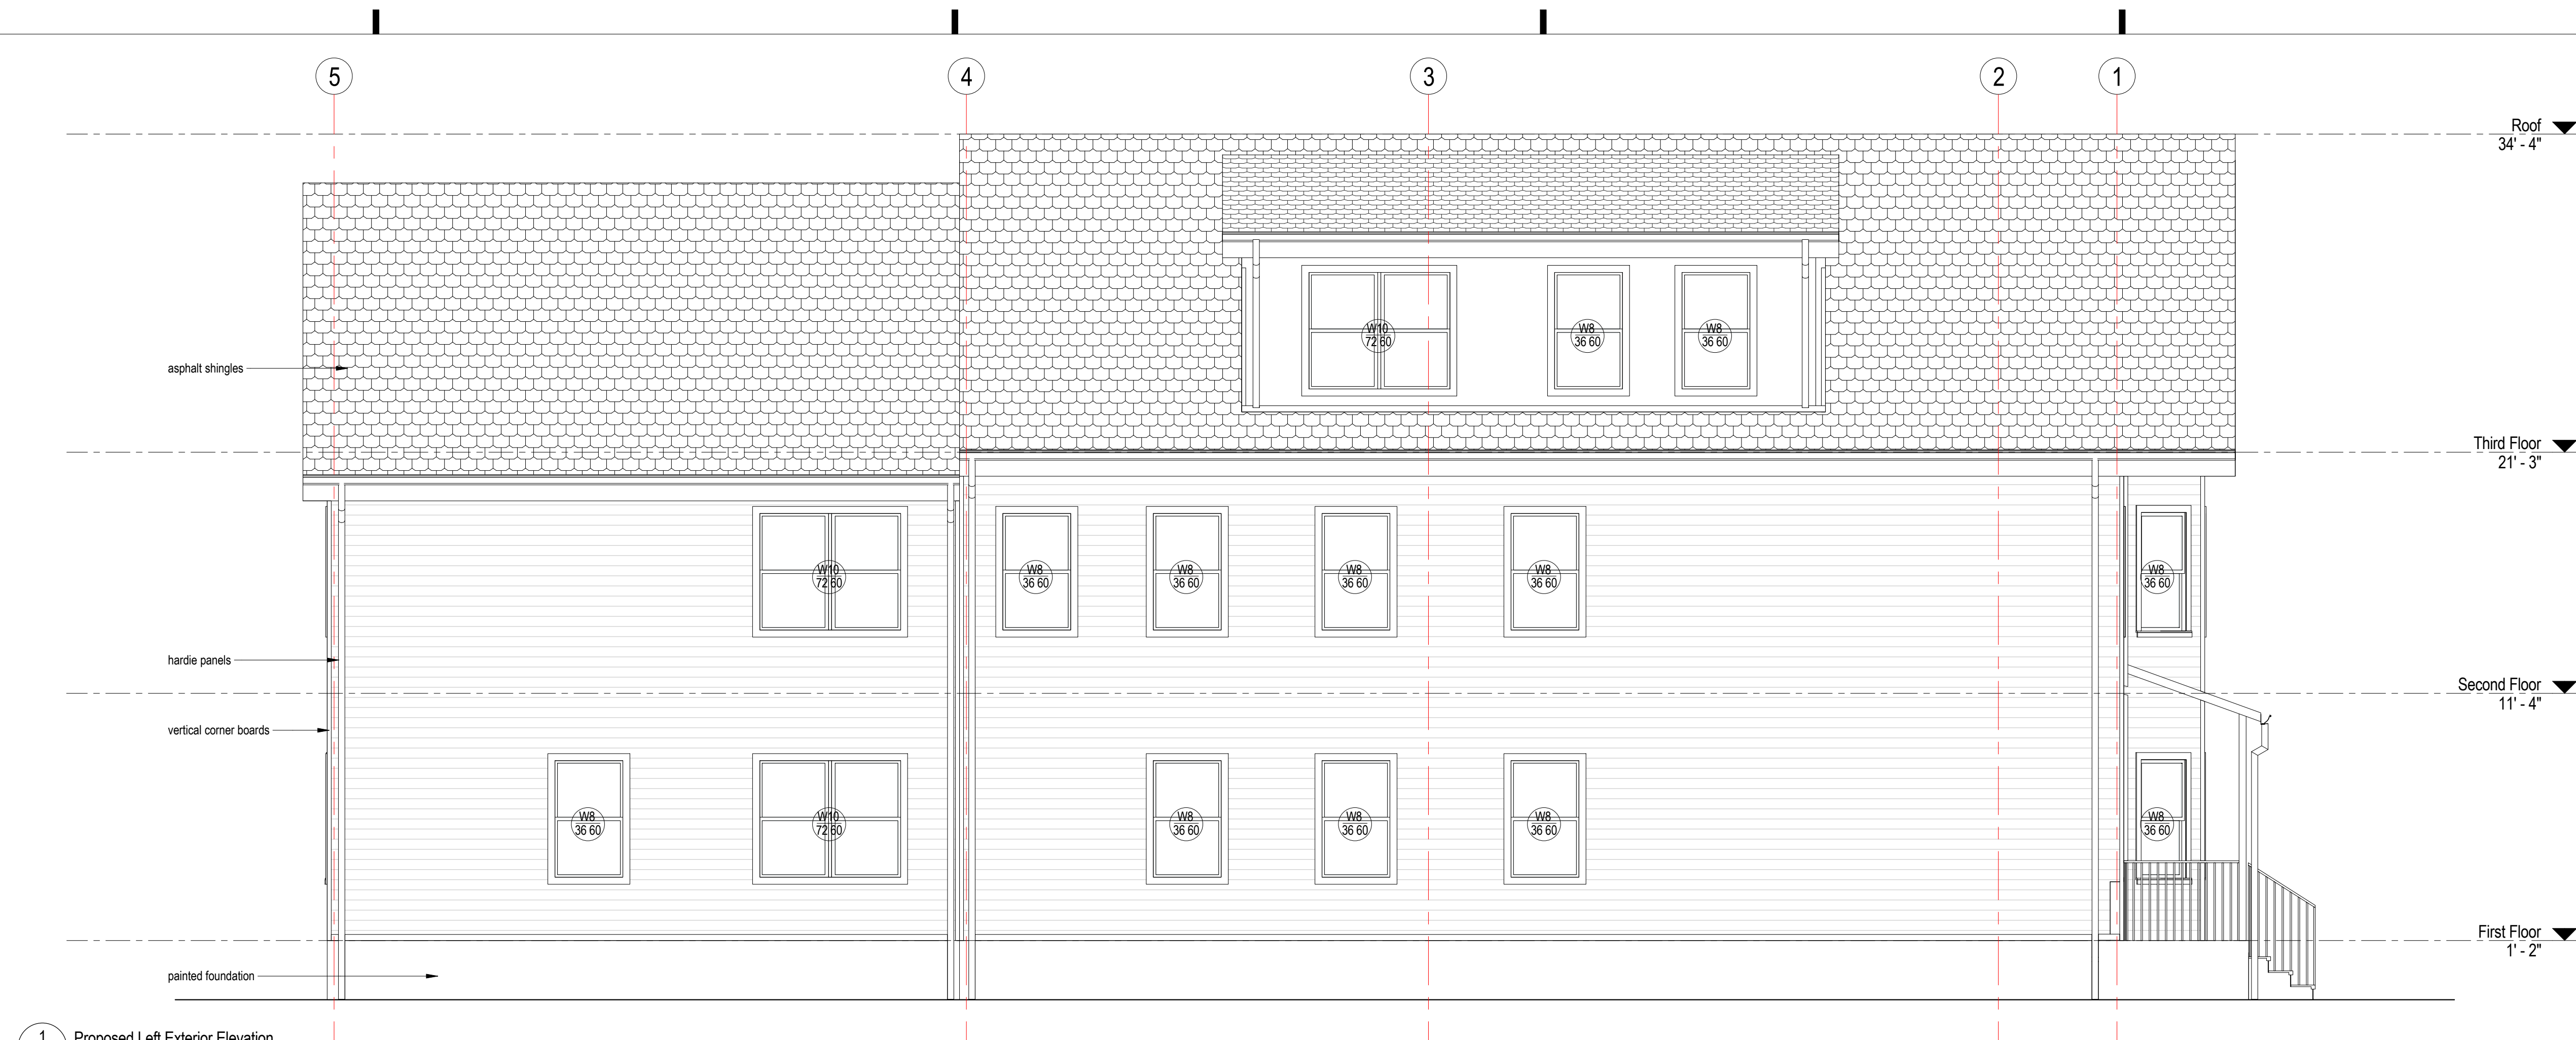

Dormer Windows as constructed

12 ft of windows across 24 ft. of dormer face

Requires 9 ft. of relief from SZO 3.I.i.A

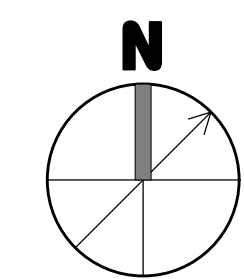

For Permit

WARNING:  
Joe The Architect, Inc., all drawings and written material herein constitute the original and unpublished work of the architect, and the same may not be duplicated, used, or disclosed without the written consent of the architect. Contractors to use Architectural drawings for set out. Contractors to check and verify all Dimensions on Site prior to Construction/Fabrication. Figure Dimensions take precedence over Scaled Dimensions. Any discrepancies should be immediately referred to the Architect. The project manager shall be notified in writing of any discrepancies prior to proceeding with the work. The scale of drawings may change when copied or faxed. All work to comply with I.B.C. Regulations and relevant American Standards.  
© 2019 - all rights reserved

consultant / contractor information:

stamp:

revision	revision description	date

project title:

CLYDE STREET RESIDENCE

26 Clyde Street  
Somerville, MA 02145

client information:  
Brian O. Lavelle

J t A


JOE THE ARCHITECT

343 Medford Street, Suite 4C Somerville, MA 02145  
t: +1(617) 764-3593 e: askjoe@joethearchitect.com  
www.joethearchitect.com

drawing title


LEFT EXTERIOR  
ELEVATION

project number 324	drawing scale 1/4" = 1'-0"	approver Approver
drawing number A202	revision	

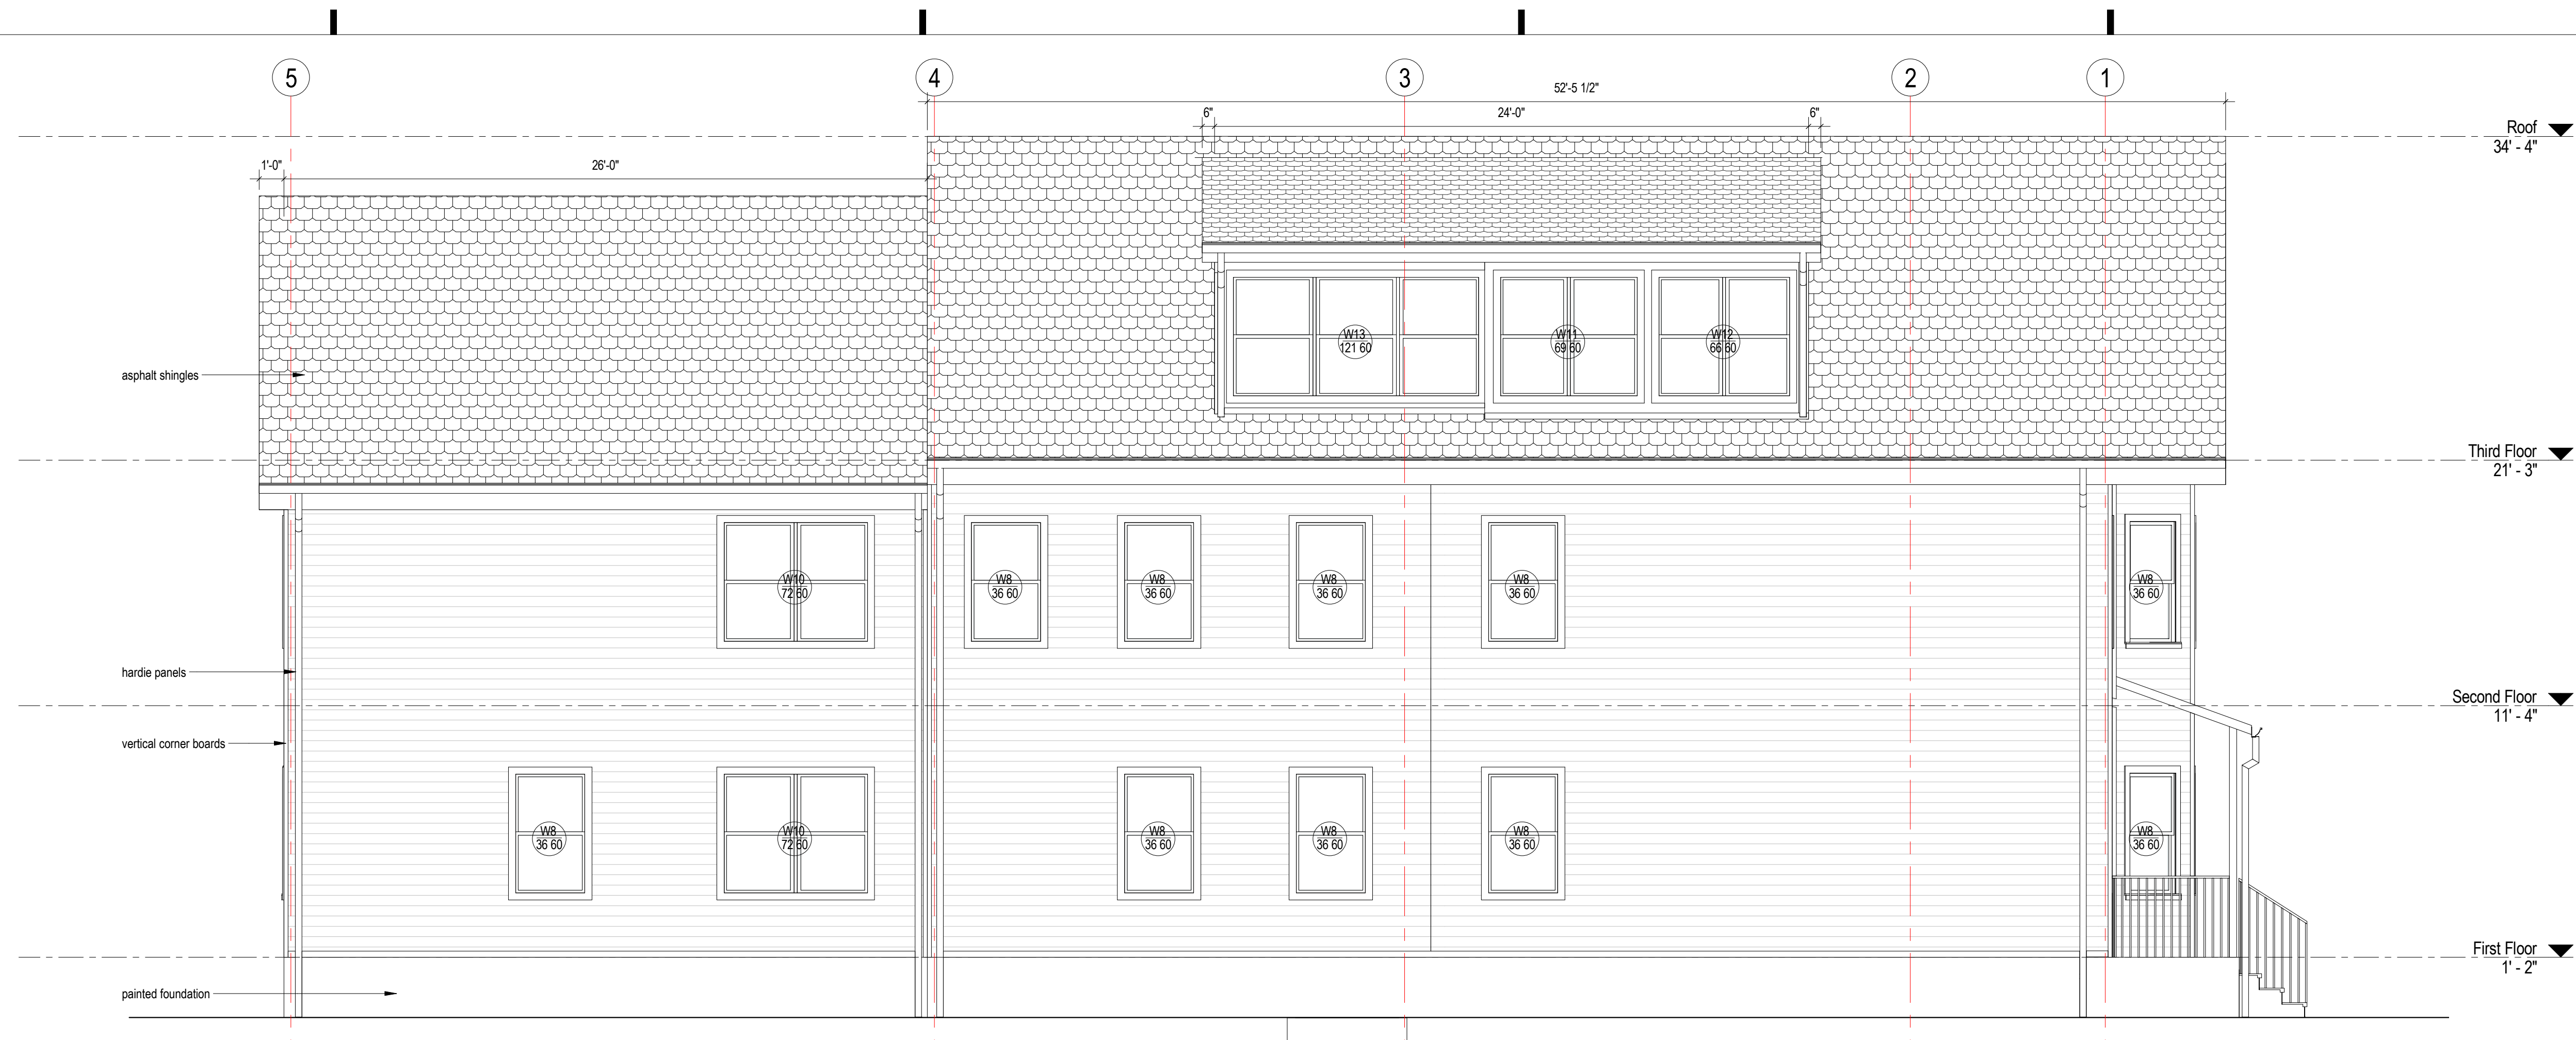

Dormer Windows as Zoning Conforming:

21 ft. of windows across 24 ft. dormer face  
Complies with SZO SZO 3.I.i.A

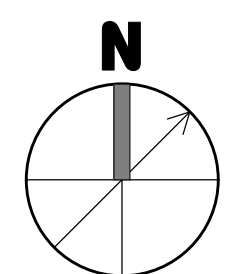

### For Permit

**WARNING:**  
Joe The Architect, Inc., all drawings and written material herein constitute the original and unpublished work of the architect, and the same may not be duplicated, used, or disclosed without the written consent of the architect. Contractors to use Architectural drawings for set out. Contractors to check and verify all Dimensions on Site prior to Construction/Fabrication. Figure Dimensions take precedence over Scaled Dimensions. Any discrepancies should be immediately referred to the Architect. The project manager shall be notified in writing of any discrepancies prior to proceeding with the work. The scale of drawings may change when copied or faxed. All work to comply with I.B.C. Regulations and relevant American Standards.  
© 2019 - all rights reserved.

consultant / contractor information:

stamp:



revision	revision description	date

project title:  
CLYDE STREET RESIDENCE

26 Clyde Street  
Somerville, MA 02145

client information:  
Brian O. Lavelle

**J t A**  
**JOE THE ARCHITECT**  
343 Medford Street, Suite 4C Somerville, MA 02145  
t: +1(617) 764-3593 e: askjoe@joethearchitect.com  
www.joethearchitect.com

drawing title  
**LEFT EXTERIOR  
ELEVATION**

project number 324	drawing scale 1/4" = 1'-0"	approver Approver
drawing number A202	revision	