
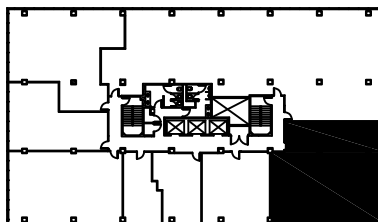


WESTBEND I

1701 River Run, Fort Worth, Texas

SUITE 407
2,204 RSF

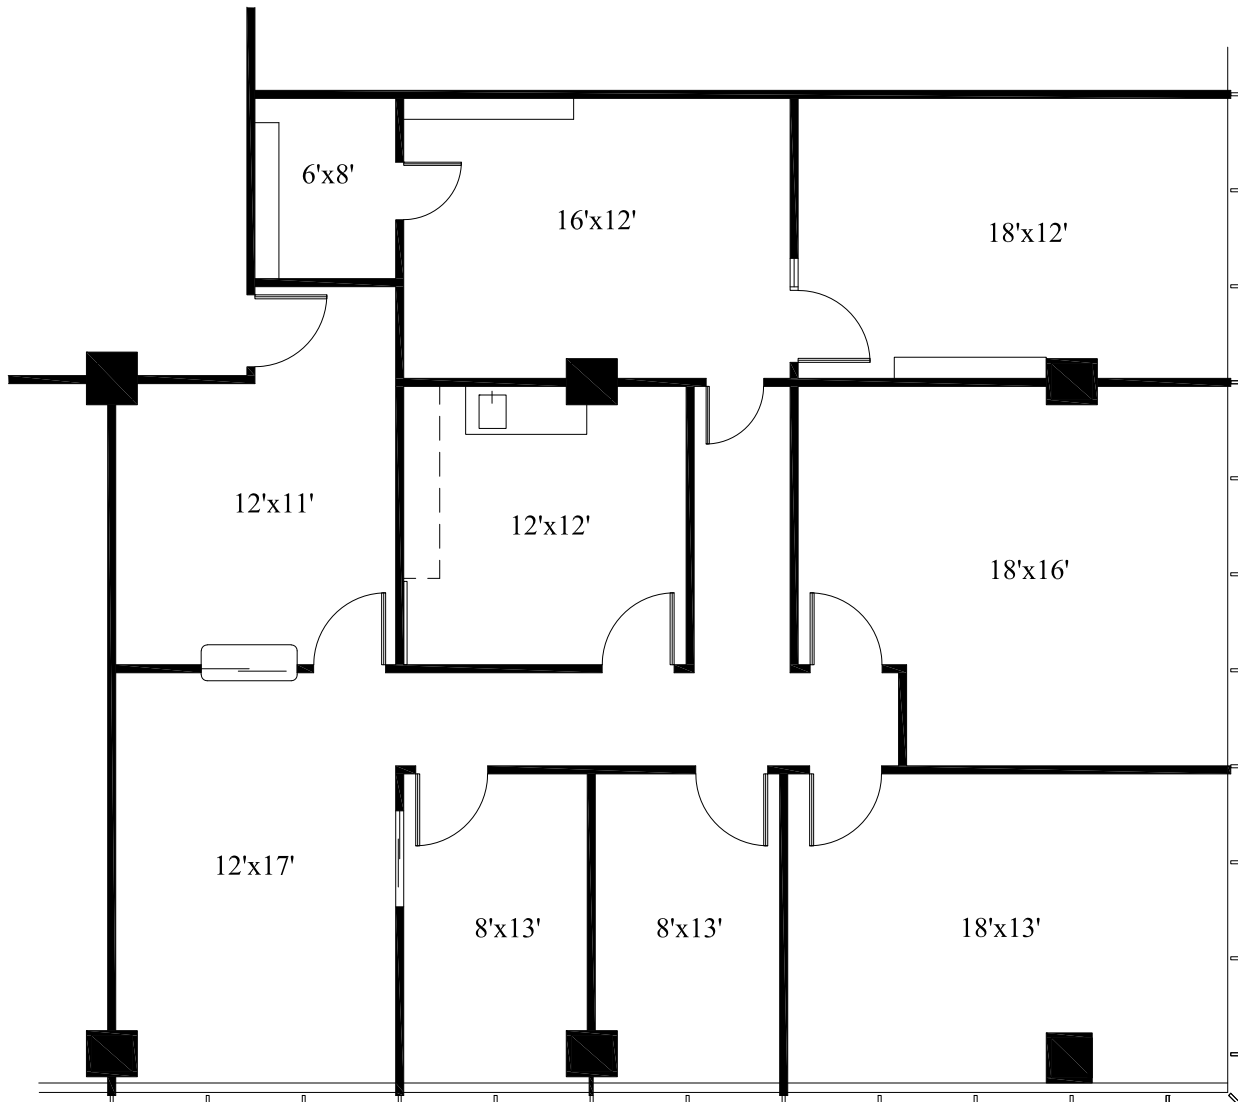

4TH FLOOR

Scale: 1/8"=1'-0"

All dimensions and square footages are approximate.

January 3, 2025



THOMPSON CONSULTING SERVICES, INC. 5728 LBJ Freeway, Suite 460, Dallas, Texas 75240 (972)934-2600