
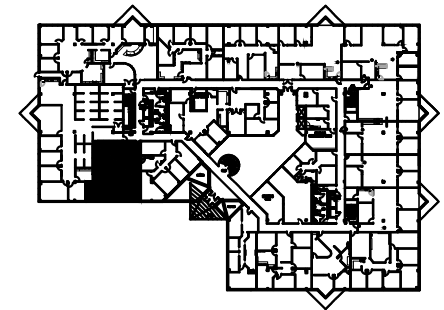


FOR LEASING INFO CONTACT:

Chris Lipscomb
214.237.5022
chris.lipscomb@transwestern.com

Laney Underwood
214.237.5020
laney.underwood@transwestern.com

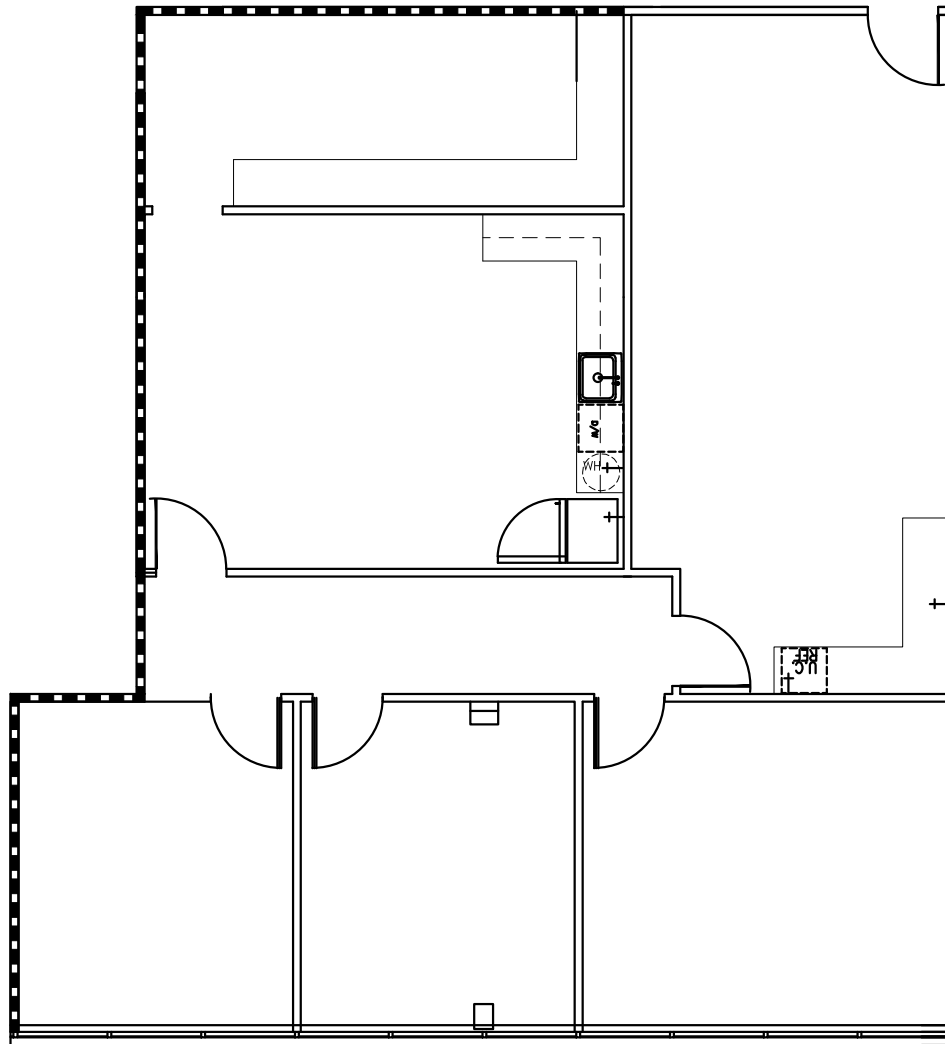

HILLCREST OAKS PLAZA IV

6600 LBJ FREEWAY DALLAS, TX

FLOOR: 1st
SUITE: 160
RSF: 1,909
DATE: 09.04.15

ENTOS
design