


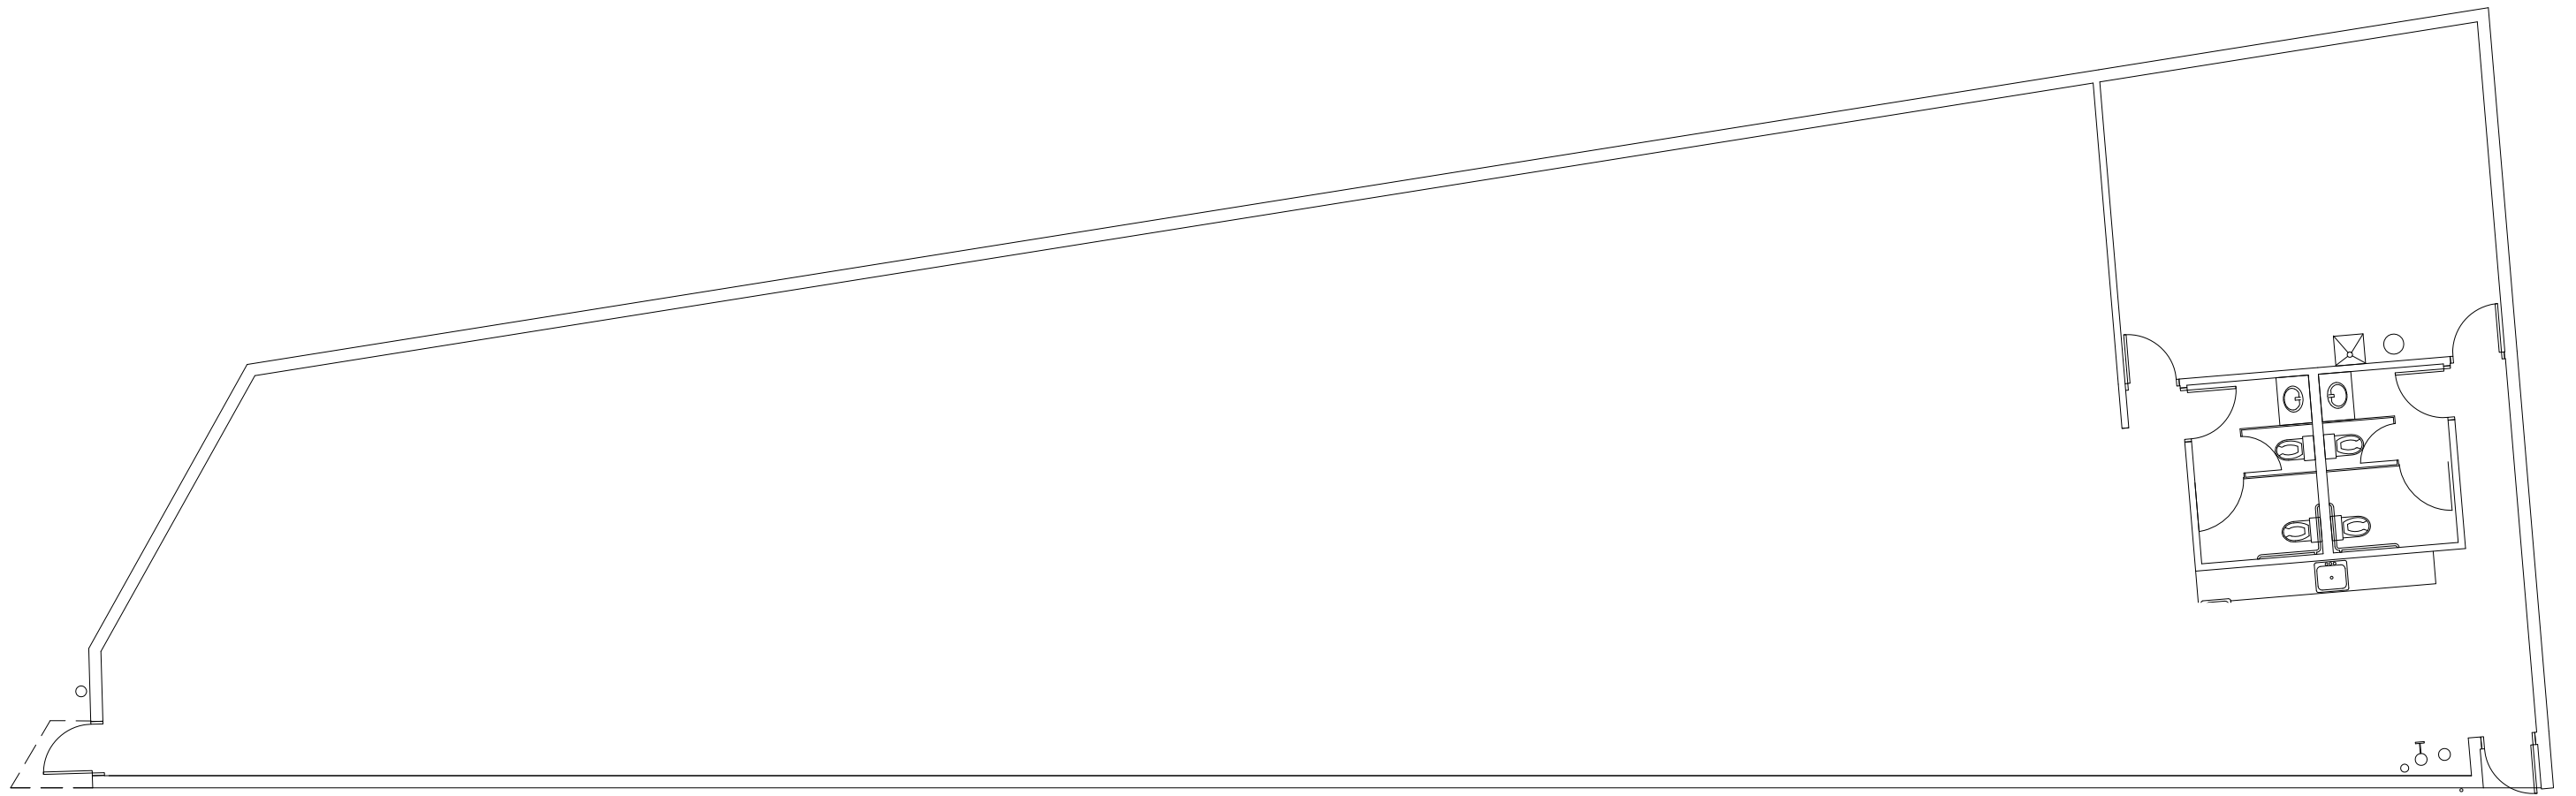

Scale: 3/32" = 1'-0"

