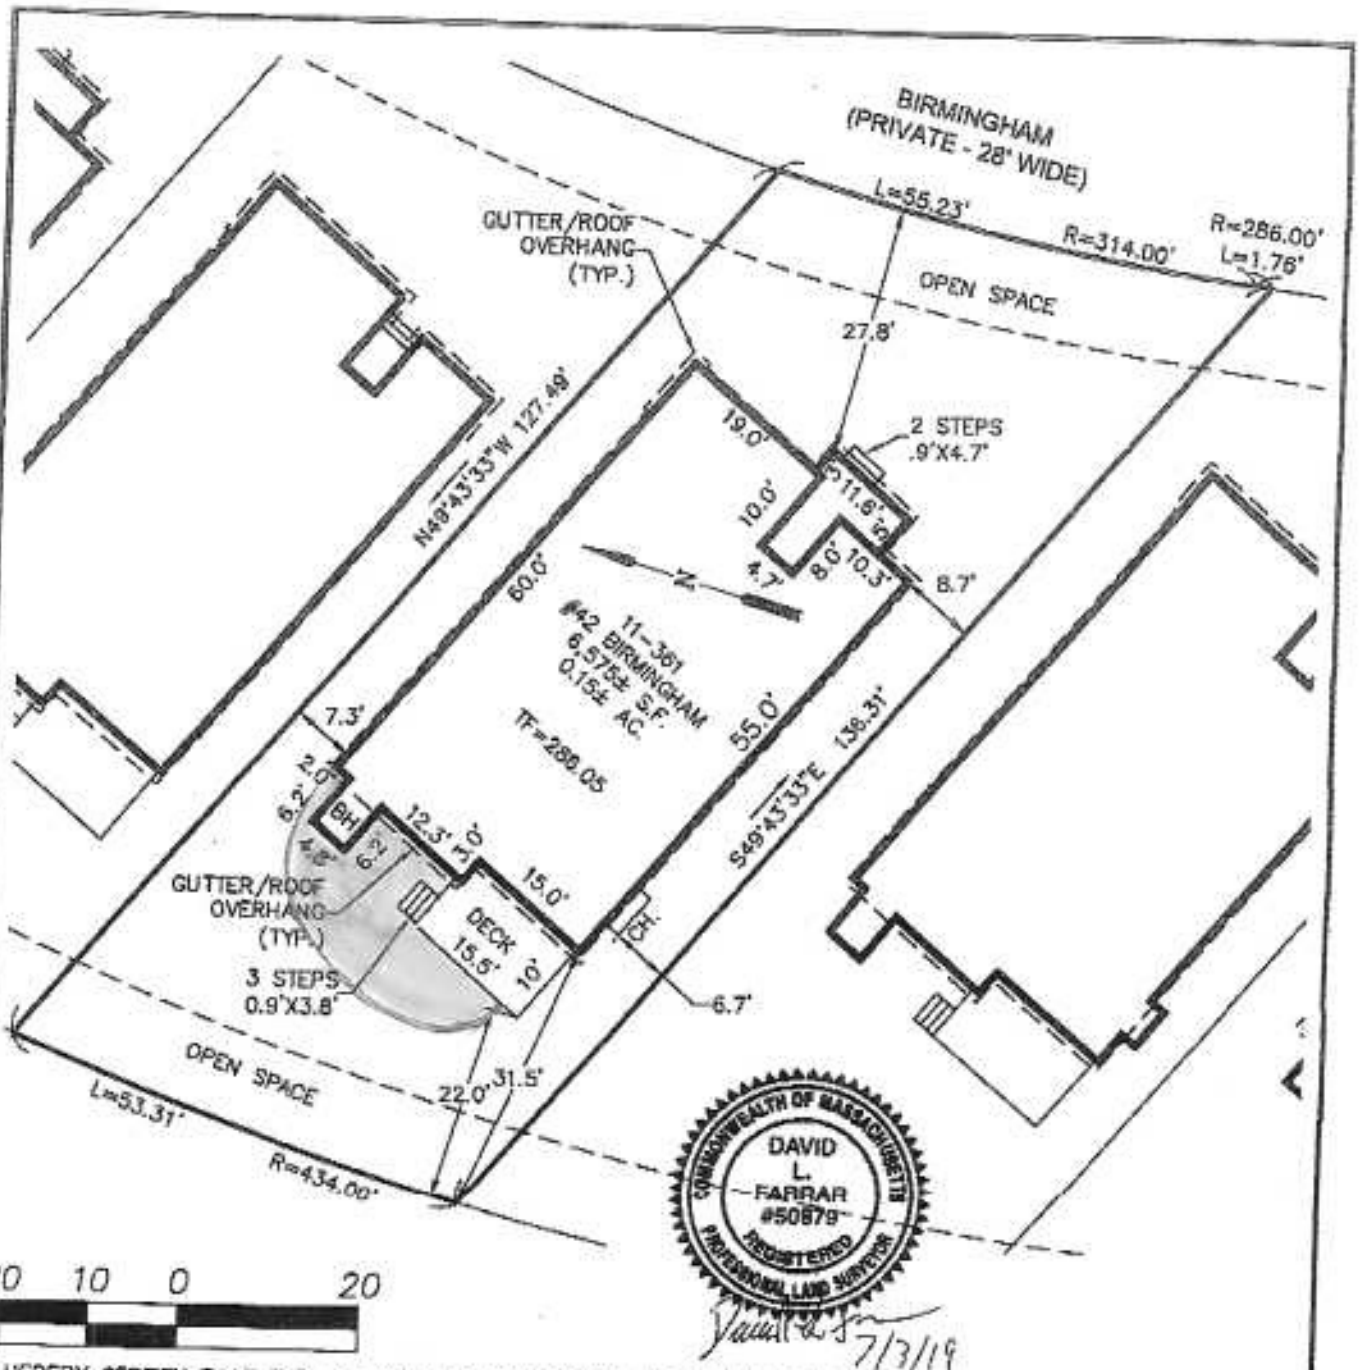


"I HEREBY CERTIFY THAT THE LOT CORNERS, DIMENSIONS, ELEVATIONS, AND SETBACKS TO THE EXISTING BUILDING OR STRUCTURE, INCLUDING ANY OUTSIDE PROTRUSION, SUCH AS DECKS, STEPS, BULKHEAD, OVERHANG, CHIMNEY, ETC., AS WELL AS THE FOUNDATION AS SHOWN ON THIS PLAN ARE CORRECT AND CONFORMING TO THE TOWN OF PLYMOUTH BY-LAWS AND REGULATIONS FOR OSMUD OVERLAY ZONING DISTRICT."

AS-BUILT PLAN

LOT 078B-000-011-361 #42 BIRMINGHAM
PLYMOUTH, MASSACHUSETTS

PREPARED FOR

PULTE HOMES OF NEW ENGLAND, LLC

115 FLANDERS ROAD
WESTBORO, MASSACHUSETTS 01581

MARCHIONDA & ASSOCIATES, LP

ENGINEERING AND PLANNING CONSULTANTS

62 MONTVALE AVE. SUITE I
STONEHAM, MA. 02180
(781) 438-6121

SCALE: 1"=20'

DATE: 7/3/19


73-75-6-0788720
File No. sf

SKETCH ADDENDUM

Borrower or Owner: Stanley Saulny
Property Address: 42 Birmingham
City: Plymouth County: Plymouth State: MA Zip Code: 02360-3641
Client: Pulic Mortgage LLC/VA

Chablis


1st Floor

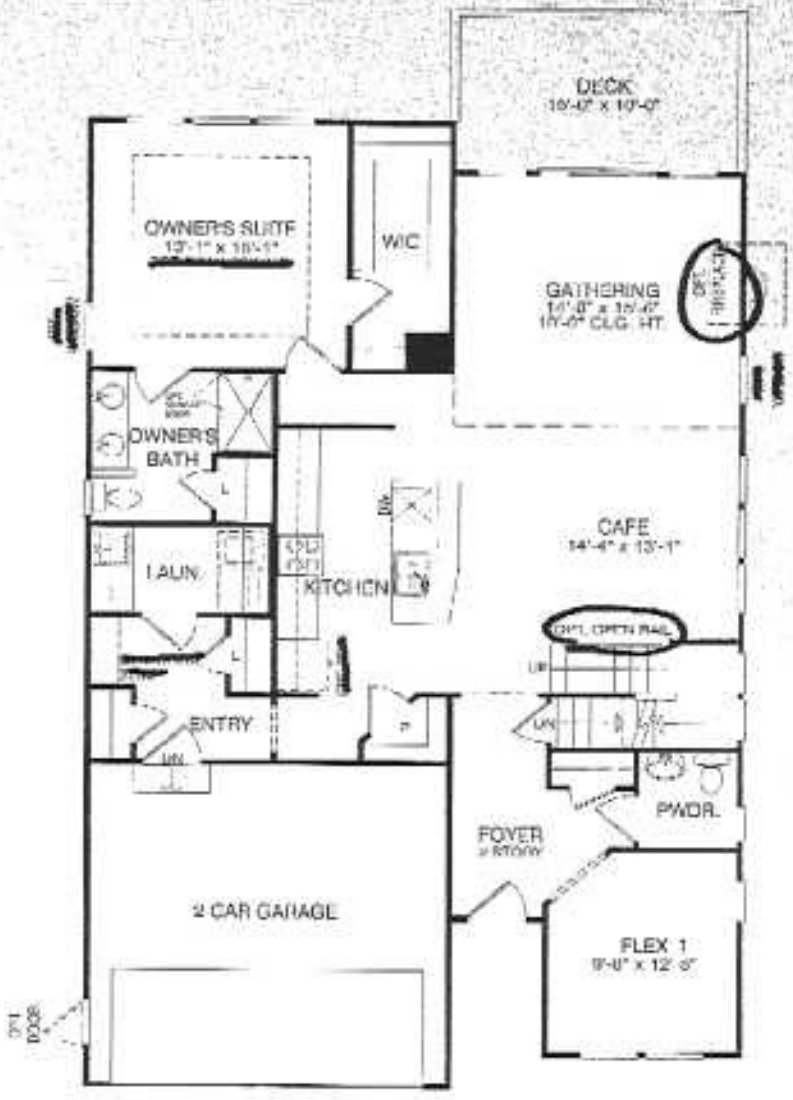

Note:Dotted lines indicate options that must be purchased separately.

Chablis

1st Floor

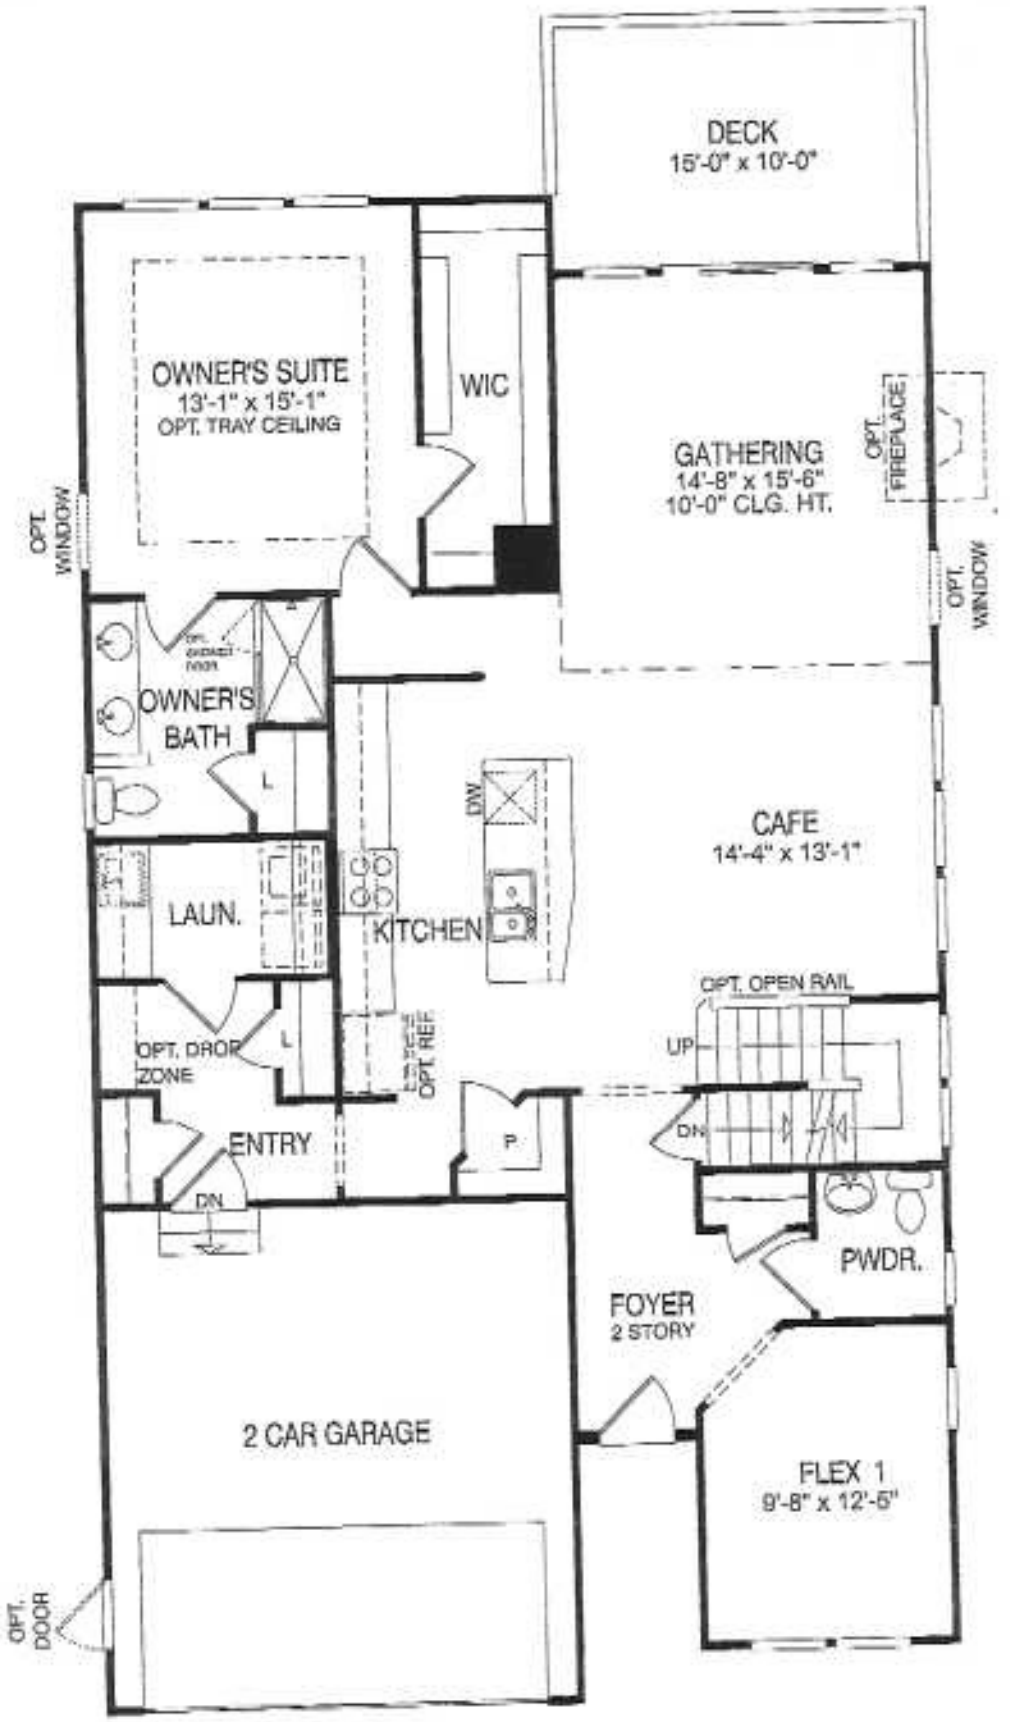

Note:Dotted lines indicate options that must be purchased separately.