



Herb.

KMR.CDD.M/Q.1917.01(1-3)(g)

6-1

97



4-2

(200-24-2-17.)

Form No. 2.

ORDERS UNDER SECTION 96 (2) OF ACT, III OF 1901.

No. E/ 4766 OF 1917

MUNICIPAL ENGINEER'S OFFICE,

Karachi, 26th May 1917
31st

MEMO:

With reference to his application, dated 10th April 1917.
 Messrs Ralli Brothers is informed
 that the plan submitted by him for building a shed
 on plot No. 4, Survey Sheet BK
 situate in Wood Street, Railway
 Quarter, is approved, and permission to build in accordance therewith is
 granted. The building to be erected subject to the Bye-laws and Rules of the
 Municipality.

J. G. L. Verley

A. M. INST. C. E.,

Engineer,

Karachi Municipality.

NOTICE 1.—This pass does not give permission to occupy Municipal land with building materials. This can only be allowed when the street is wide enough to permit building materials being deposited on it without it being a source of danger to the public, and only then on a boarding being placed round the land to be occupied, and on payment, in advance of fees for occupation of Municipal land, at the following rates:—

	Rs.	A.	P.
(1) For the first three months, per square yard, per diem	...	0	0 1/4
(2) For the next three months " " "	...	0	0 1
(3) For any subsequent time " " "	...	0	0 2

NOTICE 2.—Windows, steps and doors of the building will not be permitted to project on or overhang any public street or Municipal land.

NOTICE 3.—Plinths will not be allowed to project more than 2" on any public street for ornamental purposes.

4767 Copy to the Building Inspector
 4768 Inspector the No.

PROPERTIES.

4-3

*Handwritten notes: "P. 1. 11/11/17" and "2. 11/11/17" with a signature "G. C. D." and "Verby".*

KARACHI, 25th. May 1917.

KARACHI.

Dear Sir,

With reference to your letter No.E.4171/16th. May, we beg
17th.
to give you below copy of a letter we have received from the City
Deputy Collector re shed on plot No.4, B-2, Railway Quarter, and
await your sanction to proceed with the work.

We are, Dear Sir,

Yours faithfully,

per pro. Ralli Brothers,

*Handwritten signature: "Theoratorail"**Handwritten initials: "L. 11/11/17" and "M. 2. A."*COPY OF LETTER NO.4942/24th. MAY.

With reference to your letter dated 18th. May 1917, request-
ing permission to build a shed on plot No.4 Sheet B-2, Railway
Quarter in accordance with the plan approved by the Engineer Karachi
Municipality, I have the honor to inform you that the above plot
is under the control of the Karachi Municipality whose permission
is necessary before commencing the work.

2) The plans are therefore returned.



No: 4942 of 1917.

Revenue Department,
City Deputy Collector's Office,
Karachi, 24th May 1917.

From,

F. E. Cumming, Esquire,
City Deputy Collector, Karachi.

To,

Messrs: Ralli Brother,
Karachi.

Gentlemen,

With reference to your letter dated 18th May 1917, requesting permission to build a shed on a plot No: 4 Sheet B-2, Railway Quarter in accordance with the plan approved by the Engineer Karachi Municipality, I have the honour to inform you that the above plot is under the control of the Karachi Municipality whose permission is necessary before commencing the work.

2/ The plans are therefore returned.

I have the honour to be,
Sir,

Your most obedient servant,

Sd/ F. E. Cumming,

City Deputy Collector, Karachi.

No: 4943 of 1917.

Revenue Department,
City Deputy Collector's Office,
Karachi, May 1917.

Copy forwarded for information to the Engineer Karachi Municipality with reference to his endorsement No: 7/4172 dated 16/17th May 1917.

F. E. Cumming



2/1 for report to the Engineer Karachi Municipality



5494

4-4-2

Enquiry office for
early Compliance.

Nathaniel

26
317



G-5

12th May 1917

Memo

Messrs. Rathi Bros.
Karachi.

Sir

Referring to your letter of 4th May 1917
with a set of amended plan. Please
the honor to inform you that the
3'-0" opening to the work will be done
as stated in this spec. no. E 34549
26 April is essential & must be provided
27. ~~The plan as returned herewith for a second~~
~~accordance~~ as shown in the plan.

A.M.Inst., C.E.,
Engineer

Karachi Municipality

Transmitted
If there is no
objection to the
plan it should be
re-stated &
copies approved
returned V.

Mr. Merchant please see his
copies as the plan has been approved.

Nathaniel

15
5 17



G-6-1


K A R A C H I, 4th. May 1917.

The Engineer,

Karachi Municipality,

K A R A C H I.

Dear Sir,

With reference to your letter No. E3454/26th. April we beg to return herewith the 5 drawings for building a shed on plot No. 4, B-2, Railway Quarter, duly amended as required.

Considering that the shed will be entirely opened in front we should be obliged if you would let us know whether the windows to the North side of it referred to in your above letter, will still be required.

We are, Dear Sir,

Yours faithfully,

per pro. Ralli Brothers,

Handwritten signatures and notes:
 1/5
 2
 1/7/17
 1/7/17



Mr. Goodrich and what is
the drawings referred to.

Nathan

5/5



The Engineer,

Karachi Municipality,

KARACHI.

Sir,

FC attached and

beg to report that the

3' feet lane has been

left. but they want

to know whether it is

essential of leaving

the lane. Request for

order. Now no objection

to the plan approved.

Yours obedt

Nathan

Yes! 3'-5" opening for
ventilation is
essential.

11/5/17



G-7

No. E 3454 of 1917.

Municipal Office.

Karachi. 26th April 1917.

27th

From

The Engineer,
Karachi Municipality.

To,

Messrs Ralli Brothers,
Karachi.

Gentlemen,

With reference to your letter dated 19th instant regarding building on plot No. 4, B-2 Railway Quarter I have the honour to inform you that the open space to the North should not be less than 3'-0" wide. The shed should have windows to the North.

I herewith return the plans for amendment.

I have the honour to be

Sir,

Your most obedient servant

A. M. Inst. C. E.,

Engineer

Karachi Municipality.

k

PROPERTIES.

G-8

NALLI BROTHERS

— F.O. BOXES —

TELEGRAM ADDRESS: NALLI, KARACHI

MR. L. E. NALLI, BART.
ANTHONY A. VLASTO.

KARACHI, 19th April 1917.



The Chief Officer & Chief Engineer,

Karachi Municipality,

KARACHI.

Dear Sir,





With reference to our application d/- 9th. instant for permission to erect a godown on plot No.4-B2, Railway Quarter, we shall feel obliged if you will let us know when we may expect to receive the necessary sanction as we wish to proceed with the work at once.

We are, Dear Sir,

Yours faithfully,

per pro. Nalli Brothers,

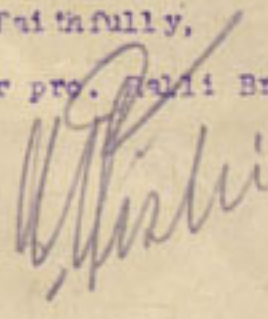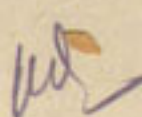G. G. D.



No. E 411 of 1917.

Municipal Office.

Karachi. 16th May 1917.

MEMO 3-

their
With reference to Mx application dated 4th
Instant with plans for plot No. 4, B-2 Railway Quarter
Messrs Halli Brothers are requested to apply for permission
to the City Deputy Collector with two copies of plans
returned herewith duly signed and approved. They must not start
any building operation until they hear further from this
office.

J. A. L. Kerby

A. M. Inst. C. E.,

E N G I N E E R,

KARACHI MUNICIPALITY?

No. E 412 of 1917.

Municipal Office.

Karachi. 16th May 1917.

Copy forwarded to the City Deputy Collector
with reference to his No. 536 dated 27th February 1914.

J. A. L. Kerby

A. M. Inst. C. E.,


E N G I N E E R,

KARACHI MUNICIPALITY.


APPROVED.

James L. Kelly
J.L. Inst. C.E.
Engineer,
Karachi Municipality



GROUND PLAN.

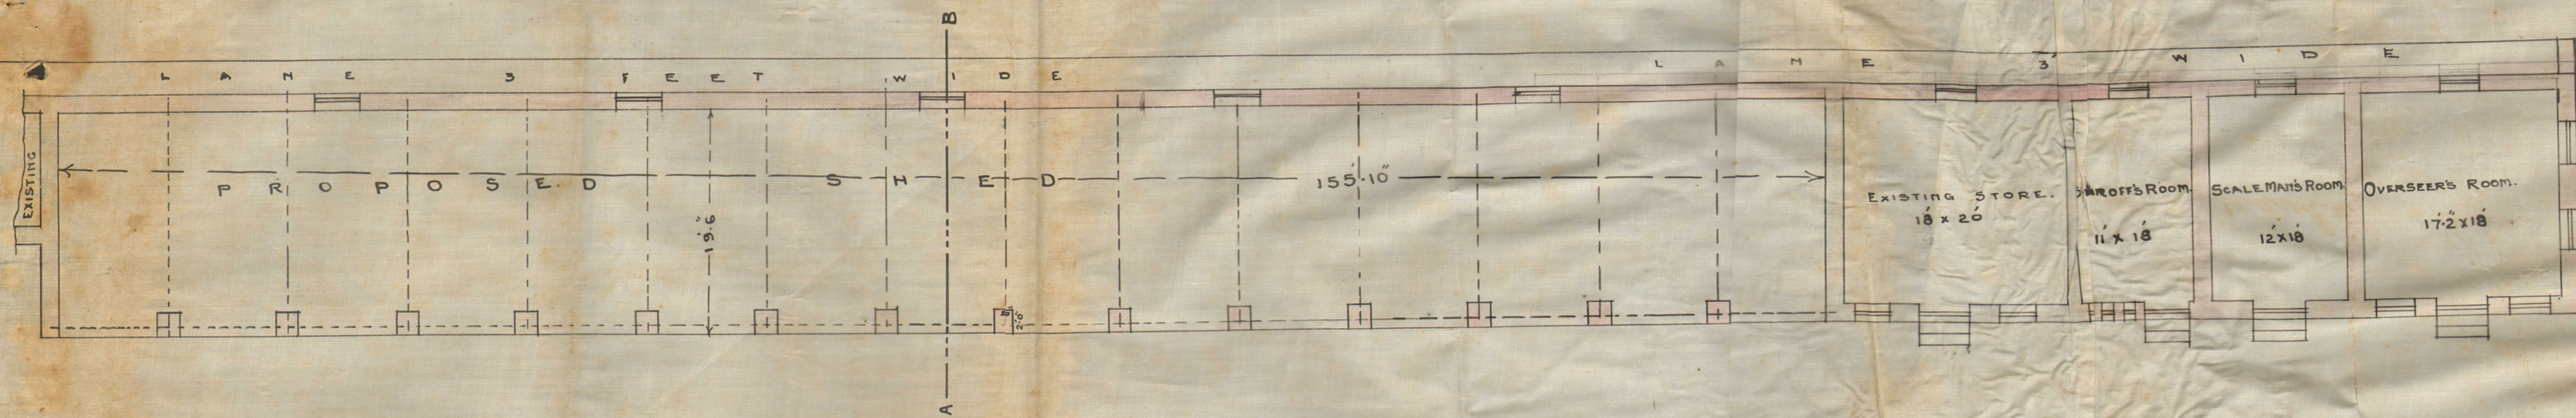

ELEVATION.

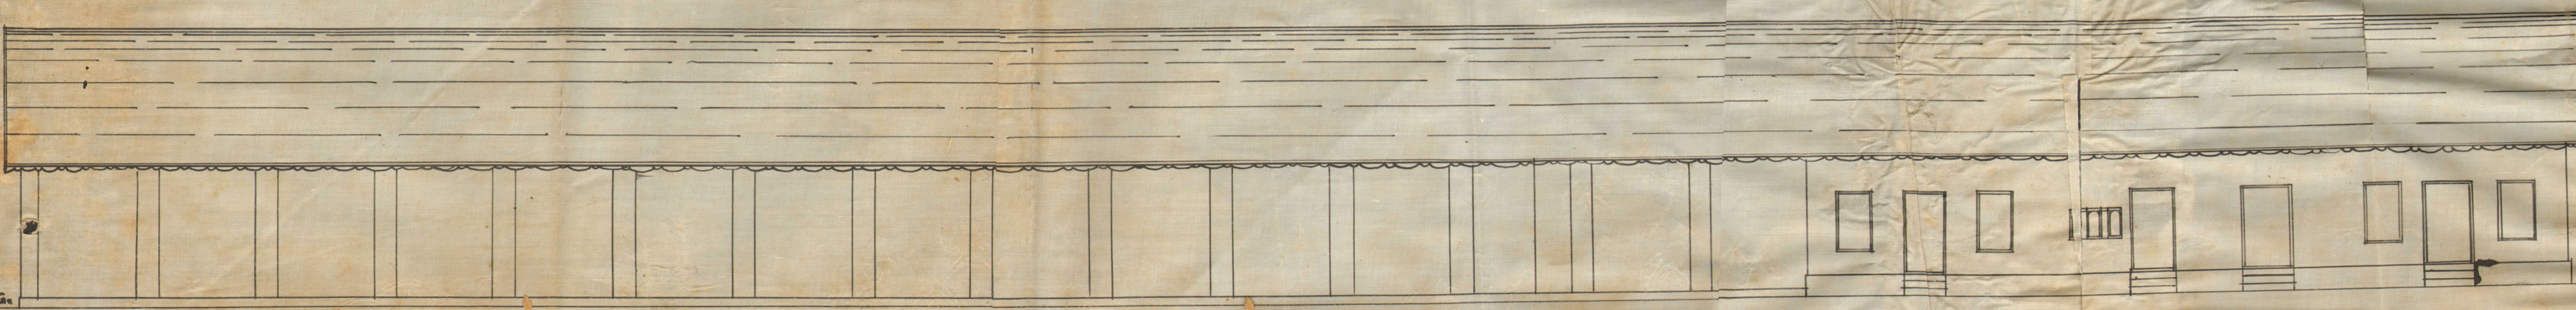

SECTION ON AB.

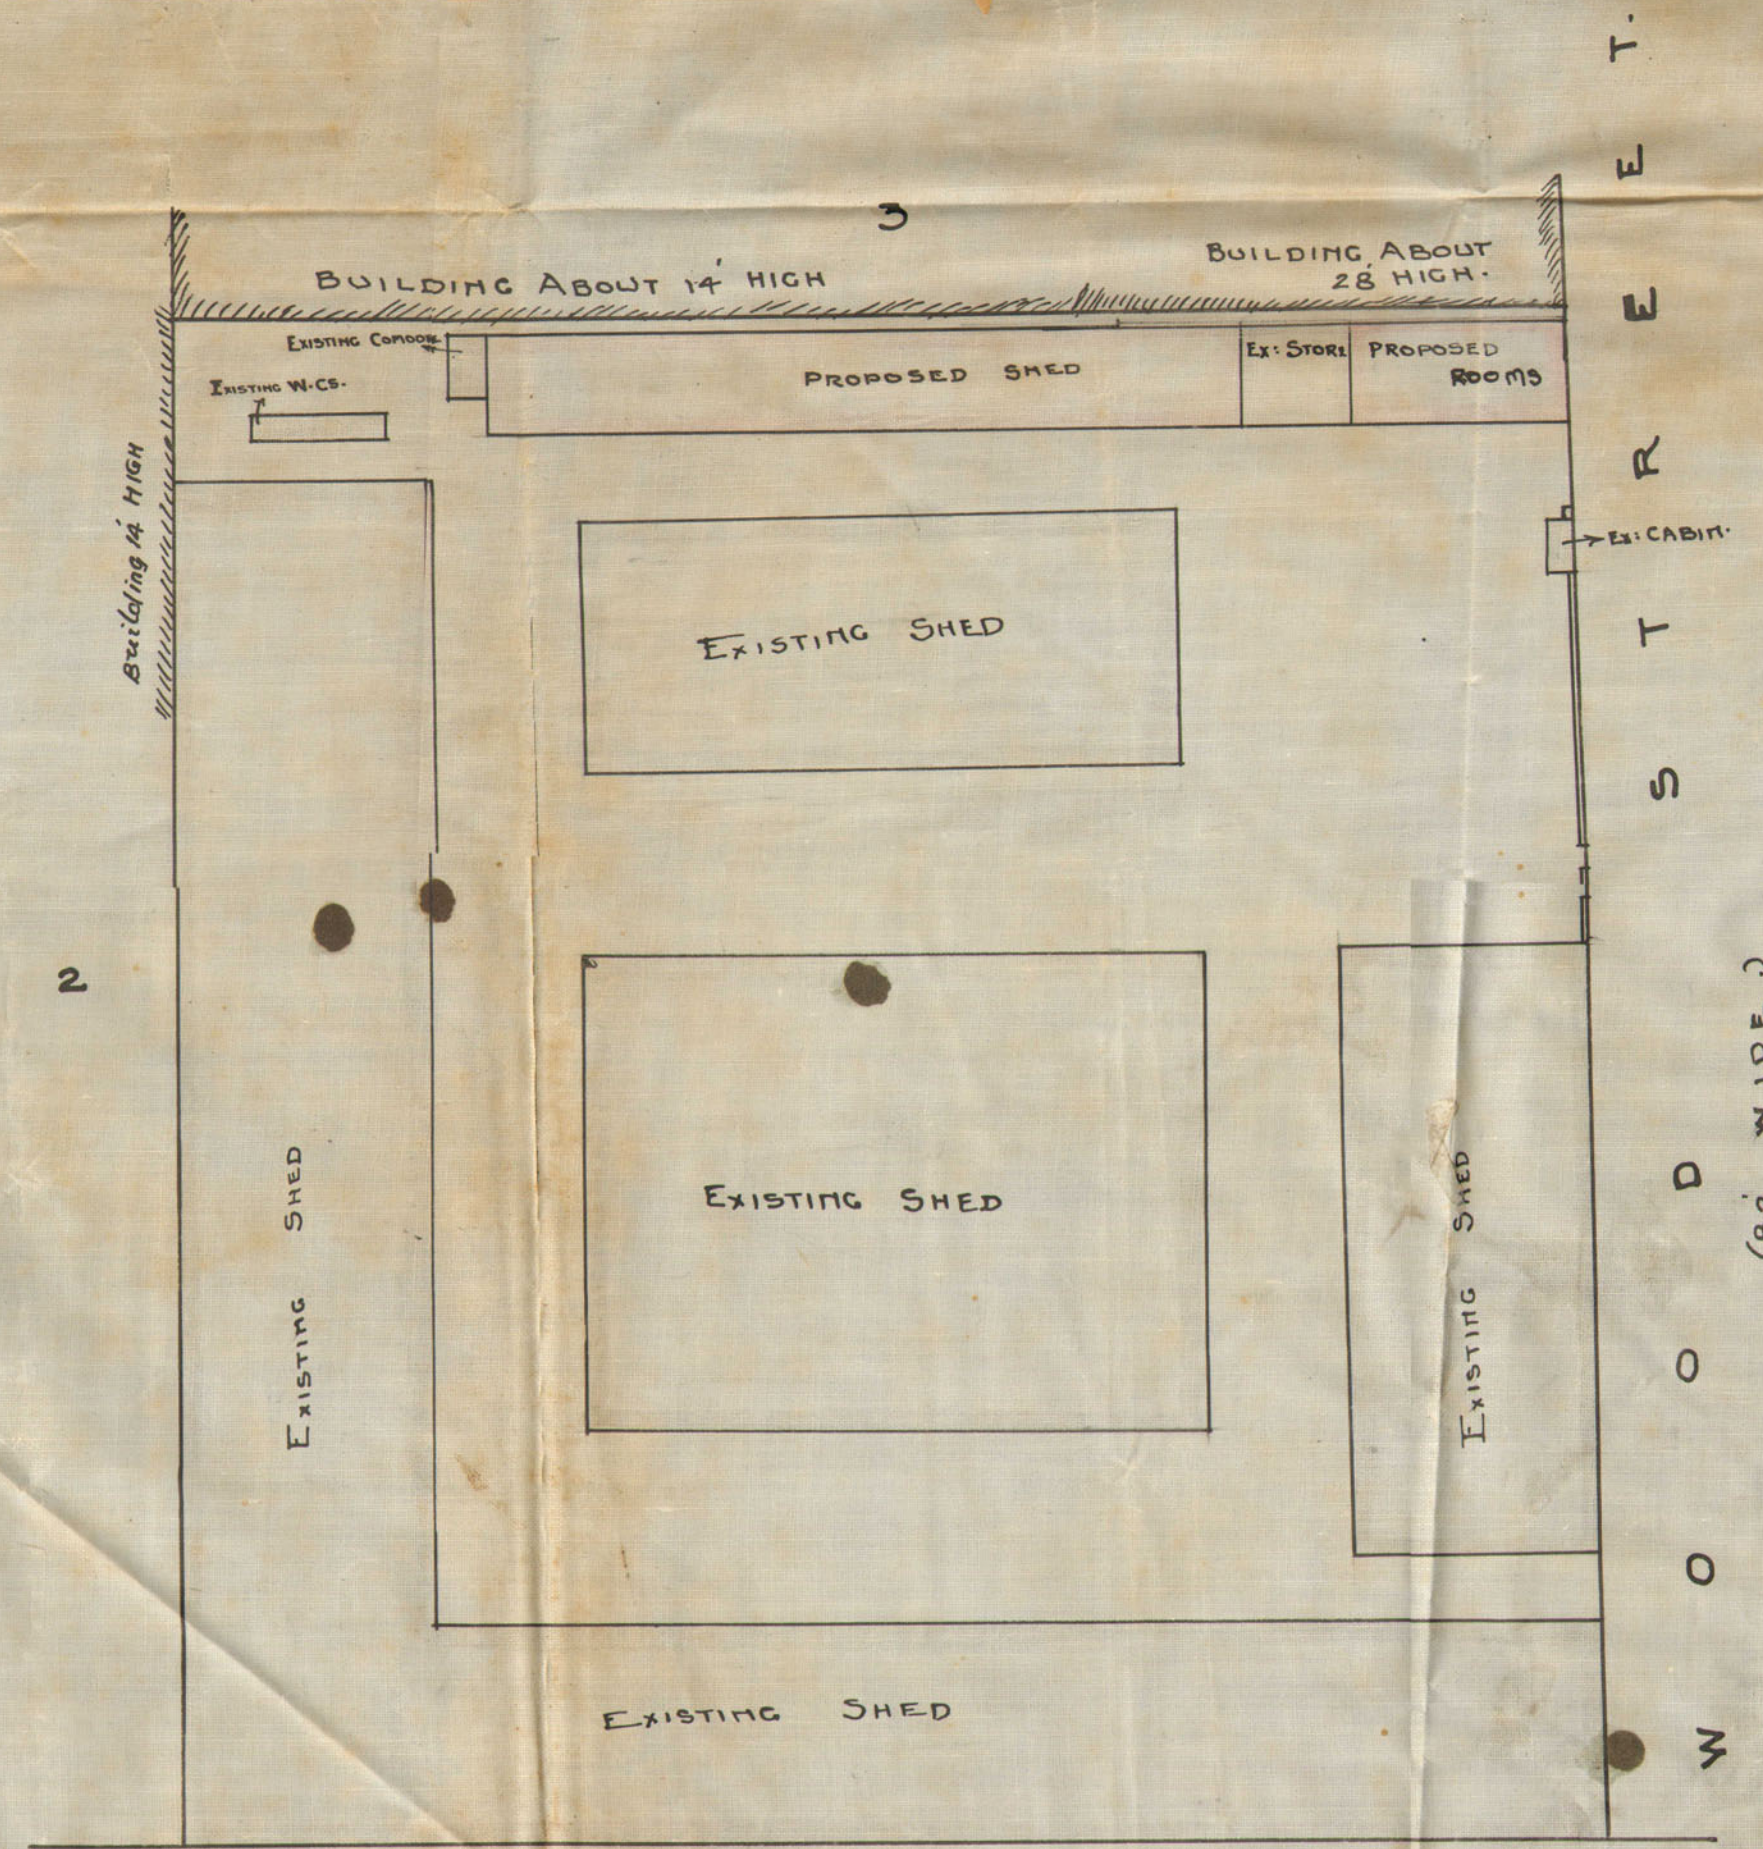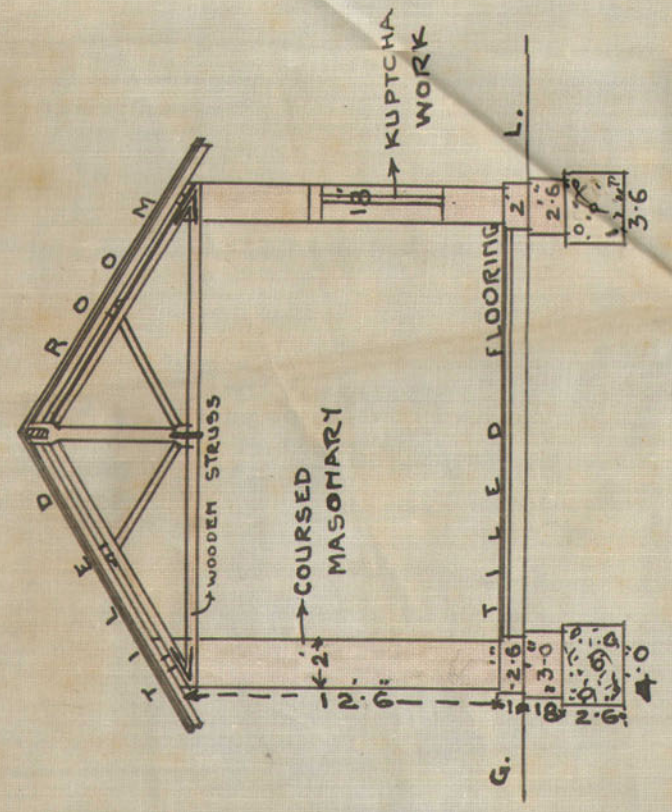

SITE PLAN

SCALE 40'=1.

RAILWAY LINES Q R

PLAN

Showing proposed structures on No 4-B.2.

SCALE 8'=1.

Navlakha M.T.
LICENCED SURVEYOR.

N. W. RAILWAY LINES.
OPEN LAND



G-11-1

200-12-7-16

Form No. 1.

Karachi, 10/4/ 1917.

NOTICE UNDER SECTION 96 OF ACT III OF 1901.

To

THE CHIEF OFFICER AND CHIEF ENGINEER,
KARACHI MUNICIPALITY.

SIR,

^{we} beg to inform you that ^{we} intend building a shed
on plot No. 4

Survey Sheet No. B2 situate in Wood

Street, Railway Lines Quarter.

As required by the rules of the Municipality, ^{we} beg to submit herewith ^{we} a plan of the same for your approval.

^{we} beg to remain,

Sir,

Your most obedient servant,

per PRO. RAIL BROTHERS

Wishii
Signature of the applicants.

No. G. 4216 of 191

MUNICIPAL CHIEF OFFICER AND
CHIEF ENGINEER'S OFFICE.

Karachi, 13-4- 1917

Forwarded to the Municipal Engineer for favour of disposal.

Wishii
M. INST. C. E.

Chief Officer and Chief Engineer,
Karachi Municipality

Attest Secy 5/4

13/4



G-11-2

No. E. ²2904 of 1917

MUNICIPAL ENGINEER'S OFFICE.

Karachi, 13th April 1917

MEMO.

The above application is forwarded to the Municipal Health Officer for
favour of report.

Imamul Bakhsh
M. E. E.
Engineer,
Karachi Municipality.

MUNICIPAL HEALTH OFFICER'S REPORT.

Returned to the Engineer, Karachi Municipality, with the following
remarks:—

No objection

D. P. H.

D. P. H. (London),
Health Officer,
Karachi Municipality.

Date 1917

No. E. ²2904 of 1917

MUNICIPAL ENGINEER'S OFFICE.

Date 16th April 1917

Forwarded to the Building Surveyor for report

Imamul Bakhsh

Through

THE LAND SURVEYOR,

Karachi Municipality.



BUILDING SURVEYOR'S REPORT.

Applicant's name

Rallu Bros

Whether he is the owner of the plot on which it is proposed to build

YB

Plot under whose control

Er

Whether it is permanent or temporary

Permanent

The work proposed

Addition

Building Surveyor's report

Sir,

They to report that there appears
no objection to the plan.

Date

20/4

1917

Yr. Obedient
M. Shams

Building Surveyor.

Submitted through the Land Surveyor

LAND SURVEYOR'S REPORT.

Does the plot come under Alignment

No

Area of plot

Area under Alignment

Remarks

Sir, they to report that there is no
objection to grant permission to build -

As the plot is under the control of Municipality
Yours obediently

Date

26-5

1917

Land Surveyor.

ORDERS OF THE ENGINEER.

The open space to the North should not
be less than 3'-0" wide. The shed should
have windows to the north.

V.
26/5/17



6-11-4

No. E. 477⁴ of 1917

MUNICIPAL ENGINEER'S OFFICE,

Karachi 31st May 1917

Submitted to the Managing Committee with a recommendation that
the plan be approved,

T. M. M. M.

*Frederick Lee**J. A. M. I. C. E.*

A. M. I. C. E.,

Engineer,

Karachi Municipality.

Through

Chief Officer & Chief Engineer,
Karachi Municipality

The CHIEF OFFICER & CHIEF ENGINEER.

KARACHI MUNICIPALITY.

RESOLUTION OF THE MANAGING COMMITTEE.

Resolution No. _____ dated _____