

500-13.8.13.

Form No. 1.

Karachi, 13th March 1917.

NOTICE UNDER SECTION 96 OF ACT III OF 1901.

To

THE CHIEF OFFICER AND CHIEF ENGINEER,
KARACHI MUNICIPALITY.

SIR,

I beg to inform you that I intend building a mosque

on plot No. 1 & 2

Survey Sheet No. A1 Situate in Rampart

Street old Town Quarter.

As required by the rules of the Municipality. I beg to submit herewith
a plan of the same for your approval.

I beg to remain,

Sir,

Your most obedient Servant,

Muhammad Ali Chagha

Signature of the applicant.

*Entered
Volume 143/7*

No. G. of 191

MUNICIPAL CHIEF OFFICER AND

CHIEF ENGINEER'S OFFICE.

Karachi, _____ 191

Forwarded to the Municipal Engineer for favour of disposal.

A. M. INST. C. E.,
Chief Officer and Chief Engineer,
Karachi Municipality.



H-1-2

2

No. E. of 191 .

MUNICIPAL ENGINEER'S OFFICE.

Karachi 191 .

MEMO.

The above application is forwarded to the Municipal Health Officer for favour of report.

A. M. I. C. E

Engineer,

Karachi Municipality.

MUNICIPAL HEALTH OFFICER'S REPORT.

Returned to the Engineer, Karachi Municipality, with the following remarks.—

No objection

D. P. H. (London.)

Health Officer,

Karachi Municipality.

Date 16-3-1917.

No. E. 2131 of 1917.

MUNICIPAL ENGINEER'S OFFICE.

Date 16th March 1917.

Forwarded to the Enquiry Officer for report.

Trammall

A. M. I. C. E.,

Engineer.

Karachi Municipality.

Through.

The Land Surveyor,

Karachi Municipality.



M-1-3

25/3

3

ENQUIRY OFFICER'S REPORT.

Applicant's name Ghulamali ChaglaWhether he is the owner of the plot on which it is proposed to build yesThe work proposed Government, PermanentBuild a bungalowEnquiry Officer's report Sir,I beg to report that there is no objection to approve the sameDate 29/3 1917.Enquiry Officer. [Signature]

Submitted through the Land Surveyor.

LAND SURVEYOR'S REPORT.

Does the plot come under Alignment noArea of plot —Area under Alignment —Remarks Sir, With regard to this they to report that there is no objection to grant pass. with the Ch. C. and one more copy to be required from the Ch. C. to be supplied.Date 23-3- 1917.Land Surveyor. [Signature]

ORDERS OF THE ENGINEERS.

A. M. I. C. E.,

Engineer,

Karachi Municipality



M-1-4

No. E. ⁴3815 of 1917

MUNICIPAL ENGINEER'S OFFICE.

Karachi, 8th May 1917.



Submitted to the Managing Committee with a recommendation that the plan be approved.

Forwarded

Measham

J. A. H. Kerley

A. M. I. C. E.,

Engineer,

Karachi Municipality.

M. Inst. C. E.,

Chief Officer & Chief Engineer,
Through Karachi Municipality.

M THE CHIEF OFFICER AND CHIEF ENGINEER,
KARACHI MUNICIPALITY.

RESOLUTION OF THE MANAGING COMMITTEE.

Resolution No. _____ Date _____



M-2

80

Taken out for M.E.

Sanctioned

Pr

81

191

Karnachi

on file	Name of person to be prosecuted	Nature of Offense	When offense was committed	Name of plaintiff and witnesses	Date

M-3



Heritage

KMR.CDD.MiQ.1917.01(2-3)(m)

(200-24-2-

Form No. 2.

ORDERS UNDER SECTION 96 (2) OF ACT, III OF 1901.

No. E/

3781

OF 1917

MUNICIPAL ENGINEER'S OFFICE,

Karachi, 4th May 1917

MEMO :

With reference to his application, dated 13th Feb. 1917.Mr. Nedar Praggi is informedthat the plan submitted by him for building a houseon plot No. 116, Survey Sheet C6,situate in Kutichivade Lane Street, Market

Quarter, is approved, and permission to build in accordance therewith is granted. The building to be erected subject to the Bye-laws and Rules of the Municipality.

A. M. INST. C. E.,

Engineer,

Karachi Municipality.

NOTICE 1.—This pass does not give permission to occupy Municipal land with building materials. This can only be allowed when the street is wide enough to permit building materials being deposited on it without it being a source of danger to the public, and only then on a hoarding being placed round the land to be occupied, and on payment, in advance of fees for occupation of Municipal land, at the following rates:—

	Rs.	A.	P.
(1) For the first three months, per square yard, per diem	...	0	0 ½
(2) For the next three months " " "	...	0	0 1
(3) For any subsequent time " " "	...	0	0 2

NOTICE 2.—Windows, steps and doors of the building will not be permitted to project on or overhang any public street or Municipal land.

NOTICE 3.—Plinths will not be allowed to project more than 2" on any public street for ornamental purposes.

3782 Copy to the Building Inspector
 3783 " Inspector the No
 3784 " Supdt of Machinery.

M-4

20,

The Engineer.

Karachi Municipality.

Sir,

With reference to
the attached correspondence
re the rebuilding the house
on plot No 116. Ch. market.
quarter they to report that
there seems no objection
to grant pass to build.

Yours truly
Nathaniel

5/11.

M-5-1



4667

7/1917

Revenue Department
City Survey Collection
Karachi May 1917

6908

Memorandum

With reference to his application
dated 18th April 1917 requesting permission
to make certain additions to the existing
buildings on survey no: 116, Sheet E-6,
Market Quater, in accordance with
plan no: 637, approved by the Engineer
Karachi Municipality, the Deed
Register is informed, that the permission

permission

M-5-2




Heritage

KMR.CDD.MiQ.1917.01(2-3)(m)

applied for is granted, provided he
obtains permission of the Koro-chi
Municipality, before commencing
building work
2/ plan no: 637 is also returned, duly

Sanctioned

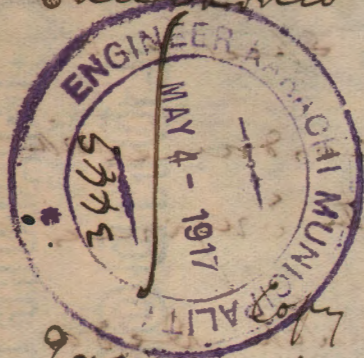

for report
Santh. Verley

Ed. F. E. Cumming,
City Deputy Collector,
Koro-chi

No. 2608 of 1917

Copy forwarded for information to the
Engineer Koro-chi Municipality with reference
to his endorsement No. 8/2937 dated 14th April 1917

Cumming

City Deputy Collector,
Koro-chi



M-6

No. E 2956

Municipal Office.

Karachi. 14th April 1917.

MEMO / -

With reference to his application dated 30th March received on 10th April 1917 with plans for plot No. 116, C-6 Market Quarter Mr: Dedar Pragji is requested to apply for permission to the City Deputy Collector with two copies of plans returned herewith duly signed and approved. He must not start any building operation until he hears further from this office.

A. M. Inst. C. E.,

E n g i n e e r

Karachi Municipality.

No. E 2957 of 1917.

Municipal Office.

Karachi. 14th April 1917.

Copy forwarded to the City Deputy Collector with reference to his No. 536 dated 27th February 1914.

A. M. Inst. C. E.,

E n g i n e e r

Karachi Municipality.



M-7-1

*Ed to
introduce
proposal*
G. H. Verley

30/3/17

Karachi

To

The Engineer

Karachi Municipality

Karachi

Sir,

With reference to your

memo no E 1463 of 1917 dated

22nd Feb. 1917 & herewith beg

to send your honor the plan

of plot no 116 - C 6 Market

quarter making the more

open space as required.

Hoping to be excused for the
trouble,

I beg to remain,

Sir,

your most obedt

E. H. Verley
E. C. Dedar Baggi


Sir,


I beg to report that the
applicant has amended
the plan according
to the instructions. ~~but~~
Health Officer's report
may be referred to.

Yrs. truly


W. H. H. H.

12/4/17


SECTION ON A.B

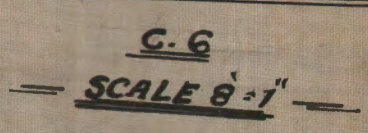

FIRST FLOOR
&
SECOND FLOOR PLAN.

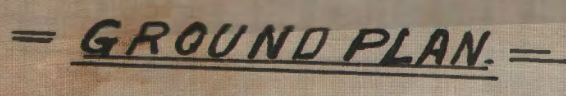

FRONT ELEVATION.

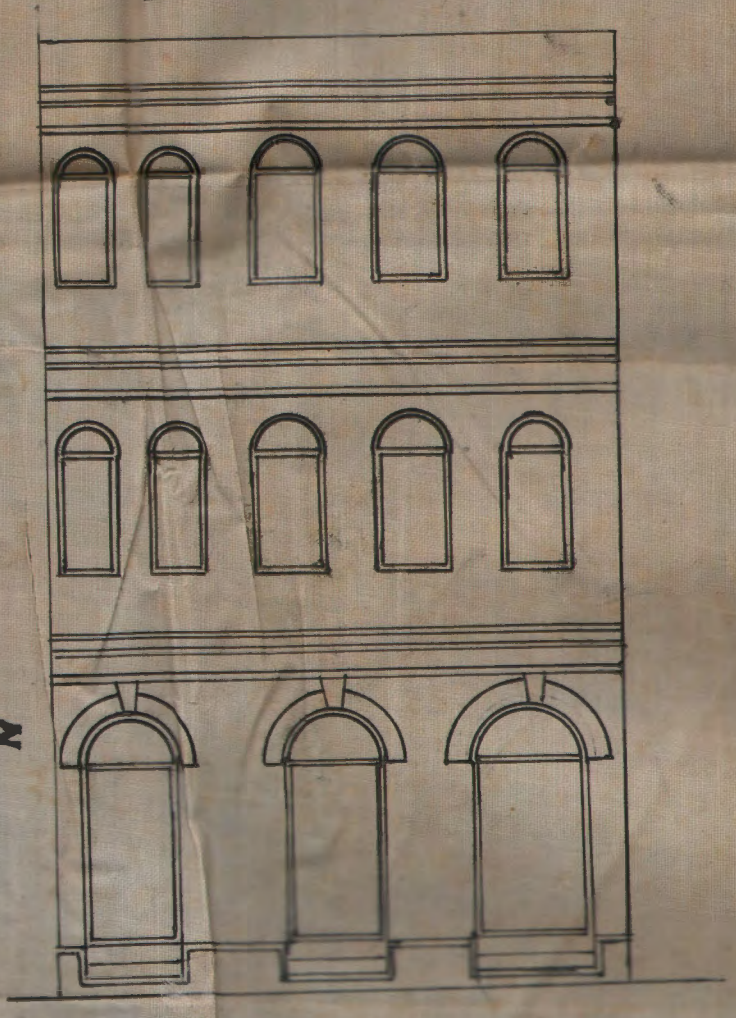

navlakha M. 7.
Surveyor