



Completion

Subject

C B. File no 3 of 1892

Comp no 53

Mo no 24 1906

Note.—Former Correspondence filed in

file

Compilation No.

Subsequent Correspondence filed in

file

Compilation No.

Karachi-

12/2/1943-

To, The Land Manager & Architect
H. M. Corp.

968

MUNICIPAL CORP.

No

22 FEB 1943

AND

Dear Sir,

Re: - S. No 24. W.O.B. Wadhwanthi

With reference to your letter No 371/42 dated 4th inst I have to state that the W.C. is made 2' higher than road level & 0'6" from inner Court yard.

As regards 2 c.c. pillars you will allow me to correct the plan, as the lintels are introduced in the wall instead of lecting pillars
Thanking you.

Yours faithfully
H. P. Pathan

20/2



B.S.

This is Sunday you
should we file the papers?
As it is impossible change
in the plan I do not think
we should pursue the matter

P. file in completion

in blue

2/3



Heritage

KMR.CDD.JaQ.1942.01

600-6-39.

F. M. I. KURESHI
B. Sc. Engineering (Edin.)
LAND MANAGER & ARCHITECT.



MUNICIPAL CORPORATION,
KARACHI.

Reference No. *B.S.C. 127/42*

DEC 17 1942

NOTICE OF DEVIATION FROM APPROVED PLAN.

To,

Mr. Feida Hussain Lt. Anjaria

Karachi.

Dear Sir,

Re:—Plot No. *24.* Sheet No. *W. 06*, *Wadhwanal P. Quarter.*

You are hereby informed that you are carrying out, or have carried out the construction work on the above plot in a manner contrary to the approved plan, as follows—

- (1) *Two 9" x 9" C.C. pillars near the existing building are not provided.*
 - (2) *Roof is not in order.*
 - (3) *Two feet plinth is not provided.*
- Hence your building ^{completion} certificate cannot be considered.*

You are therefore hereby required forthwith, upon receipt of this notice, to stop the work and to make the building in conformity with the approved plan.

If you fail to comply with the requirements of this notice within ten days of its receipt, prosecution will be filed against you.

Yours faithfully,

F. M. I. Kureshi
Land Manager & Architect.

P. H. H. Architect, to explain
to the Municipal Corporation
the reasons for the deviation from the approved plan.

F. M. I. KURESHI,

B. Sc. Engineering (Edin.)

LAND MANAGER & ARCHITECT.



**MUNICIPAL CORPORATION,
KARACHI.**

NOV 19 1942

Reference No. B. S. P. 107/42

MEMO :

Re : Plot No. 24 W.O.C. Sheet Wagahal 00 Qr.

Plan for additional conveniences
on the above plot submitted by Mr. Zida Hussain G. Dujania
has been approved by the Karachi Municipal Corporation.

F. M. I. Kureshi
NOV 18 1942

F. M. I. Kureshi
Land Manager & Architect.

Copy forwarded to—

1. Health Officer,
2. Supdt. of Machinery,
3. Assessor, & Collector,
4. Building Surveyor, with plan,
5. Land Surveyor,
6. Enquiry Officer,

for information and necessary action.



Heritage

KMR.CDD.JaQ.1942.01

2000-11-41.

NOTICE OF COMPLETION UNDER SECTION 187 (I) OF THE
CITY OF KARACHI MUNICIPAL ACT, 1933.

Karachi, 20 Nov. 1942

To,
The Chief Officer,
Karachi Municipal Corporation.

DEAR SIR,

I hereby inform you that my following building and drainage work
(insert full particulars of work one wc. and bath

on plot no. 24, 20.6, Wadhawal
Plot.

has been completed and the certificate of completion signed by the Licensed
Surveyor, who supervised the work, is submitted here-below.

Owner.

Yours faithfully,

Sd: Lida Hussain

Address.

—:o:—

Reference No. B. S. C. 20.6/24

Municipal Office,

Karachi, 2/12/42

1. Copy forwarded with compliments to the Health Officer, Karachi
Municipal Corporation for his remarks.

2. Copy forwarded to the Assessor, Karachi Municipal Corporation
for information. The above notice of completion was received
on 20/11/42.

3. Copy forwarded to the Superintendent of Machinery, Karachi
Municipal Corporation to communicate direct to the owner if there is any
objection to the building and to send copy of his objection to the

Surveyor, Karachi Municipal Corporation

encroachment

and F. C. f

in



2000-11-41.

NOTICE OF COMPLETION UNDER SECTION 187 (I) OF THE
CITY OF KARACHI MUNICIPAL ACT, 1933.Karachi, 30/11/42

To,

The Chief Officer,
Karachi Municipal Corporation.

DEAR SIR,

I hereby inform you that my following building and drainage work
(insert full particulars of work One W.C & Bath on
plot no. 24, W.O. 6, Wadhwanal Oodhagan,
Quarter

has been completed and the certificate of completion signed by the Licensed
Surveyor, who supervised the work, is submitted here-below.

Owner.

Yours faithfully,

Mr. Ladda Hussain

Address.

—: o :—

Reference No. B. S. C. W.O. 6/24

Municipal Office,

Karachi, 3/12/42

1. Copy forwarded with compliments to the Health Officer, Karachi
Municipal Corporation for his remarks.

2. Copy forwarded to the Assessor, Karachi Municipal Corporation
for information. The above notice of completion was received
on 30/11/42.

3. Copy forwarded to the Superintendent of Machinery, Karachi
to communicate direct to the owner if there is any
objection to the building and to send copy of his objection to the

Surveyor, Karachi Municipal Corporation to
encroachment
and F. C.
one in



Heritage

KMR.CDD.JaQ.1942.01

1000-4-40

NOTICE OF COMPLETION UNDER SECTION 187 (1) OF THE
CITY OF KARACHI MUNICIPAL ACT, 1933.

Karachi, 30th Nov 1942

To,
30. Nov. 1942

The Chief Officer,

Karachi Municipal Corporation.

DEAR SIR,

I hereby inform you that my following building and drainage
works (insert full particulars of the work) One W.C. & Bath

on Plot No 24 W.O. 6 Wadhomal Est.

has been completed and the certificate of completion signed by the Licensed
Surveyor, who supervised the work, is submitted here-below.

Yours faithfully,

J. Deliuson Scriver
for Owner.

Address

Completion Certificate.

TO BE SUBMITTED BY LICENSED SURVEYOR

BUILDING AND DRAINAGE COMPLETION CERTIFICATE.

I do hereby certify that the following building and drainage work
(insert full particulars of the work) One W.C. & Bath

on S.No 24. W.O. 6 Wadhomal Est.

has been supervised by me and has been completed to my satisfaction, that the
workmanship and the materials used are good; and that no provision of the
Act or the Bye-laws and no requisition made, condition prescribed, or order
issued thereunder has been transgressed in the course of the work.

Signed.

H.R. Pathan

Dated.

30/11/42.



Pathan & Co.,
Architects,
Bunder Road,
Karachi.

H. R. Pathan
30/11/42




PLAN SHOWING PROPOSED ADDITIONAL
CONVENIENCES FOR S.No. 24 W.O. 6 WADHUMAL QST
SCALE 8'-1"

NOTE -
NEW WORK SHOWN RED

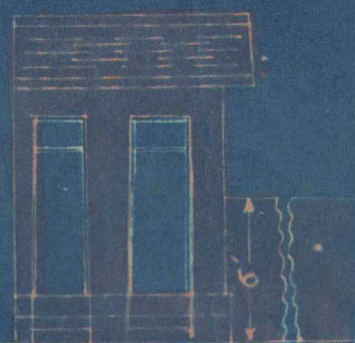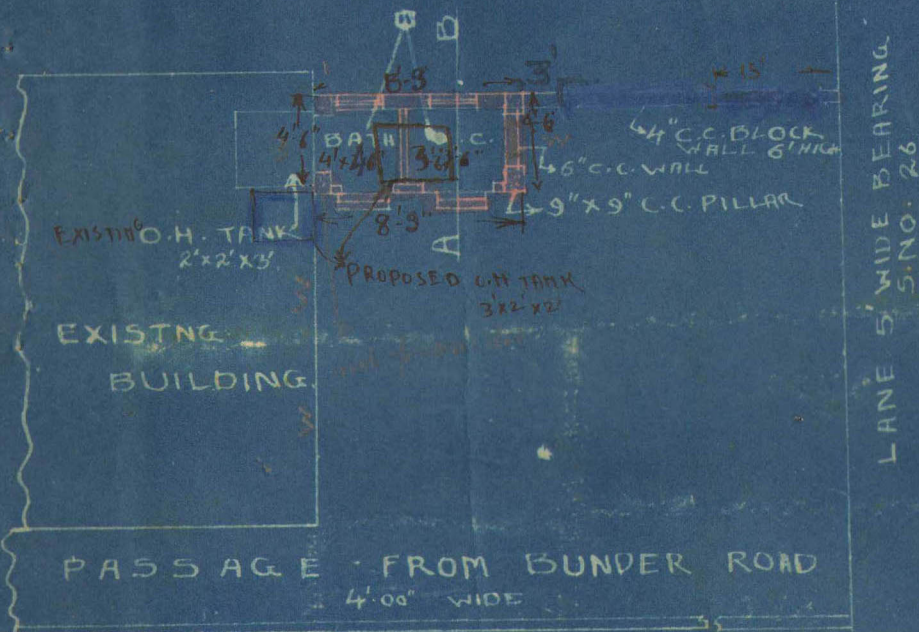

CORRUGATED
SHEET ROOF

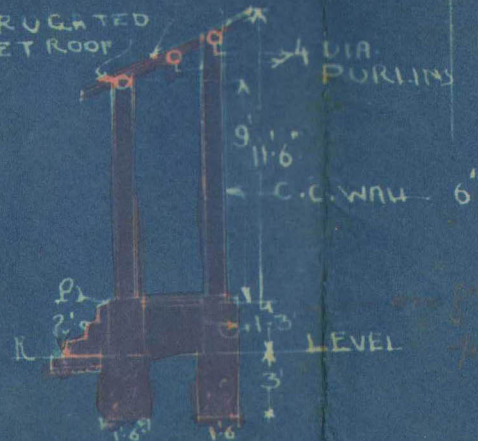

LEVEL


— SITE PLAN —
SCALE 20'=1"

AREA OF PLOT 546.0 SQ YDS.

A DARMJI BOODHABHAI ROAD

NOTE:- The ^{mat} W.A. has been removed ^{29/11}

S.NO. 23

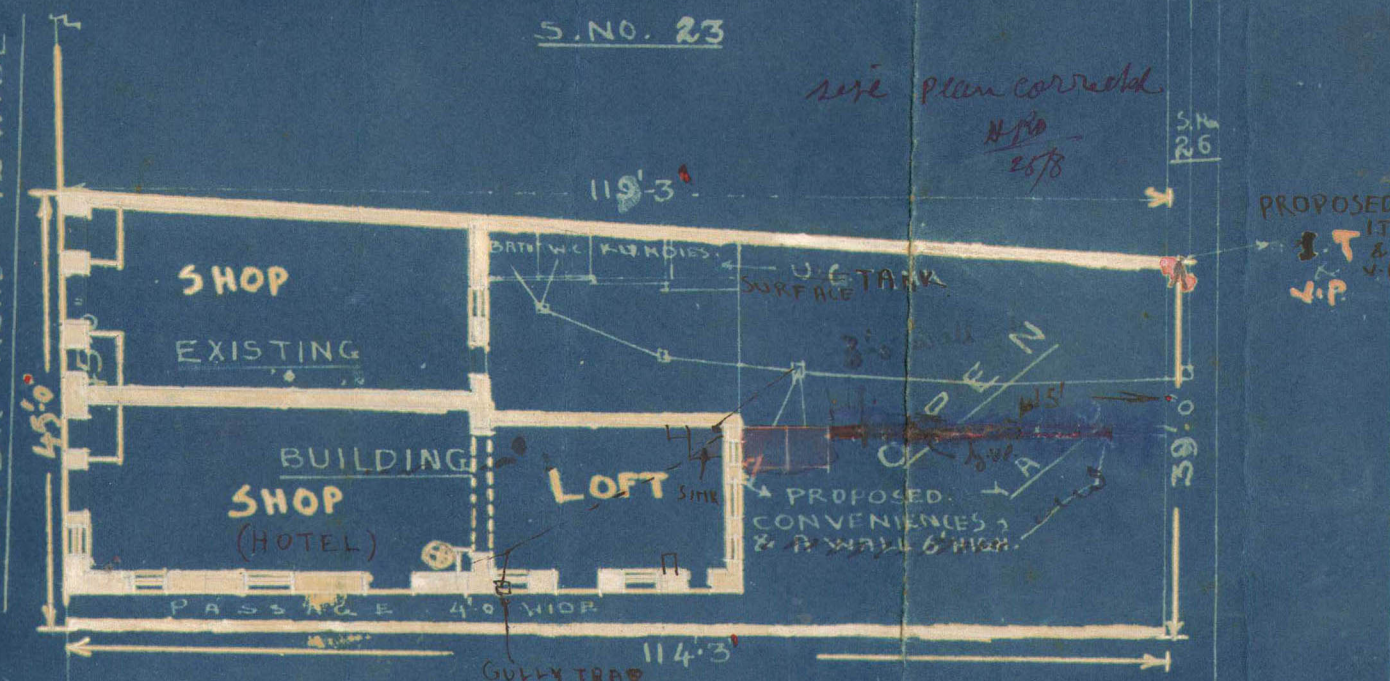

S.NO 25

— OWNER —
Zaidul Hasan & Sons
for Amirul Islam

H. P. Pathak
— PATHAK & CO.,
— ARCHITECTS,
— KARACHI.
19-7-42