


PLAN
SHOWING PROPOSED GODOWN ON
PLOT NO: 1 SHEET C1
MUCHEE MEANEE QUARTER
SCALE 8 FT = 1 INCH

APPROVED.

[Signature]
M. Ind. C.E.
Engineer
Karachi Municipality



[Signature]
Architect & Surveyor
Karachi 23-10-16

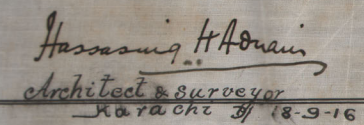


PLAN
SHOWING PROPOSED GODOWN ON
PLOT NO. 1 SHEET C1
MUCHEE MEANEE QUARTER
SCALE 8 FT. = 1 INCH

SECTIONAL ELEVATION ON E F




APPROVED:
L. S. S. S. S.
Engineer,

SECTION ON A B

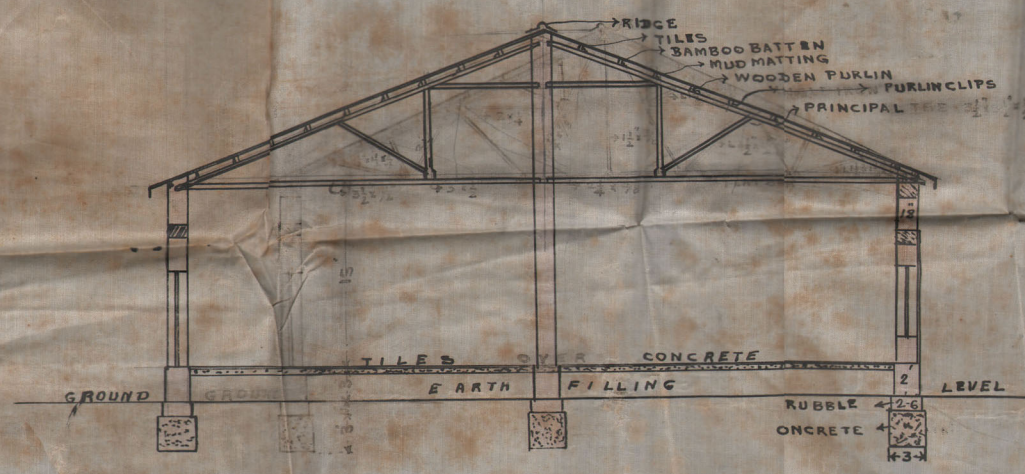


SECTION ON C D

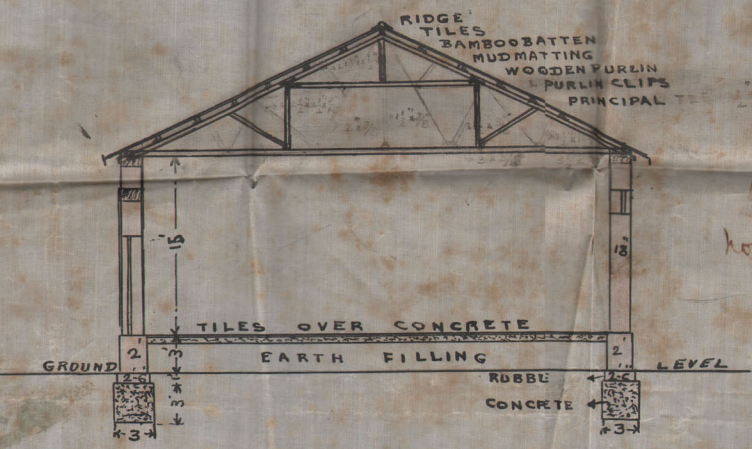


Wooden Truss
hot metal net

Hassan Singh H. Adnan
Architect & Surveyor

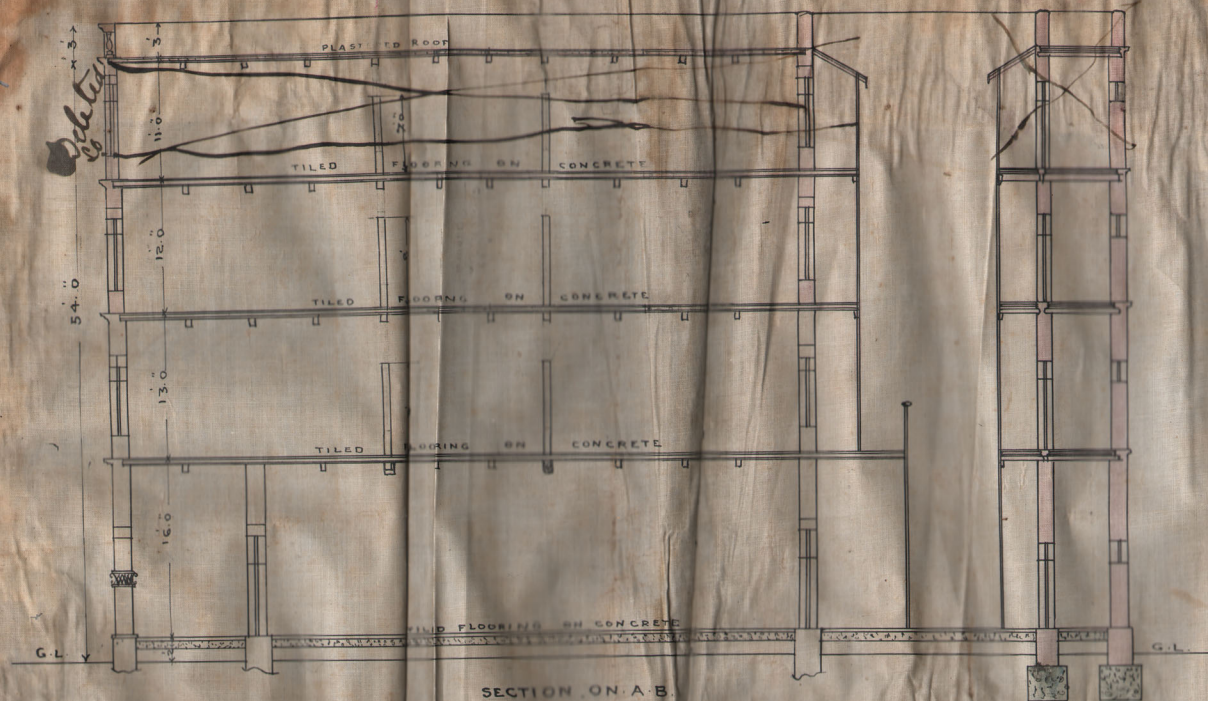


SECTION ON A-B.

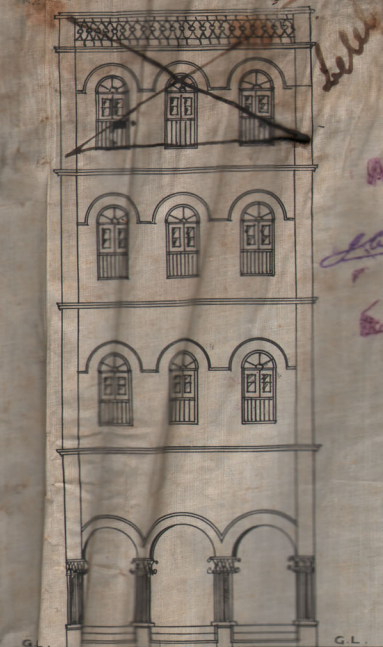


WEST ELEVATION



PLAN OF GROUND FLOOR

 

PLAN OF 1ST FLOOR.

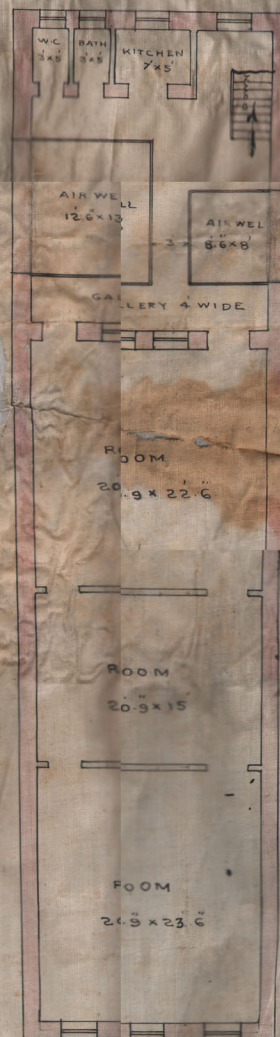

PLAN OF 2ND FLOOR.

PLAN OF PROPOSED EXTENSIONS
TO THE BUILDING ON PLOT NO 126-G4.
SUDDER BAZAR QUARTER
SCALE 8" = 1"



BLOCK PLAN

SCALE: 20' = 1"

Suleman Amee
M. Nazareth
12th March 1917.