



Heritage

KMR.CDD.Arq.1940.01

Office Telephone Nos. 2805, 2806 & 2807.

2000-5-40

F. M. I. KURESHI.

P. Sc. Engineering (Edin.)

LAND MANAGER & ARCHITECT

**MUNICIPAL CORPORATION
KARACHI.**

Reference No. B. S. P. 400/40.

MEMO:

Mdn.

Re: Plan No. 46, K.S.B

Sheet Artillery Qr.

Plan for Buildingon the above plot submitted by Mr. Mulchand B. Lala for owner
has been approved by the Karachi Municipal Corporation.

F. M. I. Kureshi
 NOV - 1940
 Land Manager & Architect.

Copy forwarded to—

1. Health Officer,
2. Supdt. of Machinery,
3. Assessor,
4. Building Surveyor, with plan,
5. Land Surveyor,
6. Enquiry Officer,
7. *Wing Secy C.G.B.*
for information and necessary action.

not started
B 13/12

work started
11/2


Foundations are being excavated.

foundation for
Small R.C.C. pillars have been
filled in
Re 3/4
for floor roof filled in
Re 14/5




PLAN
SHOWING PROPOSED BUILDING.
ON PLOT NO 4C K.E.B.
ARTILERY MAIDAN
SCALE 8"=1"

GROUND FLOOR

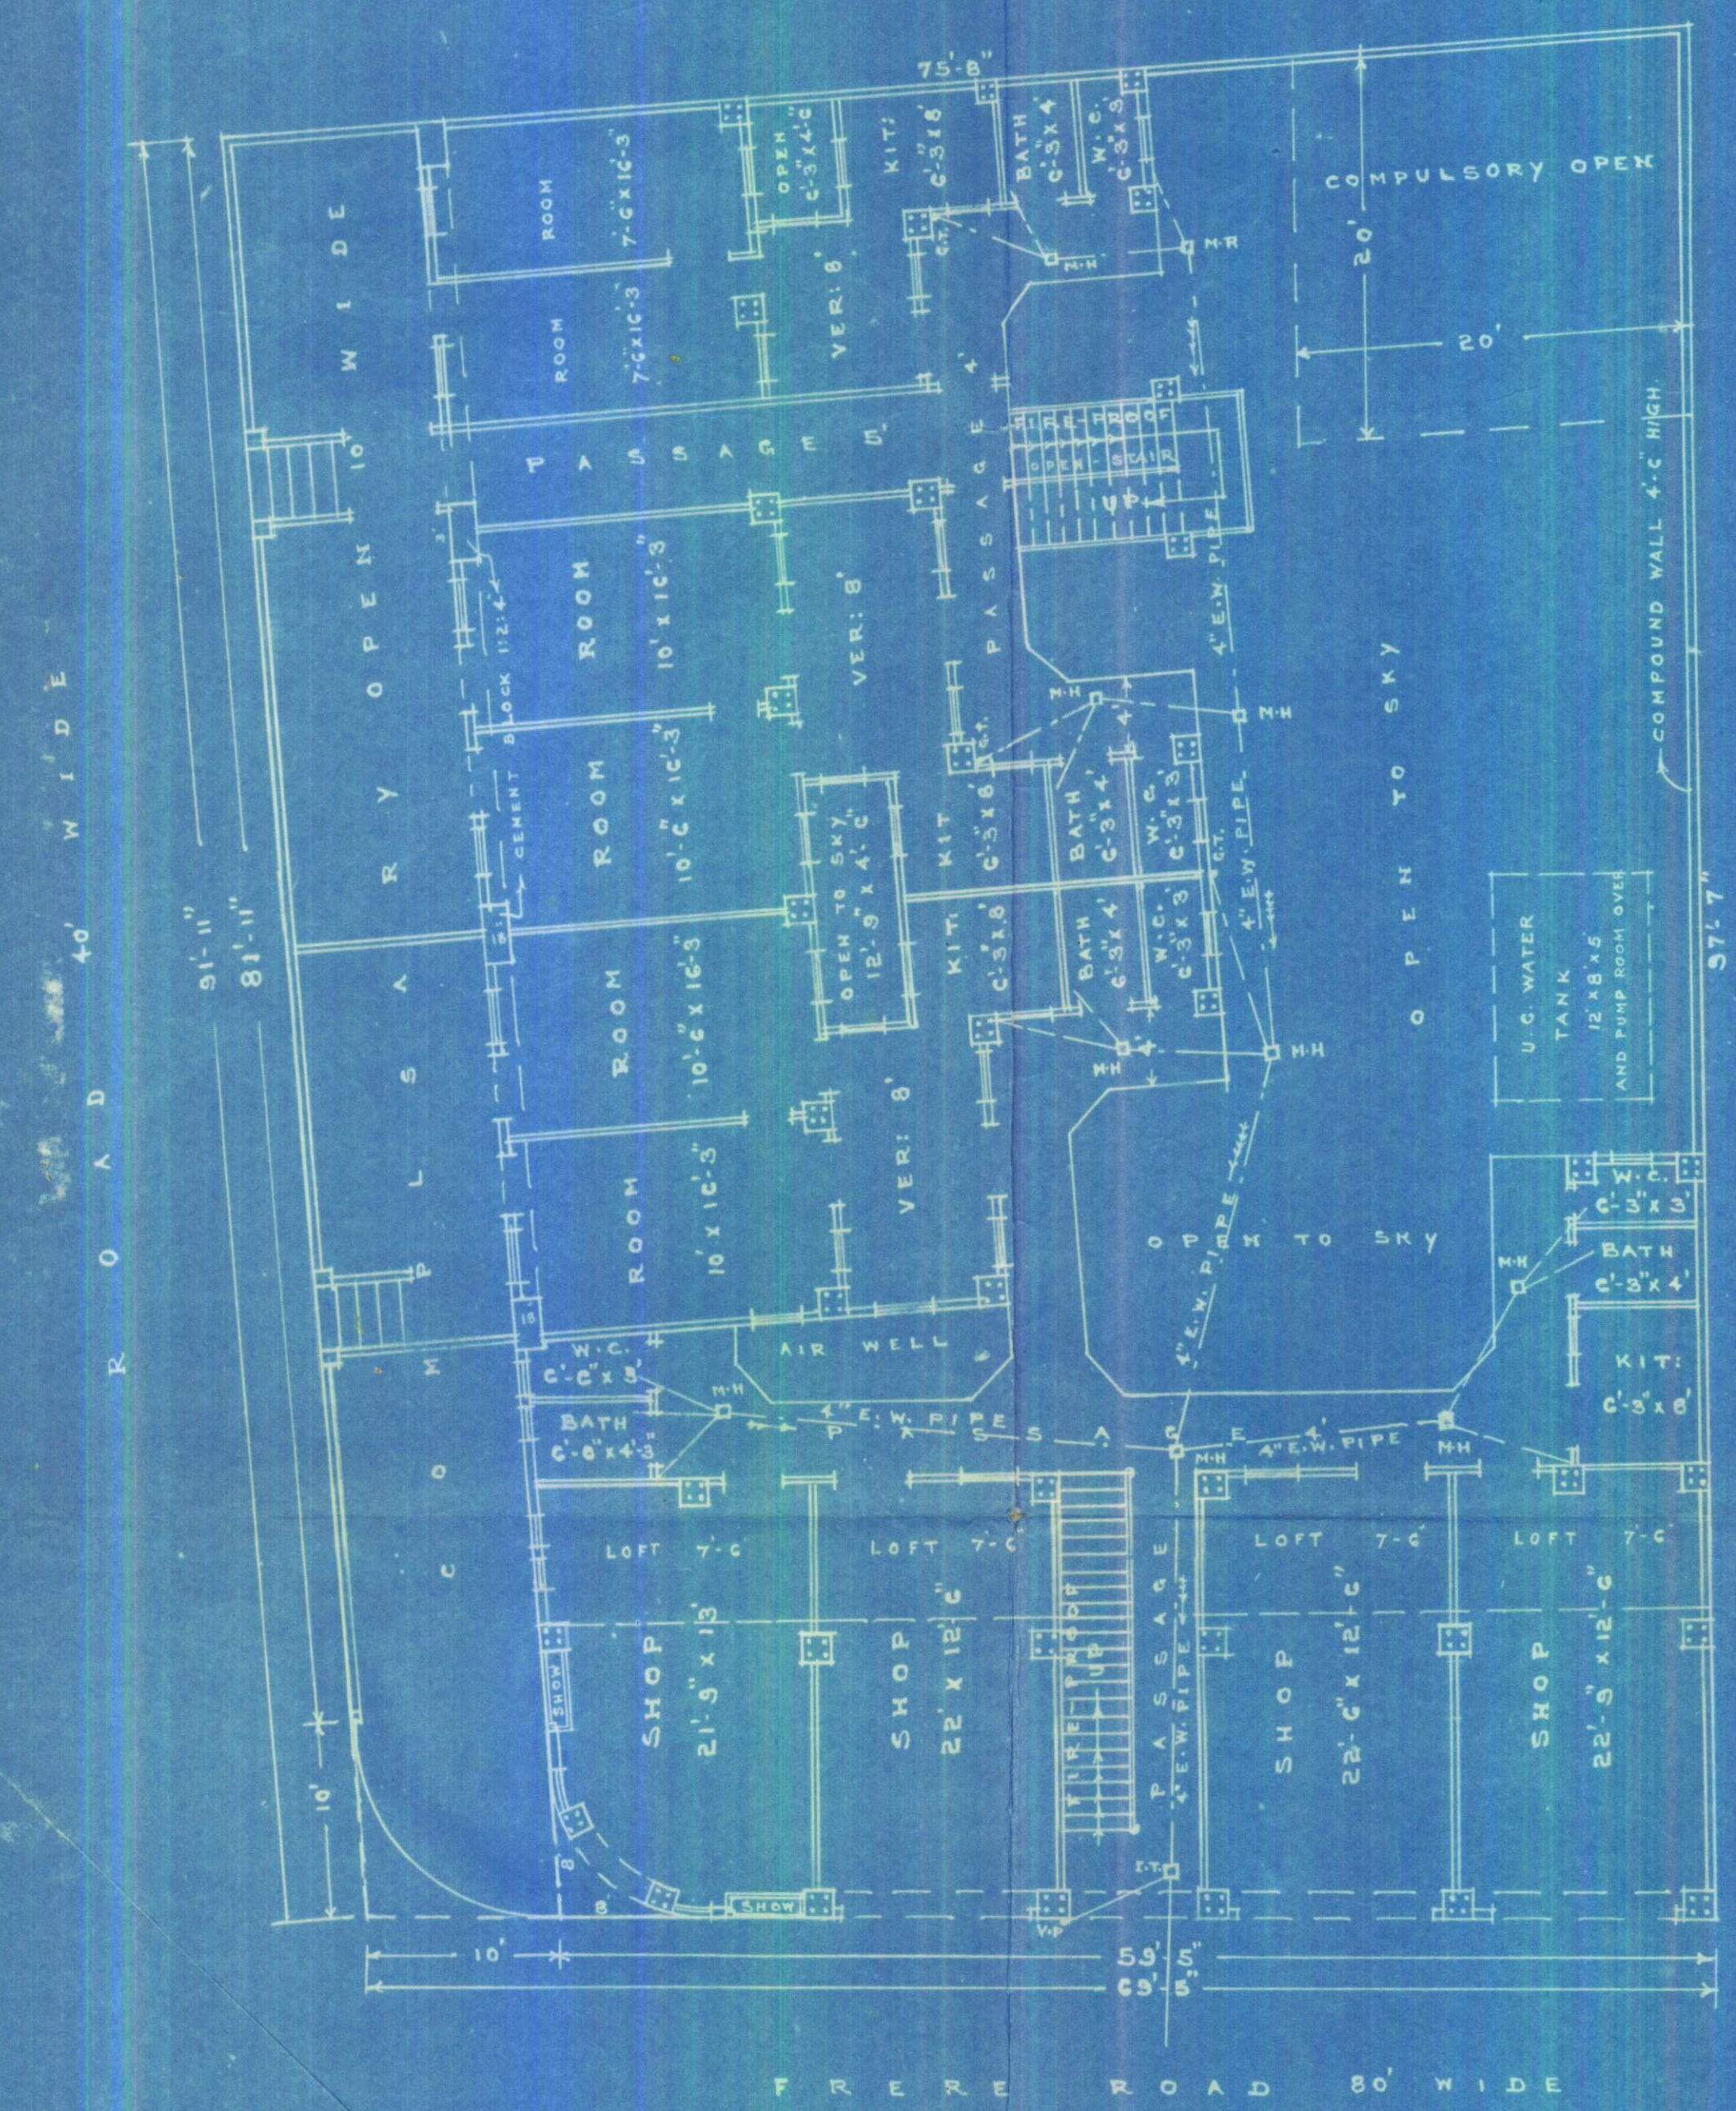

1ST 2ND & 3RD FLOOR.

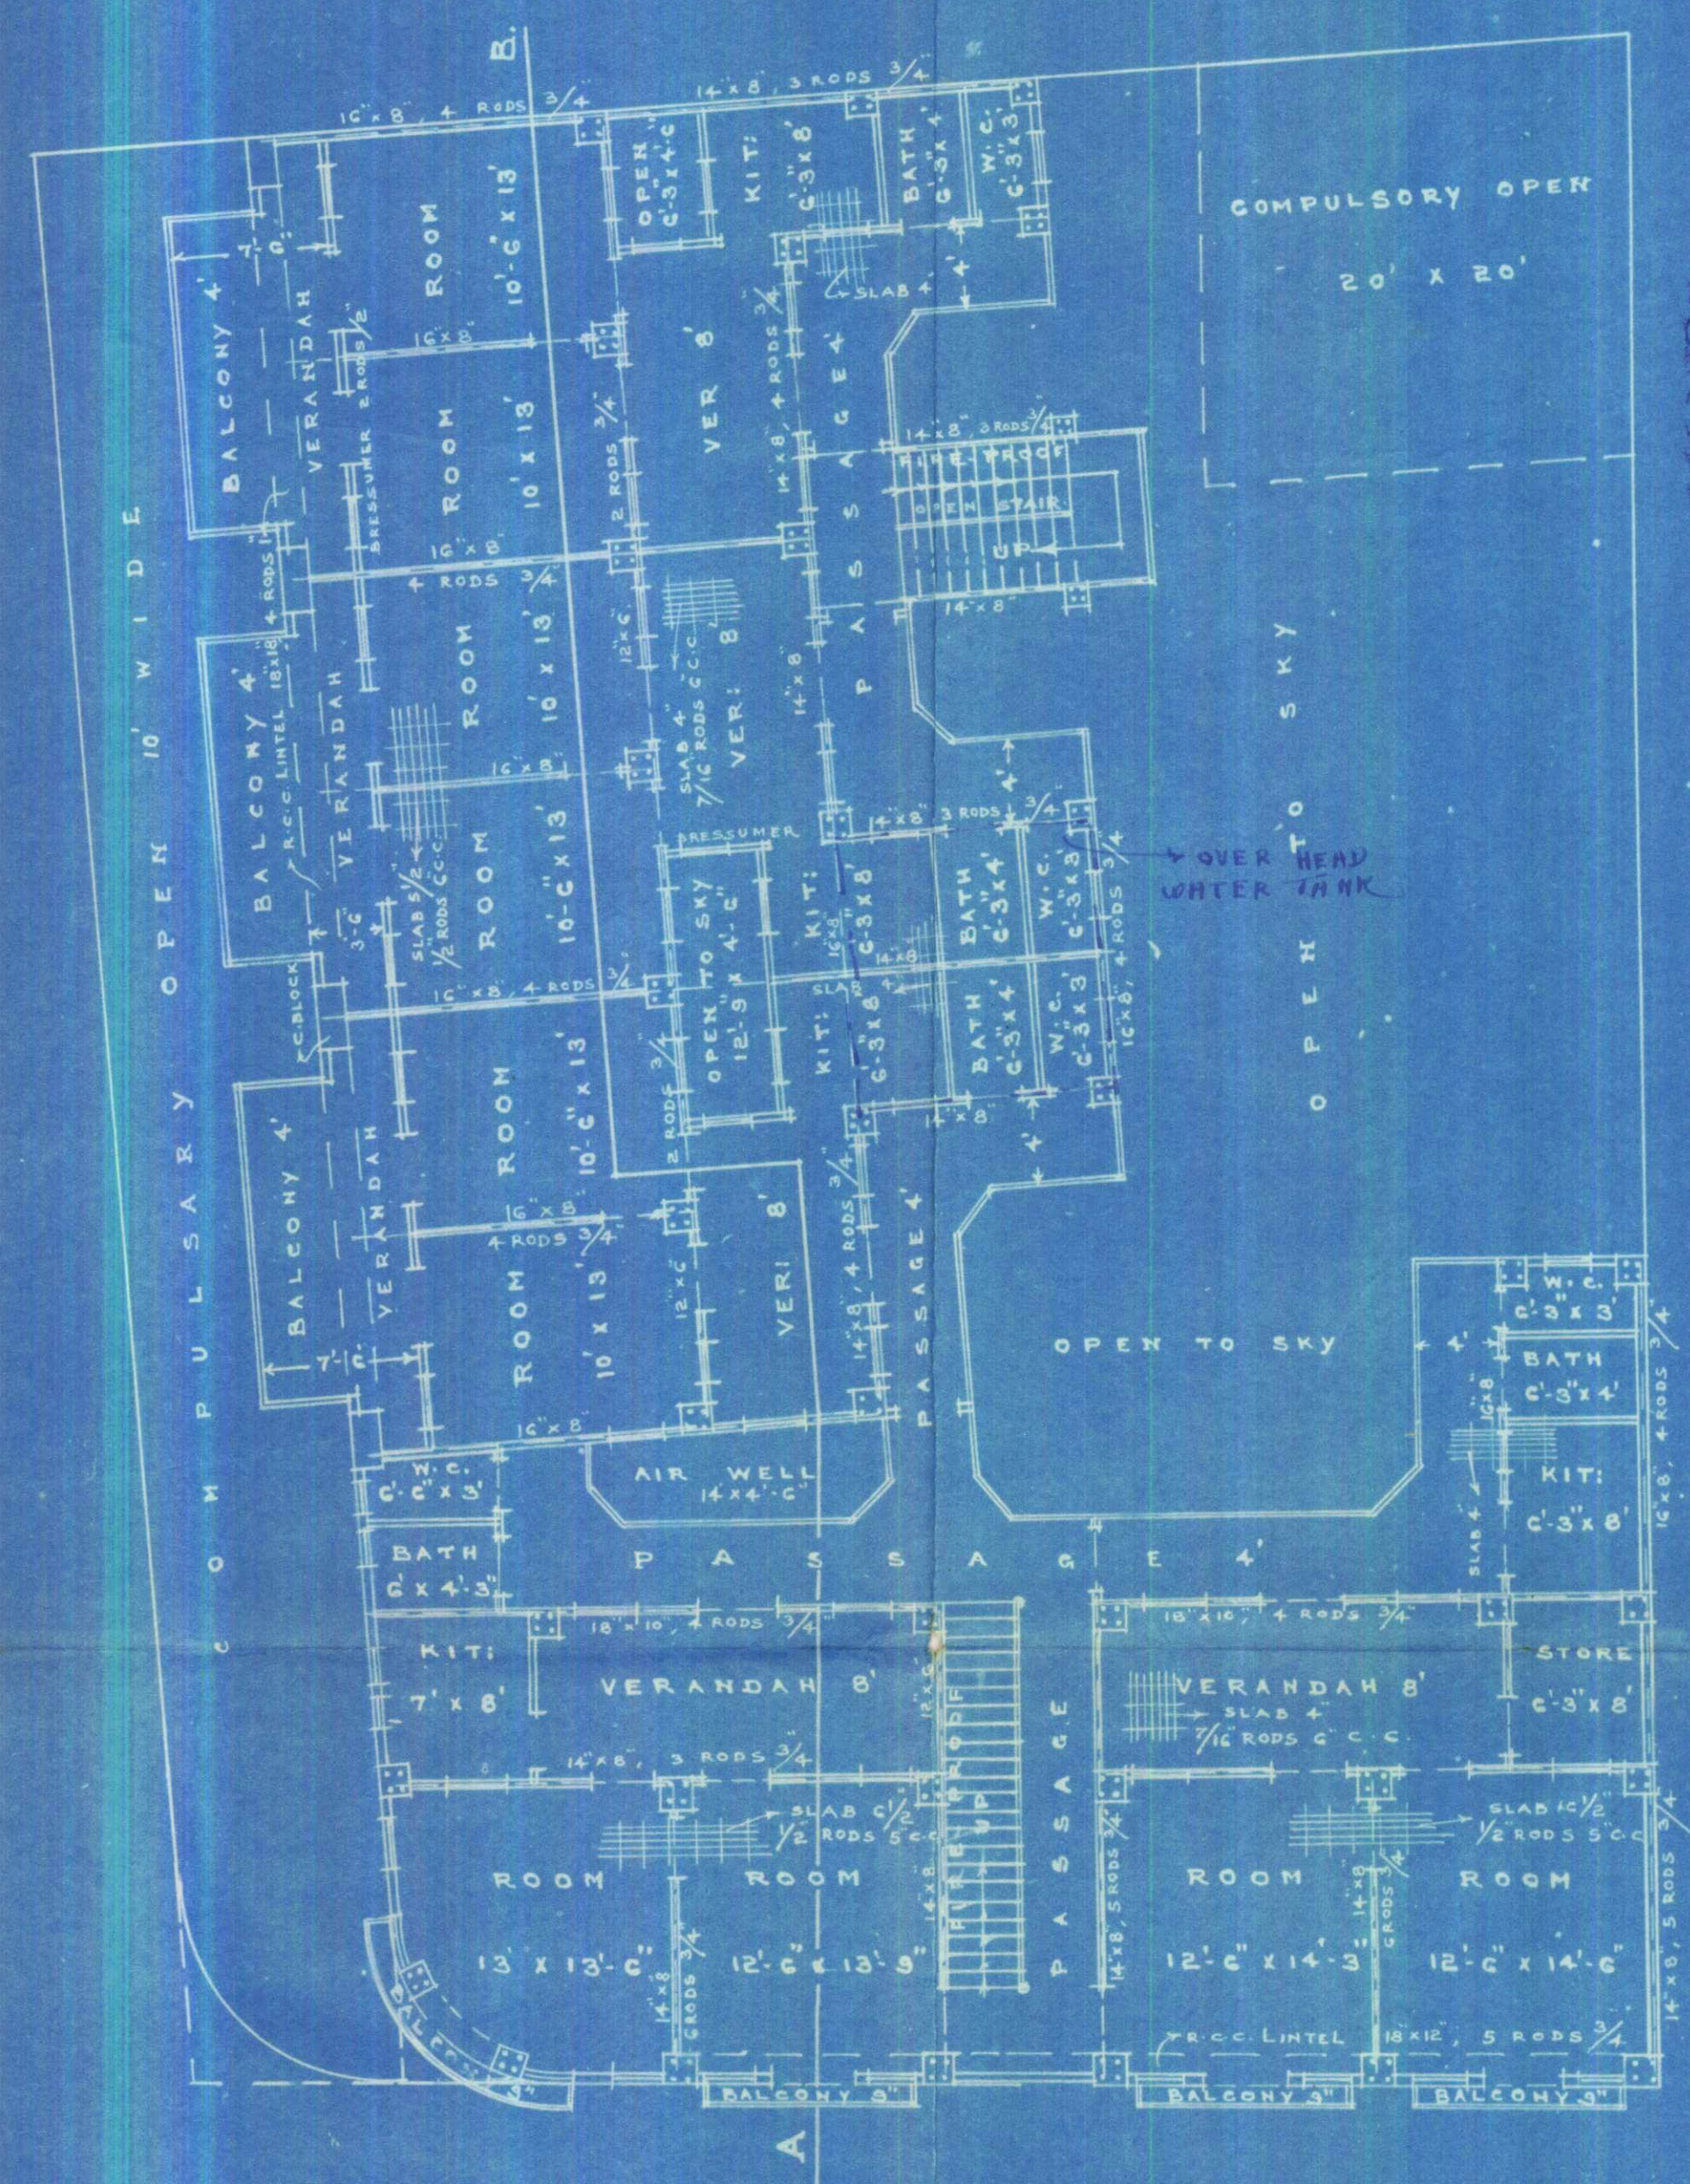

TOTAL AREA OF PLOT = 757.0 SQ YDS
 COVERED " " " = 377.0 " "

827

DT/26-7-40

SHEET NO 1

Plan is approved subject to the following conditions:
 (1) This sanction does not entitle the owner to build on land not conveyed to him by the Govt. or the Municipality by a deed or entry in a deed.
 (2) This sanction holds good provided the work of construction is commenced in earnest within a year from this date, whereafter the sanction will be deemed to have lapsed.

All Tanks built for purposes of carrying on building operations must be covered with plankings as required by Rule 9 (2) (b) of chapter II and rules VI of Municipal Rules sanctioned by the Commissioner-in-Chief under his No. 6101, dated 25-11-1933.

APPROVED.

[Signature]
 NOV 14 1940

Land Manager and Architect.

[Signature]
 OWNER. *[Signature]*

[Signature]
 M. KHIMJI & CO.
 ARCHITECTS

[Signature]
 LICENSED ARCHITECTS.