



Department \_\_\_\_\_

CB FILE No. 9 of 19 41

SECTION

PART

Disposal No. 22

Subject

58 B R I


*Note.*—Former Correspondence filed in file Compilation No.  
Subsequent Correspondence filed in file Compilation No.



**F. M. I. KURESHI,**

B. Sc. Engineering (Edin.)

LAND MANAGER & ARCHITECT,

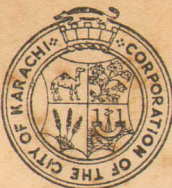

**MUNICIPAL CORPORATION,  
KARACHI.**

Reference No. B. S. P. **685/39**

MEMO :

Re: Plot No. **58, B.R.1** Sheet **Bunder** Qr.

Plan for **Building**  
on the above plot submitted by Mr. **Menghraj Moolchand**  
has been approved by the Karachi Municipal Corporation.


*[Signature]*  
OCT 4 - 1941  
Land Manager & Architect.

Copy forwarded to—


1. Health Officer,
2. Supdt. of Machinery,
3. Assessor, & Collector,
- ✓ 4. Building Surveyor, with plan,
5. Land Surveyor,
6. Enquiry Officer,

for information and necessary action.


*P. file in completion*  
*W*  
*Ken.*  
*29/11*  
*C*

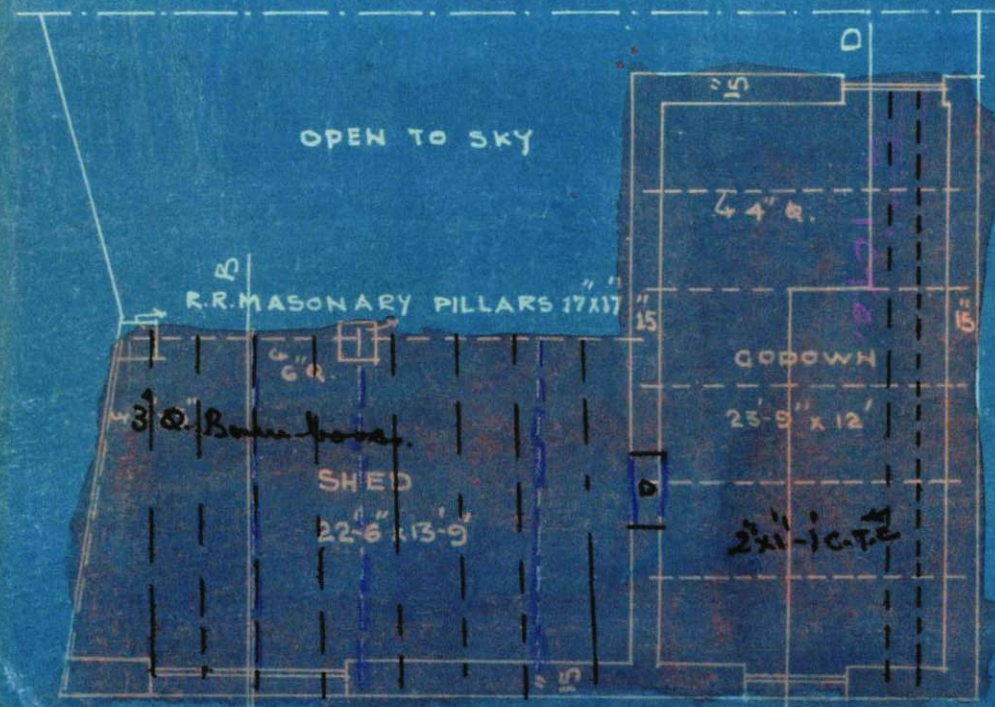

GROUND FLOOR

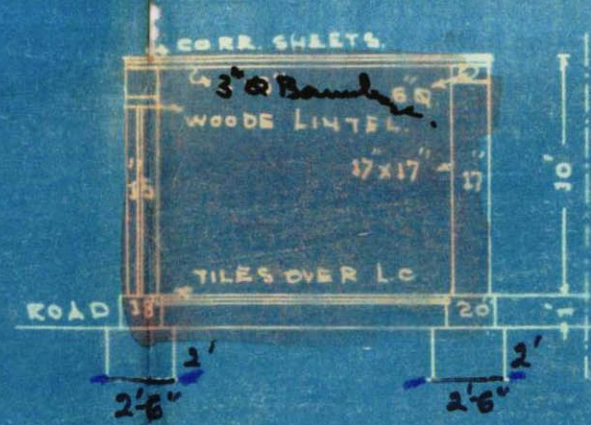

SECTION ON A.B.

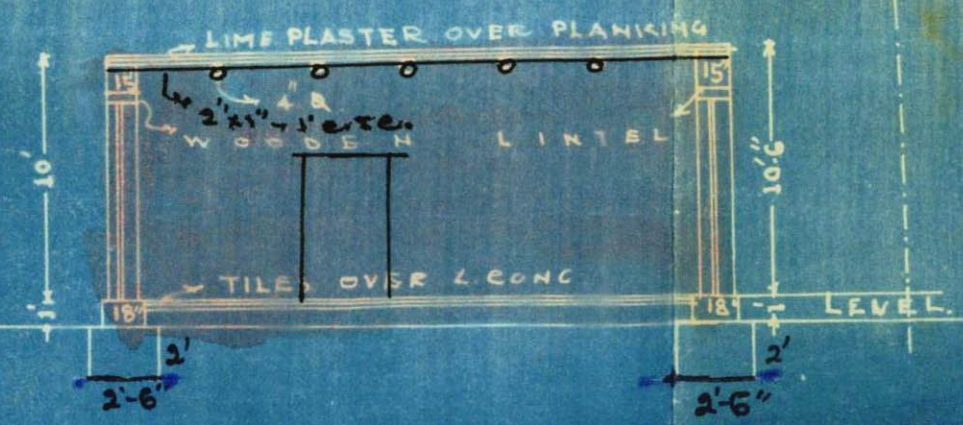


SECTION ON C.D.



SITE PLAN  
SCALE 20 FT. = 1 IN.



FRONT ELEVATION

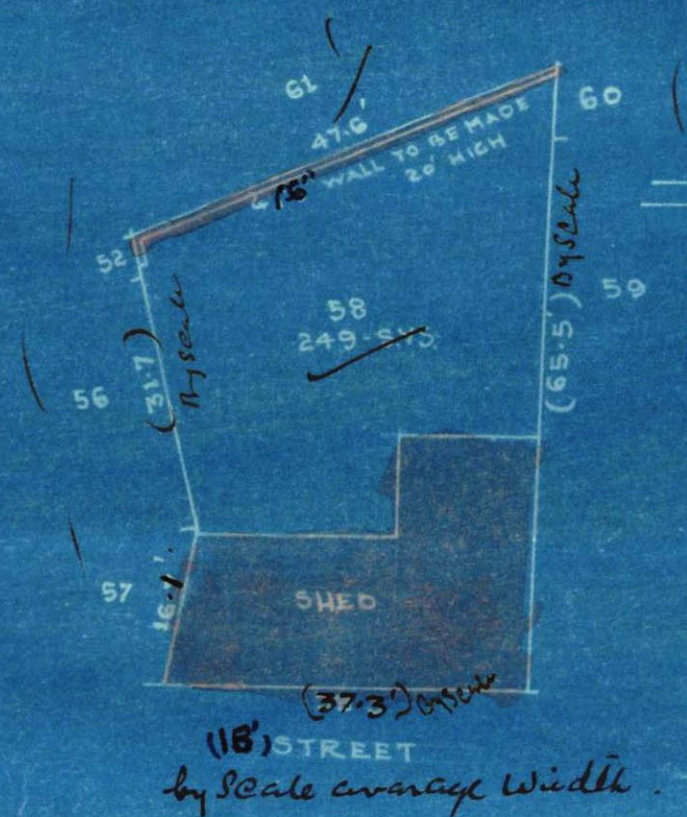

PLAN SHOWING UNAUTHORIZED STRUCTURES  
ON PLOT NO. 58, B.R.J. BUNDER.  
SCALE 8 FEET TO AN INCH  
STRUCTURE SHOWN IN RED

Note:—Plan is approved subject to following conditions.  
(1) This sanction does not entitle the owner to build on land not conveyed to him either by Govt. or the Municipality by a sanctioned plan or a sanad.  
(2) This sanction holds good, provided work of construction is commenced within a year from this date, whereas sanction will be deemed to have lapsed.

All Tanks built for purposes of supplying water for public operations must be constructed in accordance with the requirements of the Municipal Act of 1914, and the Municipal Rules sanctioned by the Government, and under the Act, 1914, dated 25-11-1914.

APPROVED.

*[Signature]*  
OCT 4 - 1941  
T. S. Manager and Architect.

1st, Mitthomal for Mangraj Boodchand.  
OWNER

ARCHITECT