



PROPOSED SERVANTS' QUARTERS AT D. J. SIND COLLEGE GYMKHANA ON PLOT NO. 1/2, C.L. 2, CIVIL LINES


SCALE: EIGHT FEET TO AN INCH

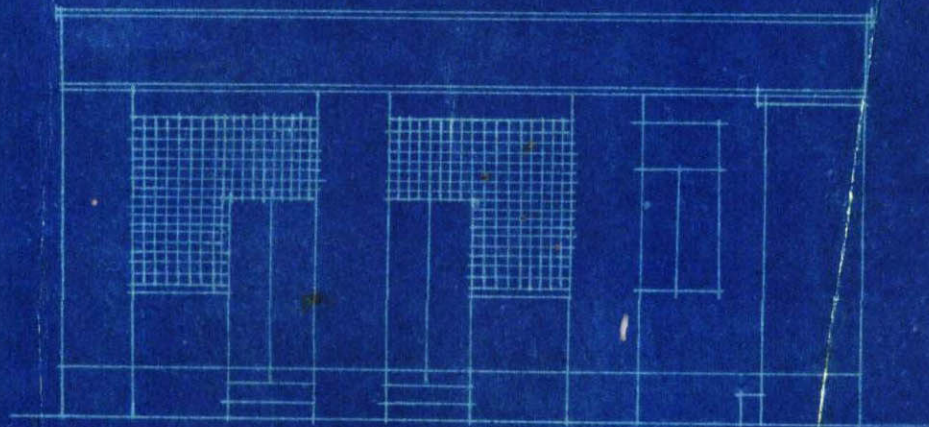


FRONT ELEVATION

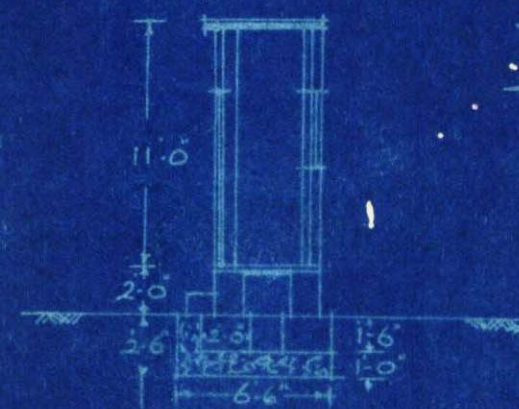

SECTION ON CD

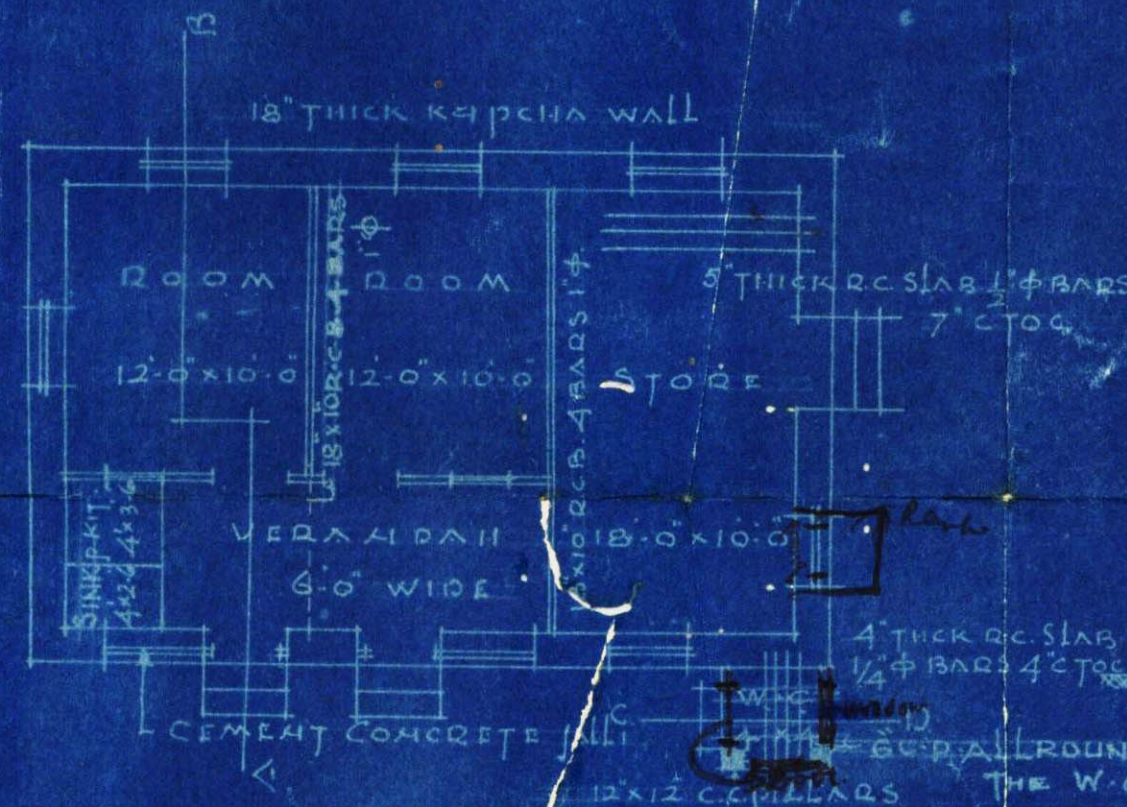

PLAN OF GROUND FLOOR

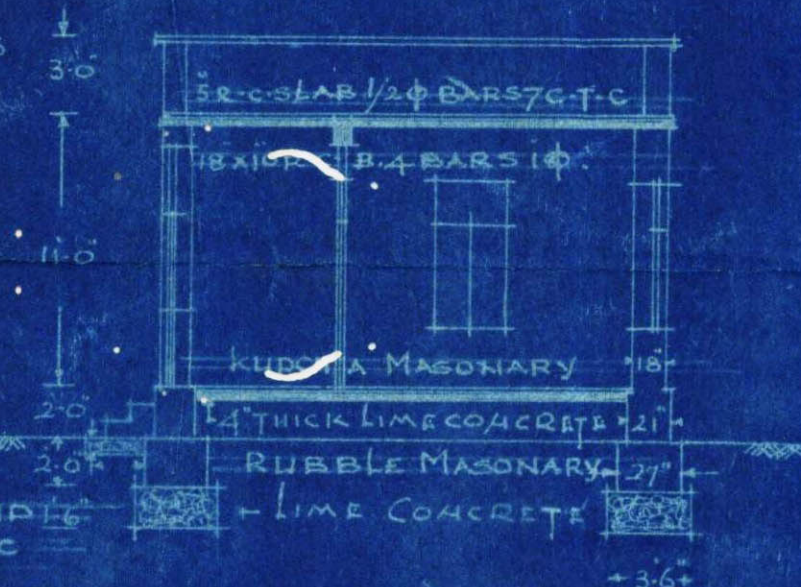


SECTION ON AB

SITE PLAN

SCALE: 80' TO AN INCH

AREA OF THE PLOT

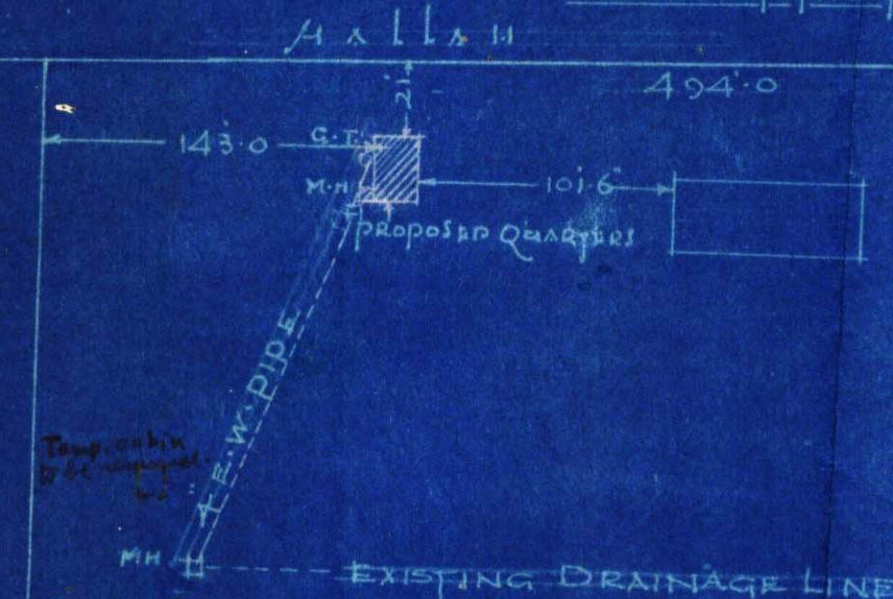


APPROVED

Land Manager and Architect

MAY 31 1940

498'-0"

LAND SET BACK

KACHERY ROAD 100' WIDE

B. V. Shinde

ARCHITECT

GOKALNATH BILHARE

ARCHITECTS

OWNER