



1-1

1903

2314

86 K.4 L.Y

Ch. Eng./A-3/62-63-3,000 (Accept. Letter form)

OFFICE OF THE CHIEF ENGINEER, K.M.C.

Section

No. CE/

Dated

To,

Messrs

KARACHI

Subject:—

Dear Sir,

at _____ % above/below the schedule of rates has been accepted by the Chairman/Vice-Chairman. You are requested to please pay a sum of Rs. _____ being contract deposit.

The cost of stamps to be affixed on the agreement to be executed amounting to Rs. _____ will have to be borne by you.

Please comply with the above said requirements within a week from the receipt hereof failing which, the acceptance will be treated as time-barred and the amount of the tender deposited will be forfeited without any further notice.

Please note that in case the contract deposit is to be paid in Government paper or Public securities, extra stamps duty of Rs. 2/- will have to be paid by you

Yours faithfully,

Vice-Chairman/Dy. Chief Officer



no 172.

2 19

Permission granted to Mr.
Per Mahmud Ahmad for
plus. no. 86- key Library 90.

C. M.
W. C.
20/1/03

3 19
No 6133 8/1/03

Municipal office.

Karachi 8th July 03.

11/10

Memo

With reference to his application dated 29th ultimo, with a plan of a house to be built on plot No 86-X4, Morra lane Ryoree quater, Mr. Peer Mahomed Morad is informed that his plan is approved except the drainage arrangements.

He will not be permitted to have a Catch pit but must connect the house with the municipal drain which passes along the road in front of his plot. He is therefore requested to make an application for this connection in the usual way.

J. B.

In J. C. C.

or

Chief Officer of the

At

Karachi Municipal

6134 Copy to the Inspector of the quater.
through the Health Officer.

4-1

To,

The Chief Officer and of Engineer
Karachi Municipality.

With reference to the attached application
dated 29th instant together with the house
plan of a house to be built on plot 2086
K.H. Ryana quarter, I beg to report that there
is no objection in granting permission with
the Health Officer's report.

R 1225
2-7-03



Yours obedtly
Kathant
1/7/03.

Mr H.O. for favour
Prof. Forest Committee

M. J. G. G.

Chief Officer, Karachi Municipality

12
1800



Int. sks W.H.O.
must

2/8/1903

The inner sks catchpit
on the place; whereas
the municipal sewer
runs past the proposed
building; this sewer should
be connected with the
drainage system
now

4/7.



Surveyor ... Can this
be connected with
the drains -

4/7/03

W.B.

Sir,

This can be connected
with the drain running
in front of the house on
plot no 86 & 4, Kaffanchi
Yours obediently
6/7/03

To Surveyor.

Superior applicant
his plan is approved
except the drainage
arrangements. —

He will not be
permitted to have
a cut pit back
to connect the
house to with the
Municipal drain which
passes along the road
in front of his plot. —
Application should
be made for this
connection in the
usual way —

6/7/03 GJB



6-1

Form No. I.

Karachi, 27th June 1903

Notice under Section 96 of the Municipality Act III of 1901.

To

THE CHIEF OFFICER AND ACTING ENGINEER,

KARACHI MUNICIPALITY.

SIR,

I beg to inform you that I intend building House

on plot No. 86, Survey Sheet No. 44, situate in Moosa Lane

Street Lyari, Quater.

As required by the Rules of the Municipality I beg to submit herewith
a Plan of the same for your approval.

I beg to remain,

Sir,

فستانی محمد پیر محمد مراد

Your most obedient Servant,

ie. Perrunehad Mirad

6-2



The above application is forwarded to the Municipal Town Surveyor for full report regarding the particulars noted below.



M. I. C. E.,
Chief Officer and Acting Engineer,
Karachi Municipality.

Town Surveyor's Report.

Particulars.	Remarks.
Whether the applicant is the owner of the plot on which it is proposed to build.	
State privy accommodation and arrangement for removal of waste water.	
Is ventilation sufficient.	
Is light ditto.	
It should be stated exactly the distance the proposed building is to be from an adjoining building.	
Other remarks.	

Submitted to the Municipal Chief Officer and Acting Engineer with compliments.

Town Surveyor,
Karachi Municipality.

6-3

3

M E M O .

Plan of proposed building on plot No. _____, Survey Sheet No. _____,

_____ Quarter, is submitted to the Managing Committee

for approval.

Ths Chief Officer and Acting Engineer being of opinion that the plan is

Date _____

M. I. C. E.,

Chief Officer and Acting Engineer,
Karachi Municipality.Resolution of the Managing Committee.


M E M O .




PLAN SHEWING PROPOSED ALTERATION TO DOWN STAIR
& PROPOSED UPSTAIR TO BE BUILT ON PLOT No 86 K, A,
LYAREE, QUARTER.

SCALE 8 FEET = ONE INCH.


29/1/1903

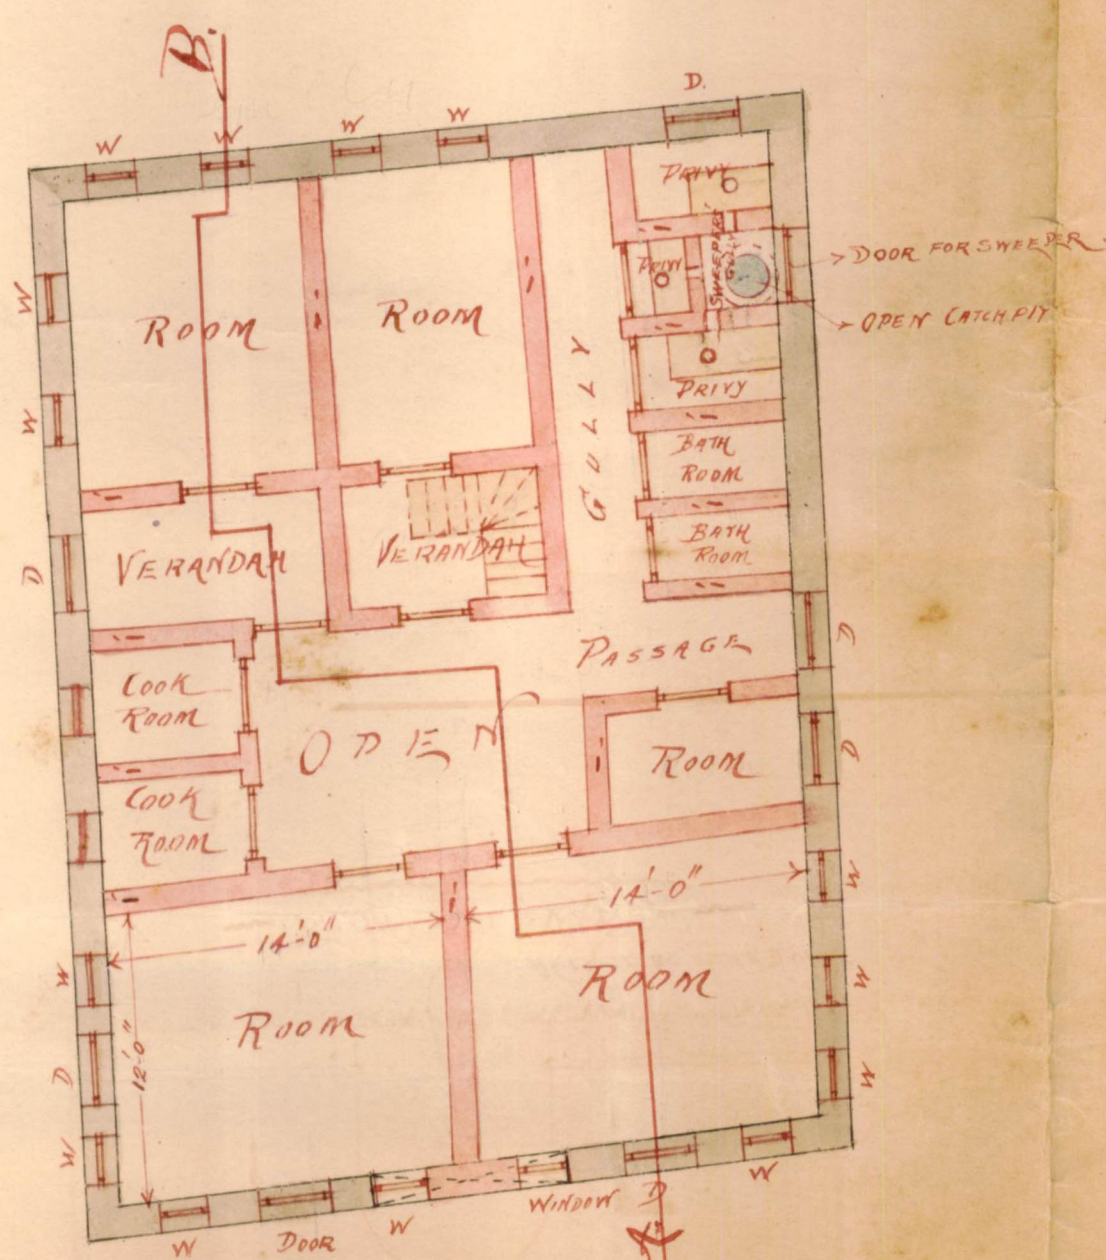

GROUND PLAN.

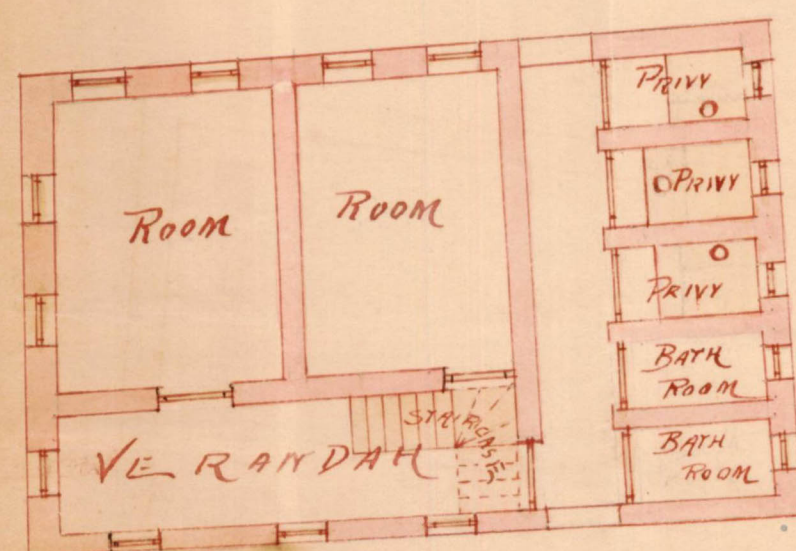

PLAN OF UPPER STORY

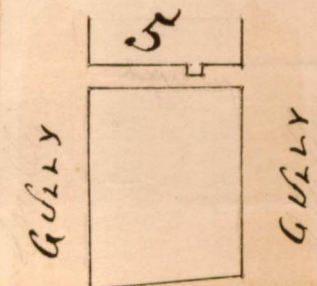


ROAD

BLACK PLAN


SCALE 40 FT = ONE INCH.

REFERENCE

RED COLOUR SHOWS PROPOSED WORK.
BLACK D. D. OLD WORK.
OLD WINDOWS ON GROUND PLAN NOT SHOWN
IN COMPOUND WALL ON ACCOUNT OF CONFUSION.
ALL OUTER WALLS OF THE BUILDING TO BE BUILT IN STONE.
ALL INNER D. D. D. D. D. D. IN PURCA BRICK 1 INCH.
D-DENOTES DOORS. W. DENOTES WINDOWS

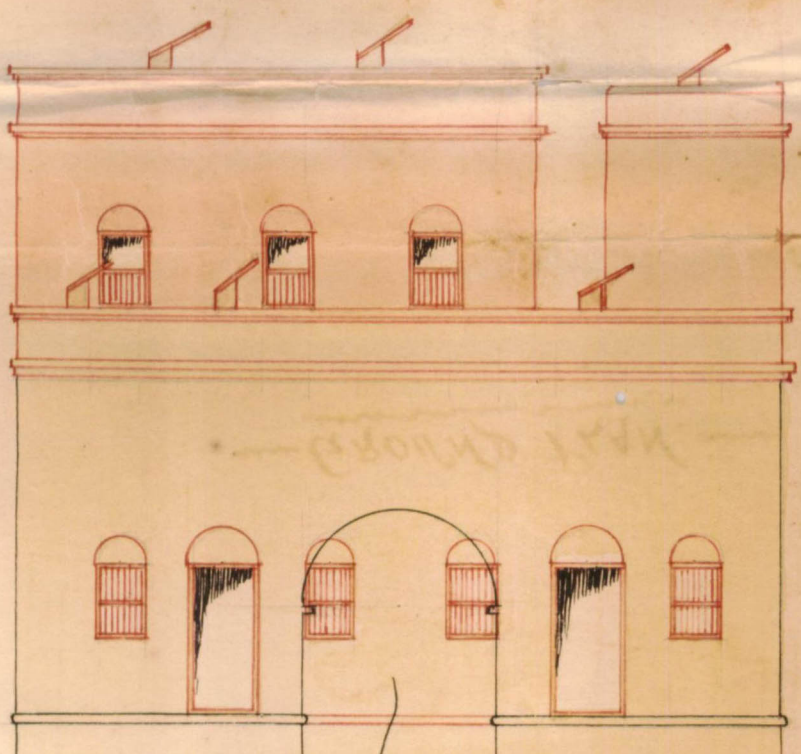

FRONT ELEVATION

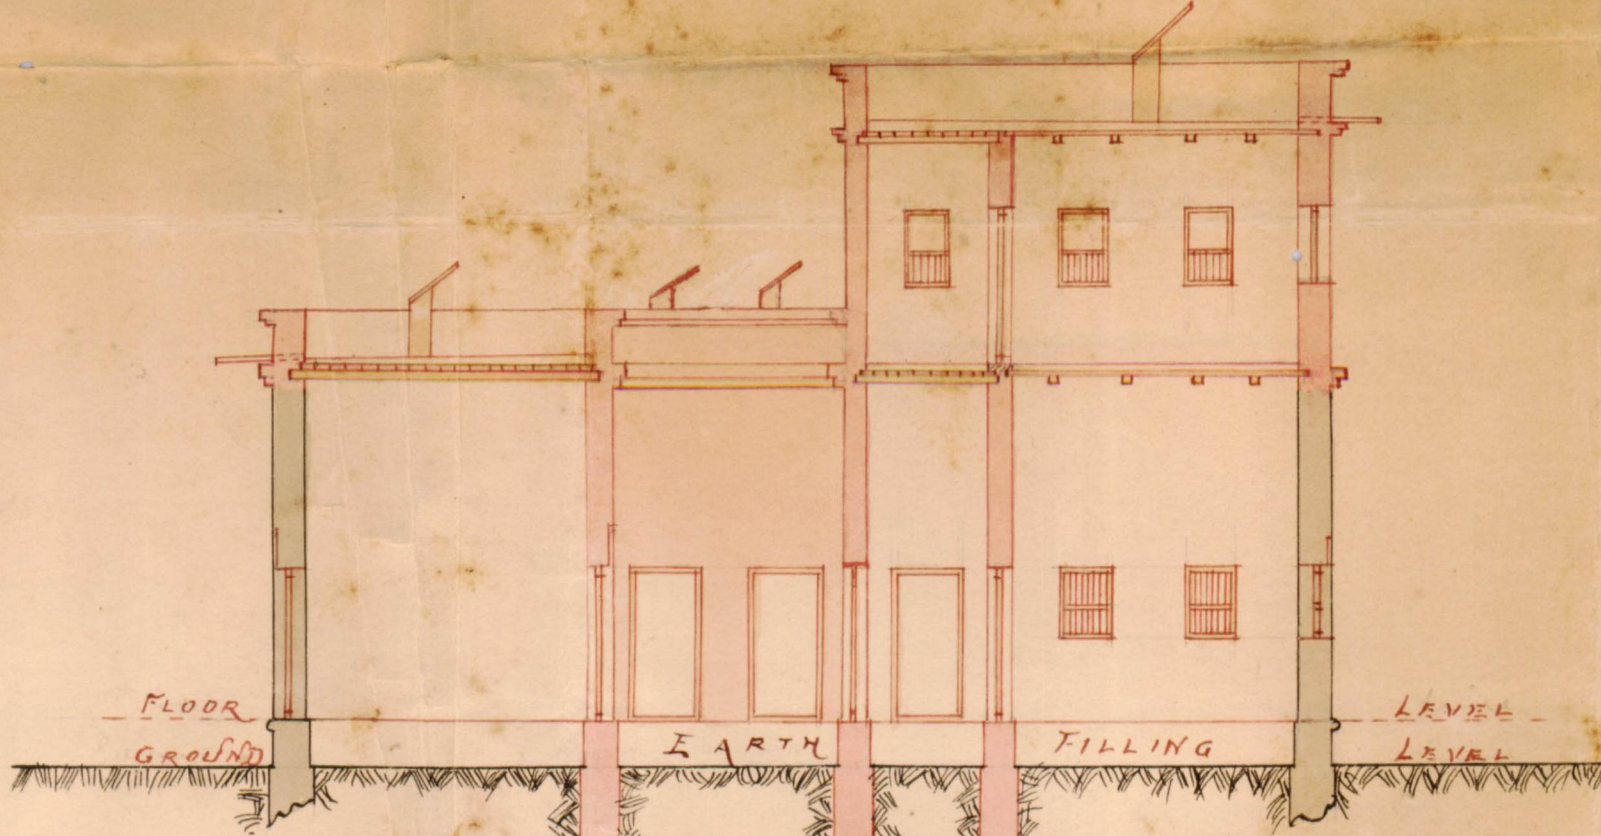

CROSS SECTION ON A. B.